

AS-BUILT DOCUMENTATION


FRANKLIN, TN 37069



100% SUBMITTAL

DRAWING INDEX

- C-1 COVER SHEET | DRAWING INDEX
- SL SYMBOLS LEGEND
- AB-1 FIRST FLOOR PLAN

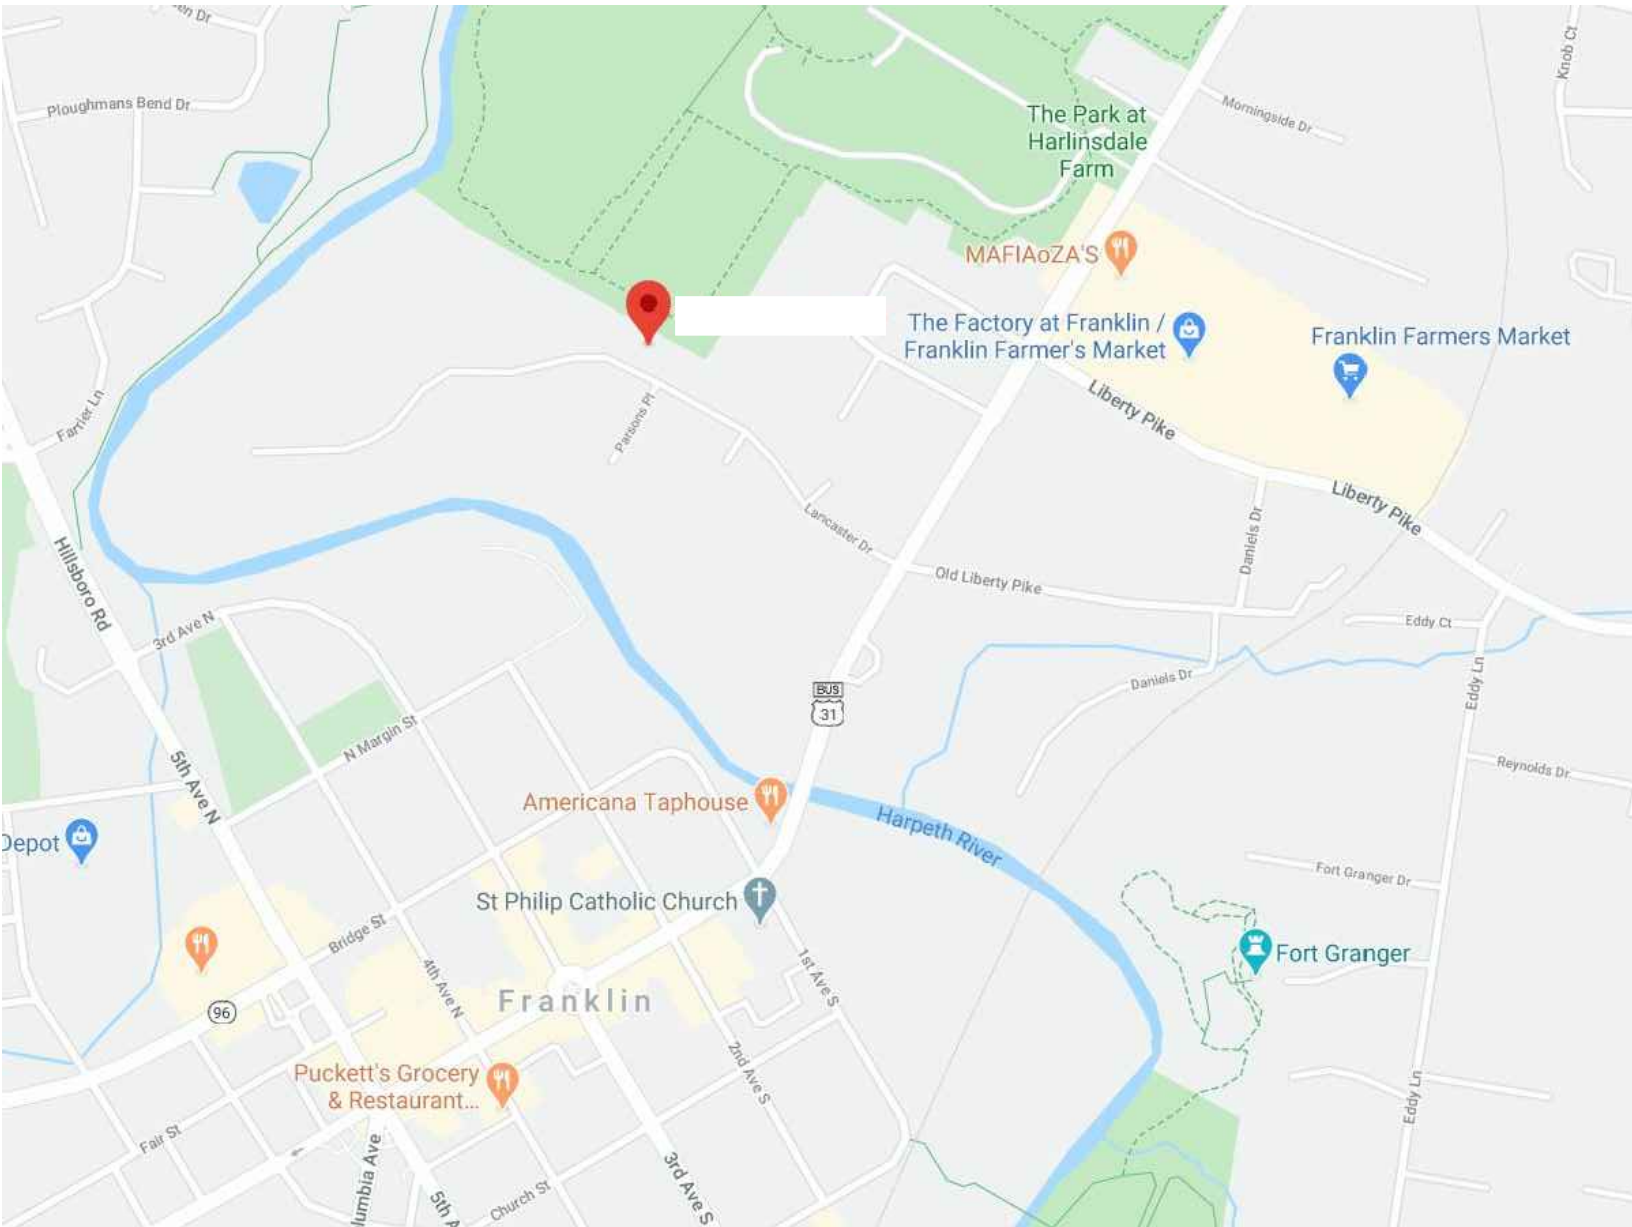

VICINITY MAP
NTS

AREA DATA	
FIRST FLOOR	1652 SQ. FT. ±
GARAGE	642 SQ. FT. ±
GRAND TOTAL	2295 SQ. FT. ±

AS BUILT

PROFESSIONALS

www.asbuiltprofessionals.com

A DIVISION OF:

AEC

CONSULTANTS INC

844.272.8458

844 A S B U I L T



© 2020 AEC CONSULTANTS INC

ARCHITECTURAL AS BUILT

FRANKLIN, TN 37069

01	100% SUBMISSION	SEE COVER SHEET
NO.	ISSUES REVISIONS	DATE
		SHEET TITLE
COVER		
HL	PROJECT MANAGER	
HL	PROJECT DIRECTOR	
012317-1	PROJECT NUMBER	
	SCALE	
CL	DRAWN BY	
	SHEET NUMBER	
C1		


SYMBOLS LEGEND

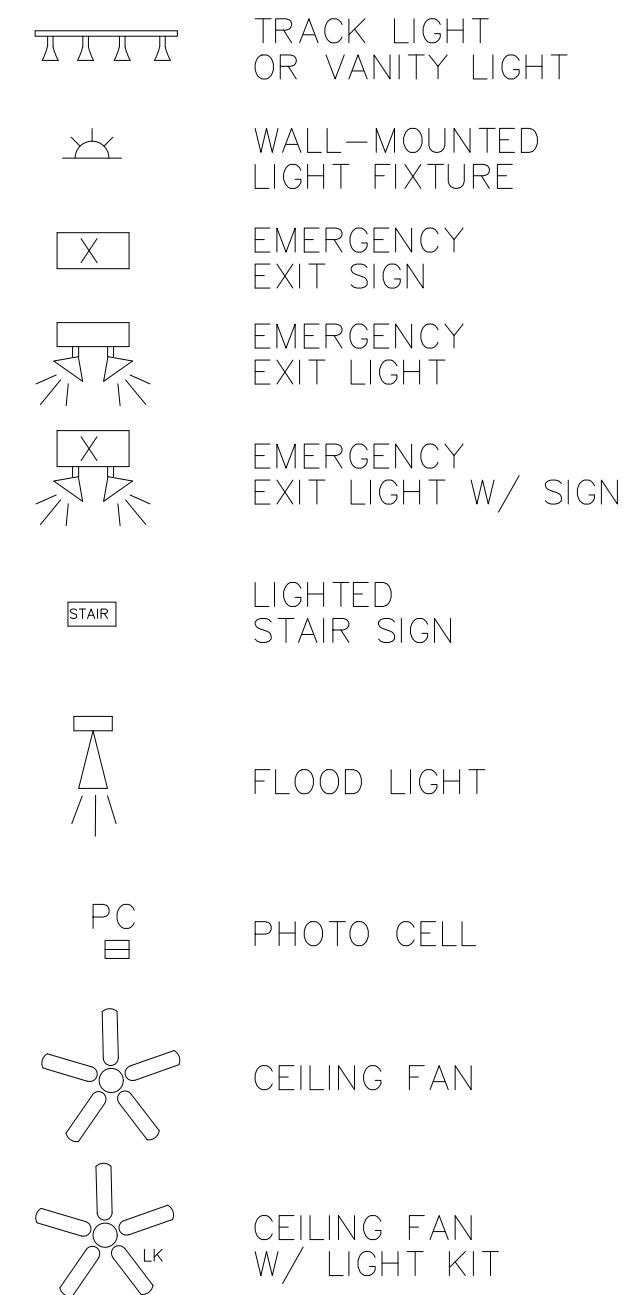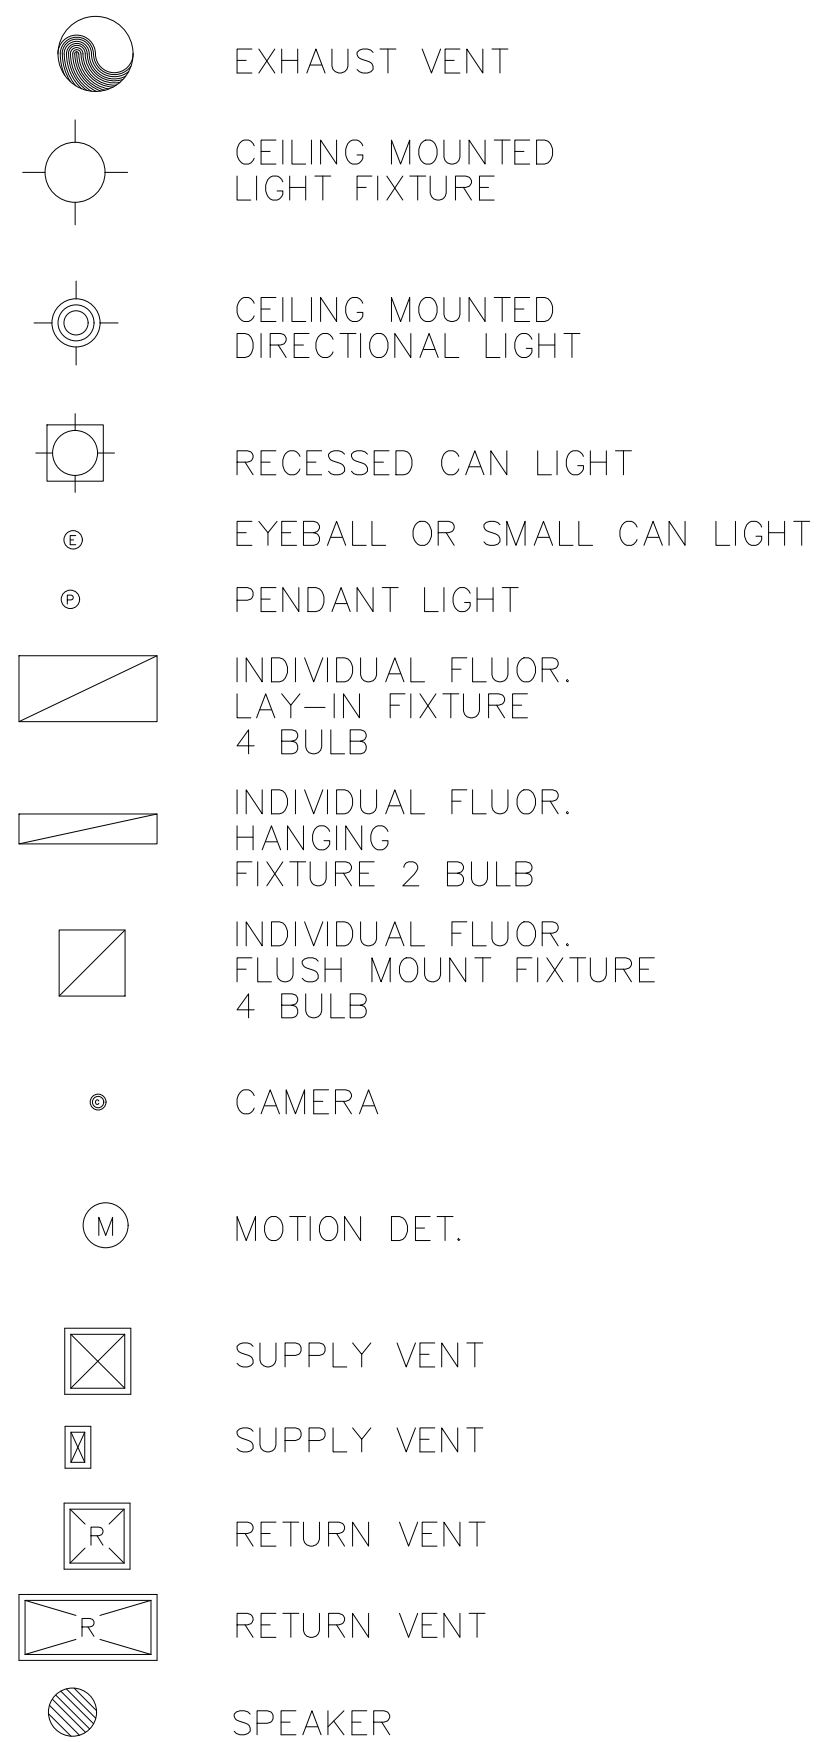RCP


7-2-6 CEILING HEIGHT AND TRIM 7'-2"
ABOVE FLOOR BELOW WITH 6"
CROWN MOULDING. NOTE: ALL
CEILINGS NOT LABELED ARE
PLASTER. CEILINGS SHOWN WITH
A GRID ARE LAY IN ACOUSTICAL
TILE.




ELECTRIC

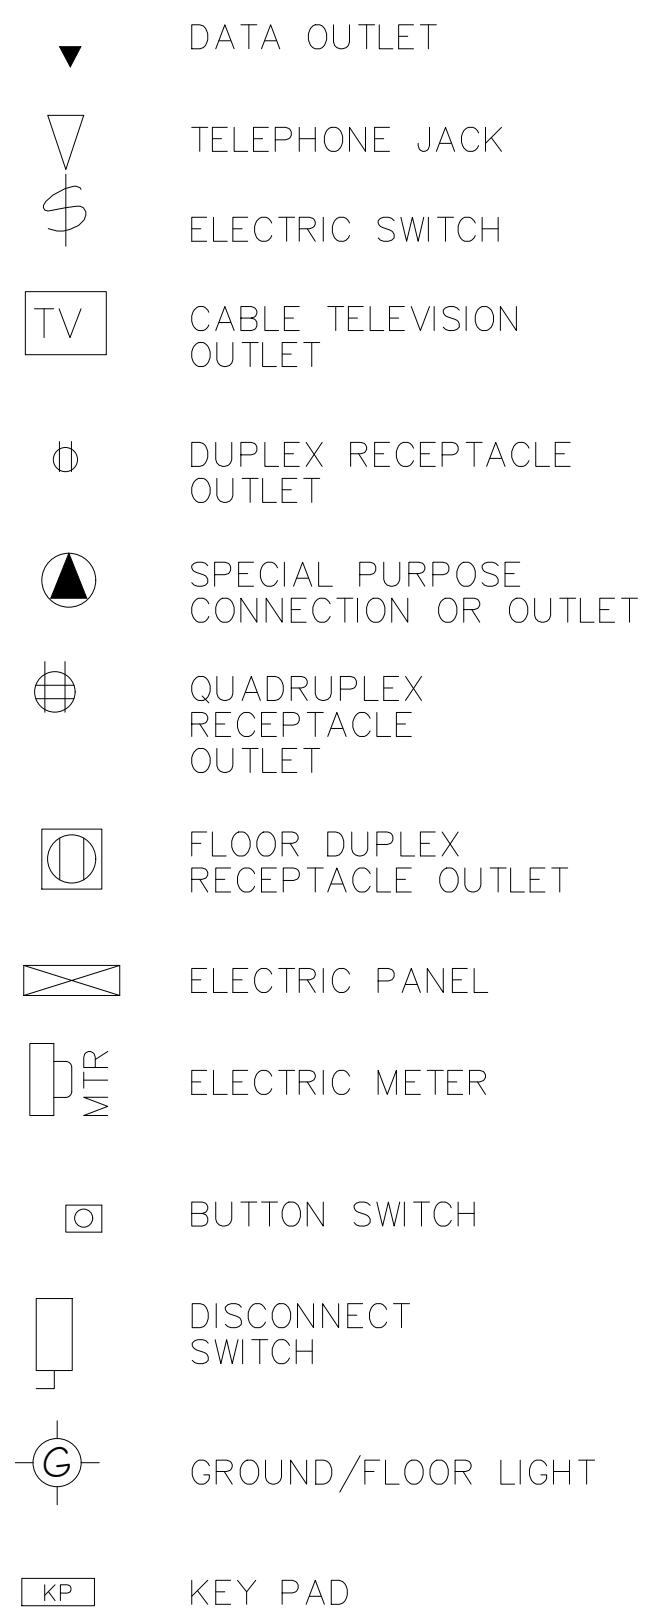


FIRE PROTECTION

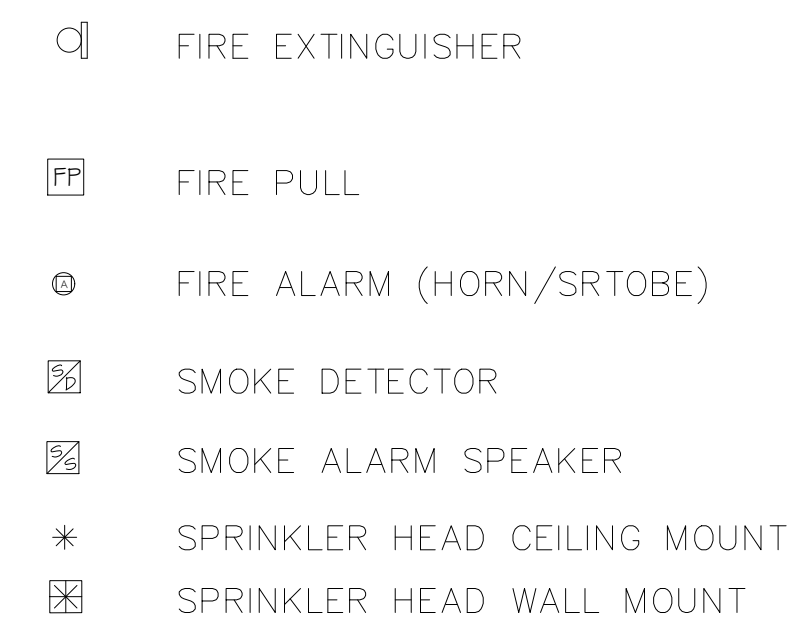


MEP

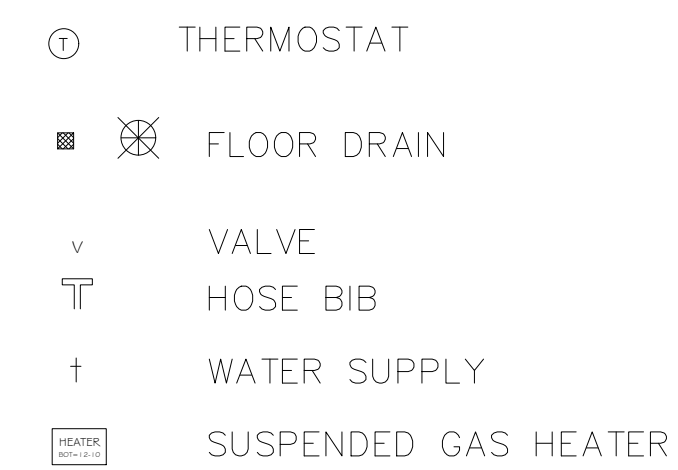


MISC

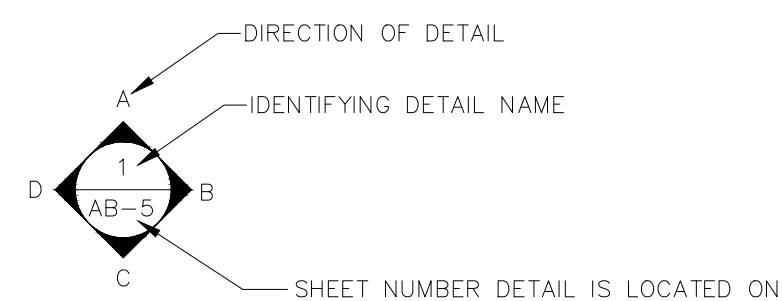


INTERIOR ELEVATIONS

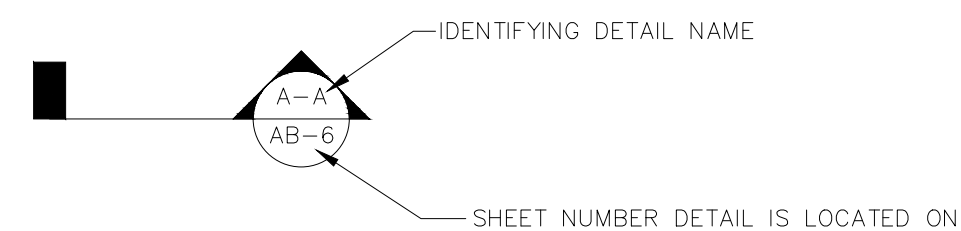

BUILDING SECTION

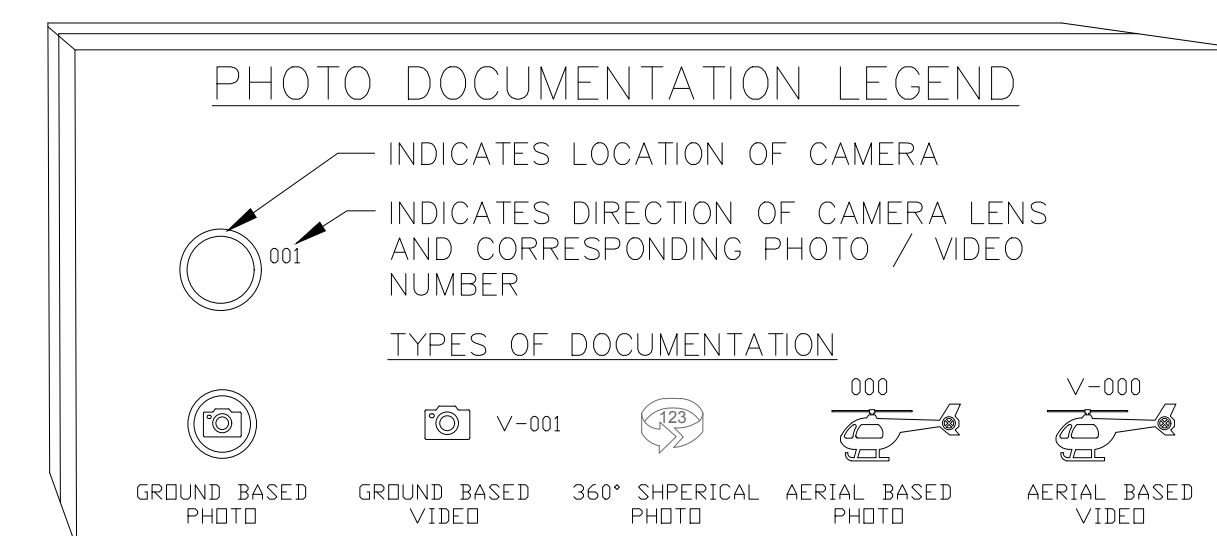

01	100% SUBMISSION	SEE COVER SHEET
NO.	ISSUES REVISIONS	DATE
		SHEET TITLE
SYMBOL LEGEND		
HL	PROJECT MANAGER	
HL	PROJECT DIRECTOR	
012317-1	PROJECT NUMBER	
	SCALE	
CL	DRAWN BY	
	SHEET NUMBER	
SL		

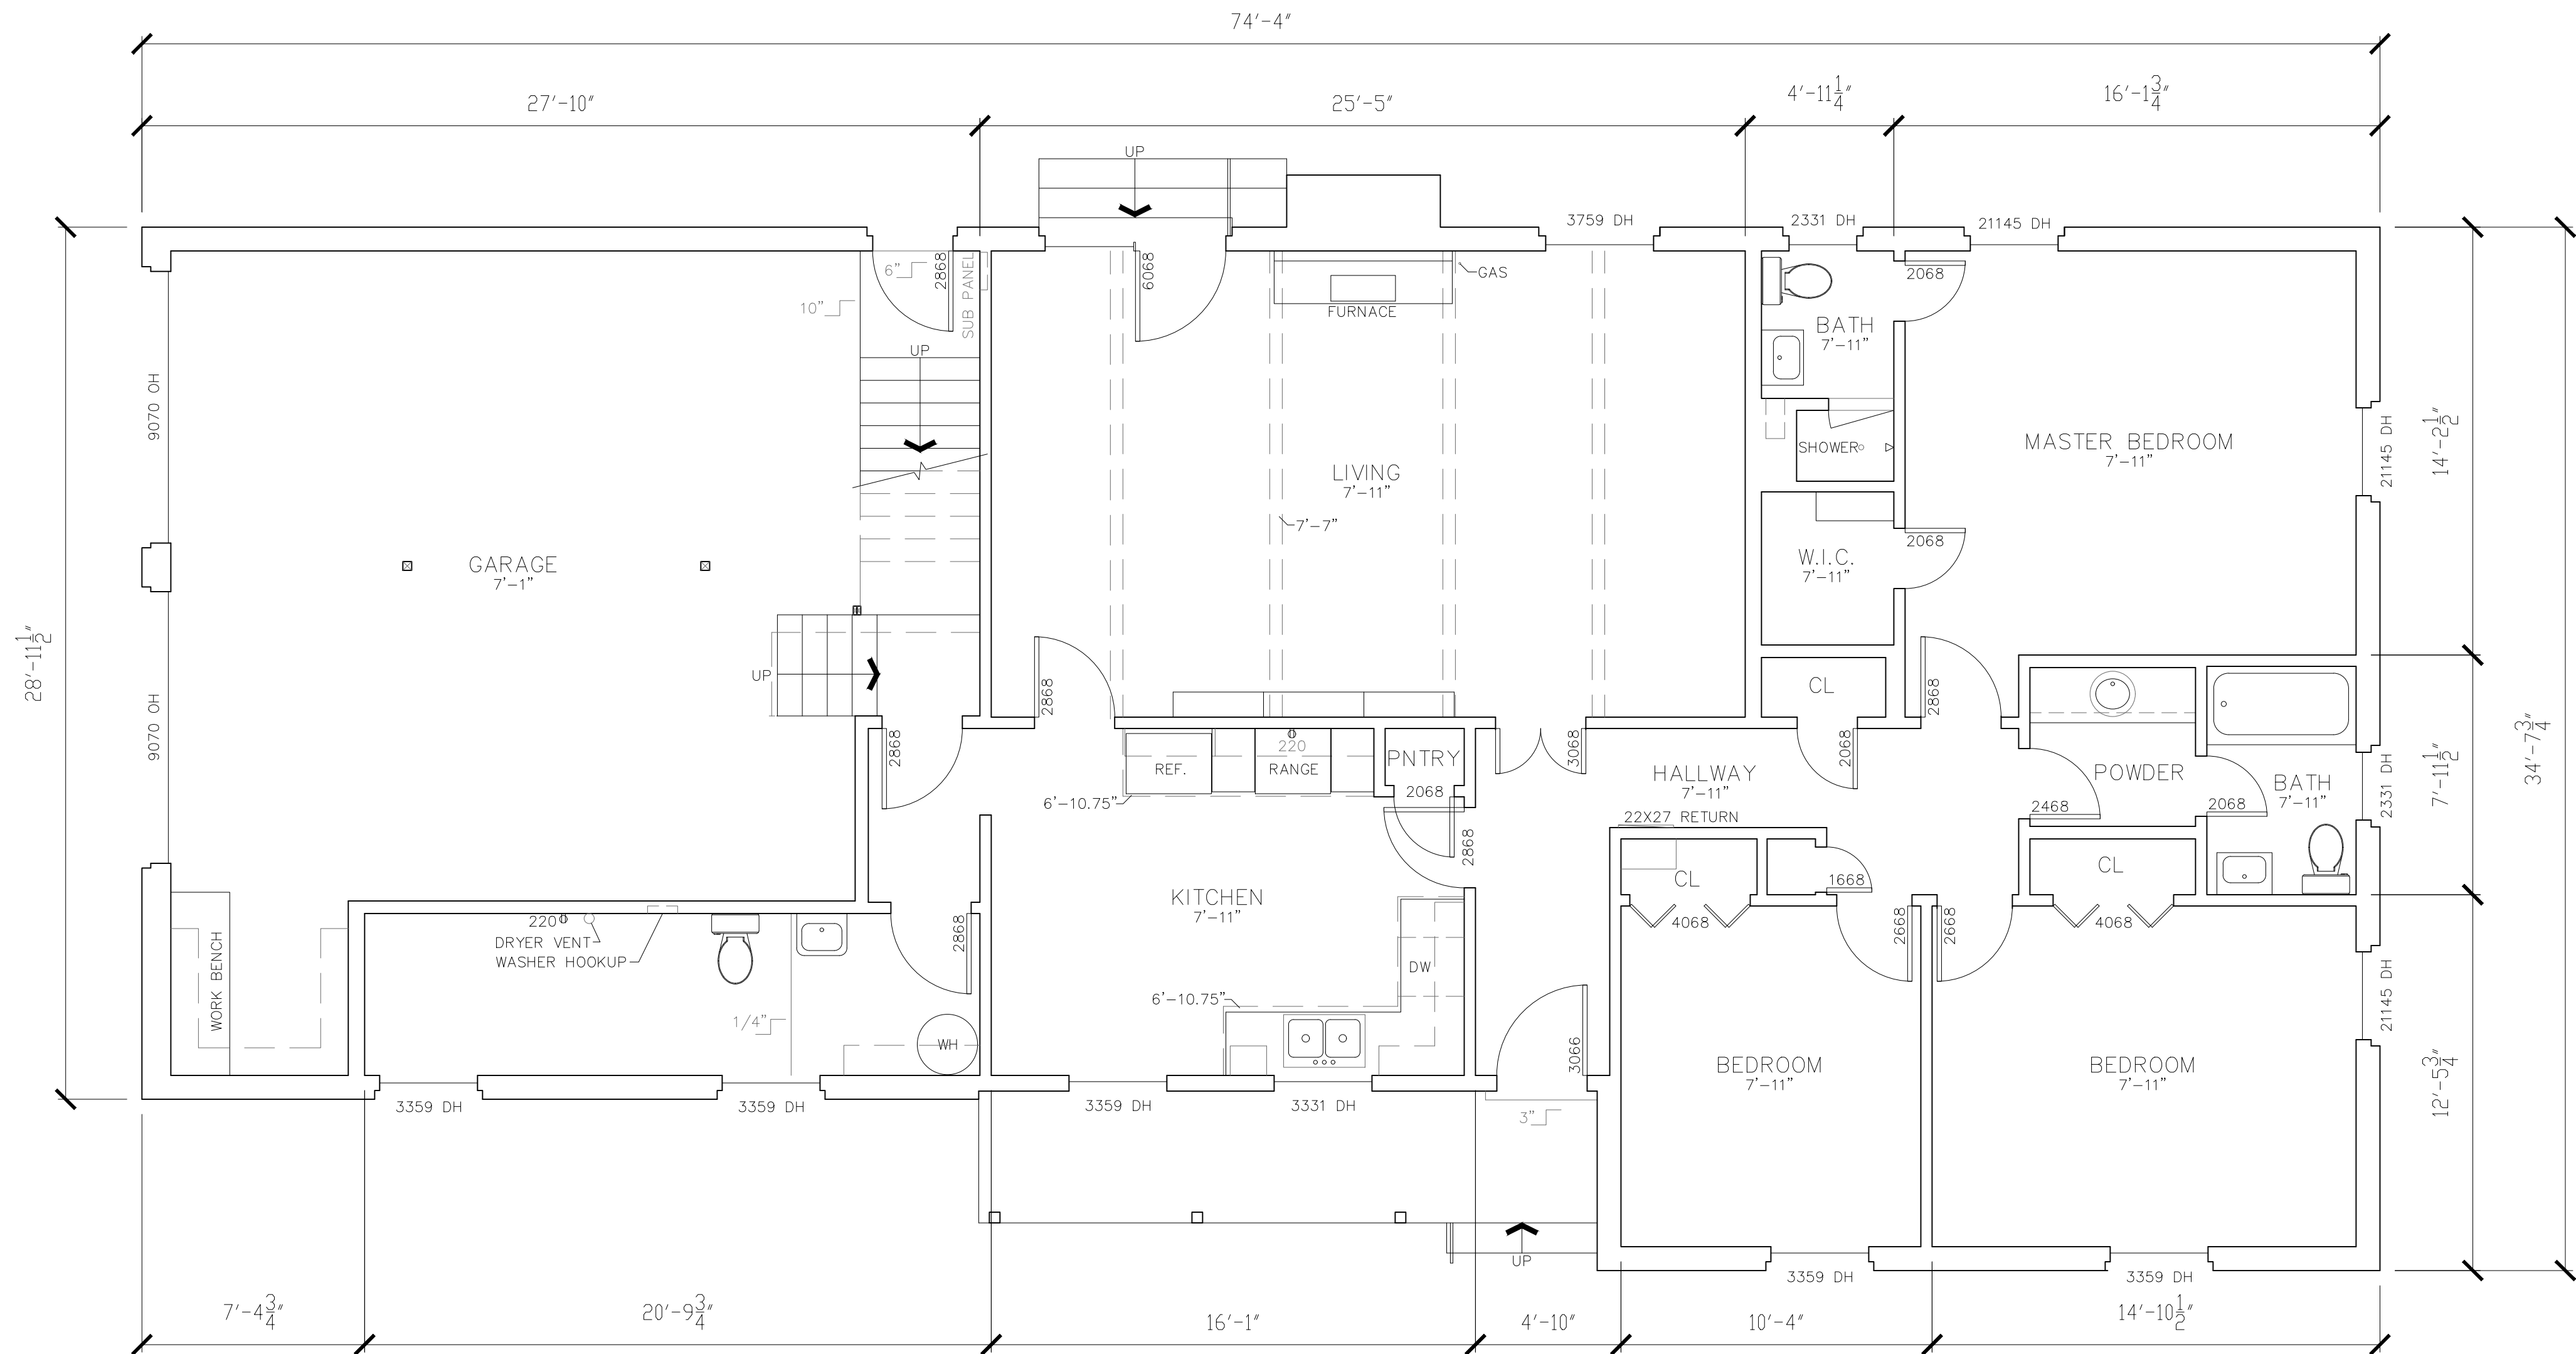

ARCHITECTURAL AS BUILT

FRANKLIN, TN 37069

01	100% SUBMISSION	SEE COVER SHEET
NO.	ISSUES REVISIONS	DATE
		SHEET TITLE
FIRST FLOOR PLAN		
HL	PROJECT MANAGER	
HL	PROJECT DIRECTOR	
012317-1		PROJECT NUMBER
1/4"=1'-0"		SCALE
CL	DRAWN BY	
		SHEET NUMBER