


AS-BUILT DOCUMENTATION

Gallatin, TN

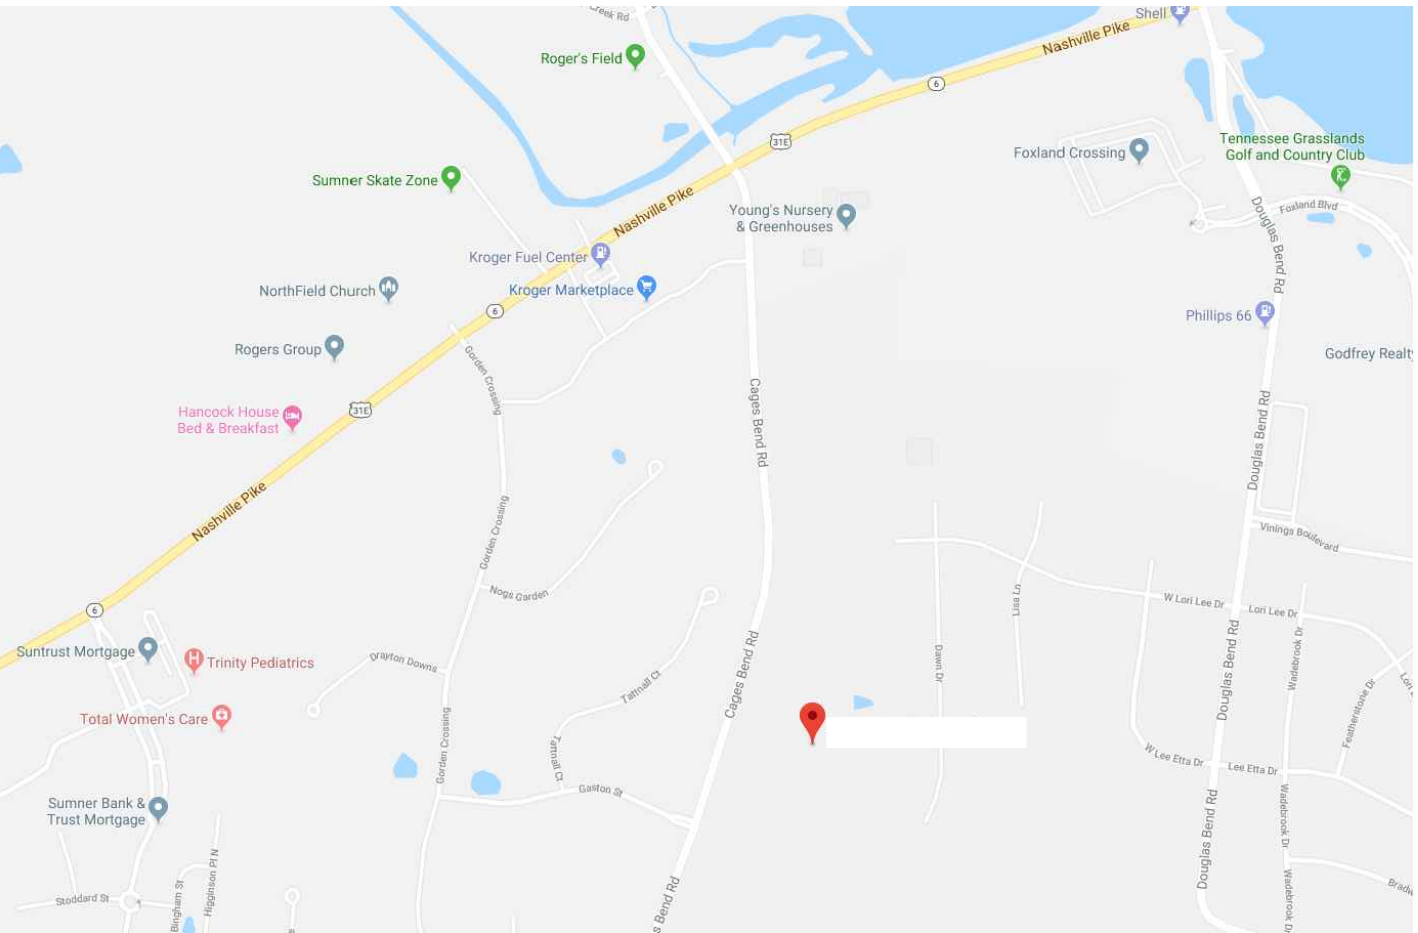

VICINITY MAP
NTS

AREA DATA	
GARAGE	500 S.F. ±
FIRST FLOOR	4,408 S.F. ±
SECOND FLOOR	2,188 S.F. ±
GRAND TOTAL	7,096 S.F. ±

DRAWING INDEX

C-1	COVER SHEET DRAWING INDEX
SL	SYMBOLS LEGEND
AB-1	FIRST FLOOR PLAN
AB-2	SECOND FLOOR PLAN
AB-3	EXTERIOR ELEVATIONS
AB-4	EXTERIOR ELEVATIONS

AS BUILT

PROFESSIONALS

www.asbuiltprofessionals.com

A DIVISION OF:

AEC

CONSULTANTS INC

844.272.8458

844 A S B U I L T

© 2018 AEC CONSULTANTS, INC.

ARCHITECTURAL AS BUILT

Gallatin, TN


01	100% SUBMISSION	SEE COVER SHEET
NO.	ISSUES REVISIONS	DATE
SHEET TITLE		
COVER SHEET		
HL	PROJECT MANAGER	
HL	PROJECT DIRECTOR	
012317-1	PROJECT NUMBER	
	SCALE	
CL	DRAWN BY	
	SHEET NUMBER	

C-1

100% SUBMITTAL



BACK ELEVATION

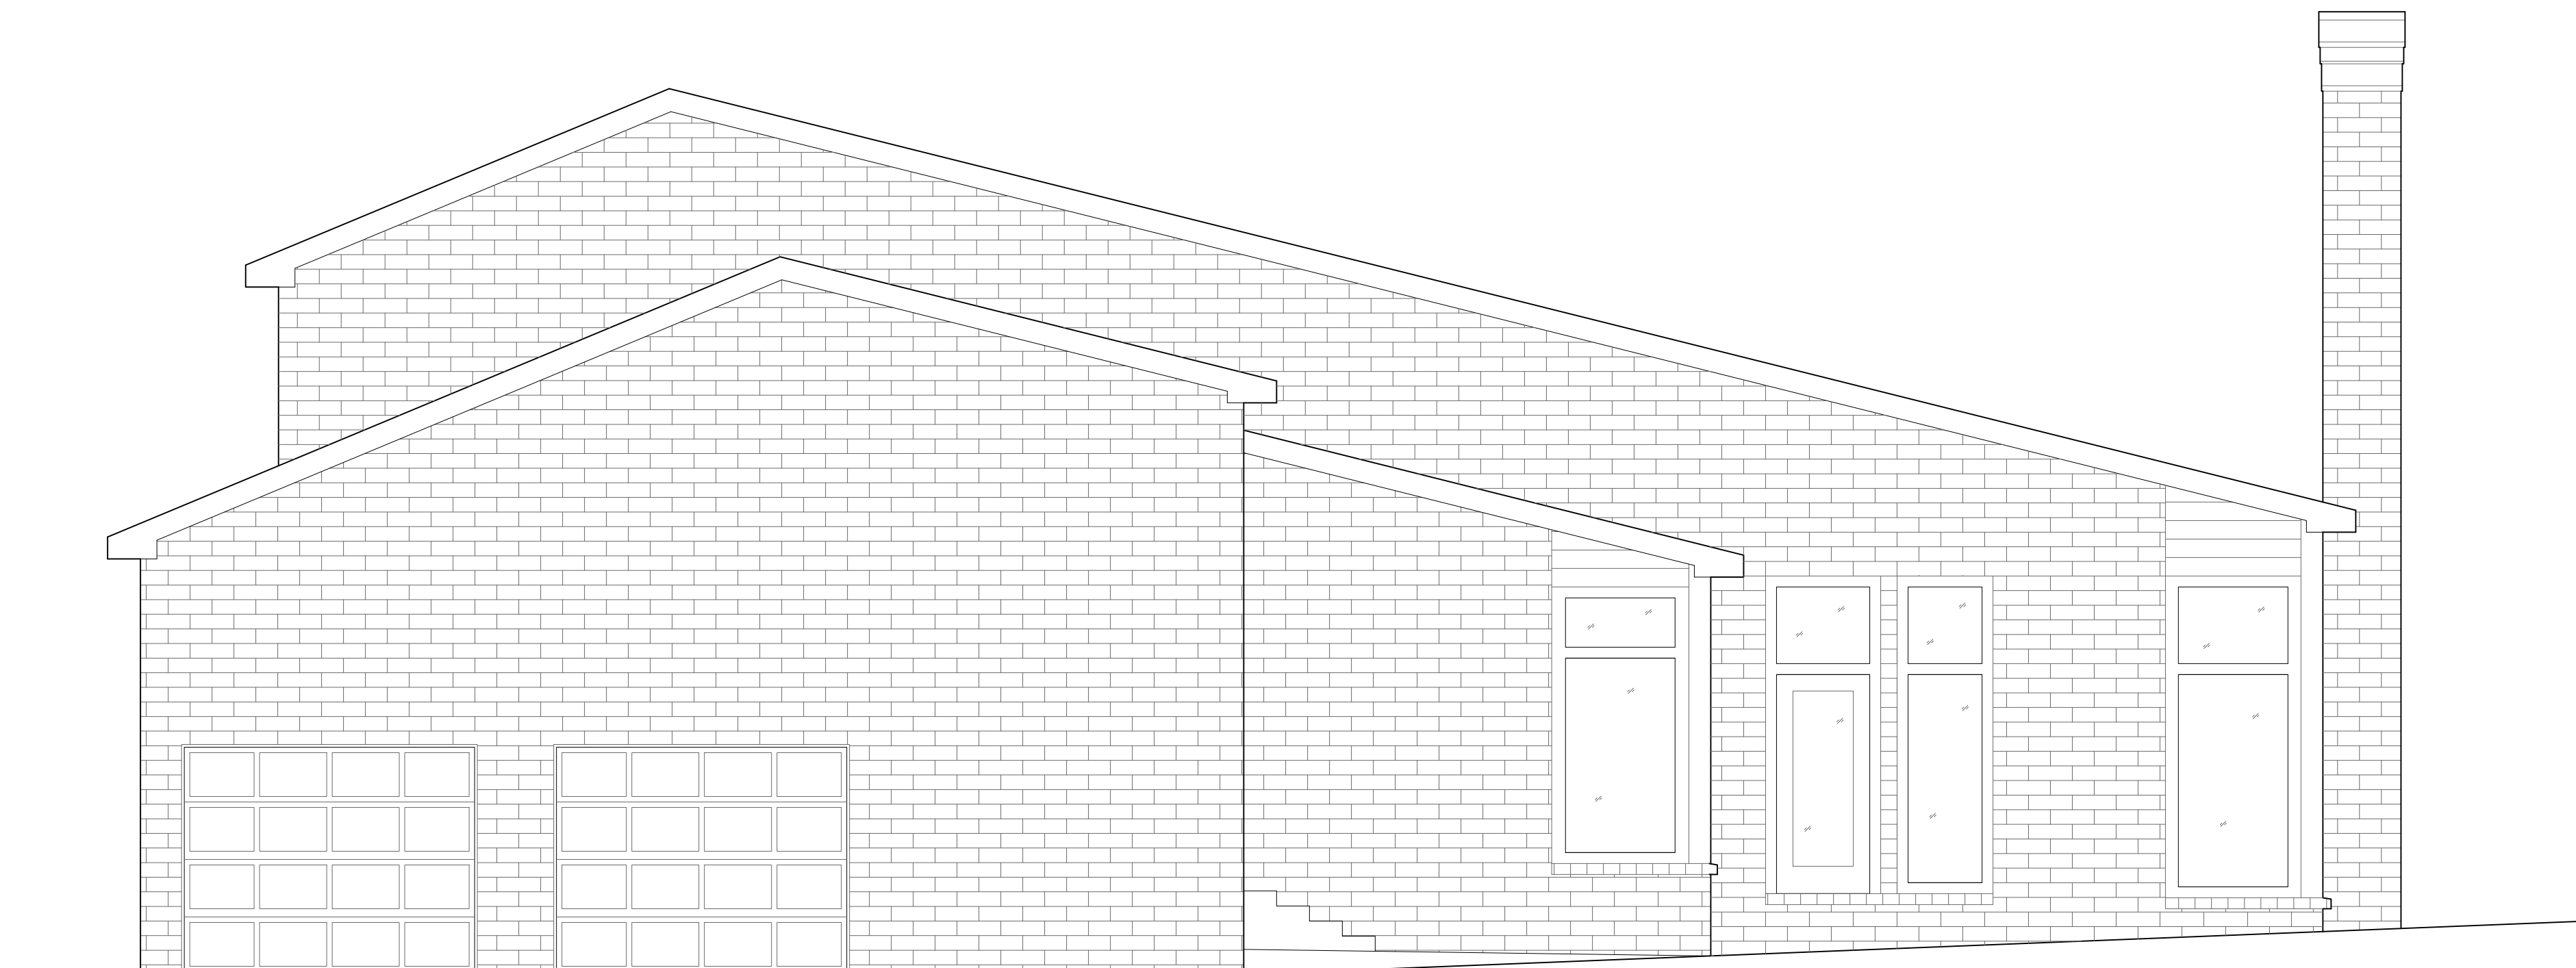

RIGHT ELEVATION

ARCHITECTURAL AS BUILT

Gallatin, TN

01	100% SUBMISSION	SEE COVER SHEET
NO.	ISSUES REVISIONS	DATE
		SHEET TITLE
ELEVATIONS		
HL	PROJECT MANAGER	
HL	PROJECT DIRECTOR	
012317-1	PROJECT NUMBER	
1/4"=1'-0"	SCALE	
CL	DRAWN BY	
		SHEET NUMBER
AB-4		