

AS-BUILT DOCUMENTATION


HIGHLAND PARK RESIDENCE



100% SUBMITTAL

DRAWING INDEX

- C-1 COVER SHEET | DRAWING INDEX
- SL SYMBOLS LEGEND
- AB-1 FIRST FLOOR PLAN
- AB-2 SECOND AND THIRD FLOOR PLAN
- AB-3 FIRST FLOOR RCP
- AB-4 SECOND AND THIRD FLOOR RCP
- AB-5 ROOF PLAN
- AB-6 ELEVATIONS
- AB-7 ELEVATIONS

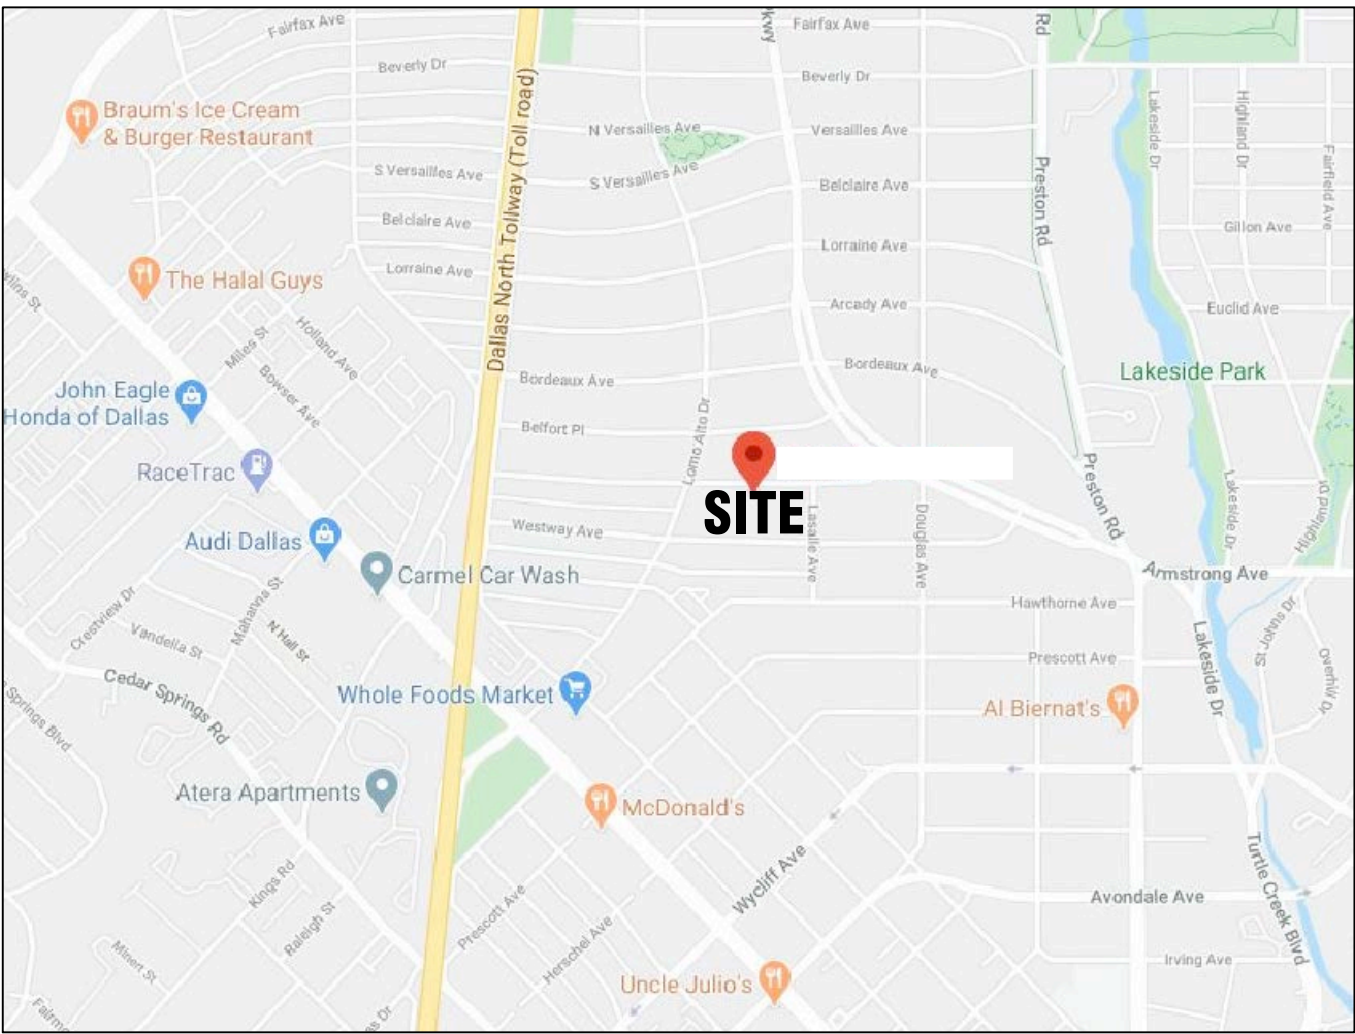

VICINITY MAP
NTS

AREA DATA	
FIRST FLOOR	2,751 S.F. ±
SECOND FLOOR	3,170 S.F. ±
THIRD FLOOR	1,013 S.F. ±
PATIO	646 S.F. ±
GARAGE PARKING	773 S.F. ±
GARAGE BASEMENT	773 S.F. ±
GARAGE SECOND FLOOR	773 S.F. ±
TOTAL HOUSE	7,580 S.F. ±
TOTAL GARAGE	2,319 S.F. ±
GRAND TOTAL	9,899 S.F. ±

AS BUILT

PROFESSIONALS

www.asbuiltprofessionals.com

A DIVISION OF:

AEC

CONSULTANTS INC

844.272.8458

844 A S B U I L T

© 2020 AEC CONSULTANTS INC

ARCHITECTURAL AS BUILT
HIGHLAND PARK RESIDENCE
DALLAS TX 75205

NO. ISSUES | REVISIONS DATE

SHEET TITLE

COVER

HL PROJECT MANAGER

HL PROJECT DIRECTOR

012317-1 PROJECT NUMBER

SCALE

MM DRAWN BY

SHEET NUMBER

C-1

SYMBOLS LEGEND

RCP

	EXHAUST VENT		TRACK LIGHT OR VANITY LIGHT
	CEILING MOUNTED LIGHT FIXTURE		WALL-MOUNTED LIGHT FIXTURE
	CEILING MOUNTED DIRECTIONAL LIGHT		EMERGENCY EXIT SIGN
	RECESSED CAN LIGHT		EMERGENCY EXIT LIGHT
	EYEBALL OR SMALL CAN LIGHT		EMERGENCY EXIT LIGHT W/ SIGN
	PENDANT LIGHT		LIGHTED STAIR SIGN
	INDIVIDUAL FLUOR. LAY-IN FIXTURE 4 BULB		FLOOD LIGHT
	INDIVIDUAL FLUOR. HANGING FIXTURE 2 BULB		PHOTO CELL
	INDIVIDUAL FLUOR. FLUSH MOUNT FIXTURE 4 BULB		CEILING FAN
	CAMERA		CEILING FAN W/ LIGHT KIT
	MOTION DET.	7-2-6 CEILING HEIGHT AND TRIM 1'-2" ABOVE FLOOR BELOW WITH 6" CROWN MOULDING. NOTE: ALL CEILINGS NOT LABELED ARE PLASTER. CEILINGS SHOWN WITH A GRID ARE LAY IN ACOUSTICAL TILE..	
	SUPPLY VENT		
	SUPPLY VENT		
	RETURN VENT		
	RETURN VENT		
	SPEAKER		JUNCTION BOX

ELECTRIC

	DATA OUTLET
	TELEPHONE/DATA
	ELECTRIC SWITCH
	CABLE TELEVISION OUTLET
	DUPLEX RECEPTACLE OUTLET
	SPECIAL PURPOSE CONNECTION OR OUTLET
	QUADRUPLEX RECEPTACLE OUTLET
	FLOOR DUPLEX RECEPTACLE OUTLET
	ELECTRIC PANEL
	ELECTRIC METER
	BUTTON SWITCH
	DISCONNECT SWITCH
	GROUND/FLOOR LIGHT
	KEY PAD
	RECESSED WALL MOUNTED FLOOR LIGHTING.
	BUTTON SWITCH

FIRE PROTECTION

	FIRE PULL
	FIRE ALARM (HORN/SRTOBE)
	SMOKE DETECTOR
	SMOKE ALARM SPEAKER
	SPRINKLER HEAD CEILING MOUNT
	SPRINKLER HEAD WALL MOUNT

MEP

	THERMOSTAT
	FLOOR DRAIN
	VALVE
	HOSE BIB
	WATER VALVE
	SUSPENDED GAS HEATER
	HVAC FLOOR VENT

MISC

	BOLLARD
	SPOT ELEVATION

7-2-6

CEILING HEIGHT AND TRIM 1'-2" ABOVE FLOOR BELOW WITH 6" CROWN MOULDING. NOTE: ALL CEILINGS NOT LABELED ARE PLASTER. CEILINGS SHOWN WITH A GRID ARE LAY IN ACOUSTICAL TILE..



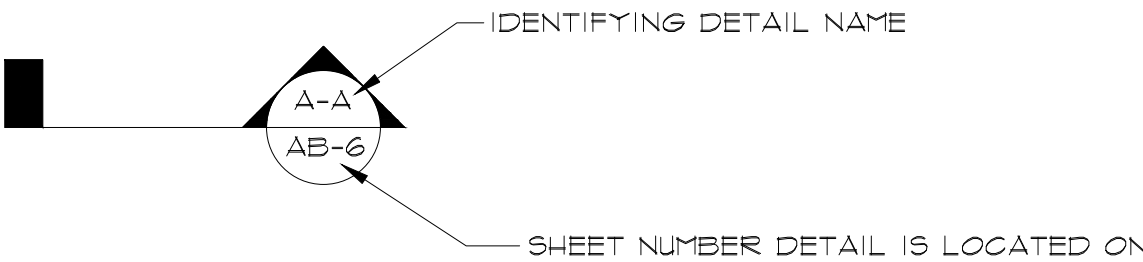


PHOTO DOCUMENTATION LEGEND

INDICATES LOCATION OF CAMERA

INDICATES DIRECTION OF CAMERA LENS
AND CORRESPONDING PHOTO / VIDEO
NUMBER

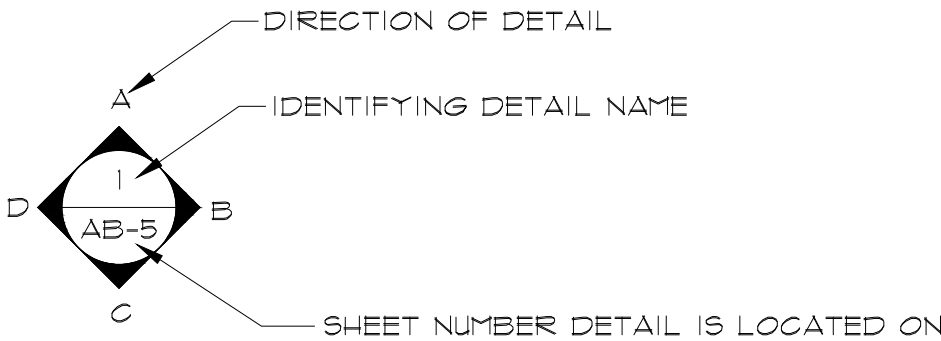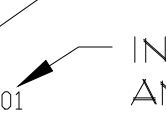

TYPES OF DOCUMENTATION



GROUND BASED PHOTO

GROUND BASED VIDEO

360° SPHERICAL PHOTO

AERIAL BASED PHOTO

AERIAL BASED VIDEO

As BUILT
PROFESSIONALS
www.asbuiltprofessionals.com
A DIVISION OF:

AEC
CONSULTANTS INC
844.272.8458
844 AS BUILT

© 2020 AEC CONSULTANTS INC

ARCHITECTURAL AS BUILT
HIGHLAND PARK RESIDENCE
DALLAS TX 75205


NO.	ISSUES REVISIONS	DATE
-----	--------------------	------

SYMBOLS


HL	PROJECT MANAGER
HL	PROJECT DIRECTOR
012317-1	PROJECT NUMBER
NOT TO SCALE	SCALE
MM	DRAWN BY
	SHEET NUMBER

SL


ARCHITECTURAL AS BUILT
HIGHLAND PARK RESIDENCE
DALLAS TX 75205

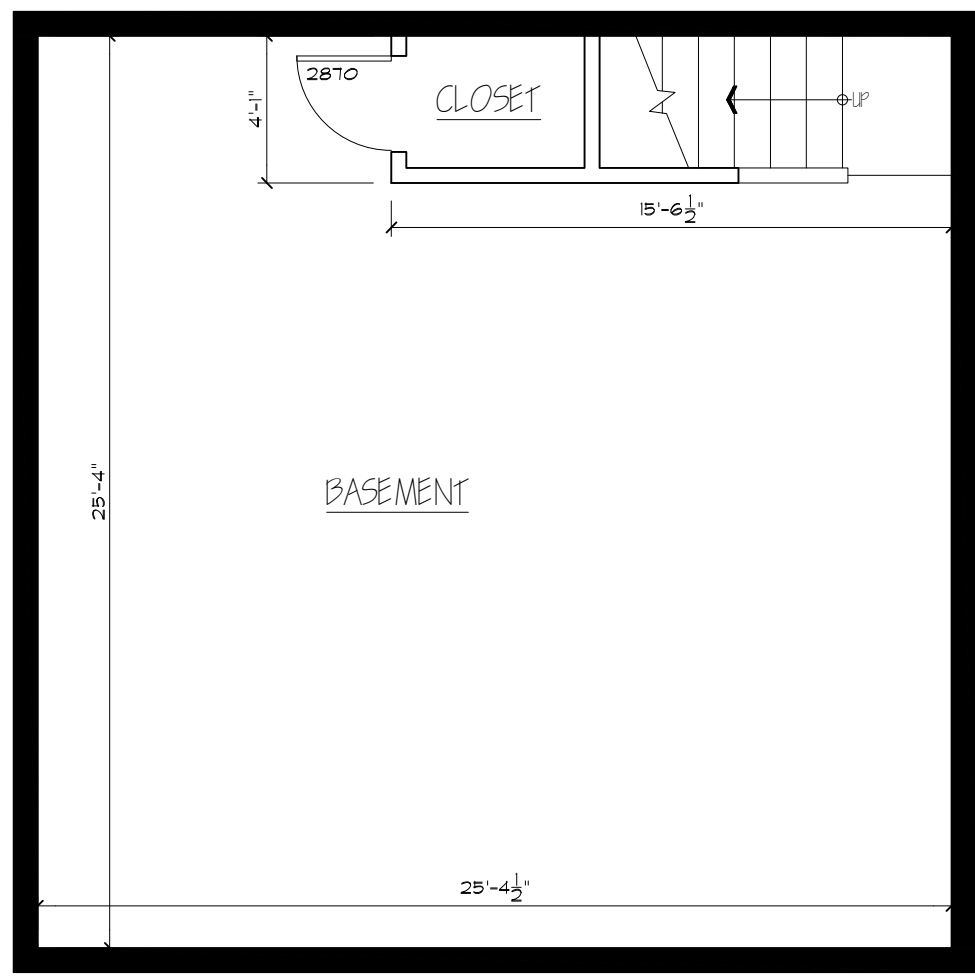

GARAGE BASEMENT

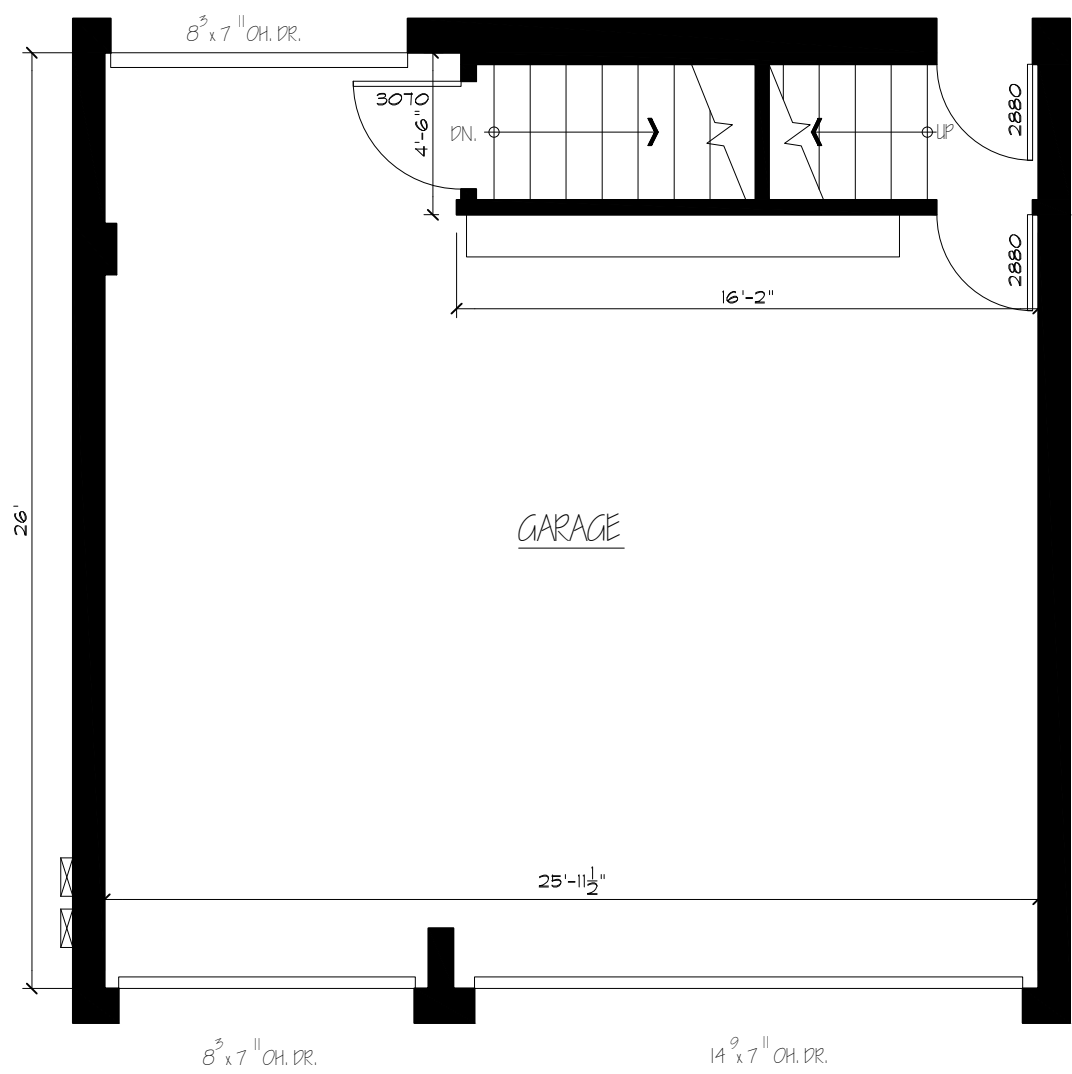

FIRST FLOOR PLAN

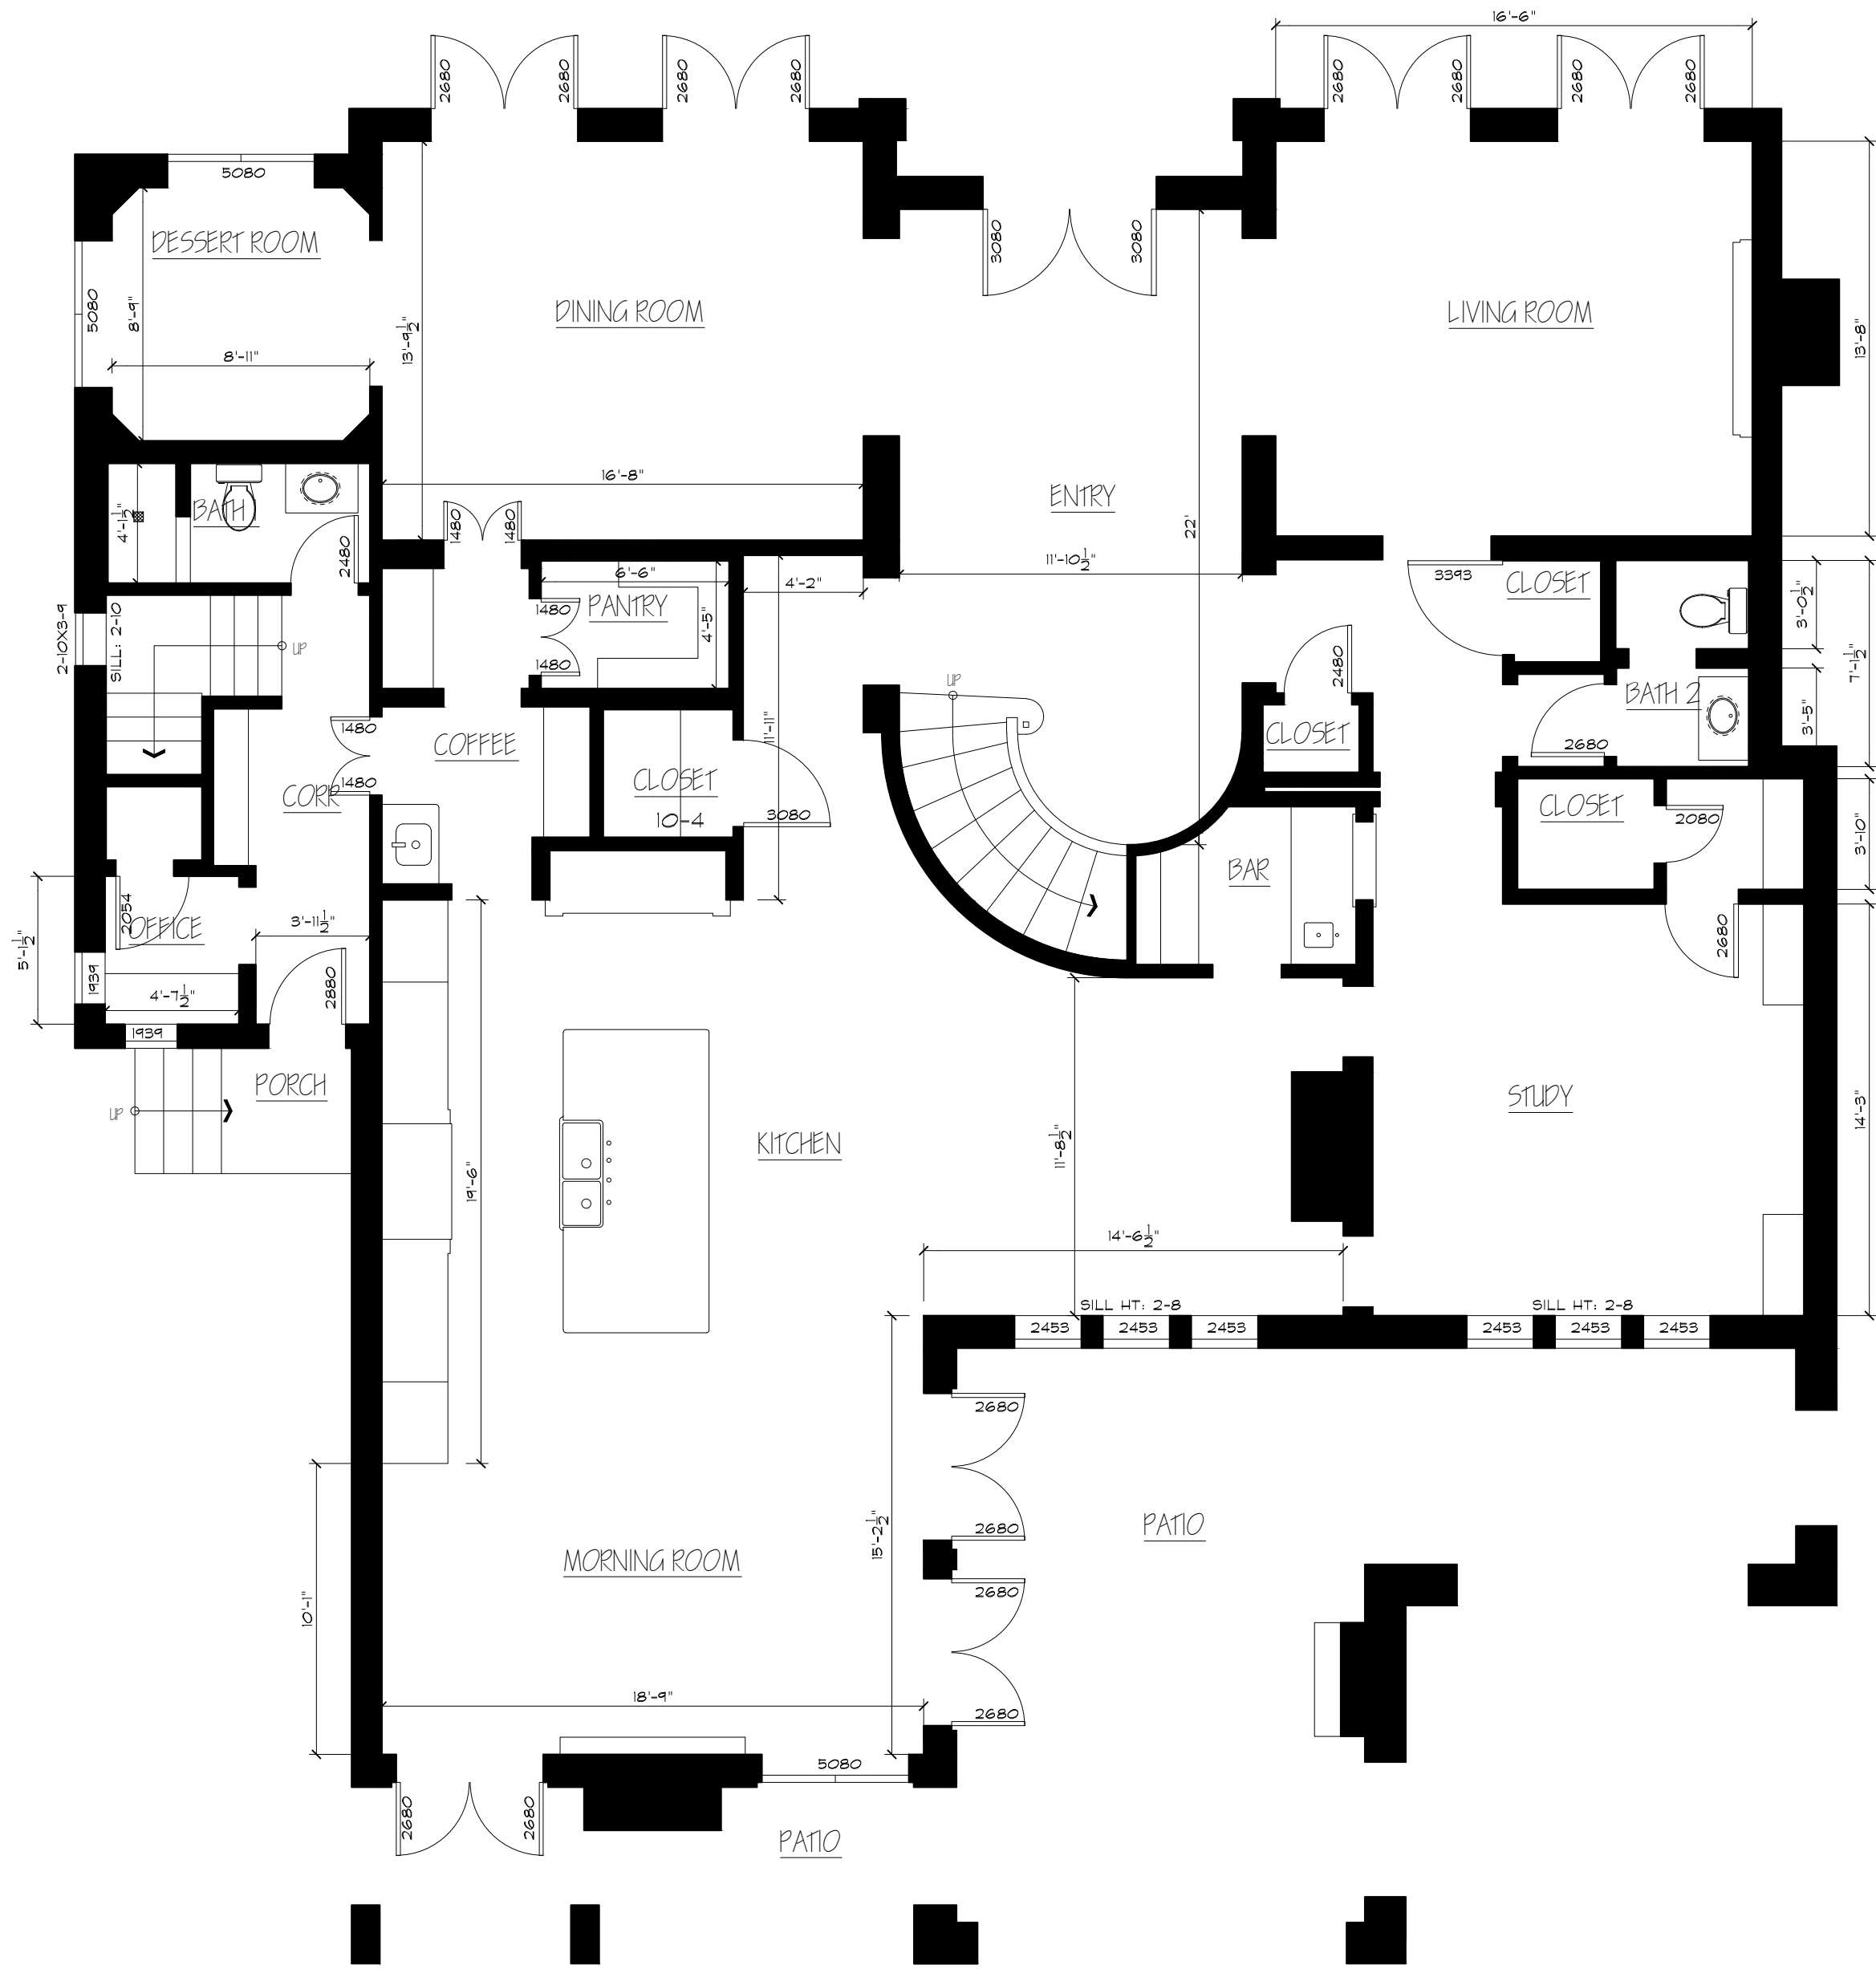

FINISH SCHEDULE				
ROOM NAME	FLOOR	WALLS	CEILING	NOTES
GARAGE	BARE CONC	PAINTED DRYWALL	PAINTED DRYWALL	
GARAGE BASEMENT	PAINTED CONC	PAINTED CONCRETE	PAINTED METAL	
KITCHEN/MORNING ROOM	STAINED WOOD	PAINTED DRYWALL	PAINTED DRYWALL	
STUDY	STAINED WOOD	PAINTED DRYWALL	PAINTED DRYWALL	
BATH 1	TILE	PAINTED DRYWALL	PAINTED DRYWALL	TILE WAINSCOT UP TO 36"
OFFICE	STAINED WOOD	WALL PAPER	WALL PAPER	
PANTRY	STAINED WOOD	PAINTED DRYWALL	PAINTED DRYWALL	
DINING ROOM	STAINED WOOD	PAINTED DRYWALL	PAINTED DRYWALL	TILE WAINSCOT UP TO 36"
DESSERT ROOM	STAINED WOOD	PAINTED DRYWALL	PAINTED DRYWALL	
ENTRY	TILE	PAINTED DRYWALL	PAINTED DRYWALL	
LIVING ROOM	STAINED WOOD	PAINTED DRYWALL	PAINTED DRYWALL	
BATH 2	STAINED WOOD	PAINTED DRYWALL	PAINTED DRYWALL	TILE WAINSCOT UP TO 36"

NO.

ISSUES | REVISIONS

DATE

SHEET TITLE

FIRST FLOOR
PLAN

HL

PROJECT MANAGER

HL

PROJECT DIRECTOR

012317-1

PROJECT NUMBER

3/16"=1'-0"

SCALE

MM

DRAWN BY

SHEET NUMBER

AB-1



DALLAS TX 75205

SHEET NUMBER36







ARCHITECTURAL AS BUILT
HIGHLAND PARK RESIDENCE
DALLAS TX 75205

SECOND AND THIRD FLOOR RCP

HL	PROJECT MANAGER
HL	PROJECT DIRECTOR
012317-1	PROJECT NUMBER
3/16"=1'-0"	SCALE
MM	DRAWN BY
	SHEET NUMBER

 AB-4

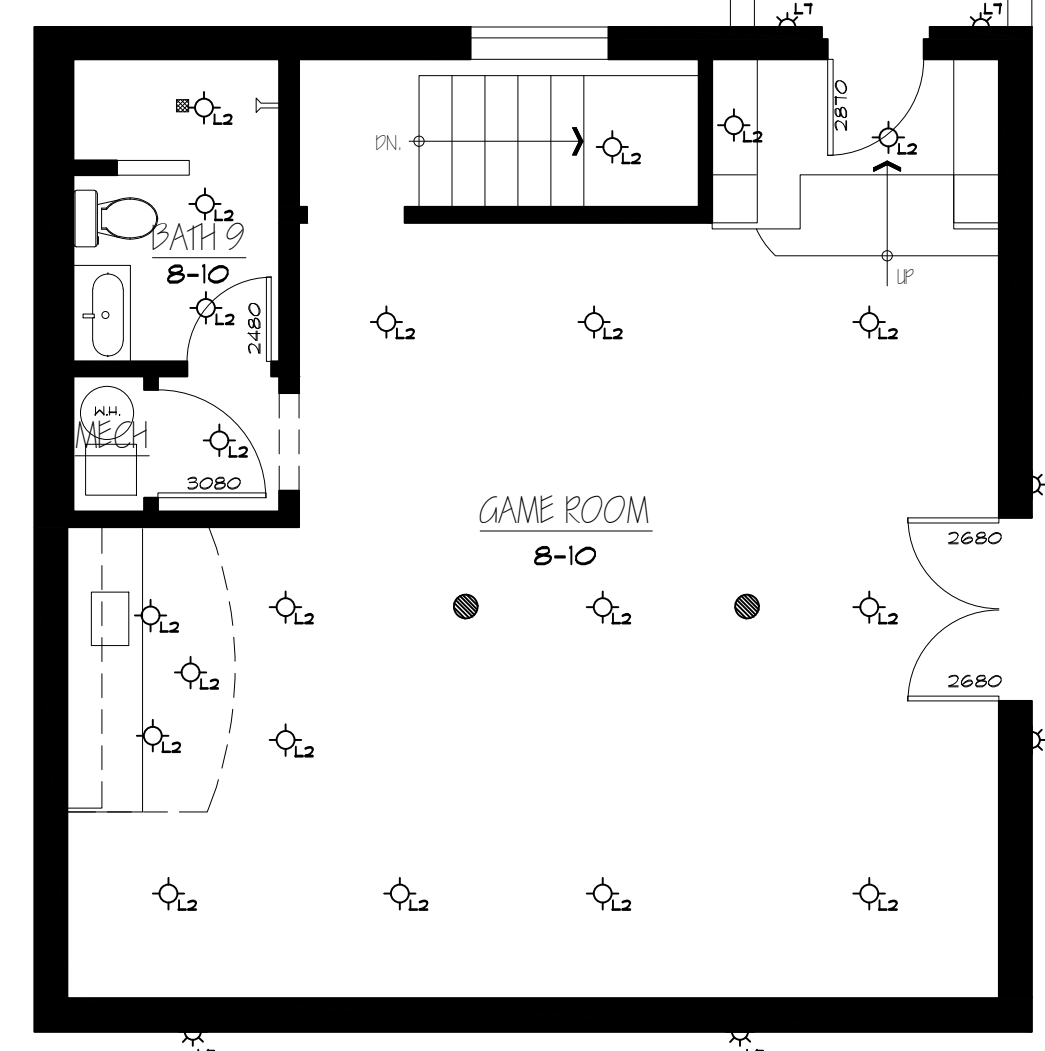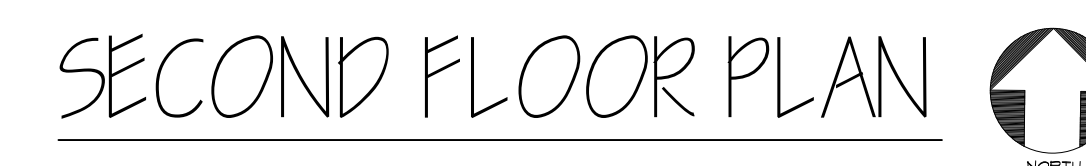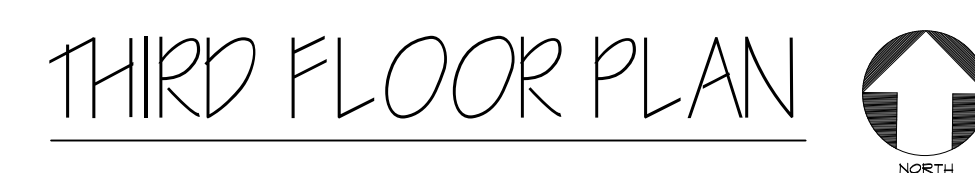



ROOF PLAN



DALLAS TX 75205

NO.	ISSUES REVISIONS	DATE
		SHEET TITLE
ROOF PLAN		
HL		PROJECT MANAGER
HL		PROJECT DIRECTOR
012317-1		PROJECT NUMBER
3/16"=1'-0"		SCALE
MM		DRAWN BY
		SHEET NUMBER
AB-5		



This is a detailed architectural line drawing of a two-story building facade. The structure is constructed from stone, with a central entrance featuring a double door under a semi-circular arch. To the left of the entrance is a large arched window, and to the right is a smaller arched window. Above the central entrance is a balcony with a decorative railing. The roof is gabled with a central dormer window. The drawing includes various architectural details such as cornices, moldings, and a small balcony on the left side. The overall style is that of a traditional architectural sketch.



AS BUILT
PROFESSIONALS

www.asbuiltprofessionals.com

A DIVISION OF:



AEC

CONSULTANTS INC

844.272.8458
844 AS BUILT

© 2020 AEC CONSULTANTS INC

**ARCHITECTURAL AS BUILT
HIGHLAND PARK RESIDENCE
DALLAS TX 75205**

[illegible]

AB-6

