

SL

100% SUBMISSION	SEE COVER SHEET
ISSUES REVISIONS	DATE

AB-1





01	100% SUBMISSION	SEE COVER SHEET
NO.	ISSUES REVISIONS	DATE
		SHEET TITLE
SECOND FLOOR & BASEMENT PLAN		
HL		PROJECT MANAGER
HL		PROJECT DIRECTOR
012317-1		PROJECT NUMBER
1/4"=1'-0"		SCALE
CL		DRAWN BY
		SHEET NUMBER
AB-2		





FRONT



LEFT

As BUILT

PROFESSIONALS

www.asbuiltprofessionals.com

A DIVISION OF:

AEC

CONSULTANTS INC

844.272.8458

844 A S B U I L T

© 2019 AEC CONSULTANTS INC


ARCHITECTURAL AS BUILT

Nashville, TN 37205

01	100% SUBMISSION	SEE COVER SHEET
NO.	ISSUES REVISIONS	DATE
SHEET TITLE		
EXTERIOR ELEVATIONS		
HL		PROJECT MANAGER
HL		PROJECT DIRECTOR
012317-1		PROJECT NUMBER
1/4"=1'-0"		SCALE
CL		DRAWN BY
SHEET NUMBER		
AB-3		



BACK

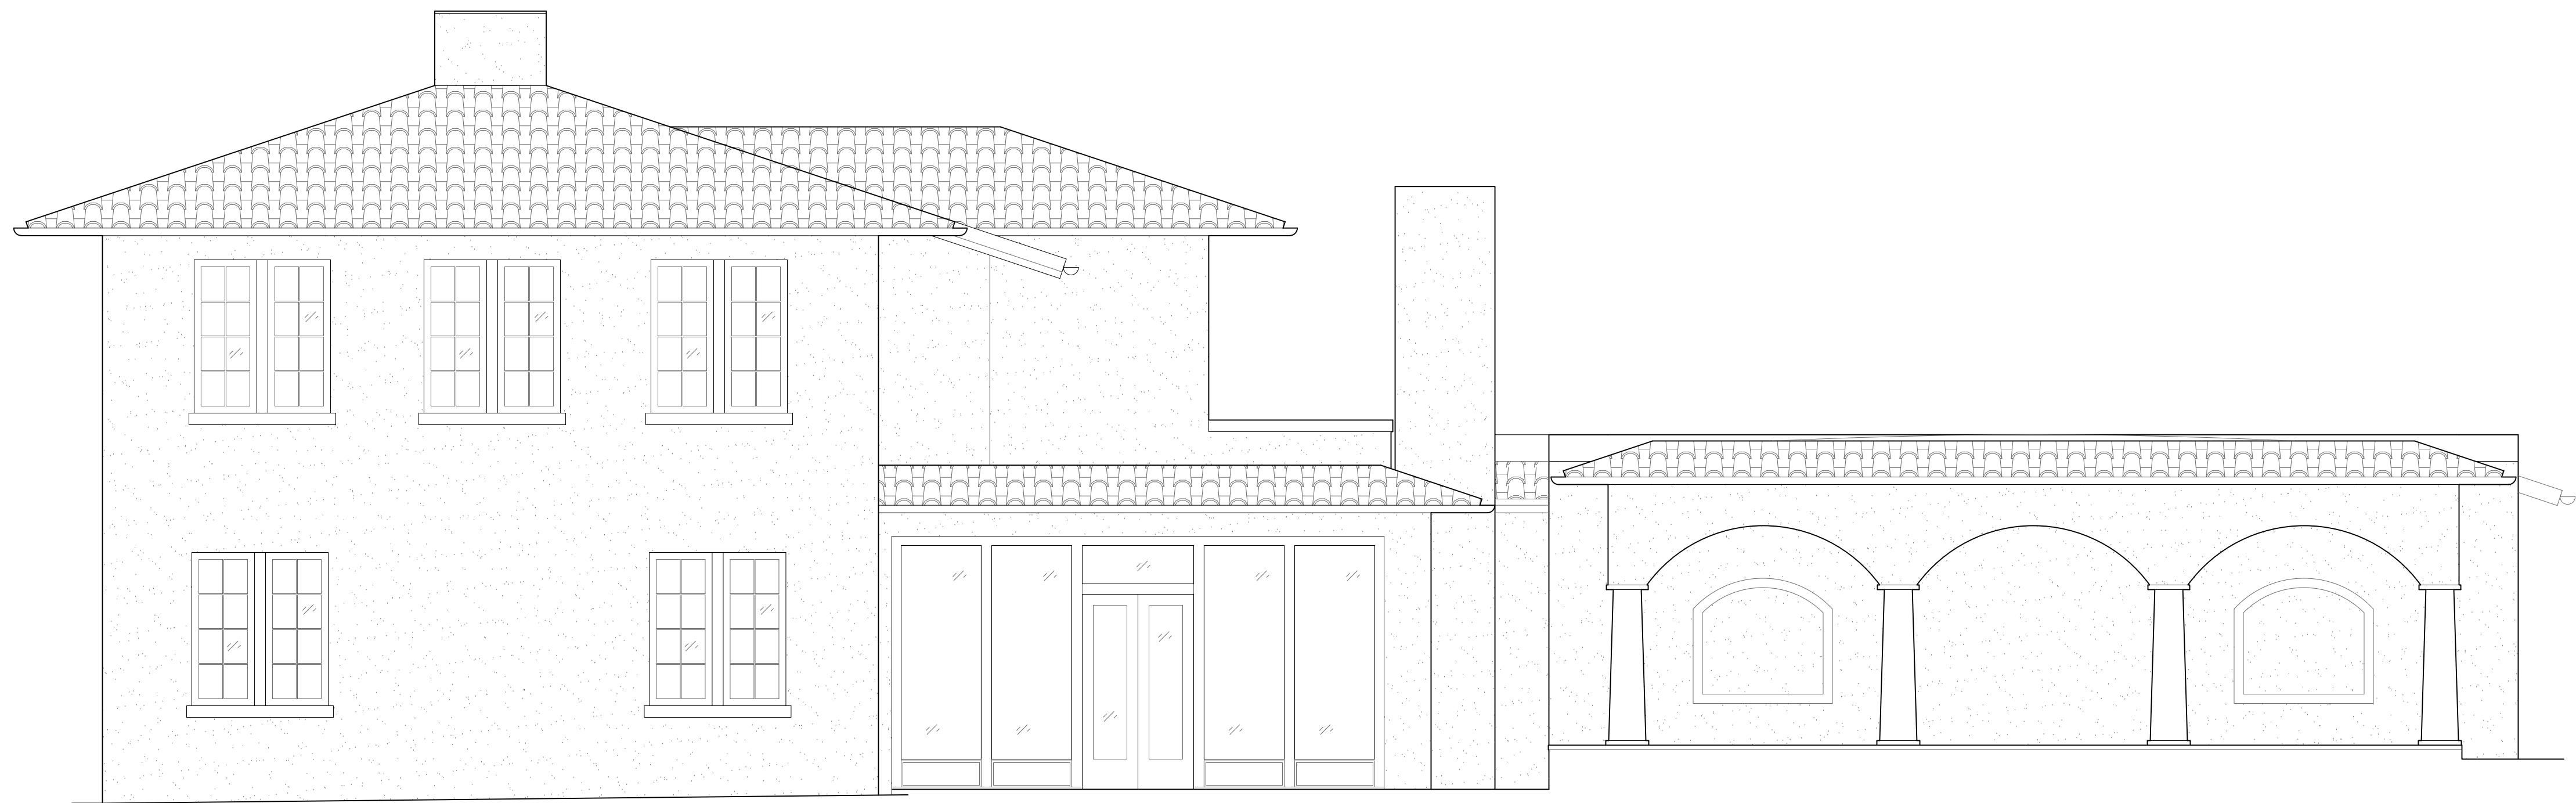

RIGHT

ARCHITECTURAL AS BUILT

Nashville, TN 37205

01	100% SUBMISSION	SEE COVER SHEET
NO.	ISSUES REVISIONS	DATE
		SHEET TITLE
EXTERIOR ELEVATIONS		
HL		PROJECT MANAGER
HL		PROJECT DIRECTOR
012317-1		PROJECT NUMBER
1/4"=1'-0"		SCALE
CL		DRAWN BY
		SHEET NUMBER
AB-4		