

AS-BUILT DOCUMENTATION



SEATTLE, WA 98105



100% SUBMITTAL

DRAWING INDEX

C-1	COVER SHEET DRAWING INDEX
SL	SYMBOLS LEGEND
AB-1	BASEMENT FLOOR PLAN AND RCP
AB-2	FIRST FLOOR PLAN AND RCP

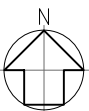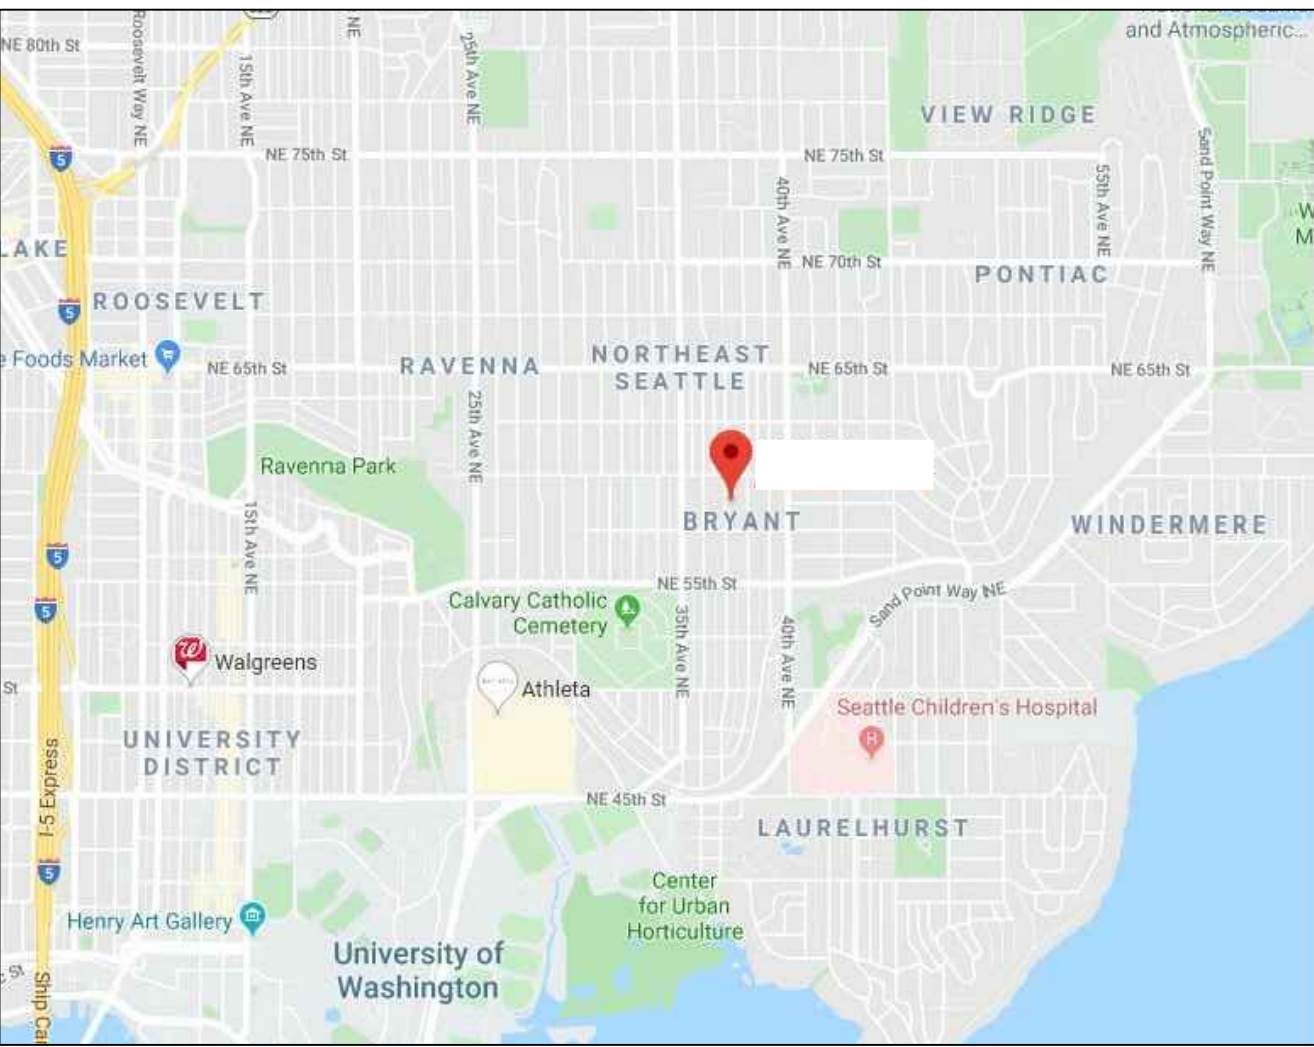

VICINITY MAP

NTS

<u>AREA DATA</u>	
BASEMENT	1,640 S.F. ±
FIRST FLOOR	1,680 S.F. ±
GRAND TOTAL	3,320 S.F. ±



AS BUILT
PROFESSIONALS

www.asbuiltprofessionals.com

A DIVISION OF:



AEC

CONSULTANTS INC

844.272.8458
844 AS BUILT


© 2017 AEC CONSULTANTS INC

ARCHITECTURAL AS BUILT

SEATTLE, WA 98105

01	100% SUBMISSION	
NO.	ISSUES REVISIONS	DATE
		SHEET TITLE
COVER SHEET		
HL		PROJECT MANAGER
HL		PROJECT DIRECTOR
?		PROJECT NUMBER
		SCALE
MM		DRAWN BY
		SHEET NUMBER


C-1

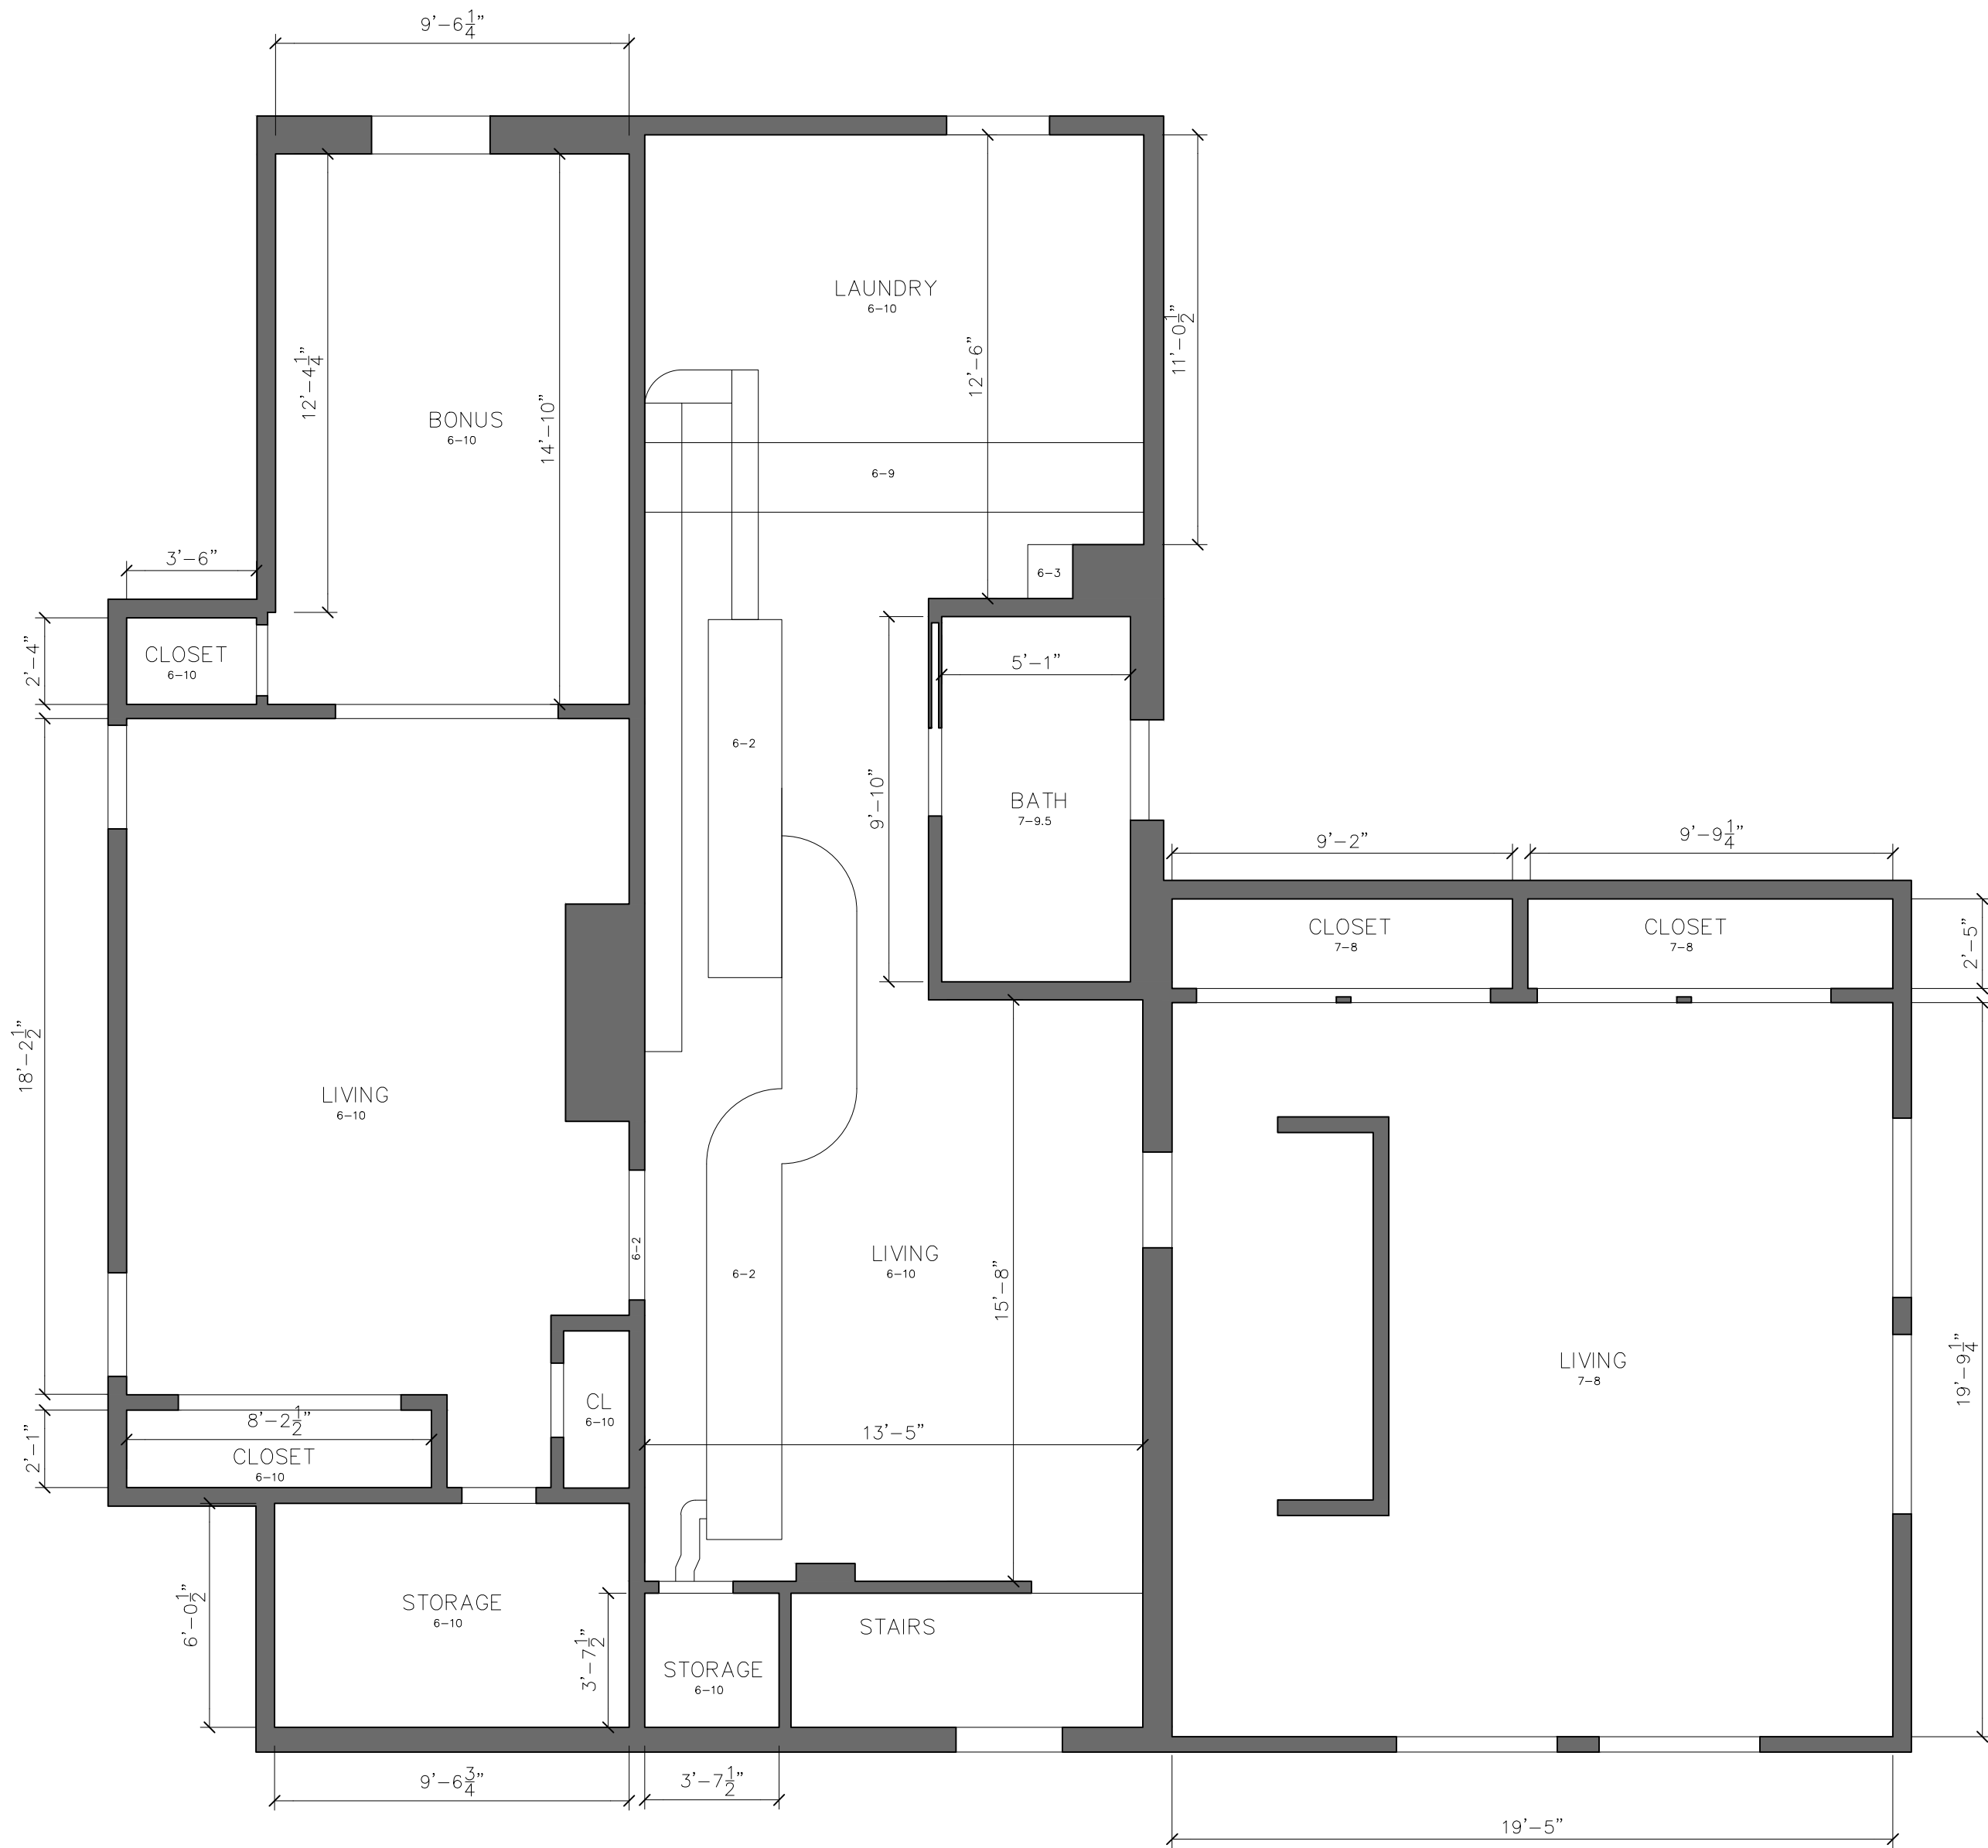

BASEMENT – RCP



BASEMENT – PLAN

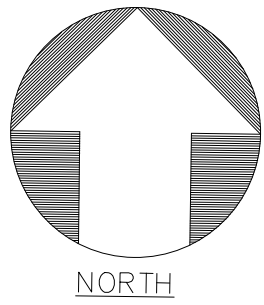

AS BUILT

PROFESSIONALS

www.asbuiltprofessionals.com

A DIVISION OF:

AEC

CONSULTANTS INC

844.272.8458

844 AS BUILT

© 2017 AEC CONSULTANTS INC

ARCHITECTURAL AS BUILT

SEATTLE, WA 98105

01	100% SUBMISSION	
NO.	ISSUES REVISIONS	DATE
HL	PROJECT MANAGER	
HL	PROJECT DIRECTOR	
?	PROJECT NUMBER	
1/4"=1'-0"	SCALE	
MM	DRAWN BY	
	SHEET NUMBER	

BASEMENT

FLOOR PLAN &

RCP

AB-1



SEATTLE, WA 98105

SHEET TITLE

HL	PROJECT MANAGER
HL	PROJECT DIRECTOR
?	PROJECT NUMBER
1/4"=1'-0"	SCALE
MM	DRAWN BY
	SHEET NUMBER

AB-2

