

# AS-BUILT DOCUMENTATION


## Winchester, TN 37398



**100% SUBMITTAL**

### DRAWING INDEX

- C-1 COVER SHEET | DRAWING INDEX
- SL SYMBOLS LEGEND
- AB-1 FIRST FLOOR PLAN
- AB-2 SECOND FLOOR & BASEMENT PLAN
- AB-3 ROOF PLAN
- AB-4 EXTERIOR ELEVATIONS
- AB-5 EXTERIOR ELEVATIONS

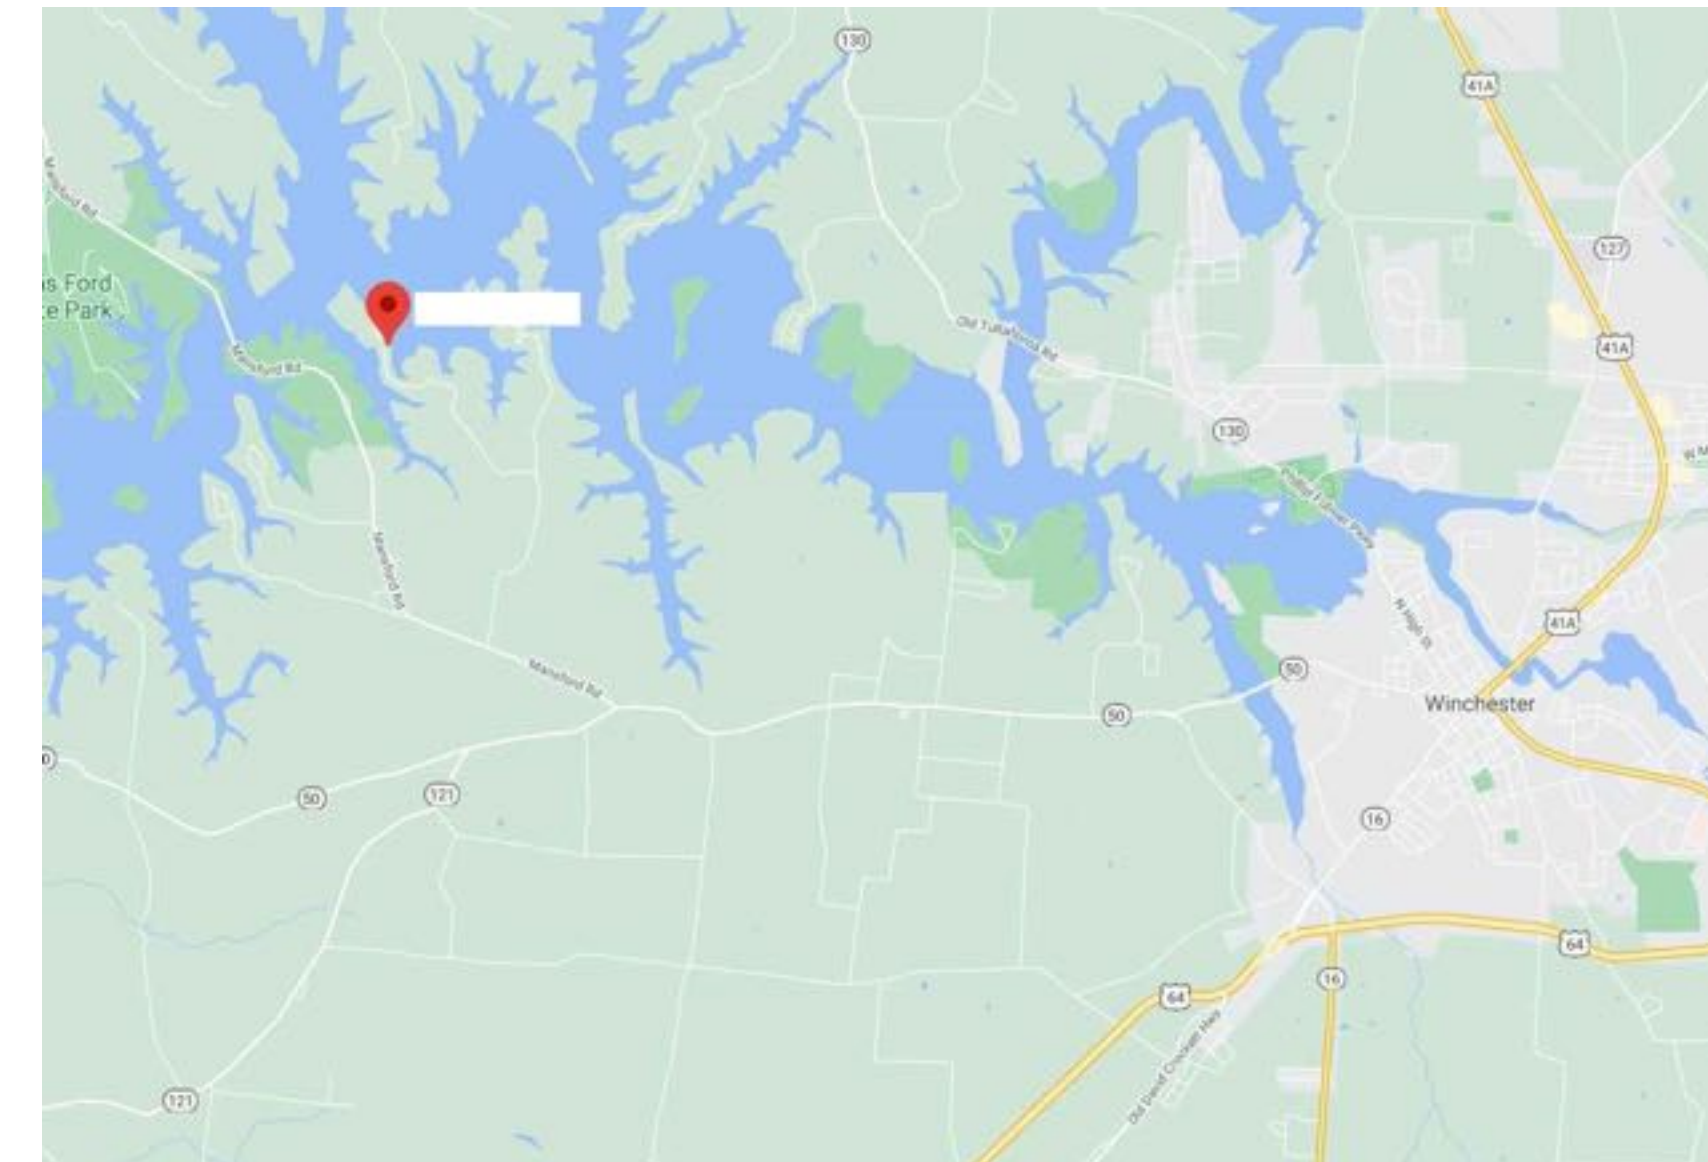

VICINITY MAP  
NTS

AREA DATA	
BASEMENT FLOOR	644 SQ. FT. ±
FIRST FLOOR	2341 SQ. FT. ±
SECOND FLOOR	597 SQ. FT. ±
GARAGE	584 SQ. FT. ±
GARAGE SECOND FLOOR	386 SQ. FT. ±
GRAND TOTAL	4552 SQ. FT. ±

**AS BUILT PROFESSIONALS**  
www.asbuiltprofessionals.com  
A DIVISION OF:

**AEC CONSULTANTS INC**

844.272.8458  
844 A S B U I L T

© 2020 AEC CONSULTANTS INC

**ARCHITECTURAL AS BUILT  
Winchester, TN 37398**

01	100% SUBMISSION	SEE COVER SHEET
NO.	ISSUES   REVISIONS	DATE

SHEET TITLE

**COVER**

HL	PROJECT MANAGER
HL	PROJECT DIRECTOR
012317-1	PROJECT NUMBER
	SCALE
CL	DRAWN BY
	SHEET NUMBER

**C1**

# SYMBOLS LEGEND

## RCP

- EXHAUST VENT
- CEILING MOUNTED LIGHT FIXTURE
- CEILING MOUNTED DIRECTIONAL LIGHT
- RECESSED CAN LIGHT
- EYEBALL OR SMALL CAN LIGHT
- PENDANT LIGHT
- INDIVIDUAL FLUOR. LAY-IN FIXTURE 4 BULB
- INDIVIDUAL FLUOR. HANGING FIXTURE 2 BULB
- INDIVIDUAL FLUOR. FLUSH MOUNT FIXTURE 4 BULB
- CAMERA
- MOTION DET.
- SUPPLY VENT
- SUPPLY VENT
- RETURN VENT
- RETURN VENT
- SPEAKER
- TRACK LIGHT OR VANITY LIGHT
- WALL-MOUNTED LIGHT FIXTURE
- EMERGENCY EXIT SIGN
- EMERGENCY EXIT LIGHT
- EMERGENCY EXIT LIGHT W/ SIGN
- LIGHTED STAIR SIGN
- FLOOD LIGHT
- PHOTO CELL
- CEILING FAN
- CEILING FAN W/ LIGHT KIT
- JUNCTION BOX

**7-2-6**  
 CEILING HEIGHT AND TRIM 7'-2" ABOVE FLOOR BELOW WITH 6" CROWN MOULDING. NOTE: ALL CEILINGS NOT LABELED ARE PLASTER. CEILINGS SHOWN WITH A GRID ARE LAY IN ACOUSTICAL TILE..

## ELECTRIC

- DATA OUTLET
- TELEPHONE JACK
- ELECTRIC SWITCH
- CABLE TELEVISION OUTLET
- DUPLEX RECEPTACLE OUTLET
- SPECIAL PURPOSE CONNECTION OR OUTLET
- QUADRUPLX RECEPTACLE OUTLET
- FLOOR DUPLEX RECEPTACLE OUTLET
- ELECTRIC PANEL
- ELECTRIC METER
- BUTTON SWITCH
- DISCONNECT SWITCH
- GROUND/FLOOR LIGHT
- KEY PAD

## FIRE PROTECTION




- FIRE EXTINGUISHER
- FIRE PULL
- FIRE ALARM (HORN/SRTOBE)
- SMOKE DETECTOR
- SMOKE ALARM SPEAKER
- SPRINKLER HEAD CEILING MOUNT
- SPRINKLER HEAD WALL MOUNT

## MEP

- THERMOSTAT
- FLOOR DRAIN
- VALVE
- HOSE BIB
- WATER SUPPLY
- SUSPENDED GAS HEATER

## MISC

- BOLLARD
- 11-4-11/16 SPOT ELEVATION

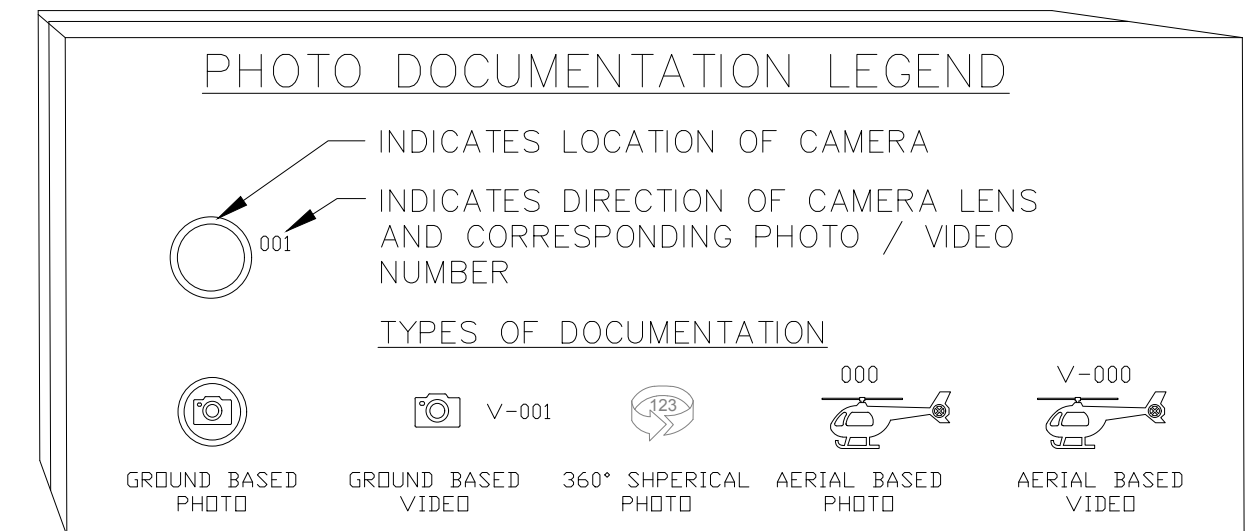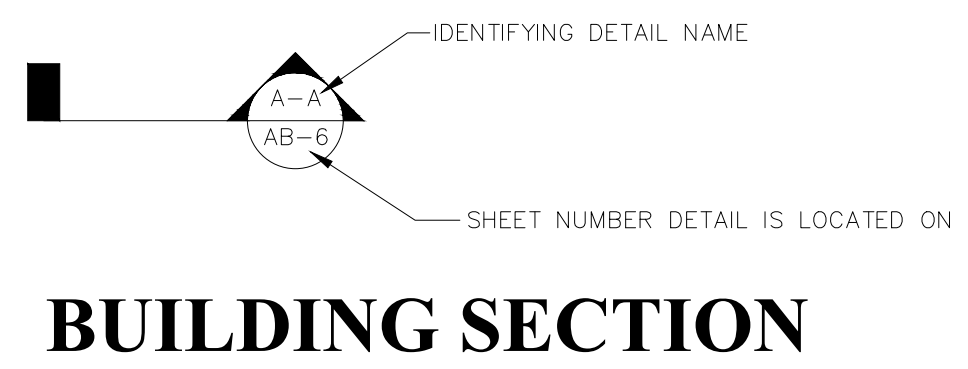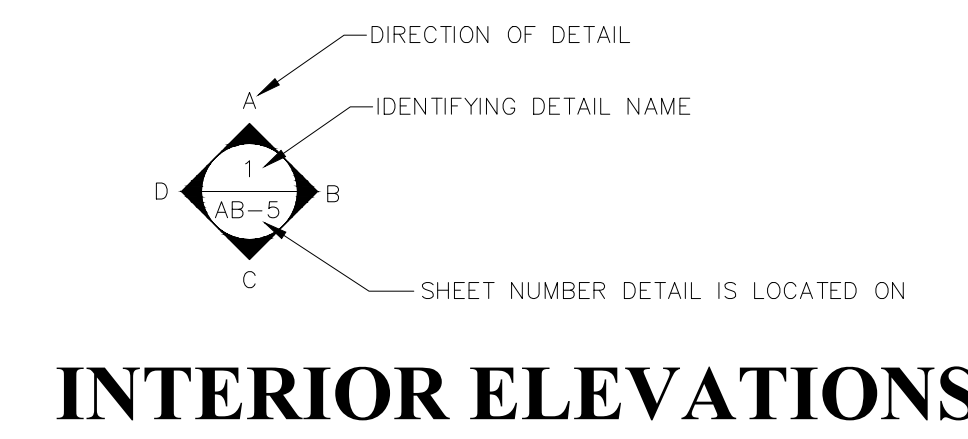


**ARCHITECTURAL AS BUILT**

**Winchester, TN 37398**

01	100% SUBMISSION	SEE COVER SHEET
NO.	ISSUES   REVISIONS	DATE

PROJECT TITLE	
HL	PROJECT MANAGER
HL	PROJECT DIRECTOR
012317-1	PROJECT NUMBER
	SCALE
CL	DRAWN BY
	SHEET NUMBER

**SL**

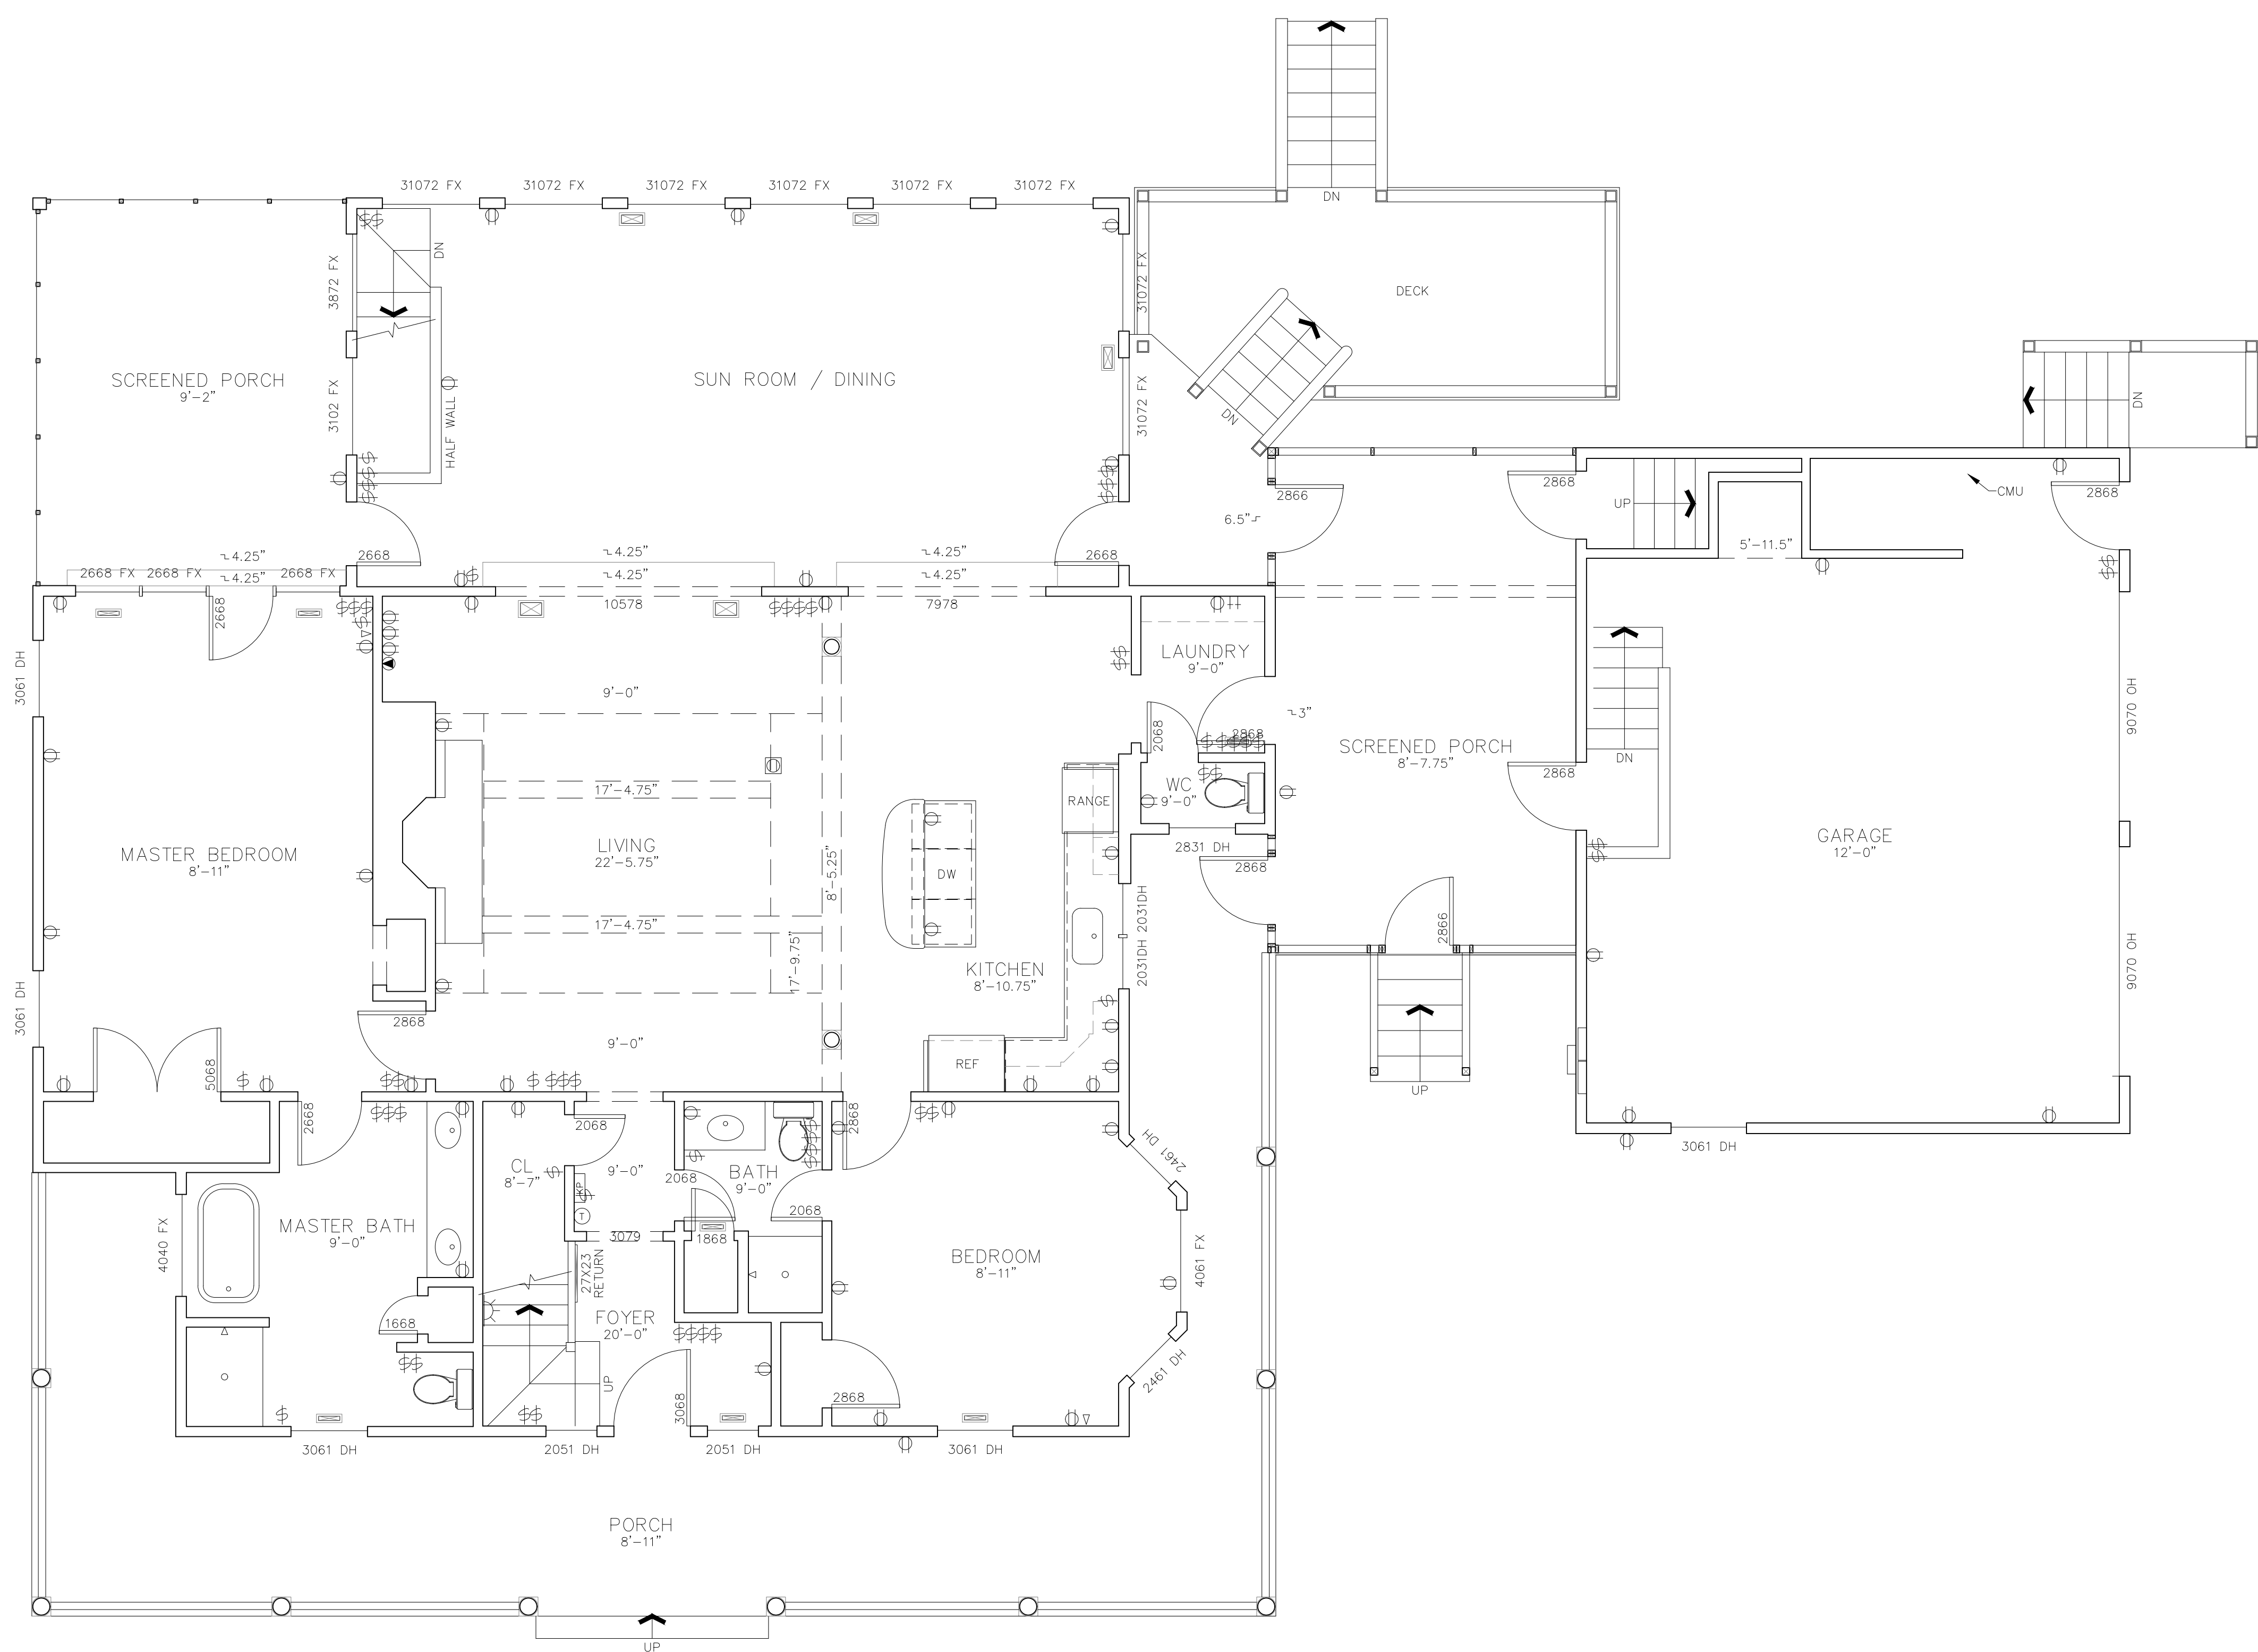


**ARCHITECTURAL AS BUILT**  
**Winchester, TN 37398**


01	100% SUBMISSION	SEE COVER SHEET
NO.	ISSUES   REVISIONS	DATE

SHEET TITLE  
**FIRST FLOOR PLAN**


HL	PROJECT MANAGER
HL	PROJECT DIRECTOR
012317-1	PROJECT NUMBER
<b>1/4"=1'-0"</b>	SCALE
CL	DRAWN BY
	SHEET NUMBER

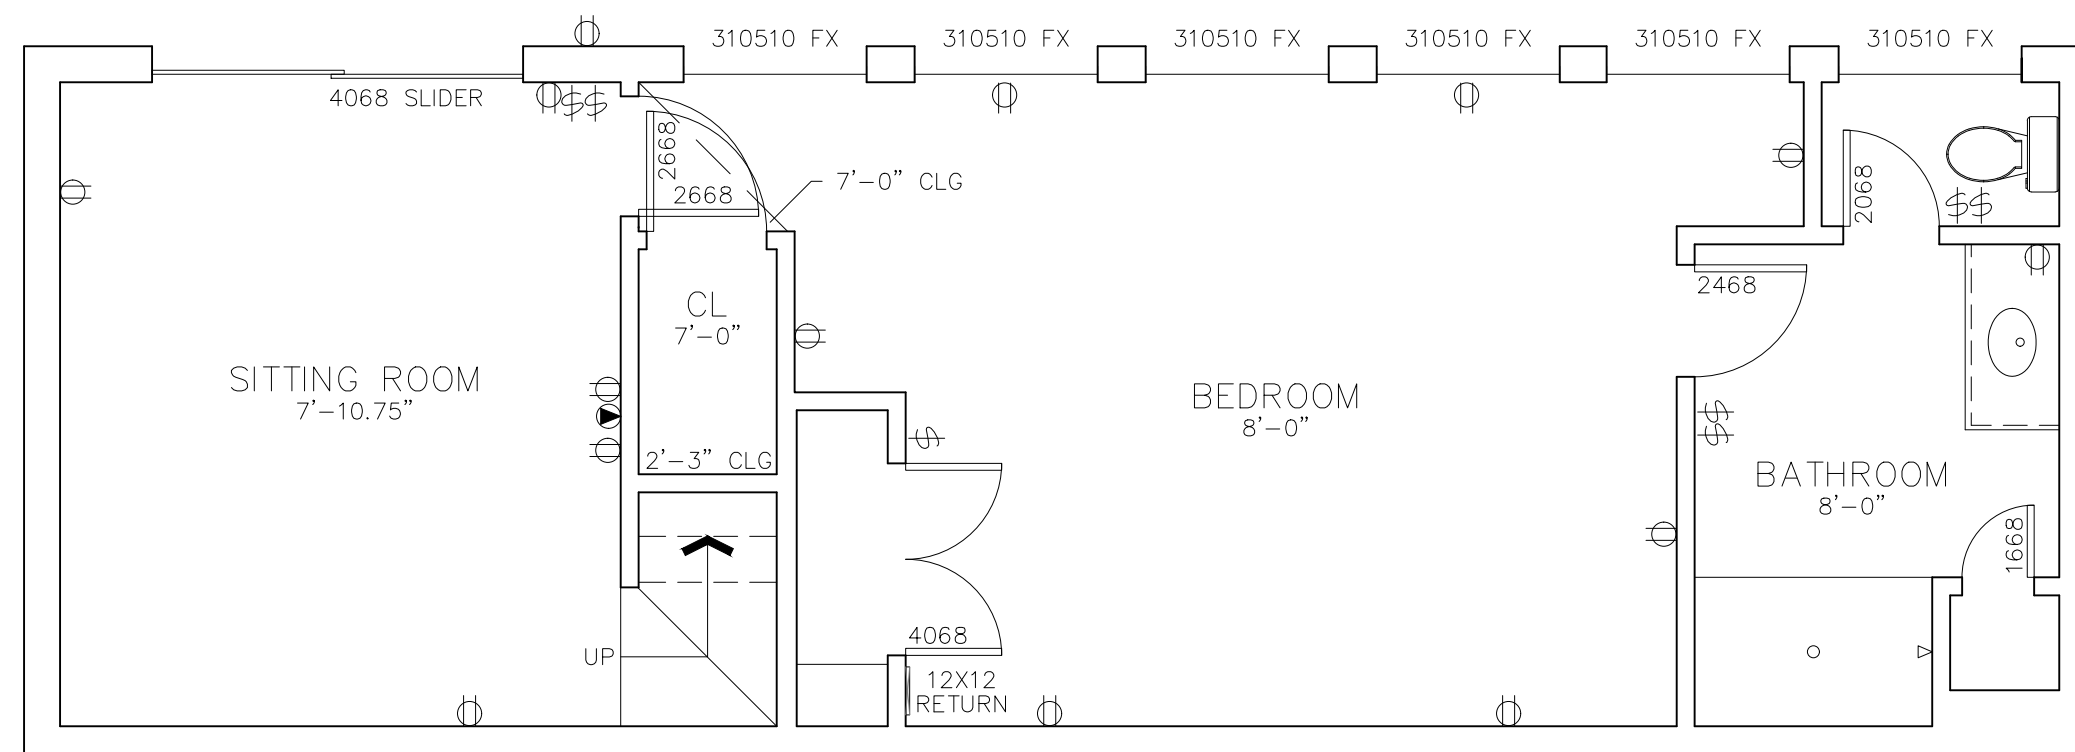

 **BASMENT FLOOR**

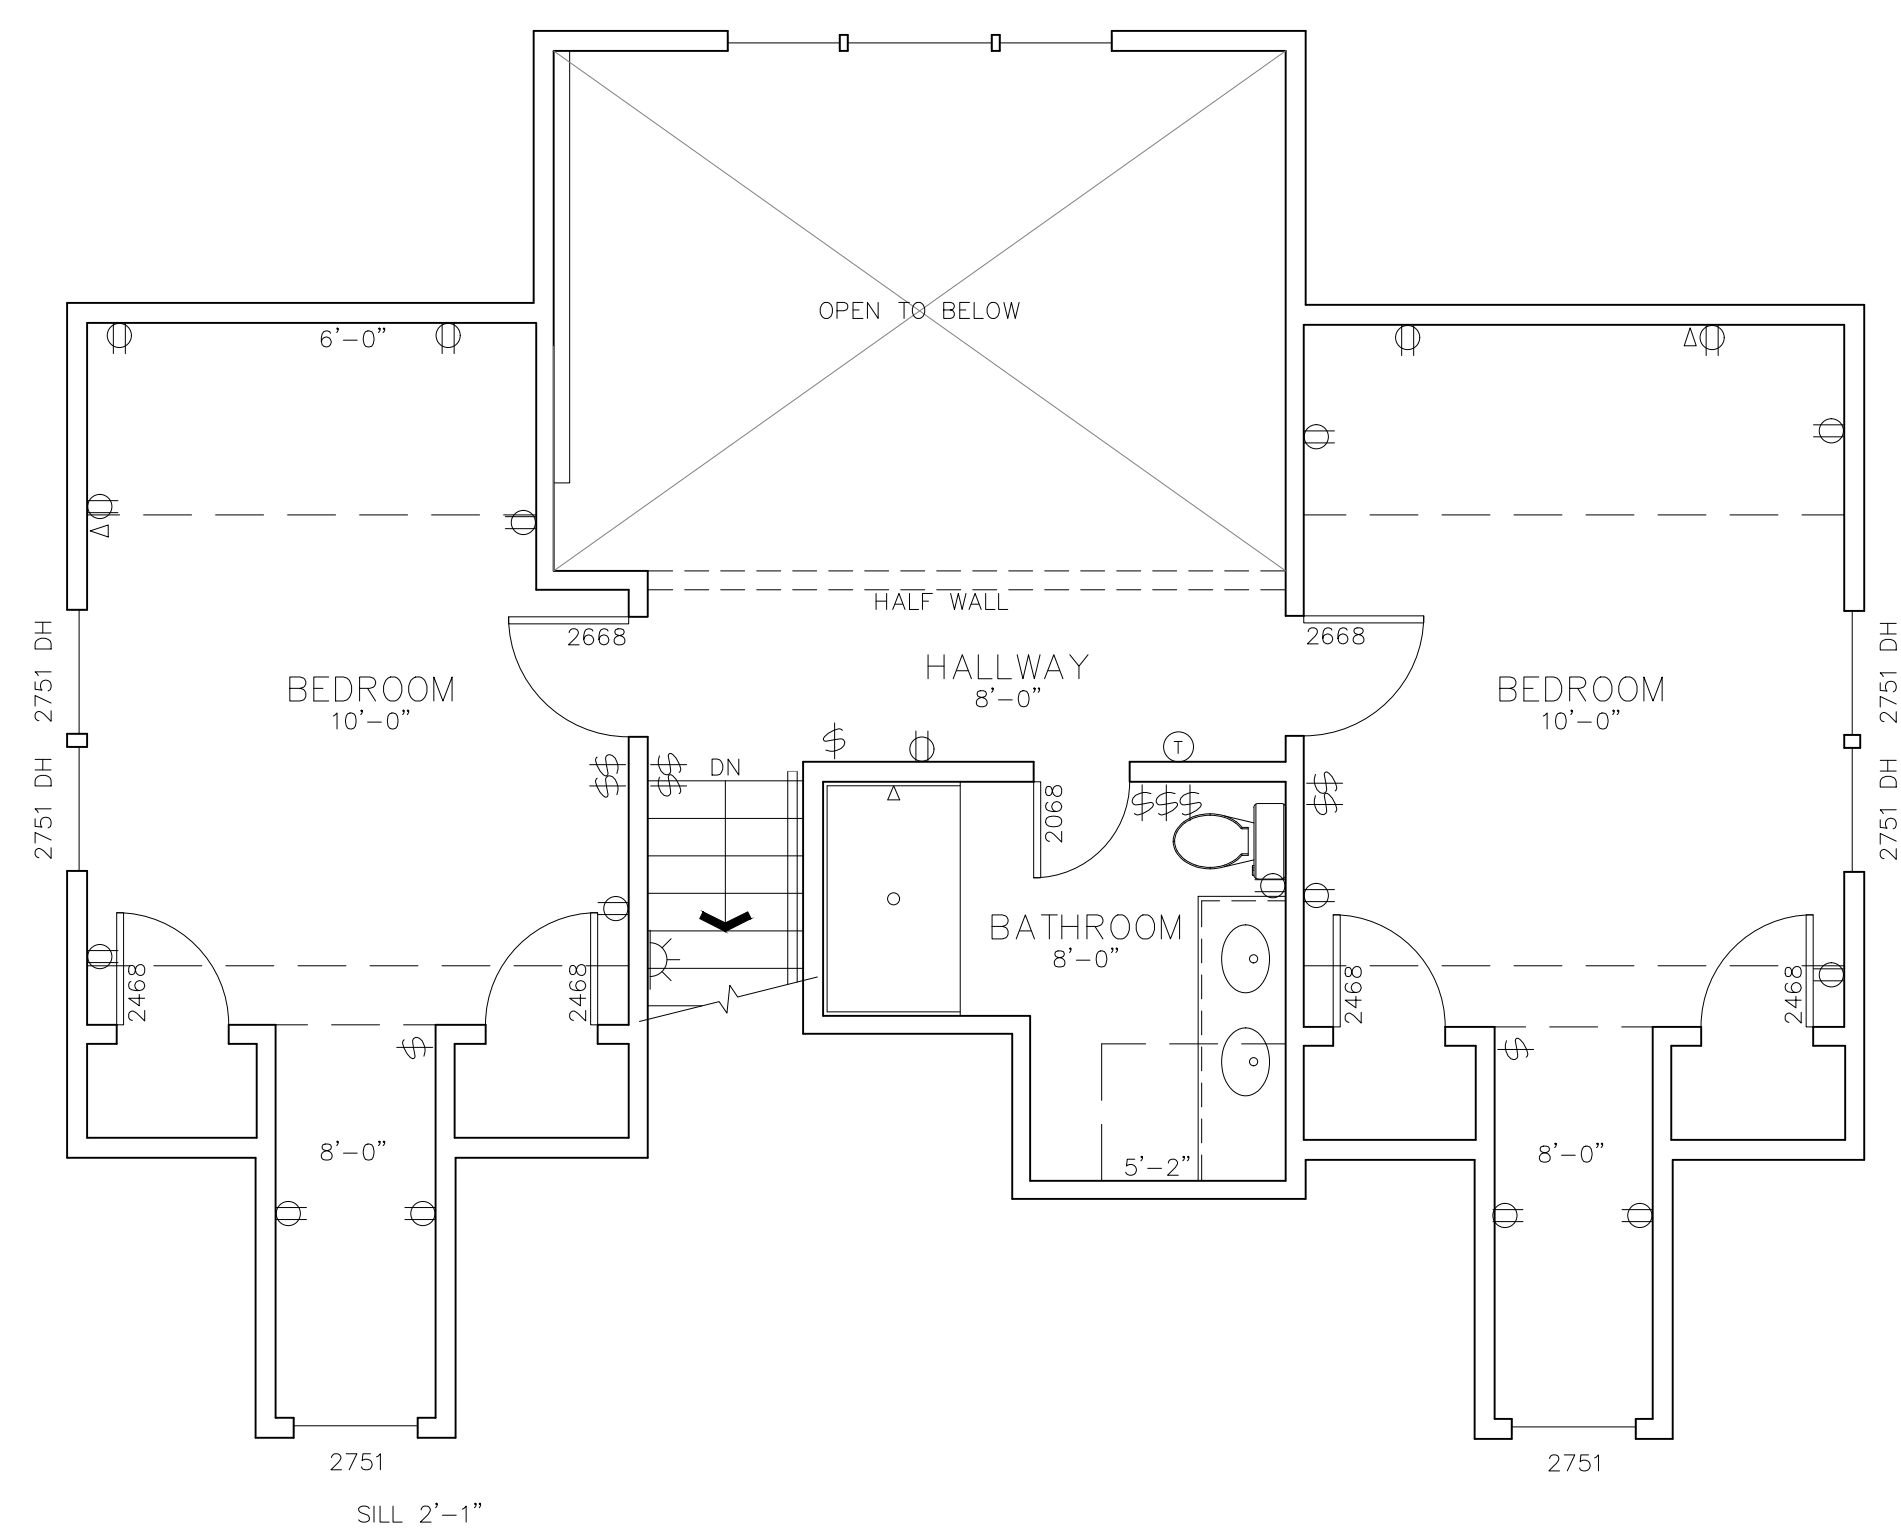

 **SECOND FLOOR**

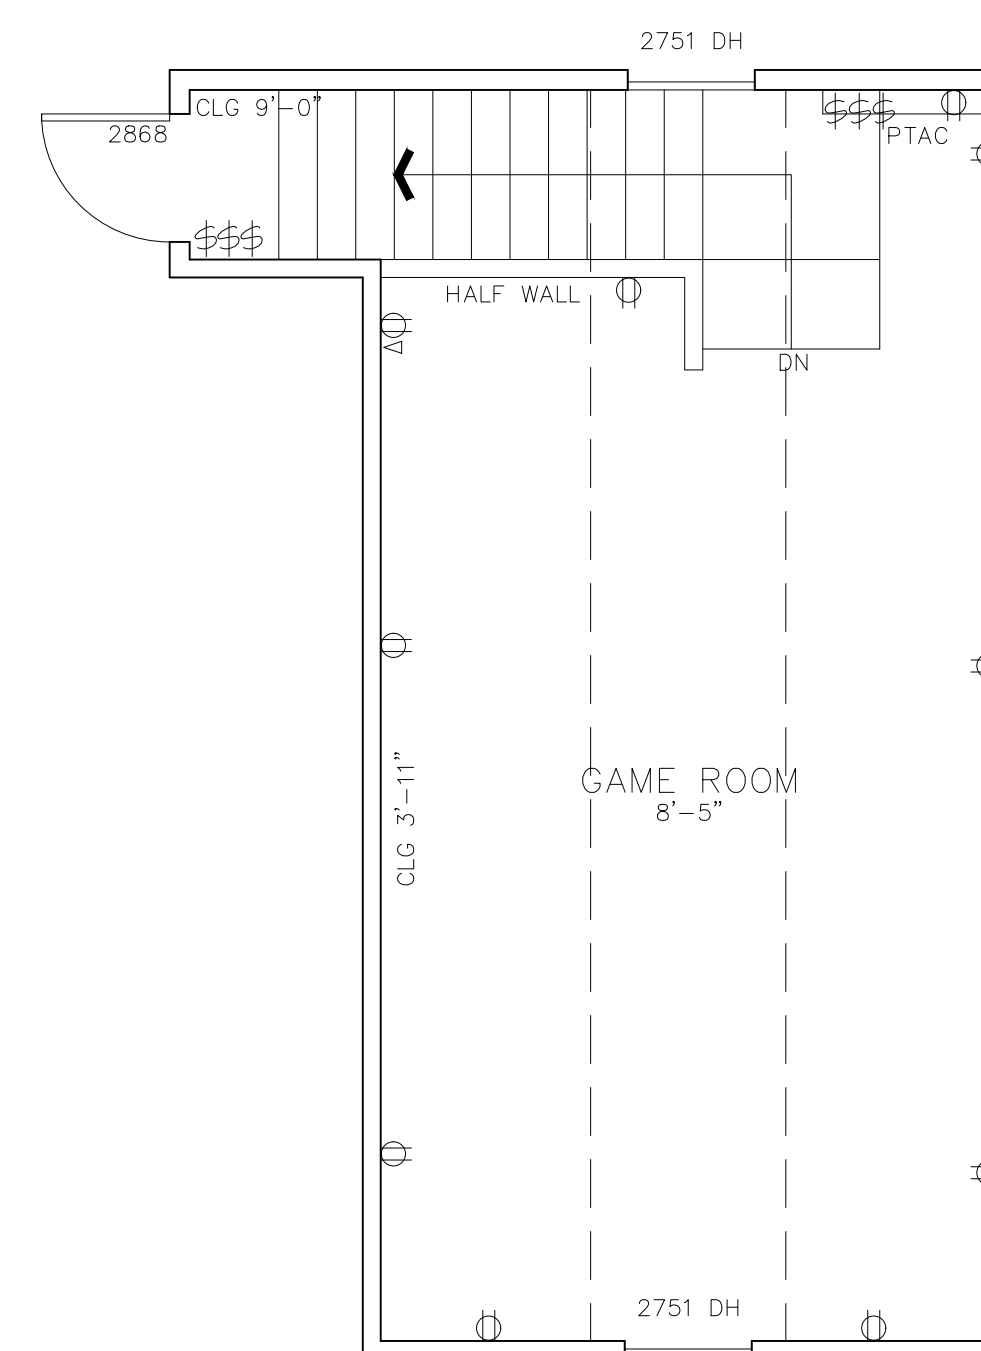

 **GARAGE SECOND FLOOR**

**AS BUILT**  
**PROFESSIONALS**  
 www.asbuiltprofessionals.com  
 A DIVISION OF:

**AEC**  
**CONSULTANTS INC**

844.272.8458  
 844 A S B U I L T

© 2020 AEC CONSULTANTS INC

**ARCHITECTURAL AS BUILT**

**Winchester, TN 37398**


NO.	ISSUES   REVISIONS	DATE	SEE COVER SHEET
01	100% SUBMISSION		

**SECOND FLOOR PLAN**

HL	PROJECT MANAGER
HL	PROJECT DIRECTOR
012317-1	PROJECT NUMBER
<b>1/4"=1'-0"</b>	SCALE
CL	DRAWN BY
	SHEET NUMBER

**AB-2**

**ARCHITECTURAL AS BUILT**  
**Winchester, TN 37398**

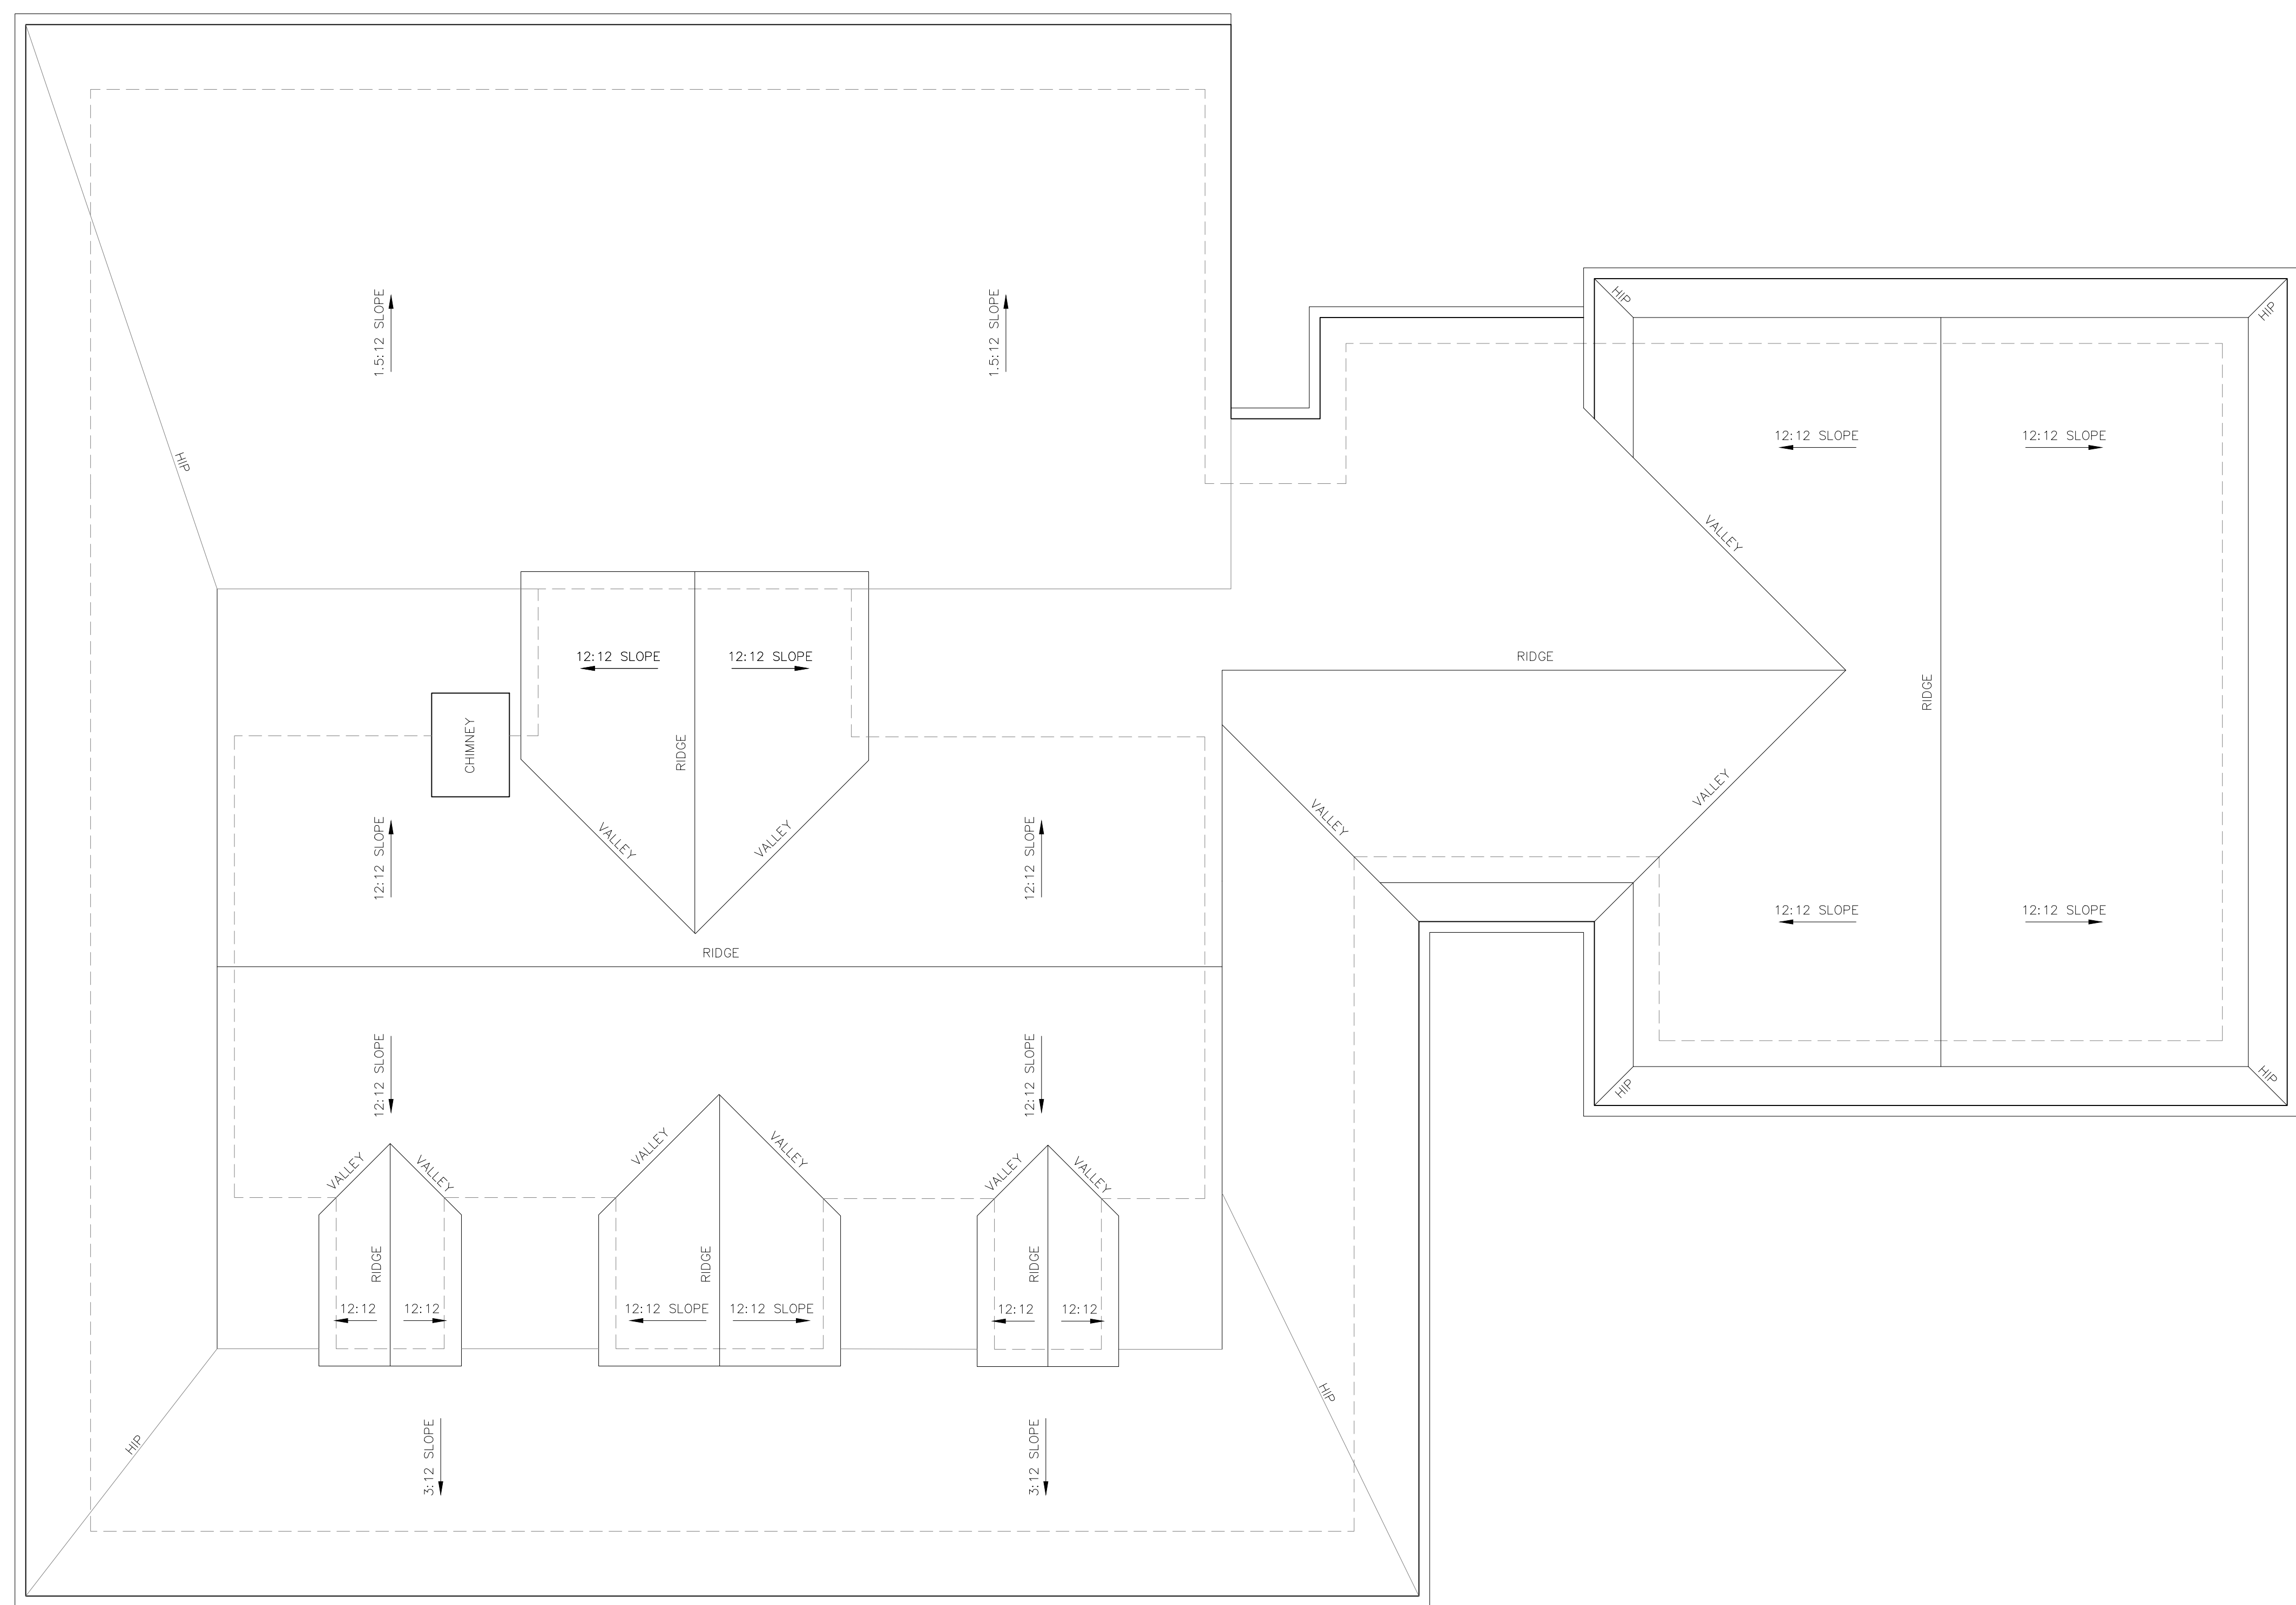

**ROOF PLAN**

01	100% SUBMISSION	SEE COVER SHEET
NO.	ISSUES   REVISIONS	DATE

SHEET TITLE  
**ROOF PLAN**

HL	PROJECT MANAGER
HL	PROJECT DIRECTOR
012317-1	PROJECT NUMBER
<b>1/4"=1'-0"</b>	SCALE
CL	DRAWN BY
	SHEET NUMBER

**AB-3**

RIDGE  
25'-6"

SECOND FLOOR  
9'-10-1/2"

FIRST FLOOR  
0'-0"



FRONT



RIGHT

**AS BUILT**  
PROFESSIONALS

www.asbuiltprofessionals.com

A DIVISION OF:



© 2020 AEC CONSULTANTS INC

**ARCHITECTURAL AS BUILT**

**Winchester, TN 37398**

01	100% SUBMISSION	SEE COVER SHEET
NO.	ISSUES   REVISIONS	DATE

SHEET TITLE

**EXTERIOR ELEVATIONS**

HL	PROJECT MANAGER
HL	PROJECT DIRECTOR
012317-1	PROJECT NUMBER
1/4"=1'-0"	SCALE
CL	DRAWN BY
	SHEET NUMBER

**AB-4**

