

AS-BUILT DOCUMENTATION

SEATTLE, WA 98112




100% SUBMITTAL

DRAWING INDEX

- C-1 COVER SHEET | DRAWING INDEX
- AB-1 FIRST FLOOR PLAN AND RCP
- AB-2 SECOND FLOOR PLAN AND RCP
- AB-3 ATTIC FLOOR PLAN AND RCP
- AB-4 DOOR & WINDOW SCHEDULES

SCOPE OF WORK:

- ☒ Floor plans
- ☒ (RCP) reflected ceiling plan (heights and transitions only)
- ☒ Door and Window sizes
- ☒ Sill heights
- ☒ Door and window trim sizes
- ☒ Still Photos of each room
- ☒ Baseboard Heights

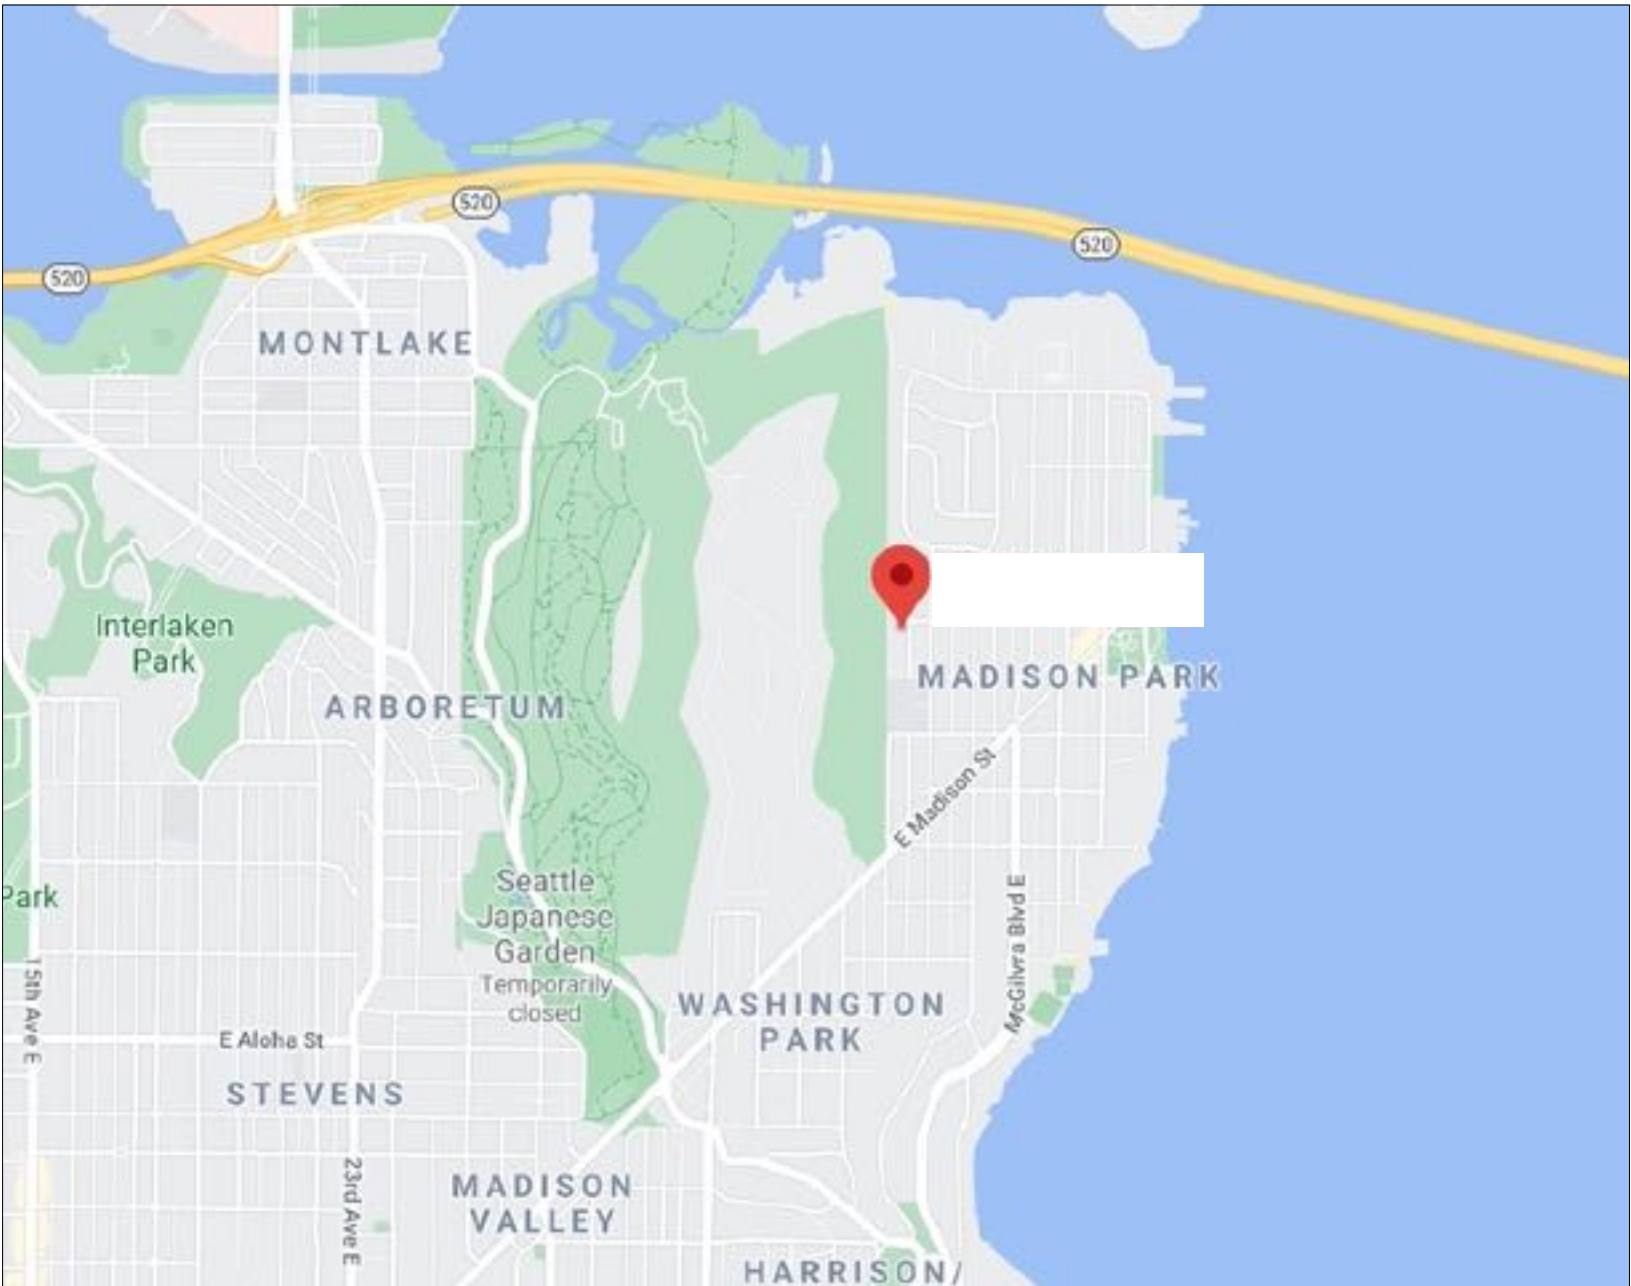

VICINITY MAP
NTS

AREA DATA	
FIRST FLOOR	2,274 S.F. ±
SECOND FLOOR	1,575 S.F. ±
ATTIC	463 S.F. ±
GRAND TOTAL	4,312 S.F. ±




© 2021 AEC CONSULTANTS INC

ARCHITECTURAL AS BUILT

SEATTLE, WA 98112

NO.		ISSUES REVISIONS	DATE
HL		PROJECT MANAGER	
HL		PROJECT DIRECTOR	
		PROJECT NUMBER	
		SCALE	
MM		DRAWN BY	
		SHEET NUMBER	
COVER SHEET			
C-1			

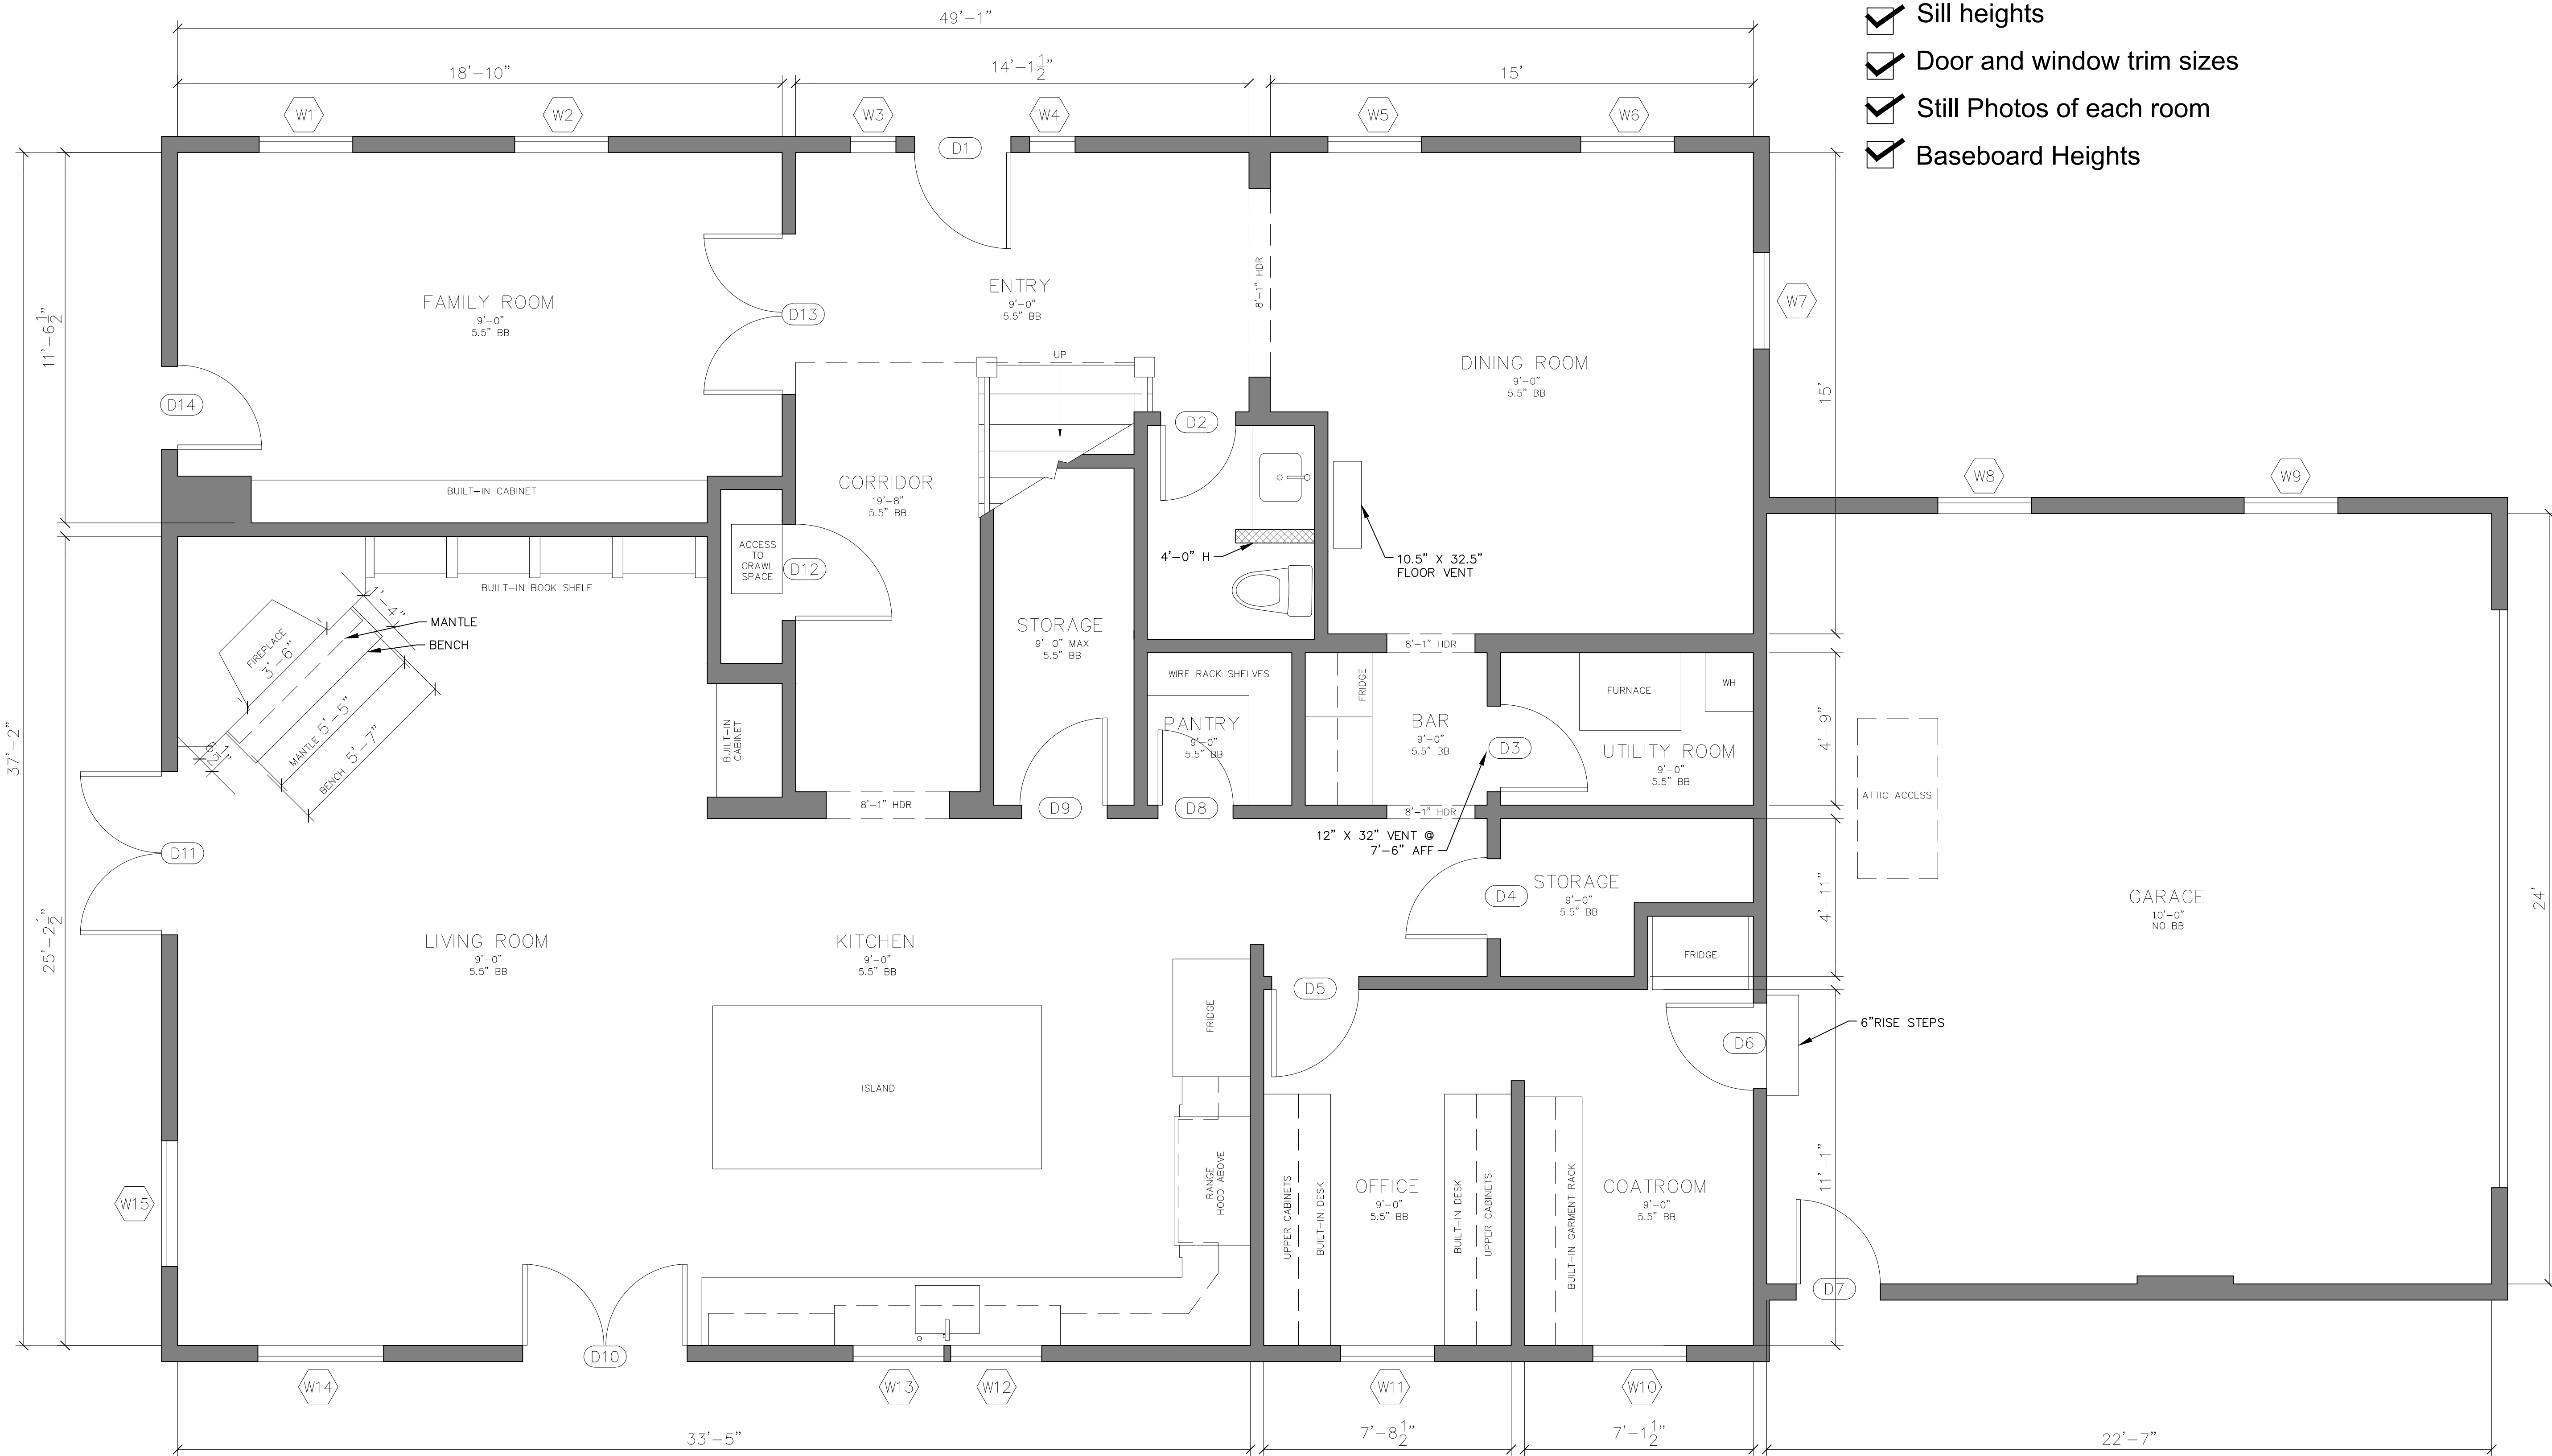

SCOPE OF WORK:

- ✓ Floor plans
- ✓ (RCP) reflected ceiling plan (heights and transitions only)
- ✓ Door and Window sizes
- ✓ Sill heights
- ✓ Door and window trim sizes
- ✓ Still Photos of each room
- ✓ Baseboard Heights



© 2021 AEC CONSULTANTS INC

**ARCHITECTURAL AS BUILT
SEATTLE, WA 98112**



NO.		ISSUES REVISIONS	DATE
		SHEET TITLE	
		PROJECT MANAGER	
		PROJECT DIRECTOR	
		PROJECT NUMBER	
		SCALE	
		DRAWN BY	
		SHEET NUMBER	

**FIRST FLOOR
FLOOR PLAN &
RCP**

3/8"=1'-0"

AB-1

- ☒ Floor plans
- ☒ (RCP) reflected ceiling plan (heights and transitions only)
- ☒ Door and Window sizes
- ☒ Sill heights
- ☒ Door and window trim sizes
- ☒ Still Photos of each room
- ☒ Baseboard Heights

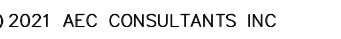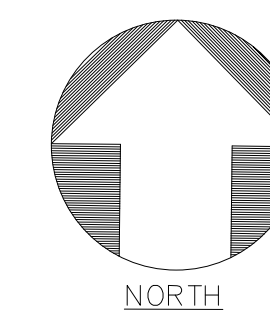

ARCHITECTURAL AS BUILT

SEATTLE, WA 98112

[illegible]

AB-2

☒ Floor plans

☒ (RCP) reflected ceiling plan (heights and transitions only)



☒ Door and Window sizes

☒ Sill heights

☒ Door and window trim sizes

☒ Still Photos of each room

☒ Baseboard Heights

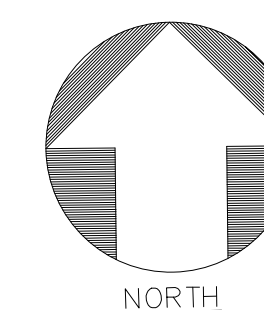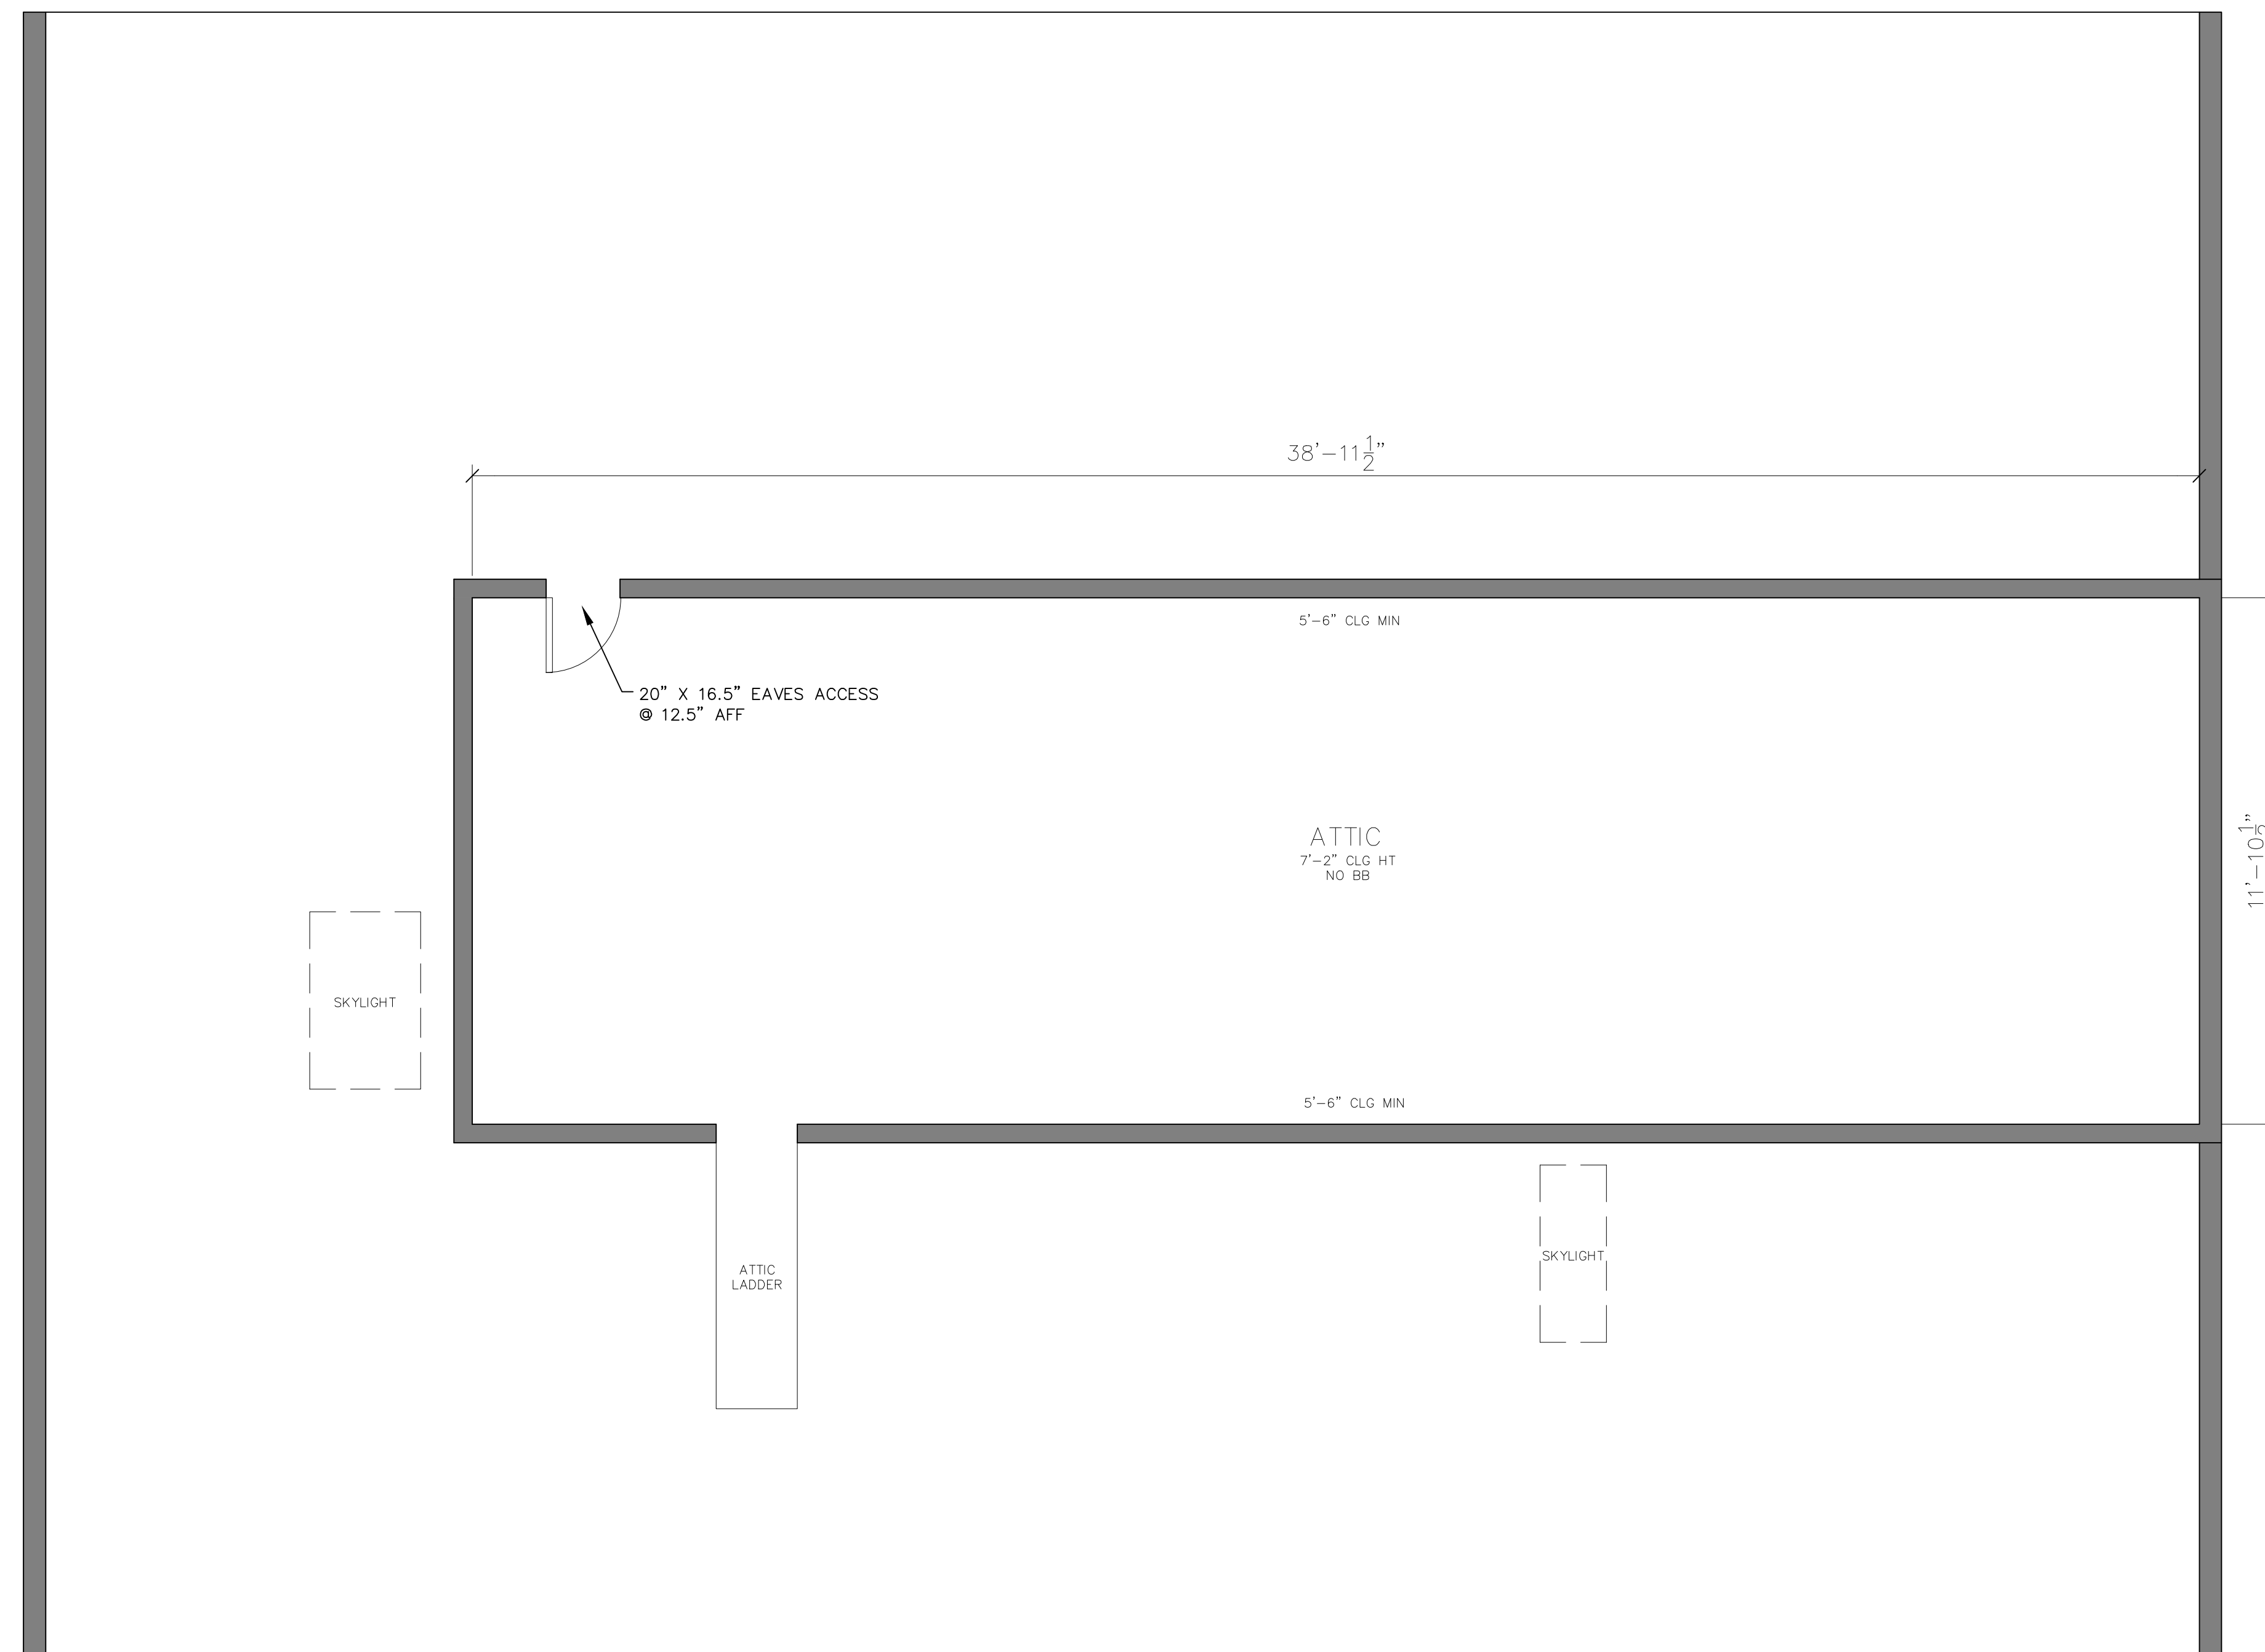

© 2021 AEC CONSULTANTS INC

ARCHITECTURAL AS BUILT

SEATTLE, WA 98112

[illegible]

NO.	ISSUES REVISIONS	DATE
-----	--------------------	------

SHEET TITLE

ATTIC PLAN & RCP


HL	PROJECT MANAGER
HL	PROJECT DIRECTOR
	PROJECT NUMBER
3/8"=1'-0"	SCALE
MM	DRAWN BY
	SHEET NUMBER

AB-3

- ☒ Floor plans
- ☒ (RCP) reflected ceiling plan (heights and transitions only)
- ☒ Door and Window sizes
- ☒ Sill heights
- ☒ Door and window trim sizes
- ☒ Still Photos of each room
- ☒ Baseboard Heights

Window Schedule							
Window	Width	Height	Sill Height	Top Trim	Left Trim	Right Trim	Notes
W1	2'-11"	5'-10.5"	1'-10"	3.5"	3.5"	3.5"	
W2	2'-11"	5'-10.5"	1'-10"	3.5"	3.5"	3.5"	
W3	1'-5"	5'-11"	2'-2"	1'-0"	5.5"	7"	
W4	1'-5"	5'-11"	2'-2"	1'-0"	7"	5.5"	
W5	2'-11"	5'-10.5"	1'-10"	4.5"	4.5"	4.5"	
W6	2'-11"	5'-10.5"	1'-10"	4.5"	4.5"	4.5"	
W7	2'-11"	5'-10.5"	1'-10"	4.5"	4.5"	4.5"	
W8	2'-11"	4'-10.5"	4'-0"	4.5"	4.5"	4.5"	
W9	2'-11"	4'-10.5"	4'-0"	4.5"	4.5"	4.5"	
W10	2'-11"	4'-11"	2'-10"	4.5"	4.5"	4.5"	
W11	2'-11"	4'-10"	2'-11"	3"	3"	3"	
W12	2'-10"	4'-9"	3'-1"	4.5"	4.5"	2.5"	
W13	2'-10"	4'-9"	3'-1"	4.5"	2.5"	4.5"	
W14	3'-11"	5'-10"	1'-10"	4.5"	4.5"	4.5"	
W15	3'-11"	5'-10"	1'-10"	4.5"	4.5"	4.5"	
W16	2'-11"	4'-10.5"	2'-10.5"	4.5"	4.5"	4.5"	
W17	2'-11"	4'-10.5"	2'-10.5"	4.5"	4.5"	4.5"	
W18	3'-11"	4'-10.5"	2'-10.5"	4.5"	4.5"	4.5"	
W19	2'-11"	4'-10.5"	2'-10.5"	4.5"	4.5"	4.5"	
W20	2'-11"	4'-10.5"	2'-10.5"	4.5"	4.5"	4.5"	
W21	2'-11"	4'-10.5"	2'-10.5"	4.5"	4.5"	4.5"	
W22	2'-11"	4'-10.5"	2'-10.5"	4.5"	4.5"	4.5"	
W23	2'-11"	4'-10.5"	2'-10.5"	4.5"	4.5"	4.5"	
W24	3'-11"	4'-10.5"	2'-10.5"	4.5"	4.5"	4.5"	
W25	2'-10.5"	1'-11"	5'-0"	N/A	N/A	N/A	
W26	3'-11"	4'-10.5"	2'-10.5"	4.5"	4.5"	4.5"	
W27	1'-11"	3'-11"	3'-10"	4.5"	4.5"	4.5"	
W28	2'-11"	4'-11"	2'-11"	4.5"	4.5"	4.5"	
W29	2'-11"	4'-11"	2'-11"	4.5"	4.5"	4.5"	
W30	3'-11"	4'-10.5"	2'-10.5"	4.5"	4.5"	4.5"	

Door Schedule								
Door	Leaf Width	Leaf Height	Opening Wd	Opening Ht	Left Trim	Right Trim	Top Trim	Notes
D1	3'-0"	8'-0"	3'-0"	8'-5"	7"	7"	1'-0"	
D2	2'-8"	7'-11.5"	2'-8"	8'-0"	4.5"	4.5"	4.5"	
D3	2'-8"	6'-8.5"	2'-8"	6'-9"	4"	4"	4"	
D4	2'-6"	6'-7"	2'-6"	6'-7"	3.5"	3.5"	3.5"	arch shaped door
D5	2'-8.5"	6'-8.5"	2'-8.5"	6'-9"	3"	3"	3"	
D6	2'-8"	6'-8"	2'-8"	6'-9"	4.5"	4.5"	4.5"	
D7	2'-7.5"	6'-8.5"	2'-7.5"	6'-9"	4.5"	4.5"	4.5"	
D8	2'-4"	6'-8.5"	2'-4"	6'-9"	4.5"	4.5"	4.5"	
D9	2'-8"	6'-8.5"	2'-8"	6'-9"	4.5"	4.5"	4.5"	
D10	2'-6.5"	7'-7.5"	5'-1"	7'-8"	4.5"	4.5"	4.5"	
D11	2'-6.5"	7'-7.5"	5'-1"	7'-8"	4.5"	4.5"	4.5"	
D12	3'-0"	7'-11.5"	3'-0"	8'-1"	4.5"	4.5"	4.5"	
D13	2'-6"	7'-11.5"	5'-0"	8'-1"	4.5"	4.5"	4.5"	
D14	2'-7"	7'-8"	2'-7"	7'-9"	3.5"	3.5"	3.5"	
D15	2'-6"	6'-8.5"	2'-6"	6'-9"	3"	3"	3"	
D16	2'-6"	6'-7.5"	2'-6"	6'-8"	4.5"	4.5"	4.5"	
D17	2'-6"	6'-7.5"	5'-0"	6'-8"	4.5"	4.5"	4.5"	
D18	2'-6"	6'-7.5"	2'-6"	6'-8"	4.5"	4.5"	4.5"	
D19	2'-6"	6'-7.5"	2'-6"	6'-8"	4"	4"	4"	
D20	2'-6"	6'-7.5"	2'-6"	6'-8"	3.5"	3.5"	3.5"	
D21	2'-6"	6'-7.5"	2'-6"	6'-8"	4"	4"	4"	
D22	2'-6"	6'-7.5"	2'-6"	6'-8"	3.5"	3.5"	3.5"	
D23	2'-3"	6'-9"	2'-4"	6'-8"	3.5"	3.5"	3.5"	
D24	2'-6"	6'-7.5"	2'-6"	6'-8"	4.5"	4.5"	4.5"	
D25	2'-6"	6'-7.5"	2'-6"	6'-8"	3.5"	3.5"	3.5"	
D26	2'-8"	6'-7.5"	2'-6"	6'-8"	3.5"	3.5"	3.5"	
D27	2'-5.5"	6'-7.5"	2'-5.5"	6'-8"	3.5"	3.5"	3.5"	
D28	2'-8"	6'-7.5"	2'-8"	6'-8"	3.5"	3.5"	3.5"	
D29	2'-3.5"	6'-9"	2'-2.5"	6'-8"	3"	3"	3"	
D30	2'-6"	6'-7.5"	2'-6"	6'-8"	3.5"	3.5"	3.5"	

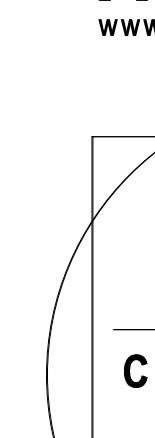 As BUILT PROFESSIONALS www.asbuiltprofessionals.com A DIVISION OF: A S AEC CONSULTANTS INC 844.272.8458 844 ASBUILT © 2021 AEC CONSULTANTS INC		
ARCHITECTURAL AS BUILT SEATTLE, WA 98112		
SHEET TITLE DOOR & WINDOW SCHEDULES		
HL	PROJECT MANAGER	
HL	PROJECT DIRECTOR	
	PROJECT NUMBER	
	SCALE	
MM	DRAWN BY	
	SHEET NUMBER	
AB-4		