

AS-BUILT DOCUMENTATION

SEATTLE, WA 98117




100% SUBMITTAL

DRAWING INDEX

- C-1 COVER SHEET | DRAWING INDEX
- AB-1 FIRST FLOOR PLAN AND RCP
- AB-2 SECOND FLOOR PLAN AND RCP
- AB-3 DOOR & WINDOW SCHEDULES

SCOPE OF WORK:

- ✓ Floor plans
- ✓ (RCP) reflected ceiling plan (heights and transitions only)
- ✓ Door and Window sizes
- ✓ Sill heights
- ✓ Door and window trim sizes
- ✓ Still Photos of each room
- ✓ Baseboard Heights

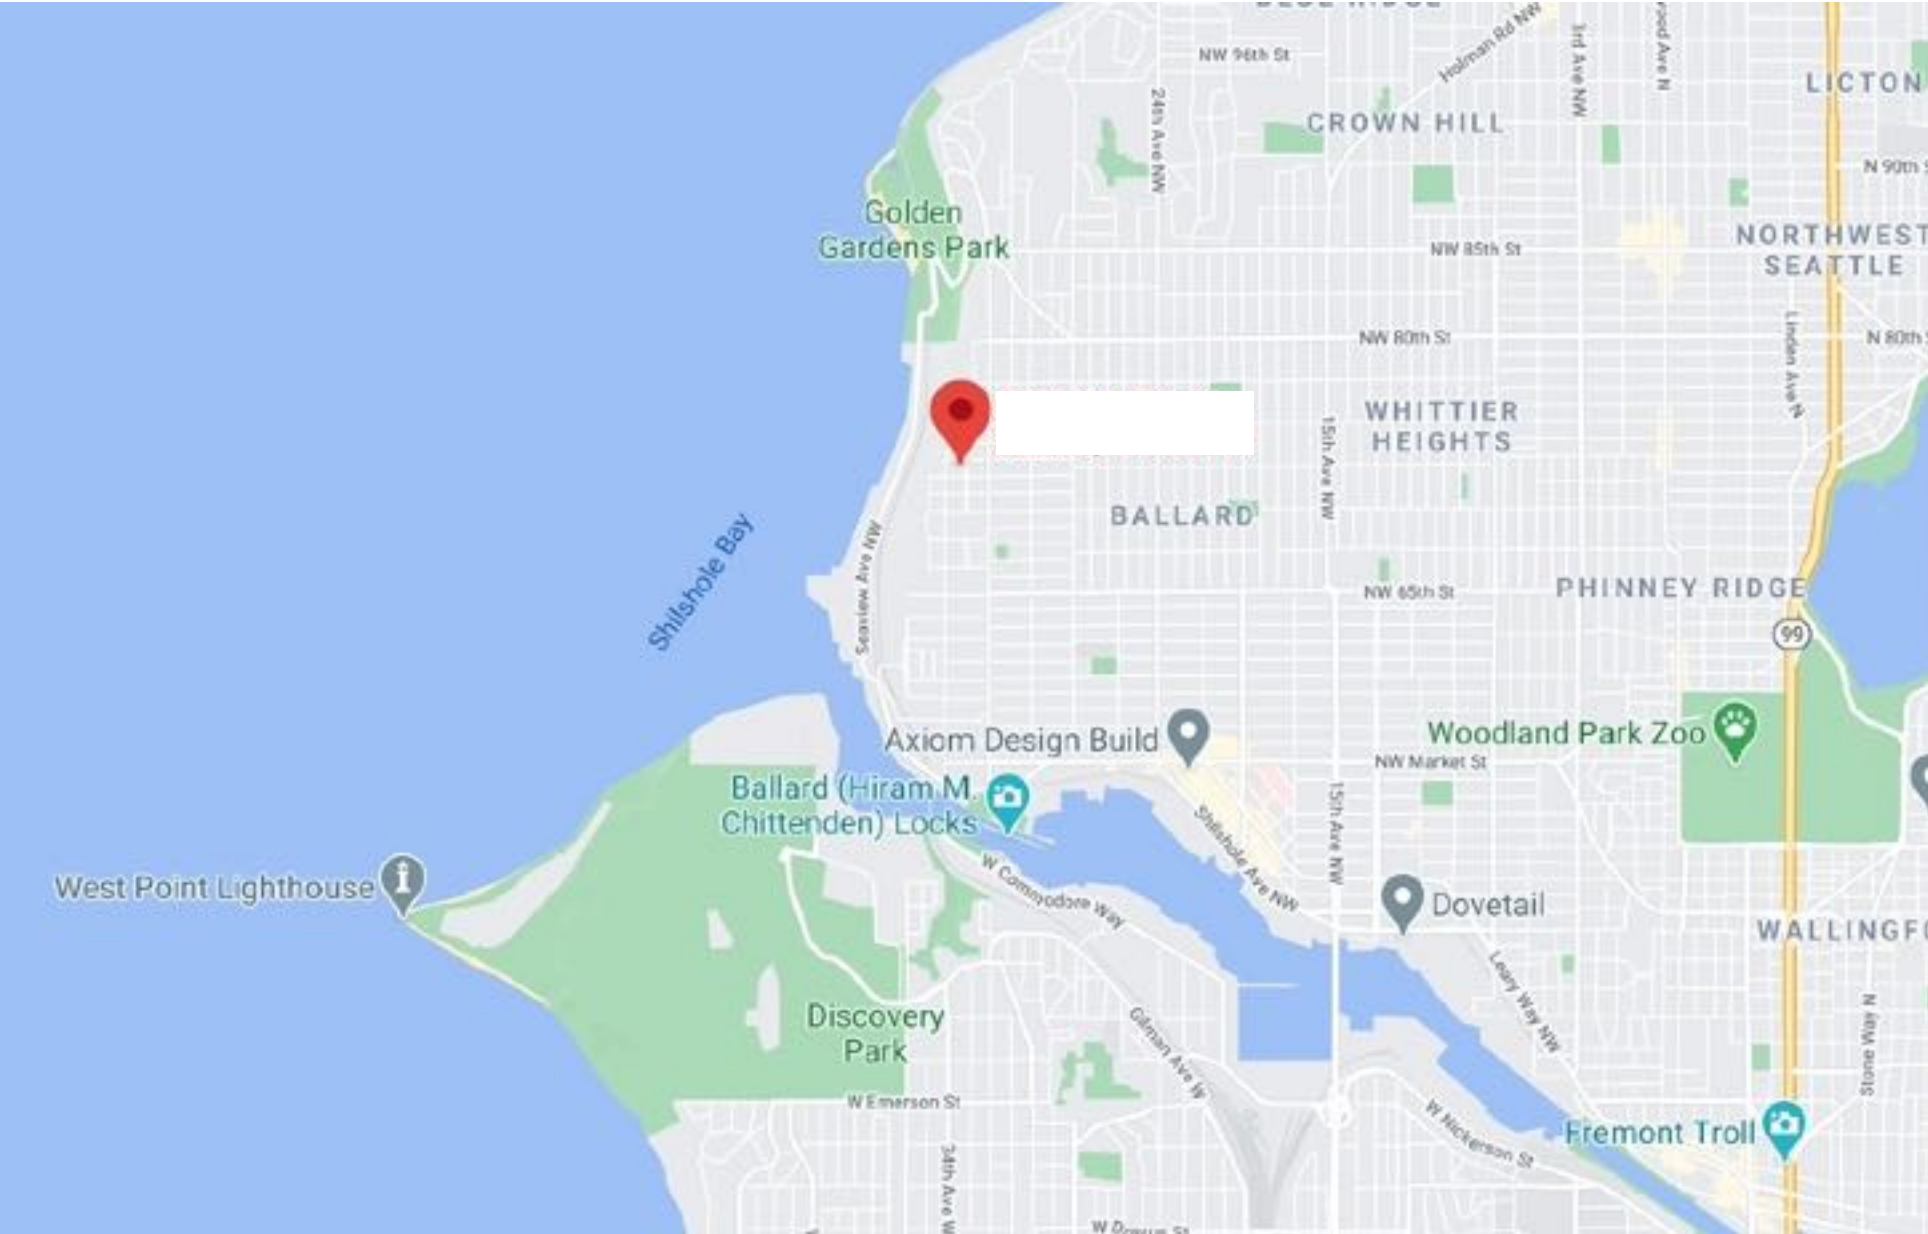

VICINITY MAP NTS

AREA DATA	
FIRST FLOOR	1,050 S.F. ±
SECOND FLOOR	840 S.F. ±
GRAND TOTAL	1,890 S.F. ±




© 2020 AEC CONSULTANTS INC

ARCHITECTURAL AS BUILT
SEATTLE WA 98117



NO.		ISSUES REVISIONS	DATE
HL		PROJECT MANAGER	
HL		PROJECT DIRECTOR	
		PROJECT NUMBER	
		SCALE	
MM		DRAWN BY	
		SHEET NUMBER	
		COVER SHEET	
		C-1	

Scope of Work:

- ☒ Floor plans
- ☒ (RCP) reflected ceiling plan (heights and transitions only)
- ☒ Door and Window sizes
- ☒ Sill heights
- ☒ Door and window trim sizes
- ☒ Still Photos of each room
- ☒ Baseboard Heights

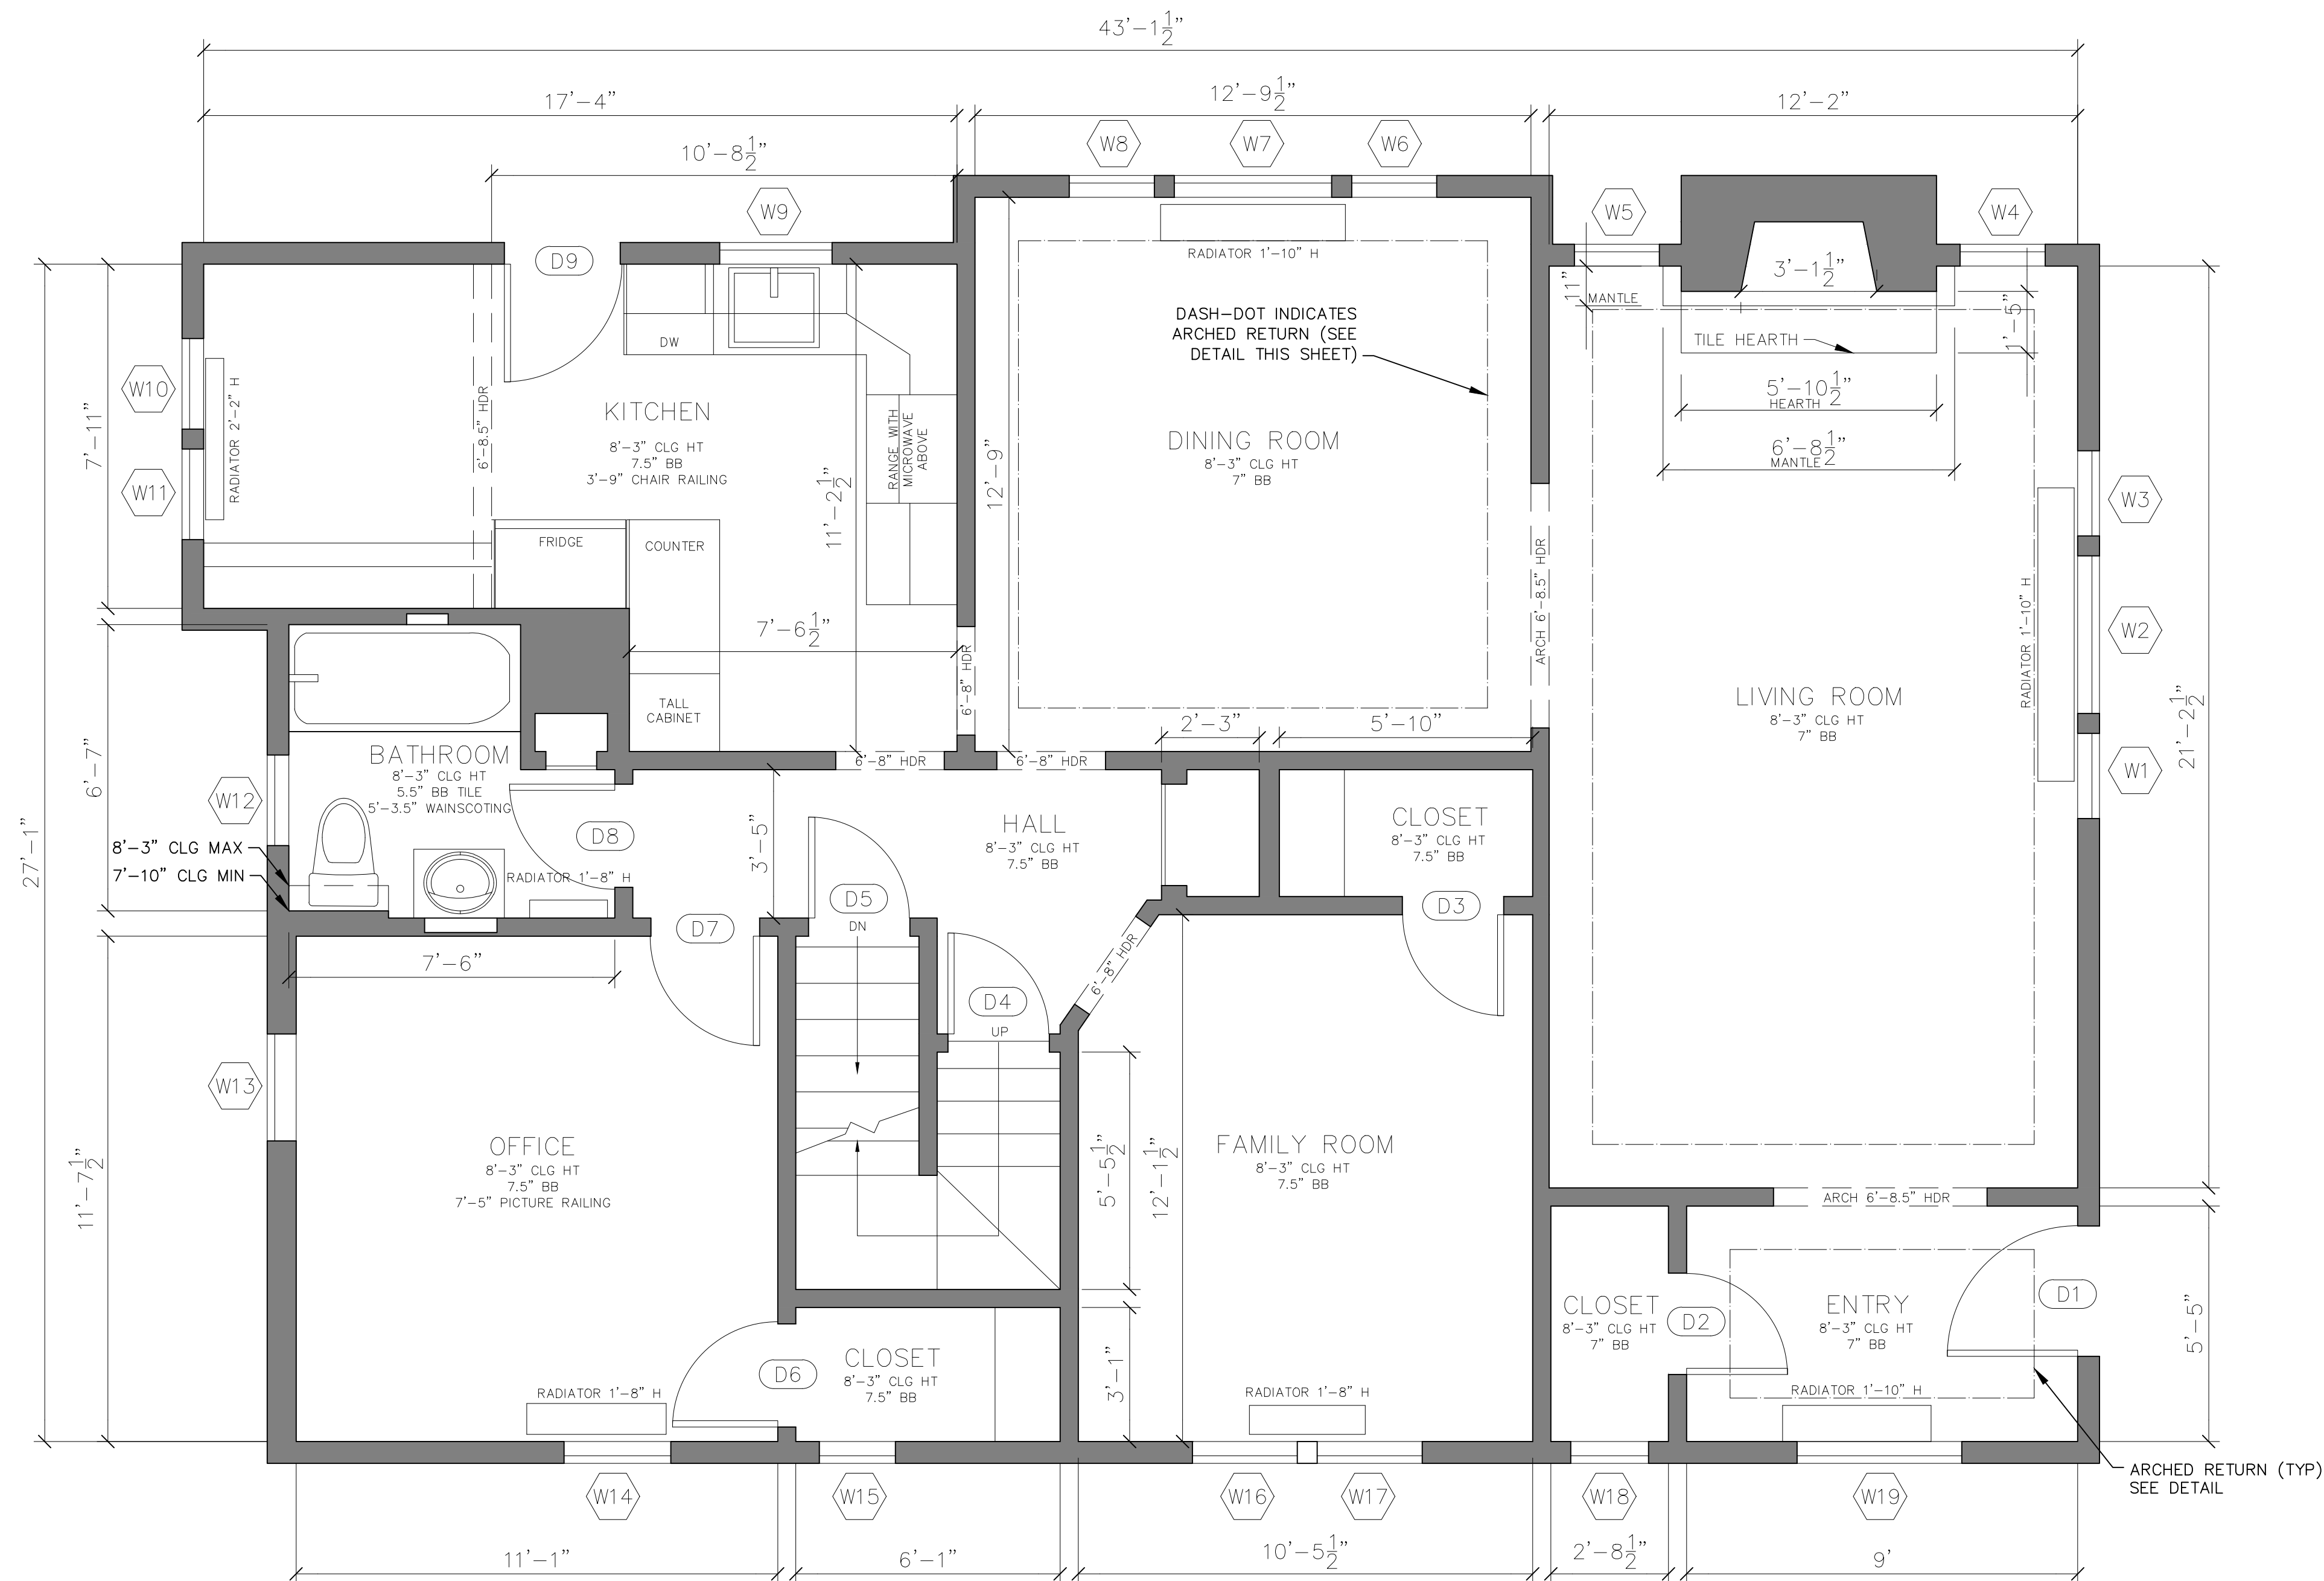

FIRST FLOOR – PLAN

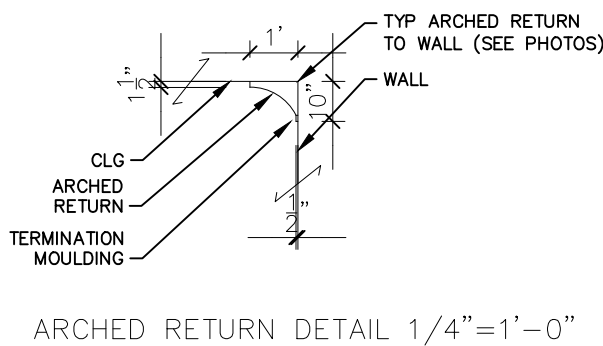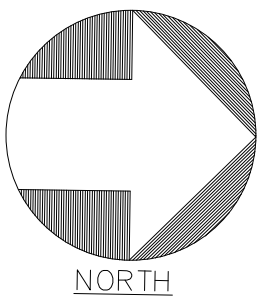

© 2020 AEC CONSULTANTS INC

ARCHITECTURAL AS BUILT
SEATTLE WA 98117

NO. ISSUES | REVISIONS DATE

SHEET TITLE
FIRST FLOOR
PLAN & RCP

HL	PROJECT MANAGER
HL	PROJECT DIRECTOR
	PROJECT NUMBER
3/8"=1'-0"	SCALE
MM	DRAWN BY
	SHEET NUMBER

AB-1


☒ Floor plans

☒ Door and Window sizes


☒ Sill heights

☒ Door and window trim sizes

☒ Still Photos of each room

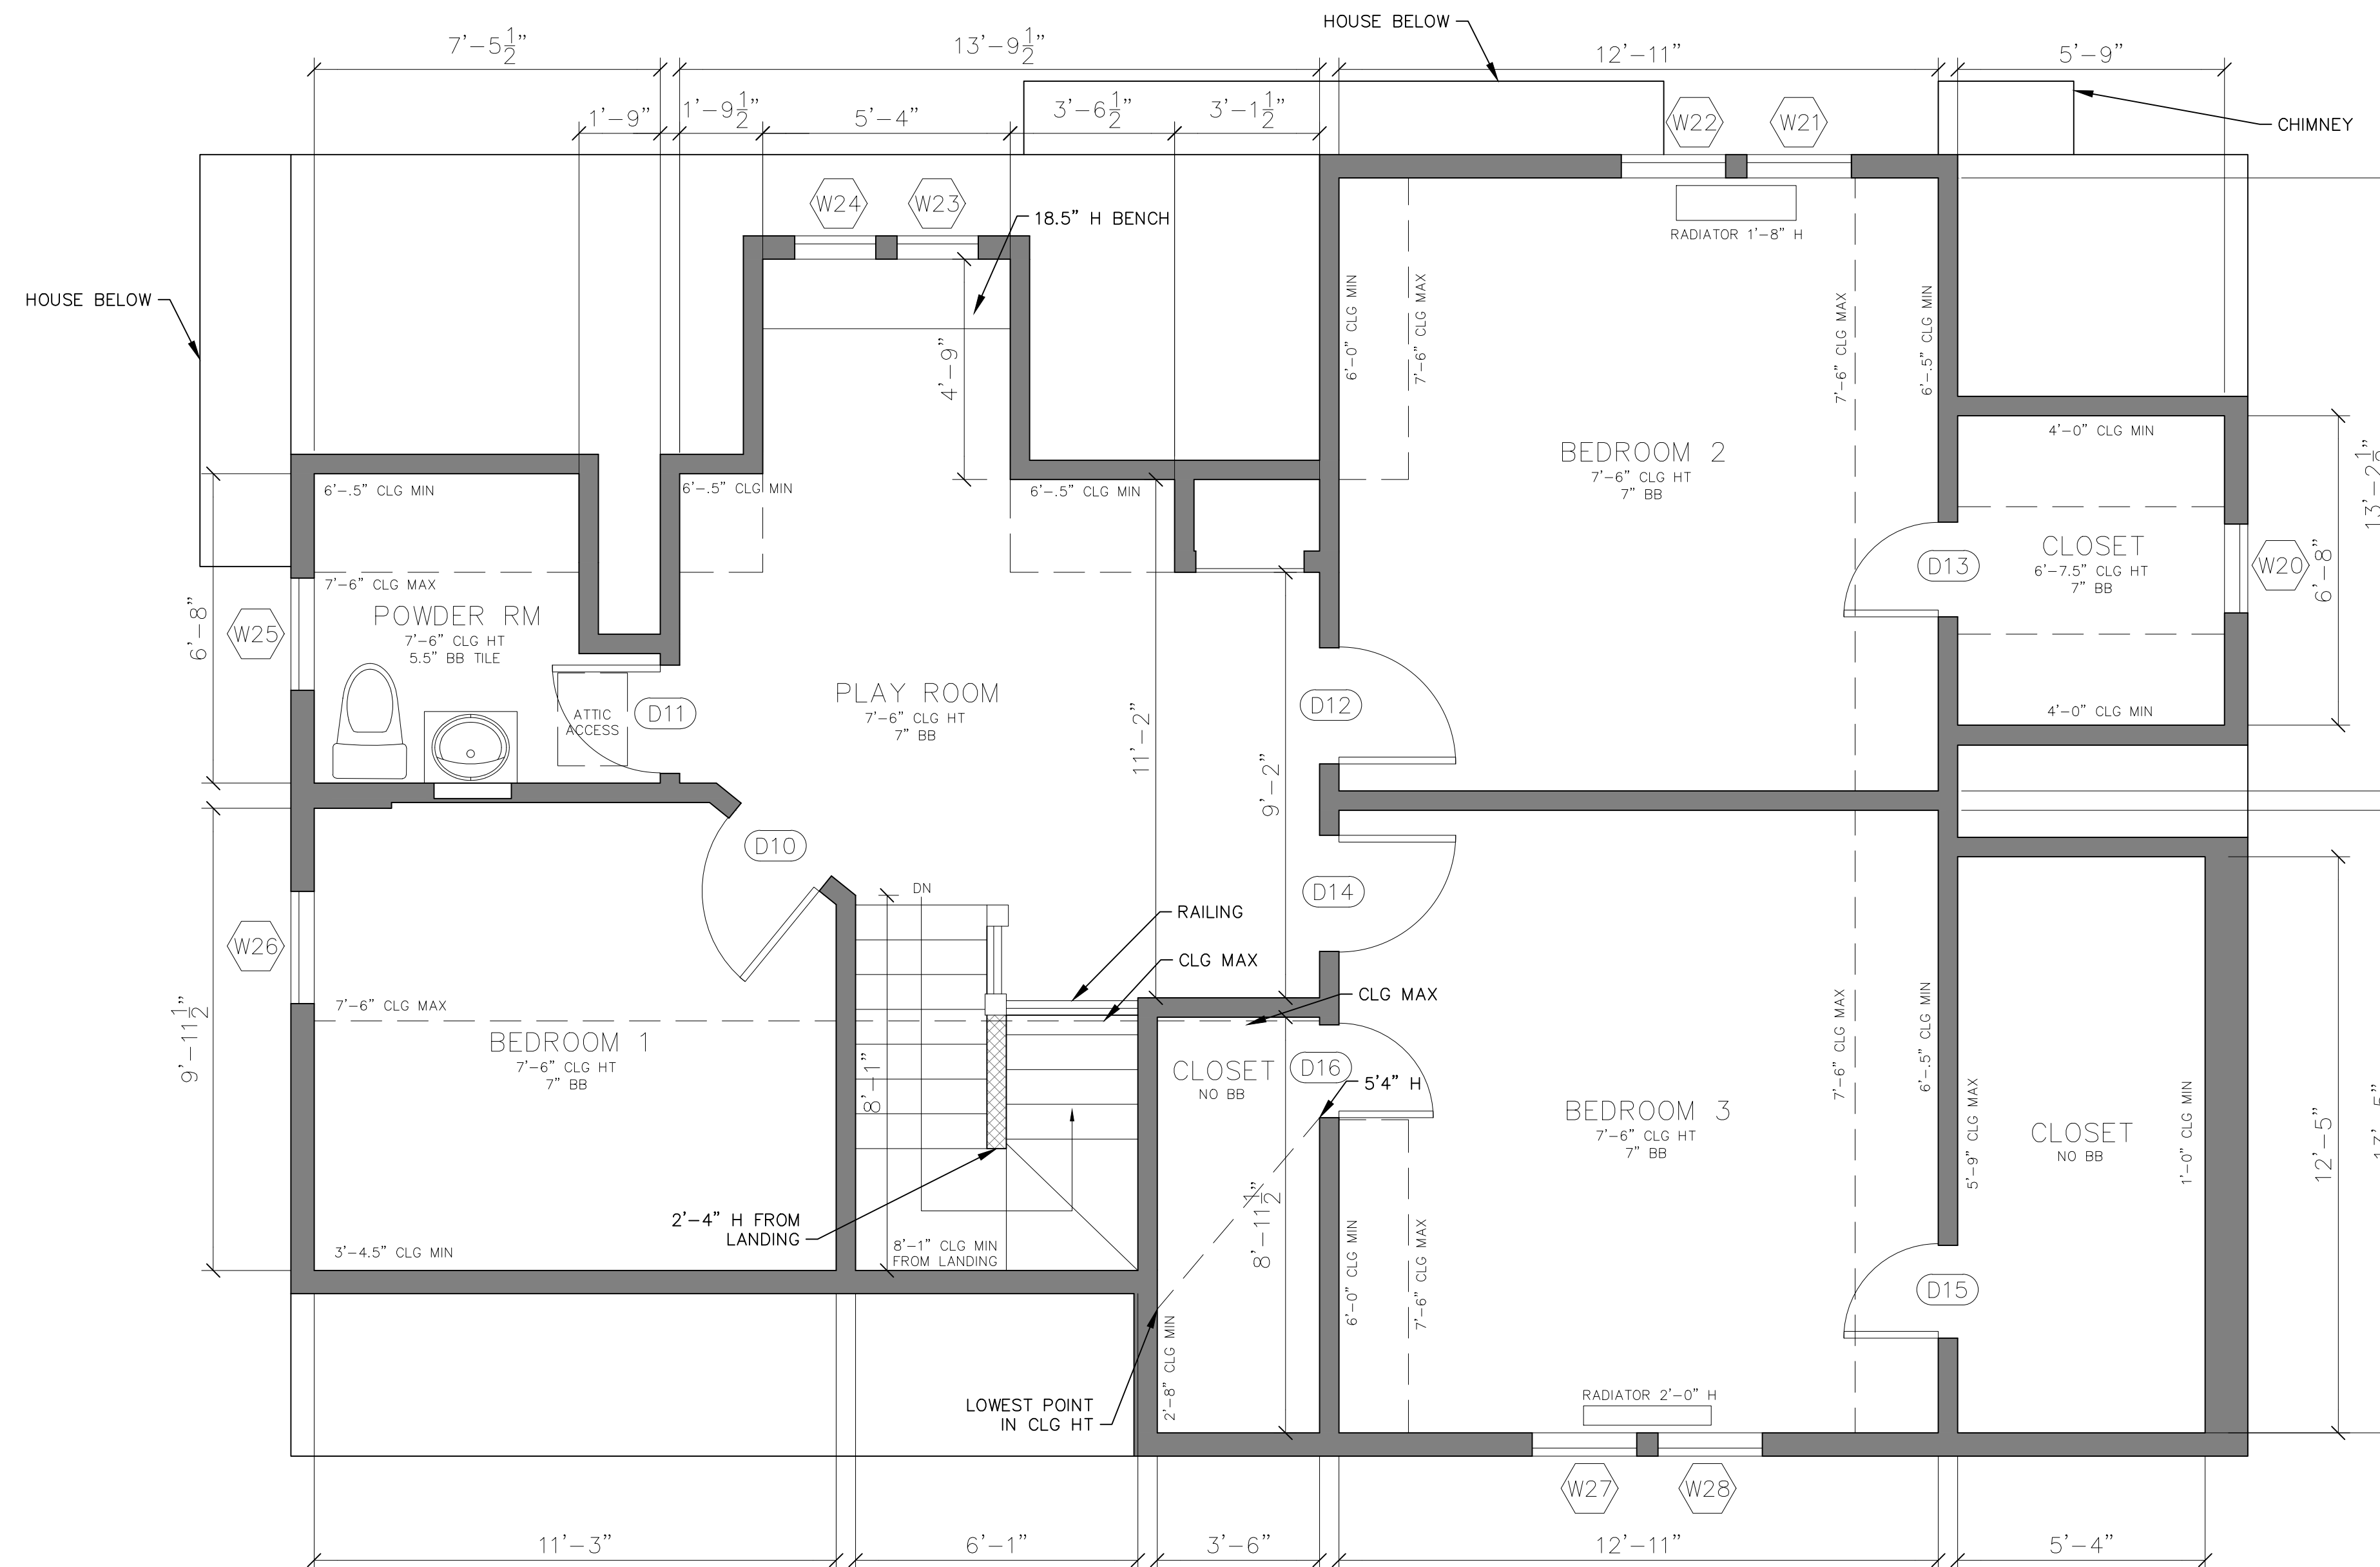☒ Baseboard Heights

SECOND FLOOR – PLAN

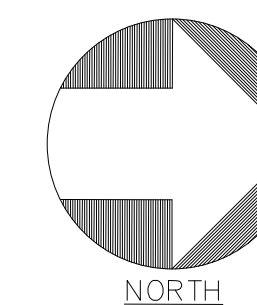

ARCHITECTURAL AS BUILT

SEATTLE WA 98117

[illegible]

AB-2

☒ Baseboard Heights

Window Schedule										
Window	Width	Height	Sill Height	Top Trim	Left Trim	Right Trim	Apron Trim	Stool Wd	Stool Ht	Notes
W1	1'-11.5"	4'-4"	2'-3.5"	3.75"	5.5"	3.75"	3.5"	9'-3"	1"	
W2	3'-7.5"	4'-4"	2'-3.5"	3.75"	5.5"	5.5"	3.5"	9'-3"	1"	
W3	1'-11.5"	4'-4"	2'-3.5"	3.75"	3.75"	5.5"	3.5"	9'-3"	1"	
W4	1'-11.5"	4'-4"	2'-3.5"	3.75"	3.75"	3.75"	3.5"	2'-9.5"	1"	
W5	1'-11.5"	4'-4"	2'-3.5"	3.75"	3.75"	3.75"	3.5"	2'-9.5"	1"	
W6	1'-11.5"	4'-4"	2'-3.5"	3.75"	5.5"	3.75"	3.5"	9'-3"	1"	
W7	3'-7.5"	4'-4"	2'-3.5"	3.75"	5.5"	5.5"	3.5"	9'-3"	1"	
W8	1'-11.5"	4'-4"	2'-3.5"	3.75"	3.75"	5.5"	3.5"	9'-3"	1"	
W9	2'-7"	2'-10"	3'-9.5"	4"	4"	4"	3.5"	3'-3"	1"	
W10	2'-1"	3'-10"	2'-9.5"	4"	5.5"	4"	3.5"	5'-3.5"	1"	
W11	2'-1"	3'-10"	2'-9.5"	4"	4"	5.5"	3.5"	5'-3.5"	1"	stool and left trim meet cabinet
W12	2'-1"	3'-4"	3'-3"	4"	4"	4"	3.5"	3'	1"	
W13	2'-5.5"	4'-4"	2'-3.5"	4"	4"	4"	3"	3'-4"	1"	
W14	2'-5.5"	4'-4"	2'-3.5"	4"	4"	4"	3"	3'-4"	1"	
W15	1'-9"	2'-4"	4'-3"	4"	4"	4"	3"	2'-7.5"	1"	
W16	2'-5"	4'-4"	2'-4"	4"	5.5"	4"	3"	6'-2.5"	1"	
W17	2'-5"	4'-4"	2'-4"	4"	4"	5.5"	3"	6'-2.5"	1"	
W18	1'-9.5"	2'-4.5"	4'-3"	3.75"	3.75"	3.75"	3.5"	2'-7.5"	1"	
W19	3'-9.5"	1'-11.5"	4'-8"	3.75"	3.75"	3.75"	3.5"	4'-7.5"	1"	
W20	1'-11"	3'-5"	2'-2.5"	4"	4"	4"	3.5"	2'-10.5"	1"	arch
W21	2'-3"	1'-7.5"	2'-3.5"	4"	5.5"	4"	3.5"	5'-11"	1"	
W22	2'-3"	1'-7.5"	2'-3.5"	4"	4"	5.5"	3.5"	5'-11"	1"	
W23	1'-9"	3'-4"	2'-8"	4"	5.5"	4"	3.5"	4'-10.5"	1"	
W24	1'-9"	3'-4"	2'-8"	4"	4"	5.5"	3.5"	4'-10.5"	1"	
W25	2'-5"	3'-4"	2'-8"	4"	4"	4"	3.5"	2'-8"	1"	
W26	2'-5"	3'-4"	2'-8"	4"	4"	4"	3.5"	2'-8"	1"	
W27	2'-3"	1'-7.5"	2'-3.5"	4"	5.5"	4"	3.5"	5'-11"	1"	
W28	2'-3"	1'-7.5"	2'-3.5"	4"	4"	5.5"	3.5"	5'-11"	1"	

Door Schedule								
Door	Leaf Width	Leaf Height	Opening Wd	Opening Ht	Left Trim	Right Trim	Top Trim	Notes
D1	3'	6'-7"	3'	6'-9"	3.75"	3.75"	3.75"	
D2	2'-4"	6'-8"	2'-4"	6'-8.5"	3.75"	3.75"	3.75"	
D3	2'-4"	6'-7"	2'-4"	6'-8.5"	3.75"	3.75"	3.75"	
D4	2'-4"	6'-8"	2'-4"	6'-8.5"	3"	3"	4"	
D5	2'-4"	6'-8"	2'-4"	6'-8.5"	3.75"	3.75"	3.75"	
D6	2'-4.5"	6'-7"	2'-4.5"	6'-8"	4"	4"	4"	
D7	2'-6"	6'-7"	2'-6"	6'-8.5"	4"	4"	4"	
D8	2'-4"	6'-8"	2'-4.5"	6'-8"	4"	4"	4"	
D9	2'-8"	6'-7.5"	2'-8"	6'-7.5"	3.75"	3.75"	3.75"	
D10	2'-6"	6'-6"	2'-6"	6'-6.5"	4"	4"	4"	
D11	2'-4"	6'-6"	2'-4"	6'-6.5"	2.5"	4"	4"	
D12	2'-6"	6'-6.5"	2'-6"	6'-7"	4"	4"	4"	
D13	2'-0.5"	5'-10.5"	2'-0.5"	5'-11"	6"	6"	6"	arch shaped trim
D14	2'-6"	6'-6.5"	2'-6"	6'-7"	4"	4"	4"	
D15	2'	5'-4"	2'	5'-4.5"	4"	4"	4"	
D16	2'	5'-4"	2'	5'-4.5"	4"	4"	4"	

[illegible]