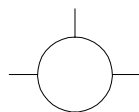
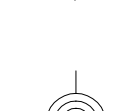
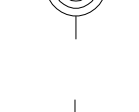
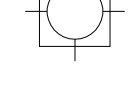
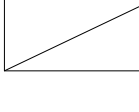
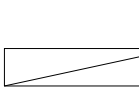
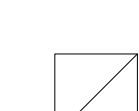
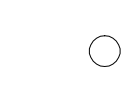
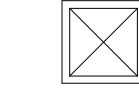
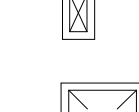
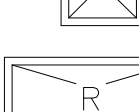
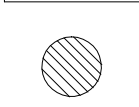
 
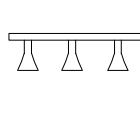
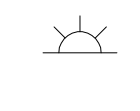
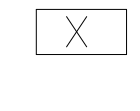
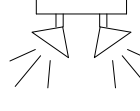
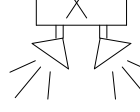
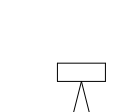
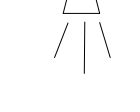
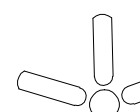
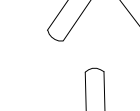


SYMBOLS LEGEND












RCP

-  EXHAUST VENT
-  CEILING MOUNTED LIGHT FIXTURE
-  CEILING MOUNTED DIRECTIONAL LIGHT
-  RECESSED CAN LIGHT
-  EYEBALL OR SMALL CAN LIGHT
-  PENDANT LIGHT
-  INDIVIDUAL FLUOR. LAY-IN FIXTURE 4 BULB
-  INDIVIDUAL FLUOR. HANGING FIXTURE 2 BULB
-  INDIVIDUAL FLUOR. FLUSH MOUNT FIXTURE 4 BULB
-  CAMERA
-  BLANK CEILING PLATE
-  MOTION DET.
-  SUPPLY VENT
-  SUPPLY VENT
-  RETURN VENT
-  RETURN VENT
-  SPEAKER




-  TRACK LIGHT OR VANITY LIGHT
-  WALL-MOUNTED LIGHT FIXTURE
-  EMERGENCY EXIT SIGN
-  EMERGENCY EXIT LIGHT
-  EMERGENCY EXIT LIGHT W/ SIGN
-  LIGHTED STAIR SIGN
-  FLOOD LIGHT
-  PHOTO CELL
-  CEILING FAN
-  CEILING FAN W/ LIGHT KIT
-  JUNCTION BOX

7-2-6 CEILING HEIGHT AND TRIM 7'-2" ABOVE FLOOR BELOW WITH 6" CROWN MOULDING. NOTE: ALL CEILINGS NOT LABELED ARE PLASTER. CEILINGS SHOWN WITH A GRID ARE LAY IN ACOUSTICAL TILE..


ELECTRIC

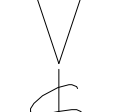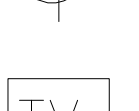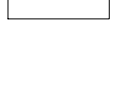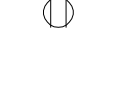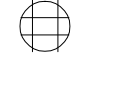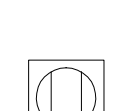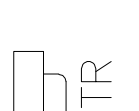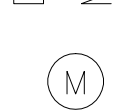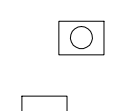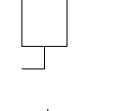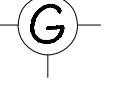-  DATA OUTLET
-  TELEPHONE JACK
-  ELECTRIC SWITCH
-  CABLE TELEVISION OUTLET
-  DUPLEX RECEPTACLE OUTLET
-  SPECIAL PURPOSE CONNECTION OR OUTLET
-  QUADRUPLX RECEPTACLE OUTLET
-  CEILING RECEPTACLE OUTLET
-  ELECTRIC PANEL
-  ELECTRIC METER
-  MOTION SENSOR
-  BUTTON SWITCH
-  DISCONNECT SWITCH
-  GROUND/FLOOR LIGHT
-  KEY PAD



 
FIRE PROTECTION

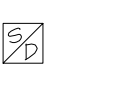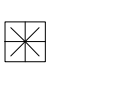-  FIRE EXTINGUISHER
-  FIRE PULL
-  FIRE ALARM (HORN/SRTOBE)
-  SMOKE DETECTOR
-  SMOKE ALARM SPEAKER
-  SPRINKLER HEAD CEILING MOUNT
-  SPRINKLER HEAD WALL MOUNT

MEP

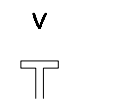
-  THERMOSTAT
-  FLOOR DRAIN
-  VALVE
-  HOSE BIB
-  WATER SUPPLY
-  SUSPENDED GAS HEATER

MISC

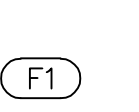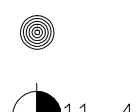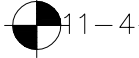
-  FURNITURE SCHEDULE LABEL
-  BOLLARD
-  11-4-11/16 SPOT ELEVATION

7-2-6

CEILING HEIGHT AND TRIM 7'-2" ABOVE FLOOR BELOW WITH 6" CROWN MOULDING. NOTE: ALL CEILINGS NOT LABELED ARE PLASTER. CEILINGS SHOWN WITH A GRID ARE LAY IN ACOUSTICAL TILE..

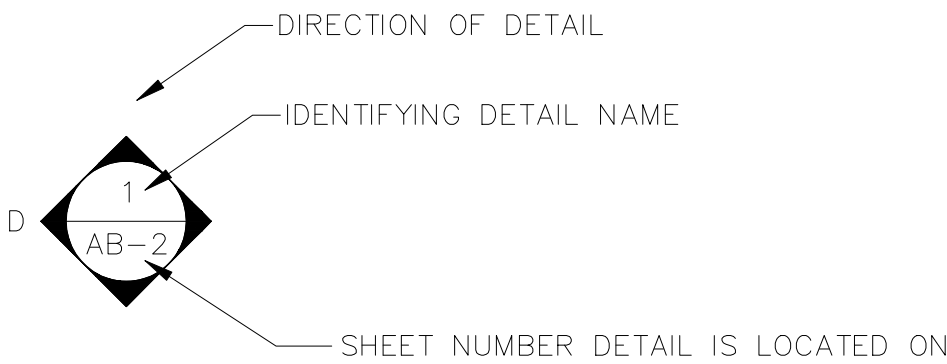

INTERIOR ELEVATIONS

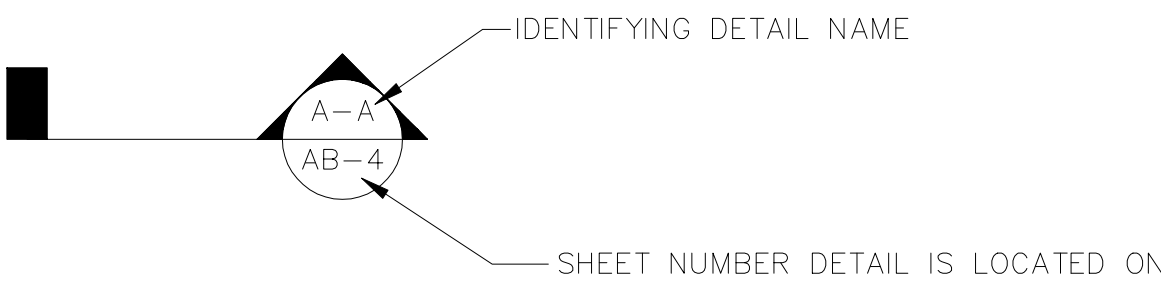

BUILDING SECTIONS

PHOTO DOCUMENTATION LEGEND

INDICATES LOCATION OF CAMERA

INDICATES CUSTOM PHOTO NUMBERING

TYPES OF DOCUMENTATION

GROUND BASED PHOTO 001

GROUND BASED VIDEO V-001

360° SPHERICAL PHOTO 123

AERIAL BASED PHOTO

AERIAL BASED VIDEO

As BUILT PROFESSIONALS
www.asbuiltprofessionals.com
A DIVISION OF:

AEC CONSULTANTS INC

844.272.8458
844 AS BUILT

© 2021 AEC CONSULTANTS INC

ARCHITECTURAL AS BUILT

New York, NY 10013

SL

**Scope of work Checklist includes: Floor Plans, RCP Heights, MEP Plans, Selected Interior Elevations, Furniture Plan-Schedule and Still Photos .

As BUILT

PROFESSIONALS

www.asbuiltprofessionals.com

A DIVISION OF:

AEC

CONSULTANTS INC

844.272.8458

844 AS BUILT

© 2021 AEC CONSULTANTS INC

ARCHITECTURAL AS BUILT

New York, NY 10013







NO.		ISSUES REVISIONS	DATE
			SHEET TITLE
FLOOR PLAN			
HL			PROJECT MANAGER
HL			PROJECT DIRECTOR
012317-1			PROJECT NUMBER
1/4"=1'-0"			SCALE
BB			DRAWN BY
			SHEET NUMBER




AB-1

****Scope of work Checklist includes: Floor Plans, RCP Heights, MEP Plans, Selected Interior Elevations, Furniture Plan-Schedule and Still Photos .**


 


BEDROOM 2 ELEVATIONS

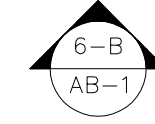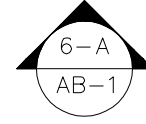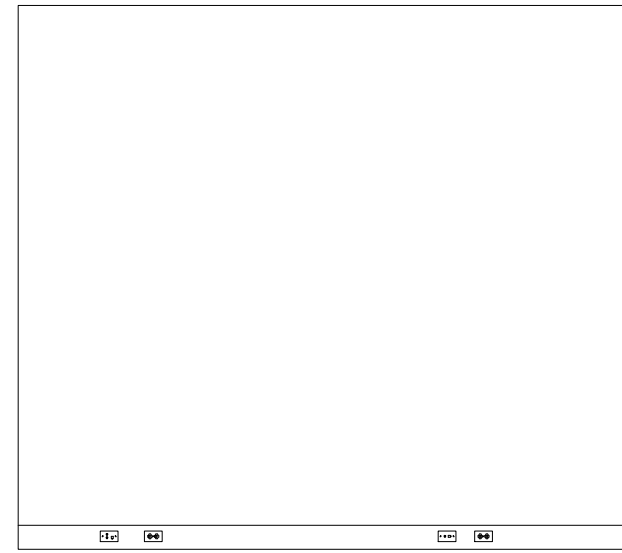








BEDROOM 3 ELEVATIONS

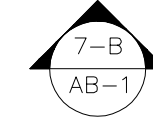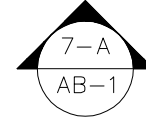 



MASTER BEDROOM ELEVATIONS

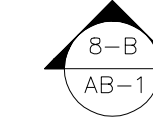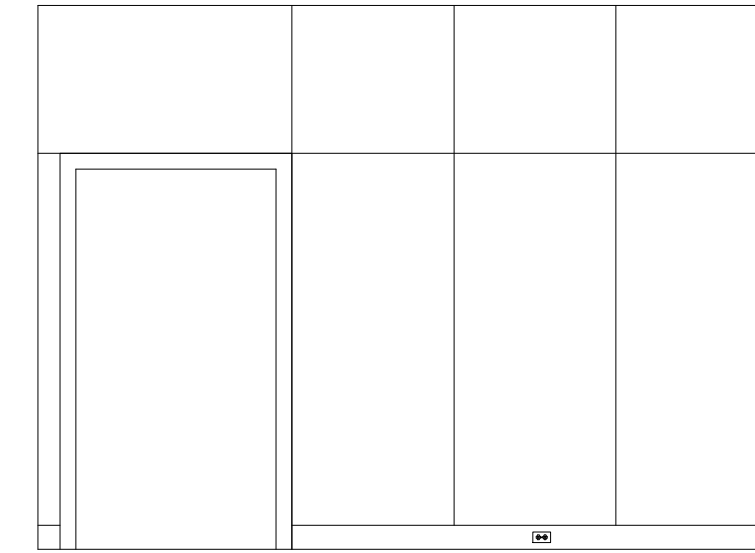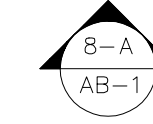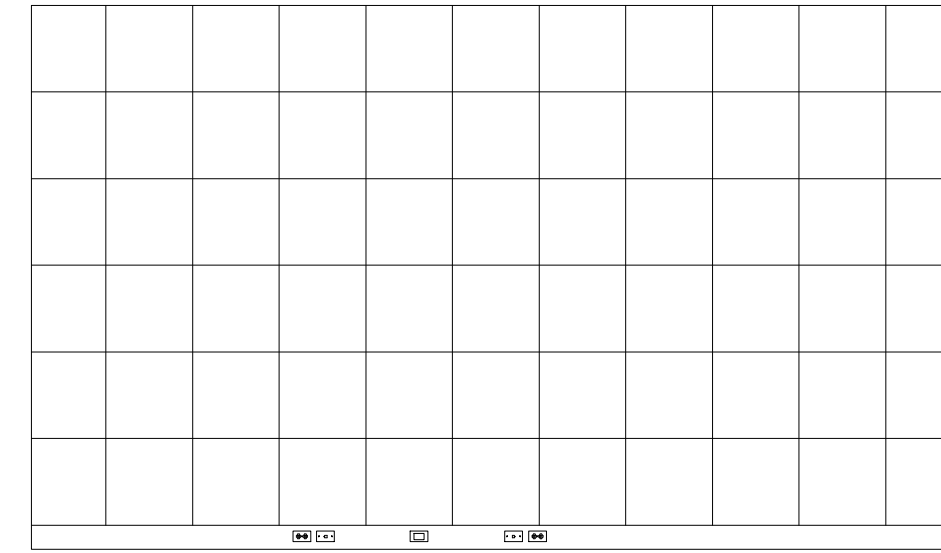



KITCHEN ELEVATIONS

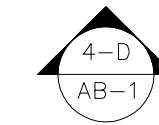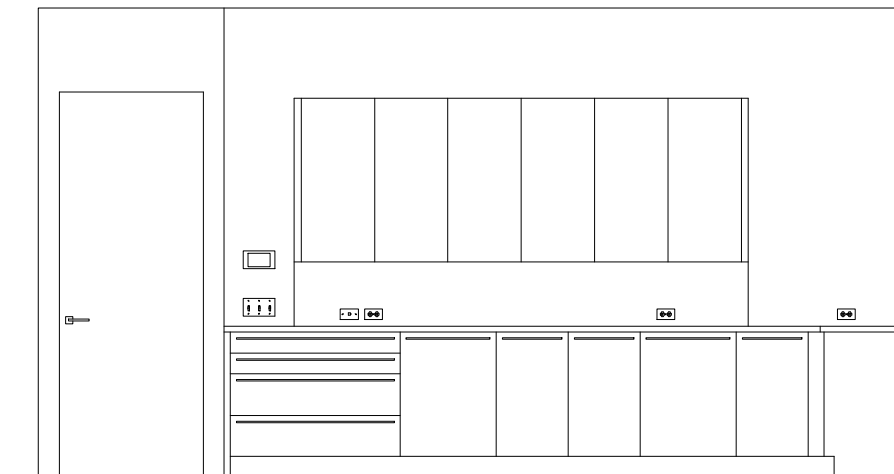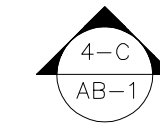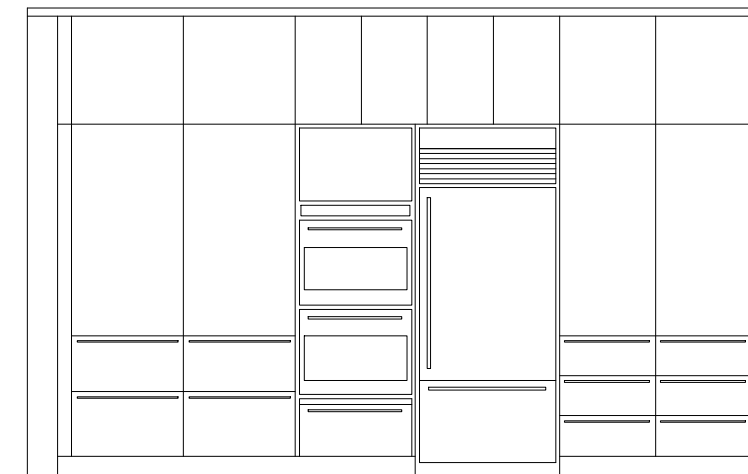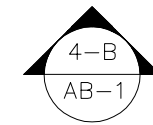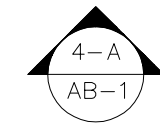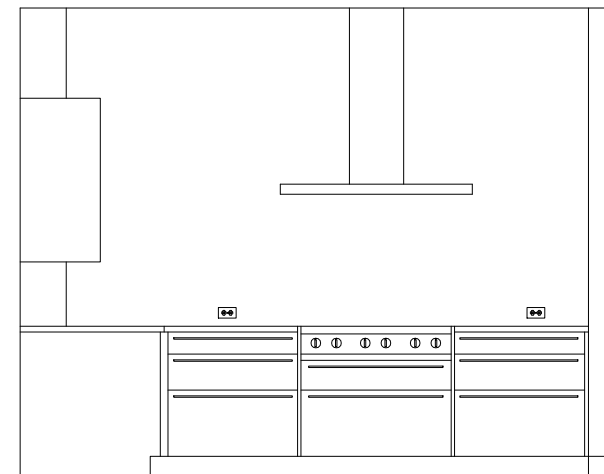


MEDIA ROOM ELEVATION

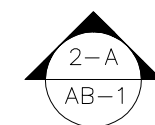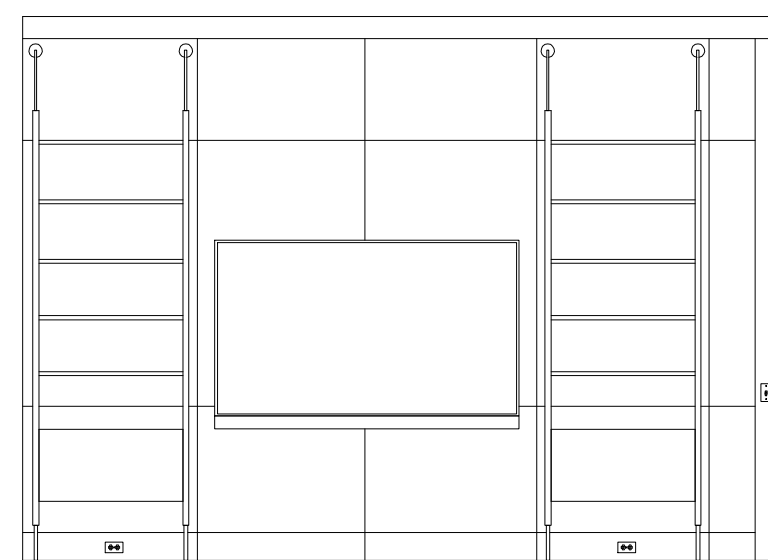









LIVING ROOM ELEVATION

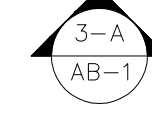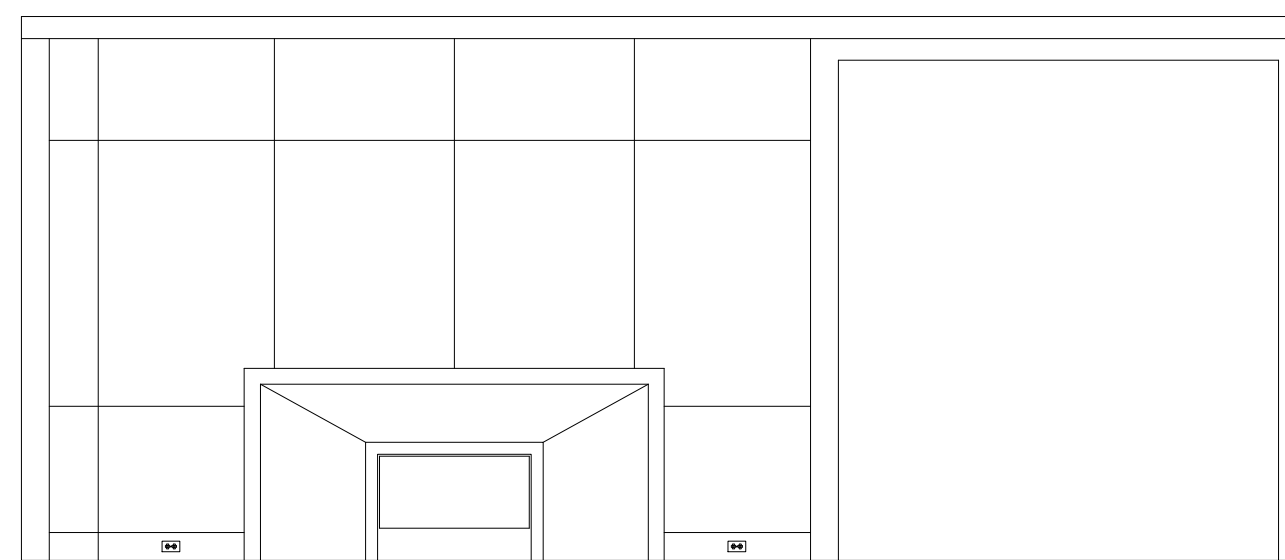

DINING ROOM ELEVATION

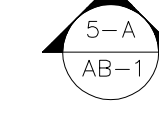

GALLERY ELEVATIONS

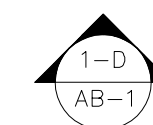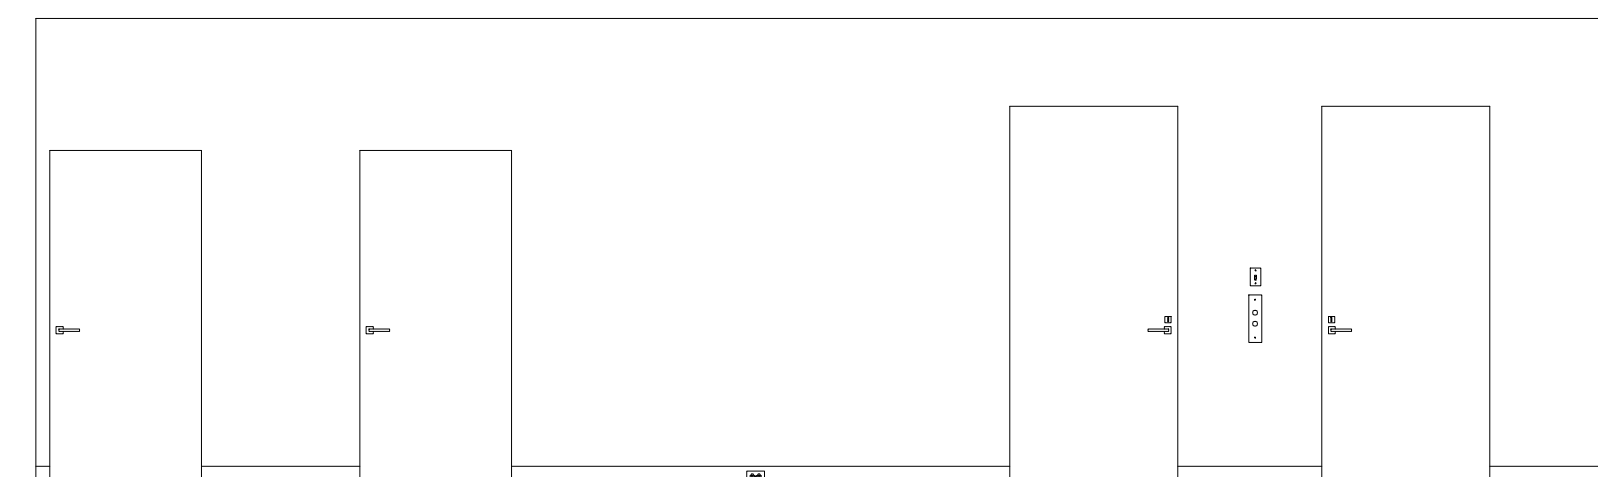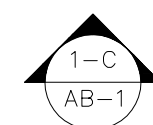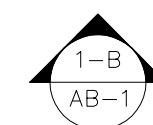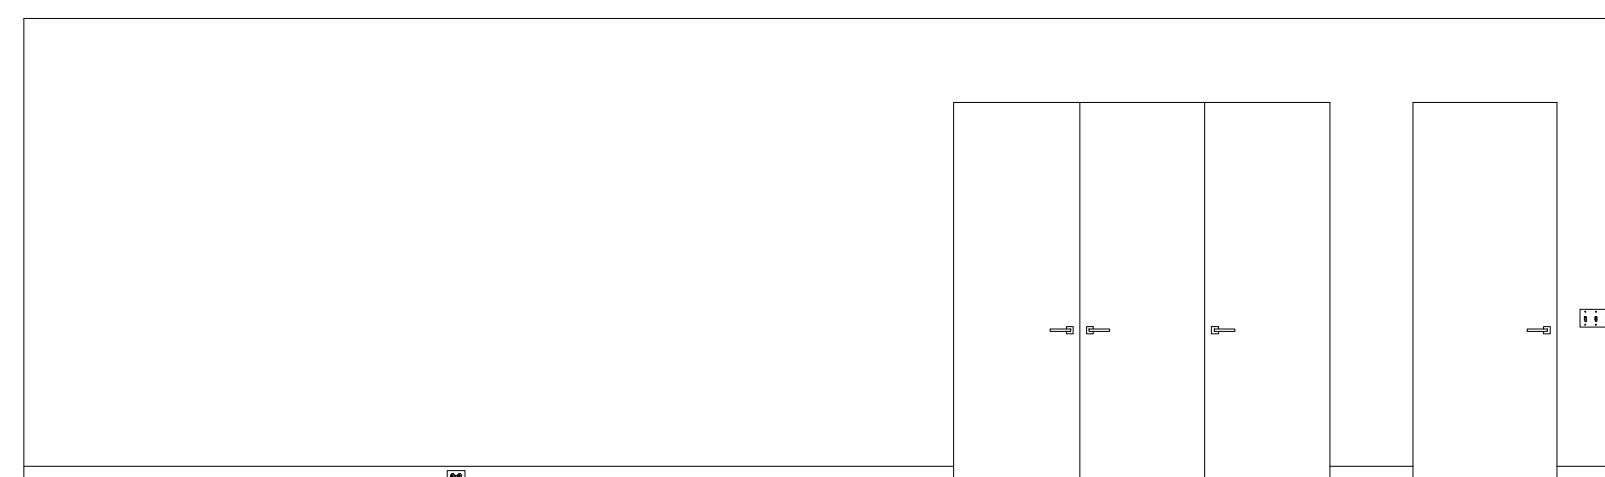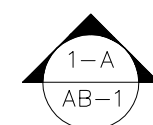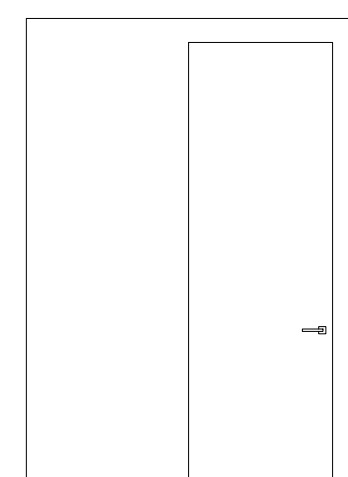 

ARCHITECTURAL AS BUILT

New York, NY 10013

01		
No.	ISSUES REVISIONS	DATE
		SHEET TITLE
INTERIOR ELEVATIONS		
HL		PROJECT MANAGER
HL		PROJECT DIRECTOR
012317-1		PROJECT NUMBER
1/4"=1'-0"		SCALE
BB		DRAWN BY
		SHEET NUMBER

AB-2

FURNITURE SCHEDULE

SYMBOL	KEY PHOTO	FURNITURE DESCRIPTION	APPROX. LxW	NOTES
F1	25	HALL TABLE	15.5"X65"	GLASS/METAL
F2	113	MEDIA BENCH	18"X70.5"	WOOD/METAL
F3	118	ROUND TABLE	43.5" DIA	GLASS/METAL
F4	110	LOUNGE CHAIR	40"X36"	LEATHER/VINYL
F5	110	OTTOMAN	24"X15"	LEATHER/VINYL
F6	110	END TABLE	20" DIA	COMPOSITE
F7	119	OTTOMAN (2)	38"X38"	UPHOLSTERED
F8	120-121	SOFA	12'-6" X 10'-6"	UPHOLSTERED
F9	122	END TABLE	30"X30"	WOOD
F10	135 and 139	SOFA TABLE (2)	12"X80"	WOOD/METAL
F11	136 and 138	SOFA (2)	42"X96"	UPHOLSTERED
F12	137	COFFEE TABLE	48"X72"	WOOD
F13	140 and 141	LOUNGE CHAIRS (2)	37"X26"	LEATHER/METAL
F14	140	OTTOMAN	20"X26"	LEATHER/METAL
F15	140	TABLE	23"X29"	COMPOSITE TRAPEZOID
F16	147	END TABLE	14" DIA	COMPOSITE
F17	148 and 149	CHAIRS (2)	36"X38"	UPHOLSTERED
F18	150	CORNER TABLE	28" DIA	WOOD
F19	153-154	GAME TABLE	40"X40"	COMPOSITE W/PULL SEATS
F20	174	DINING BUFFET	18"X84"	WOOD/METAL
F21	304-306	HEADBOARD/ENDS	82" INSIDE H.B	(2) 25"X19" ENDS WOOD
F22	314	DRESSER	23"X54"	WOOD
F23	315	LOUNGE CHAIR	32"X36"	VINYL/WOOD TRIM
F24	315	OTTOMAN	28"X16"	VINYL/WOOD TRIM
F25	356	HEADBOARD	3.5"X84"	WOOD/METAL
F26	355 and 357	NIGHT TABLES (2)	14"X15"	WOOD/METAL
F27	346	END TABLE	16" DIA	GLASS/METAL
F28	346	LOUNGE CHAIR	32"X32"	UPHOLSTERED
F29	346	OTTOMAN	22"X26"	UPHOLSTERED
F30	345	DRESSER	20"X68"	WOOD/METAL
F31	393 and 396	NIGHT TABLES (2)	24"X39"	WOOD/COMPOSITE
F32	394 and 395	BED FRAME	80"X83" INSIDE	2"X84"HB - 8"X84"FB
F33	399 and 401	CHAIRS (2)	42"X40"	UPHOLSTERED
F34	400	END TABLE	24" DIA	GLASS/METAL
F35	398	END TABLE	30" DIA	GLASS/WOOD/METAL
F36	397	SOFA	44"X84"	UPHOLSTERED
F37	430	TUB END TABLE	16"X27"	GLASS COMPOSITE/METAL
F38	491 and 493	CHAIRS (2)	32"X24"	WOOD/CUSHIONS
F39	492	TABLE	16" DIA	GLASS/METAL
F40	496-498	BOOKSHELF TOWER	17"X51"	WOOD
F41	494	COFFEE TABLE	21.5"X43.5"	WOOD/GLASS
F42	495	LOVESEAT	32"X54"	UPHOLSTERED
F43	499 and 500	EXECUTIVE DESK	32"X66"	WOOD
F44	501 and 502	COMPUTER STAND	22"X20"	WOOD
F45	454	DRESSING SEAT	32.5"X23"	UPHOLSTERED

**Scope of work Checklist includes: Floor Plans, RCP Heights, MEP Plans, Selected Interior Elevations, Furniture Plan-Schedule and Still Photos .



ARCHITECTURAL AS BUILT
New York, NY 10013

01		
NO.	ISSUES REVISIONS	DATE
SHEET TITLE		
FURNITURE SCHEDULE		
HL	PROJECT MANAGER	
HL	PROJECT DIRECTOR	
012317-1	PROJECT NUMBER	
NTS	SCALE	
BB	DRAWN BY	
SHEET NUMBER		

AB-3