



SYMBOLS LEGEND

RCP

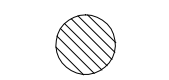

SPEAKER

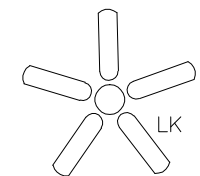


CEILING FAN
W/ LIGHT KIT

JUNCTION BOX

ELECTRIC



KEY PAD

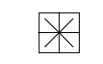


SPRINKLER HEAD WALL MOUNT

MEP



SUSPENDED GAS HEATER

MISO

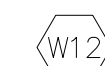

WINDOW SCHEDULE LABEL



11-4-11/16 SPOT ELEVATION

PHOTO DOCUMENTATION LEGEND




AERIAL BASE
VIDEO

AERIAL BASED
VIDEO

— SHEET NUMBER DETAIL IS LOCATED ON

INTERIOR ELEVATIONS

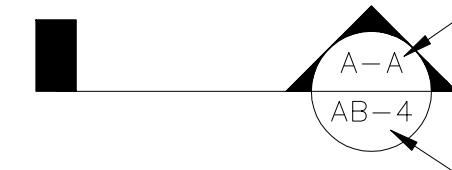

— SHEET NUMBER DETAIL IS LOCATED ON

BUILDING SECTIONS

AS BUILT
PROFESSIONALS
www.asbuiltprofessionals.com
A DIVISION OF:

DIVISION OF:

AEC
CONSULTANTS INC

844.272.8458
344 A S B U I L T

© 2020 AEC CONSULTANTS INC

ARCHITECTURAL AS BUILT ROCKY CREEK APARTMENTS

Tampa, FL 33634

SYMBOLS LEGEND

OWN BY

SL

PORCH
7'-11" C.H.

CLOSET
7'-11" C.H.

BEDROOM
7'-11" C.H.

BATH
7'-11" C.H.

LIVING/DINING AREA
7'-11" C.H.

KITCHEN
7'-11" C.H.

PANTRY
7'-11" C.H.

W1, W2, W3, W775,

ITEM	Total Count
Outlets	25
Phone Jacks	6
Data Ports	1
Cable Jacks	3
Switches	15
Dryer Outlet	1
Range Outlet	1



AS BUILT
PROFESSIONALS

www.asbuiltprofessionals.com

A DIVISION OF:



AEC

— □ —


CONSULTANTS INC

844.272.8458
844 AS BUILT

© 2020 AEC CONSULTANTS INC

**ARCHITECTURAL AS BUILT
ROCKY CREEK APARTMENTS
Tampa, FL 33634**


01	
NO.	ISSUES REVISIONS
	DATE
SHEET TITLE	
1 BEDROOM UNIT 305 FLOOR PLAN	
HL	PROJECT MANAGER
HL	PROJECT DIRECTOR
012317-1	PROJECT NUMBER
3/8"=1'-0"	SCALE
BB	DRAWN BY
SHEET NUMBER	
AB-1	

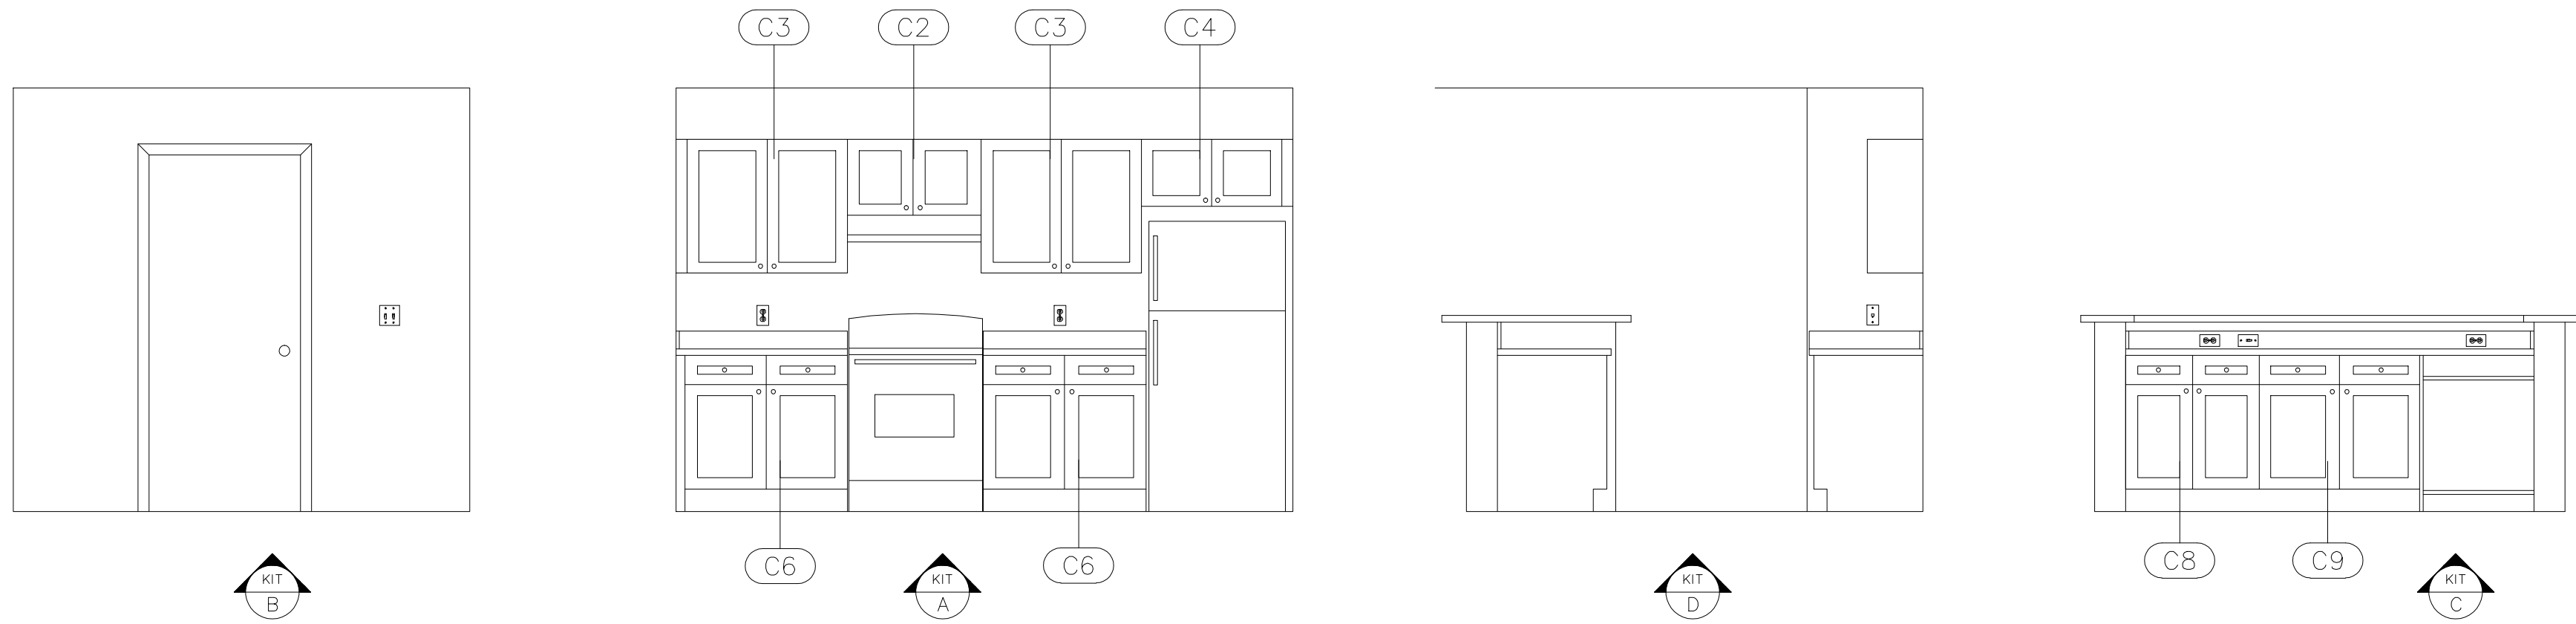


2 BEDROOM COUNT

ITEM	Total
Outlets	32
Phone Jacks	7
Data Ports	1
Cable Jacks	5
Switches	21
Dryer Outlet	1
Range Outlet	1


KITCHEN ELEVATIONS

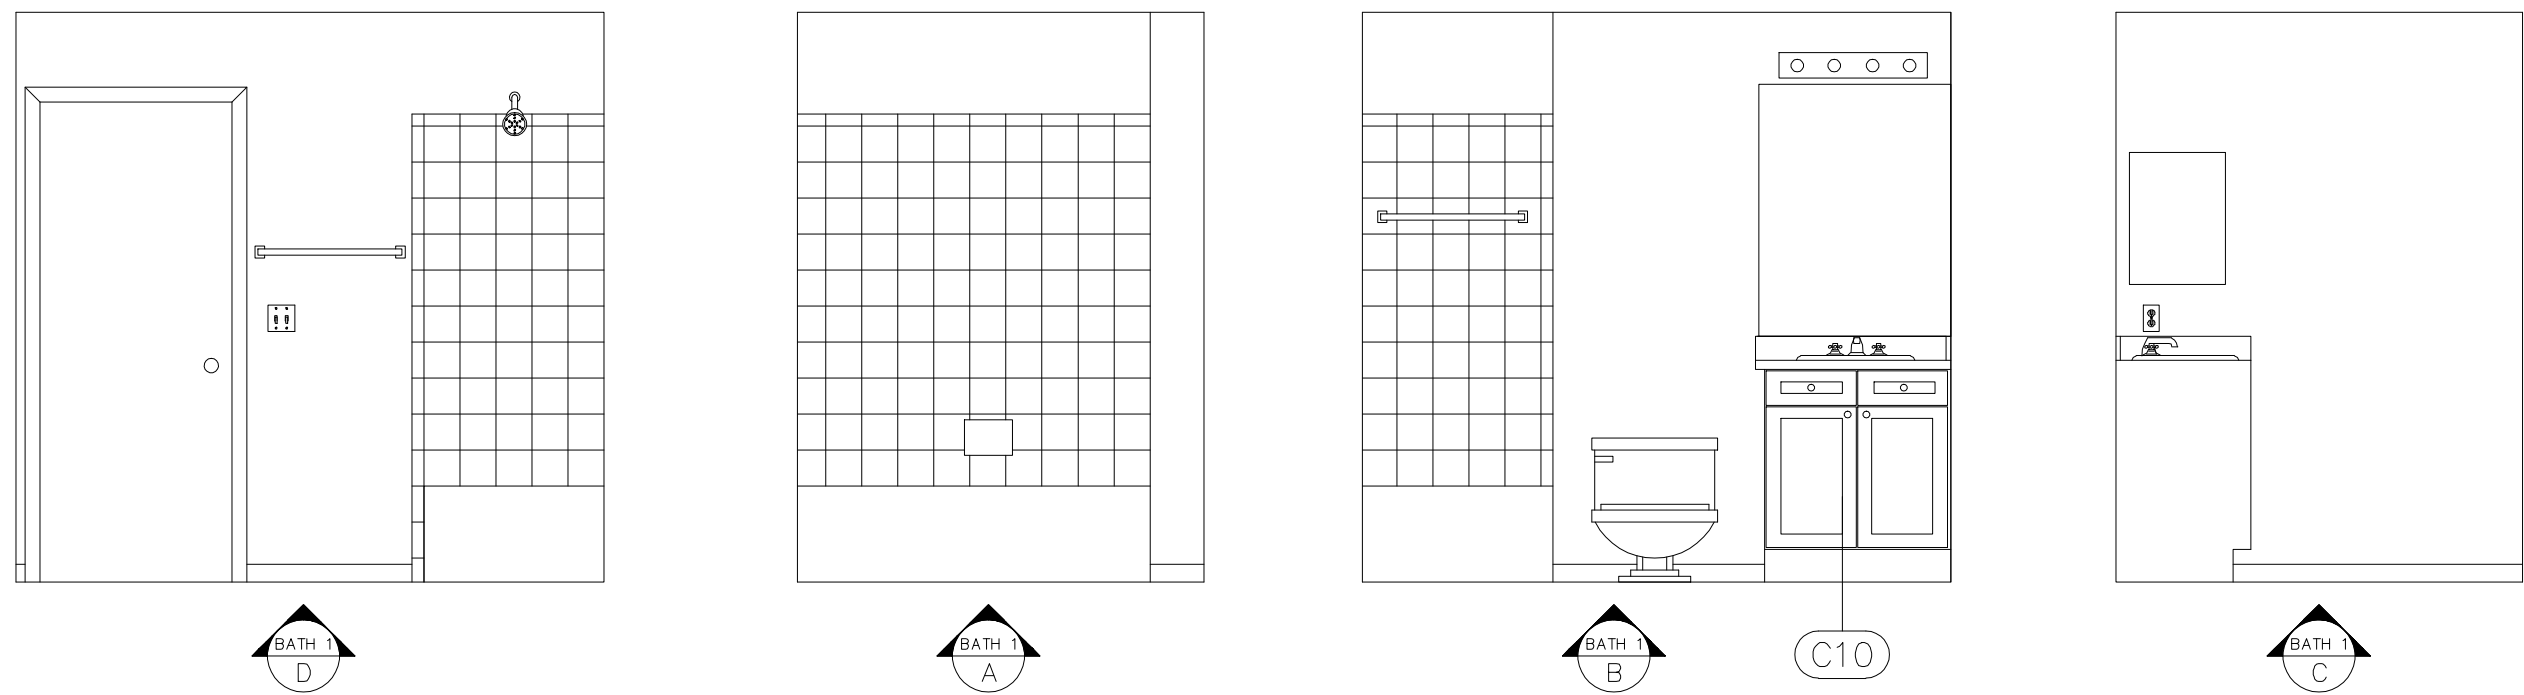

BATHROOM 1 ELEVATIONS

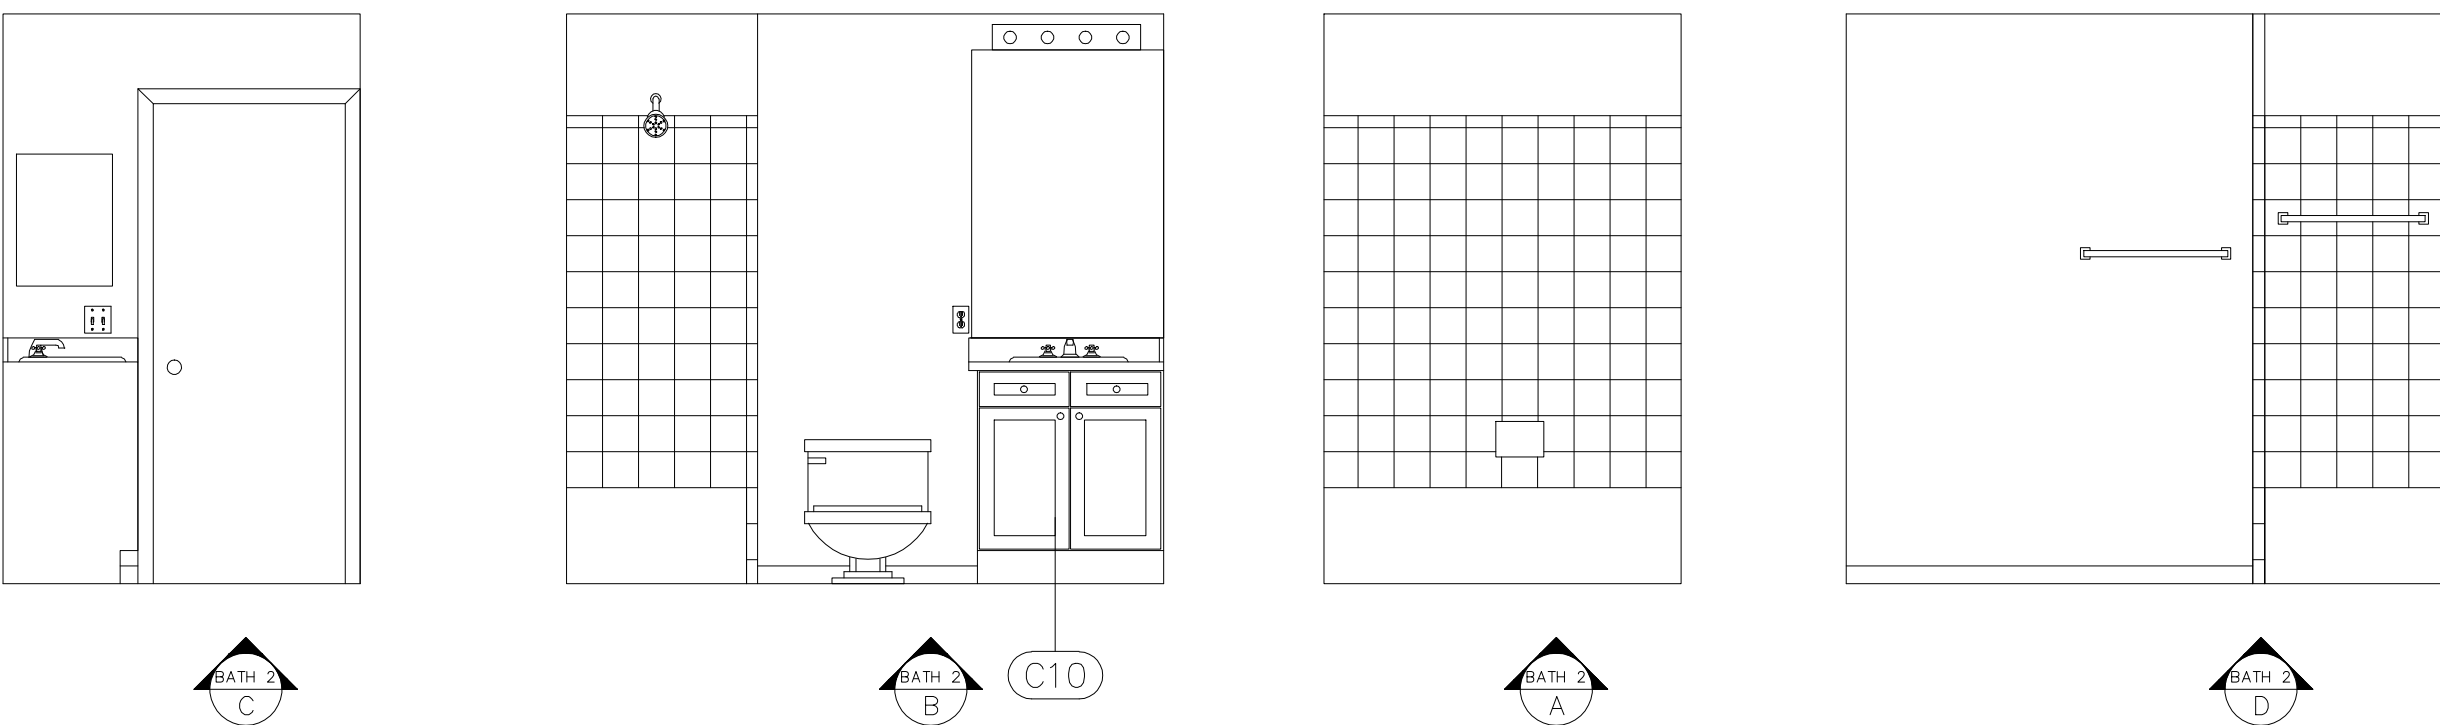

BATHROOM 2 ELEVATIONS

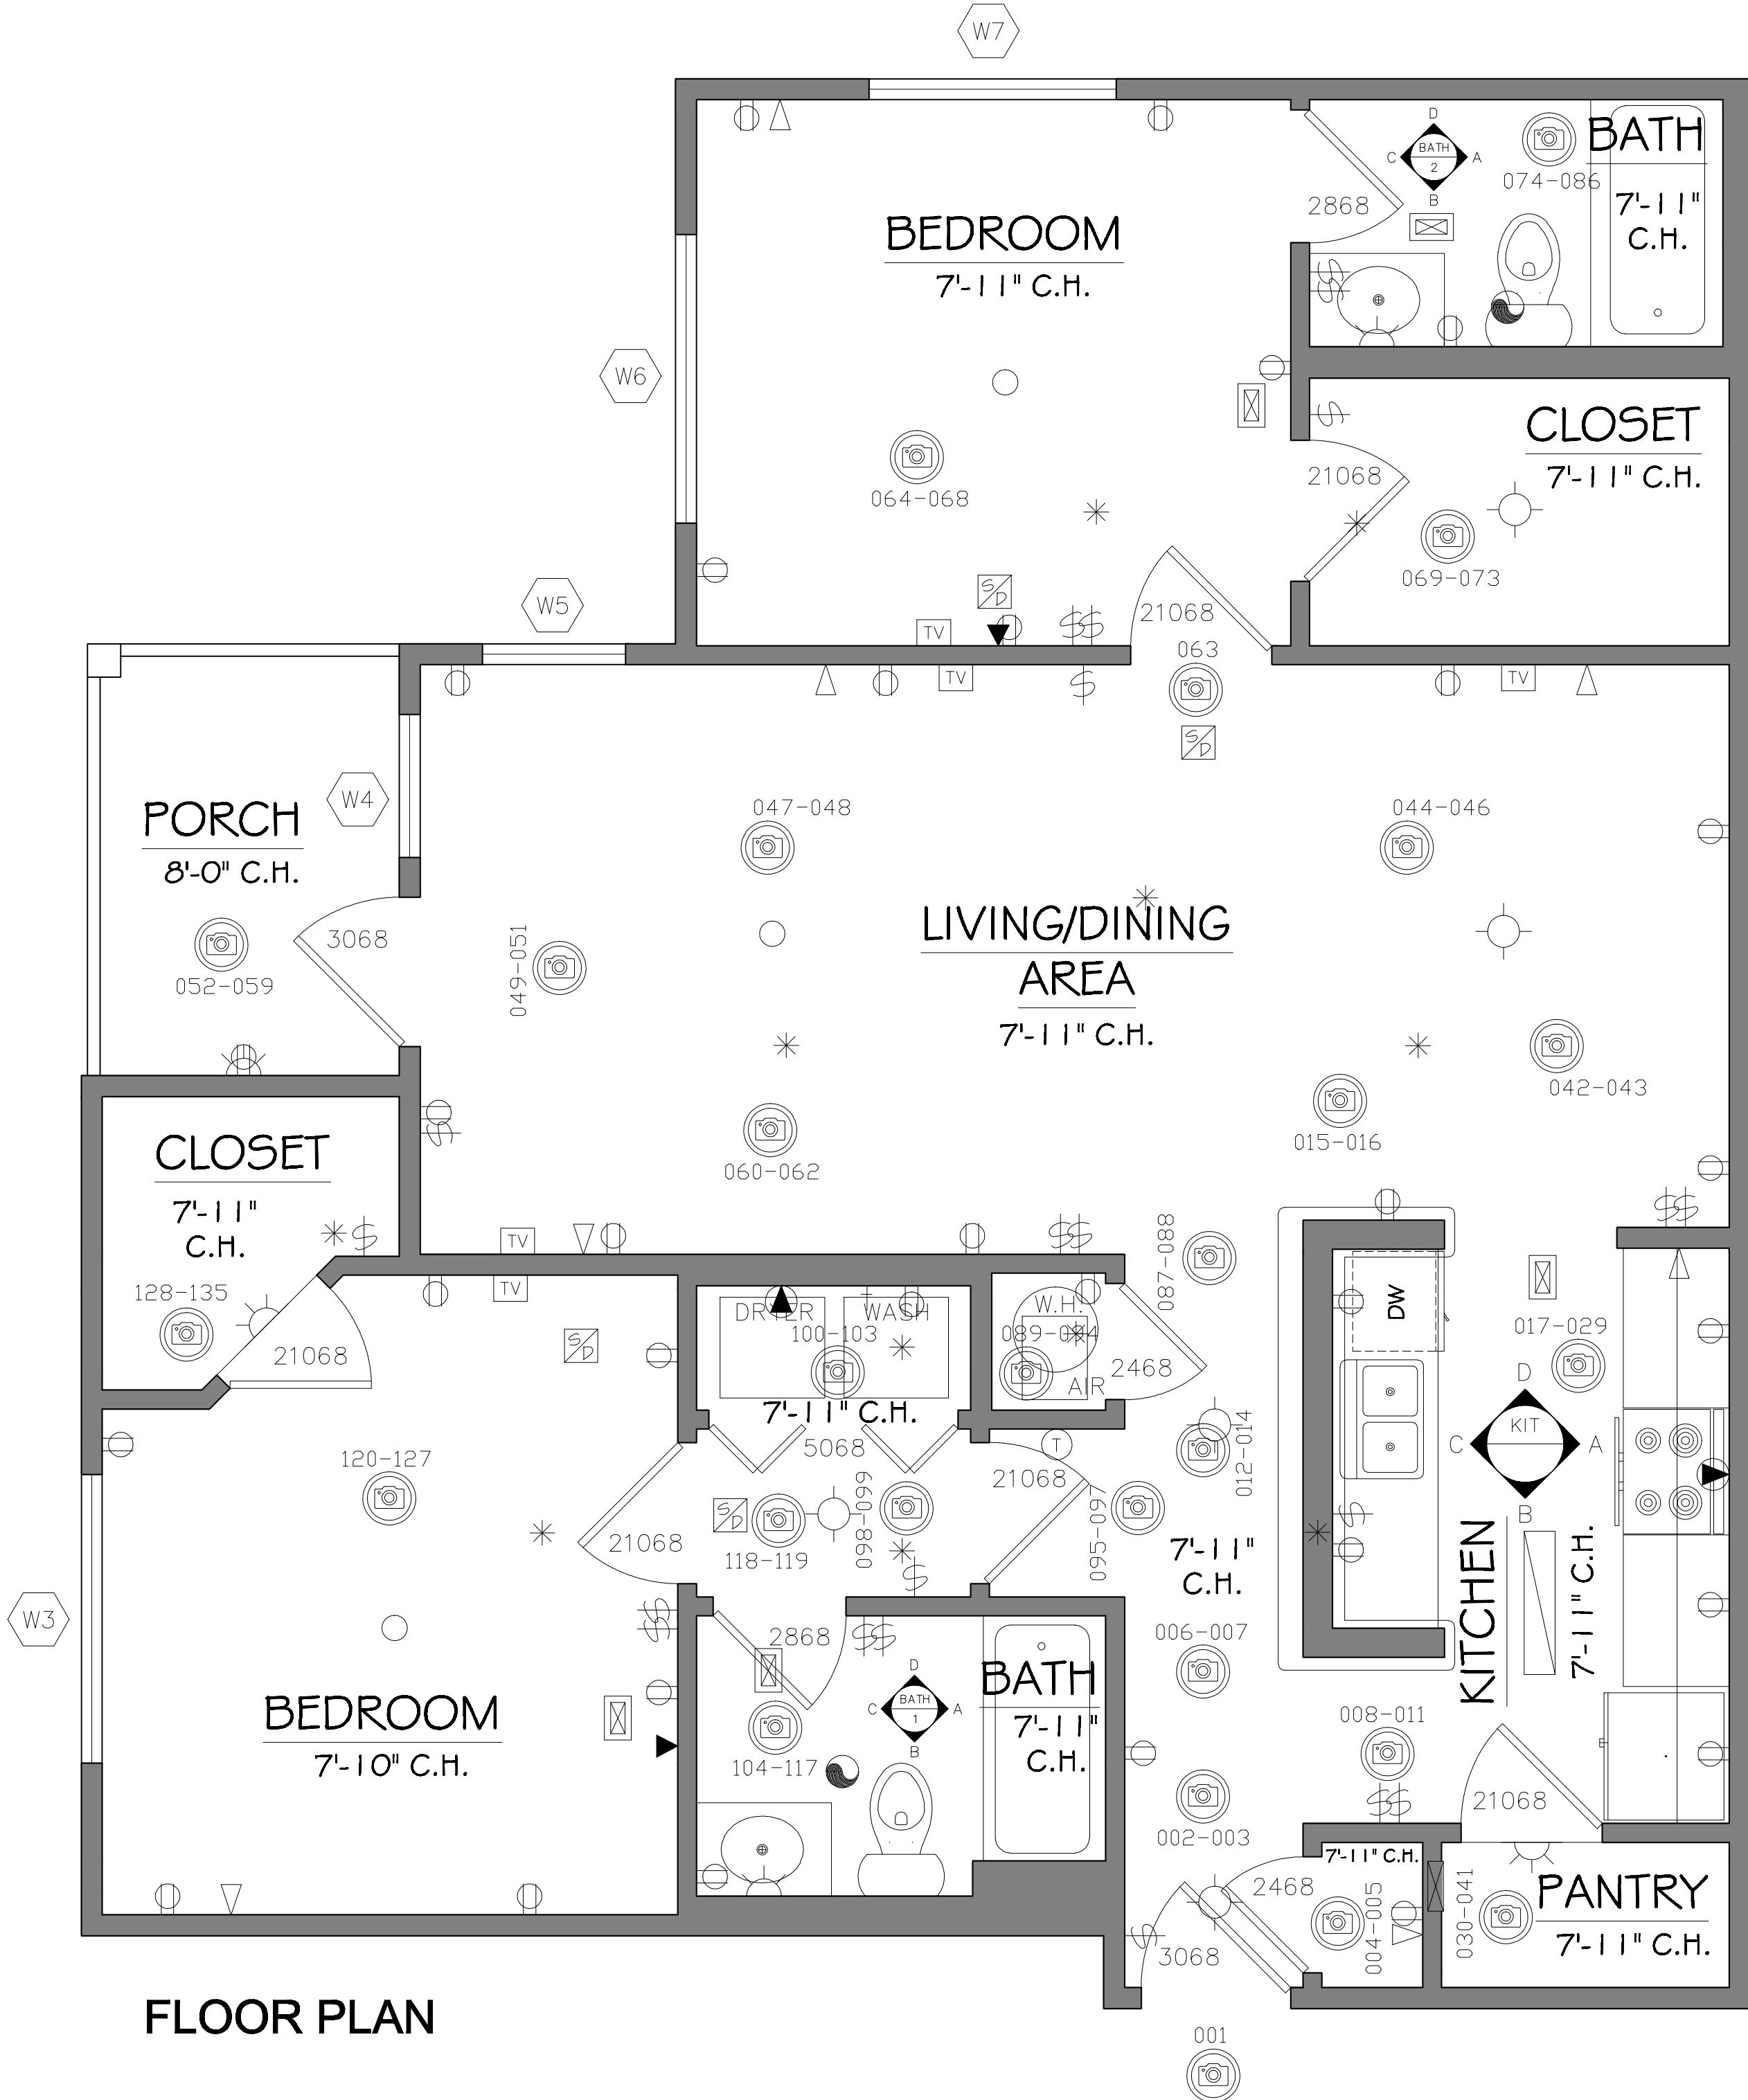

FLOOR PLAN

As BUILT

PROFESSIONALS

www.asbuiltprofessionals.com

A DIVISION OF:

AEC

CONSULTANTS INC

844.272.8458

844 AS BUILT


© 2020 AEC CONSULTANTS INC

ARCHITECTURAL AS BUILT

ROCKY CREEK APARTMENTS

Tampa, FL 33634

01	NO.	ISSUES REVISIONS	DATE
			SHEET TITLE
			2 BEDROOM UNIT 307 FLOOR PLAN
HL			PROJECT MANAGER
HL			PROJECT DIRECTOR
012317-1			PROJECT NUMBER
3/8"=1'-0"			SCALE
BB			DRAWN BY
			SHEET NUMBER

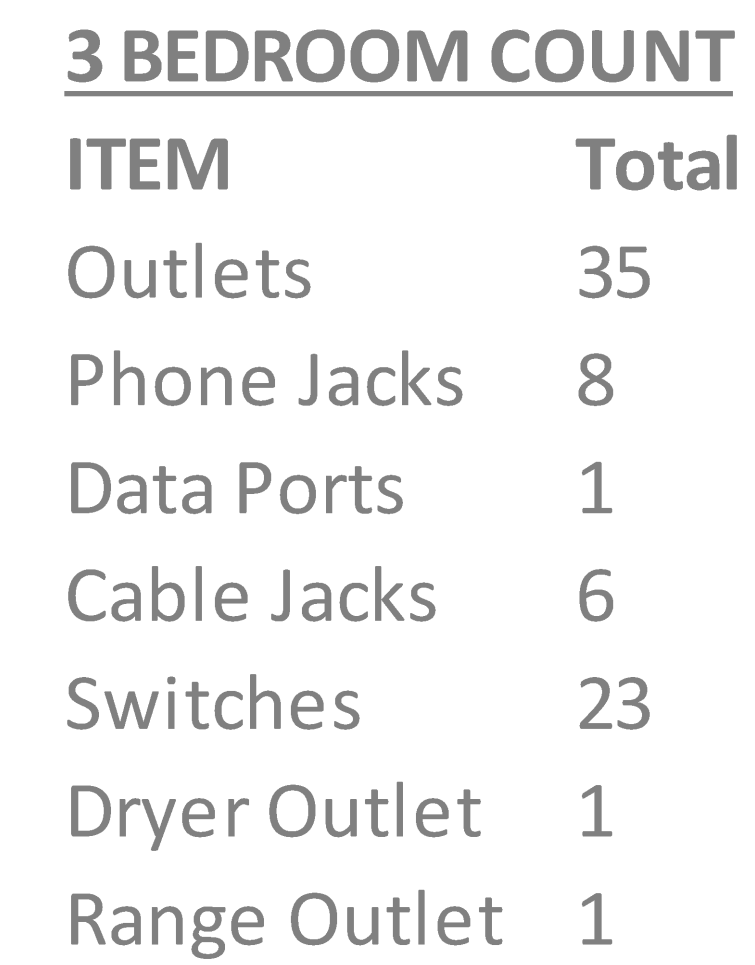

FLOOR PLAN

The floor plan shows a 3-bedroom, 2-bath house with a dining/living area, kitchen, and porch. The rooms and their dimensions are:

- Bedroom (Top Left):** 7'-11" C.H.
- Bedroom (Top Right):** 7'-11" C.H.
- Bedroom (Bottom Right):** 7'-10" C.H.
- Bedroom (Bottom Left):** 7'-10" C.H.
- Bath (Top Center):** 7'-11" C.H.
- Bath (Bottom Center):** 7'-10" C.H.
- Dining/Living Area:** 7'-10" C.H.
- Kitchen:** 7'-10" C.H.
- Pantry:** 7'-10" C.H.
- Porch:** 8'-11" DECK
- Closets:** 7'-11" C.H. (Top Left), 7'-11" C.H. (Top Right), 7'-10" C.H. (Bottom Right), 7'-11" C.H. (Bottom Left).


The plan includes various symbols for doors, windows, and furniture. The text "FLOOR PLAN" is centered at the bottom.

AB-3

ARCHITECTURAL AS BUILT














ROCKY CREEK APARTMENTS

Tampa, FL 33634

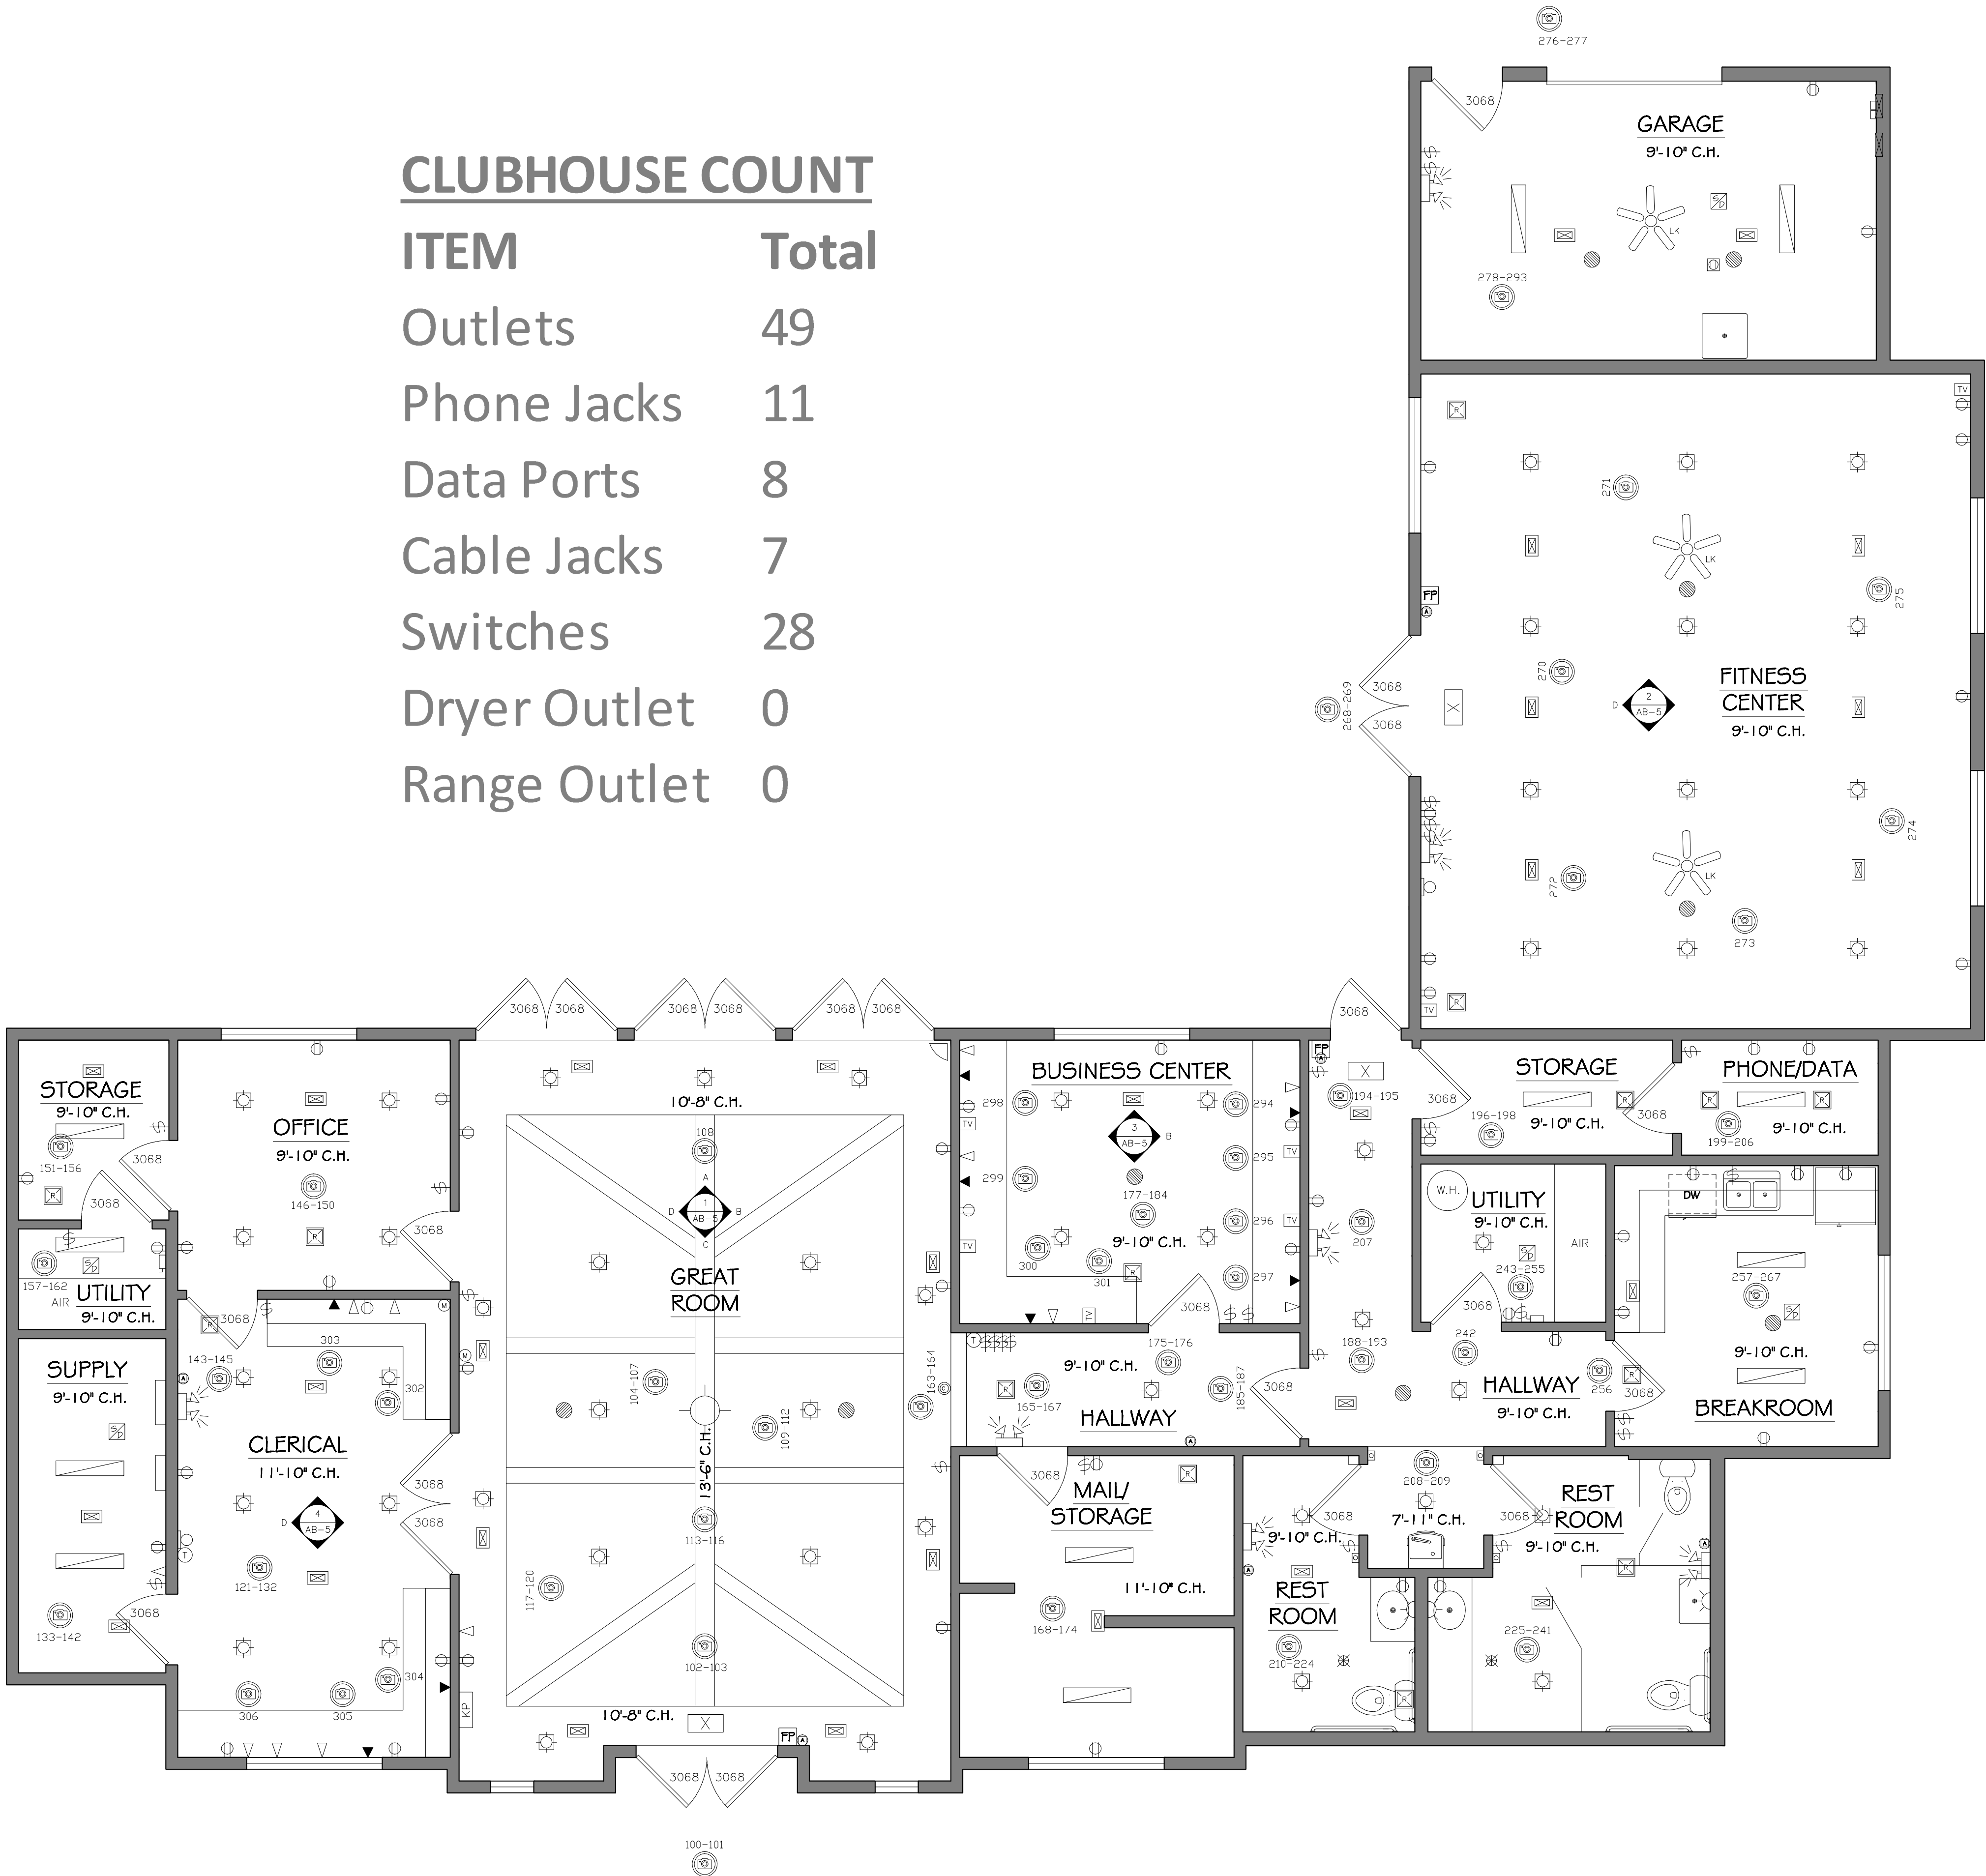




01		
NO.	ISSUES REVISIONS	DATE
		SHEET TITLE
CLUBHOUSE FLOOR PLAN		
HL	PROJECT MANAGER	
HL	PROJECT DIRECTOR	
012317-1	PROJECT NUMBER	
1/4"=1'-0"	SCALE	
BB	DRAWN BY	
	SHEET NUMBER	

AB-4

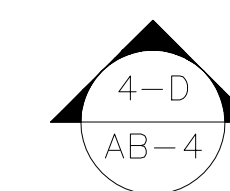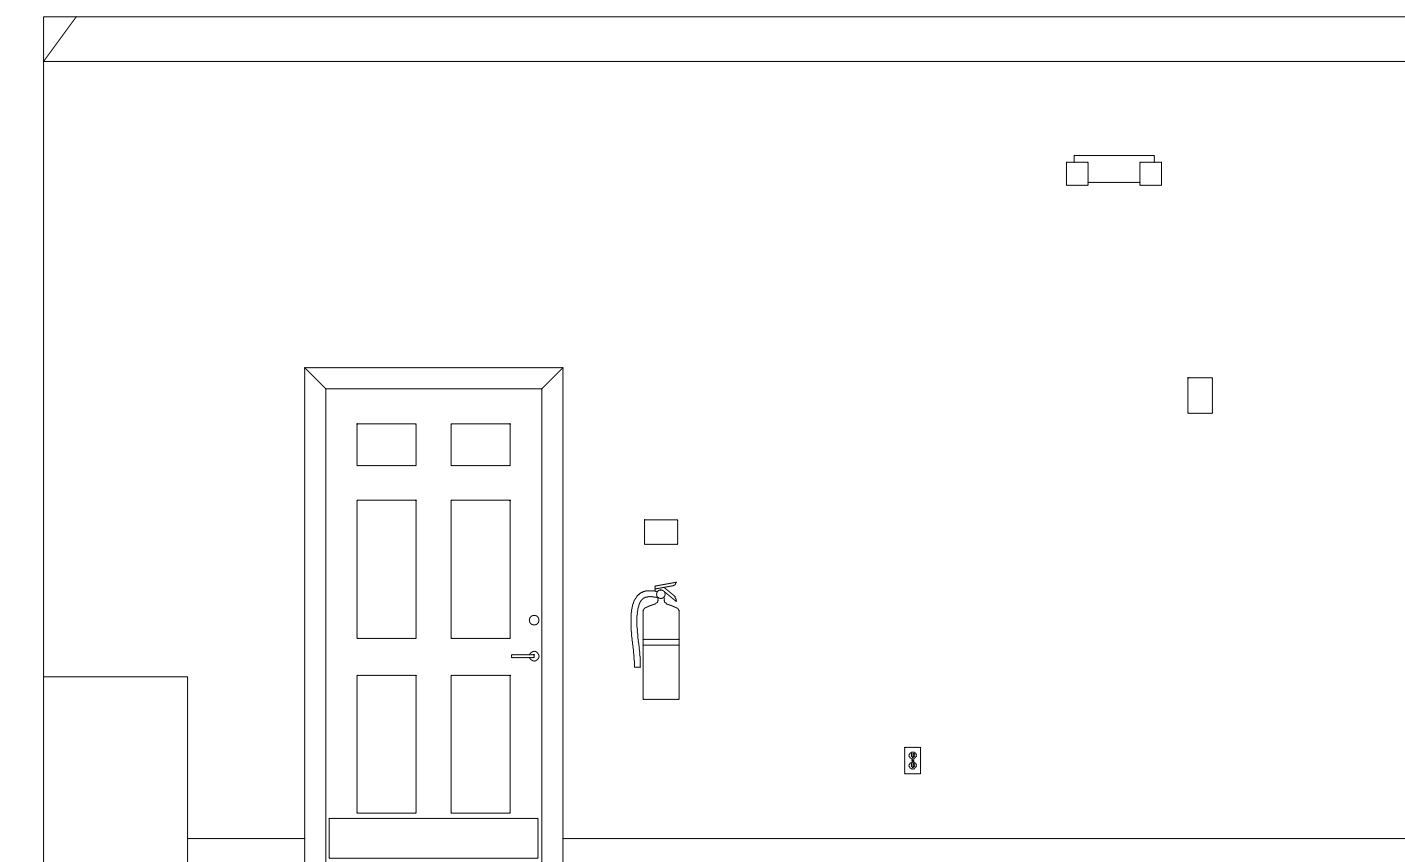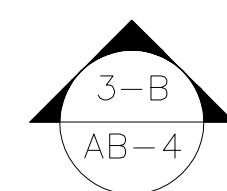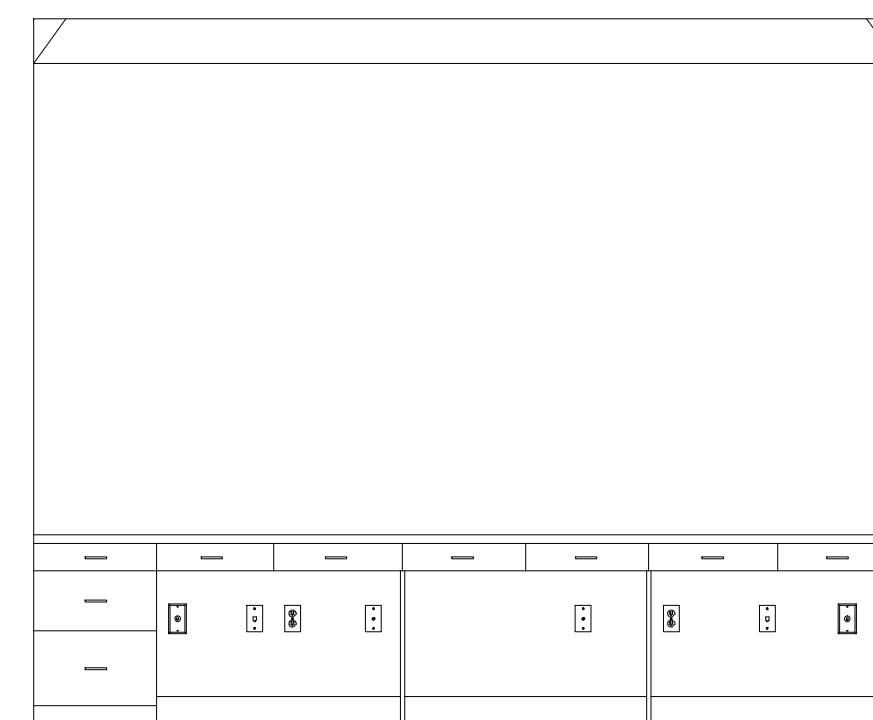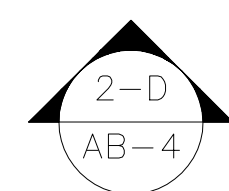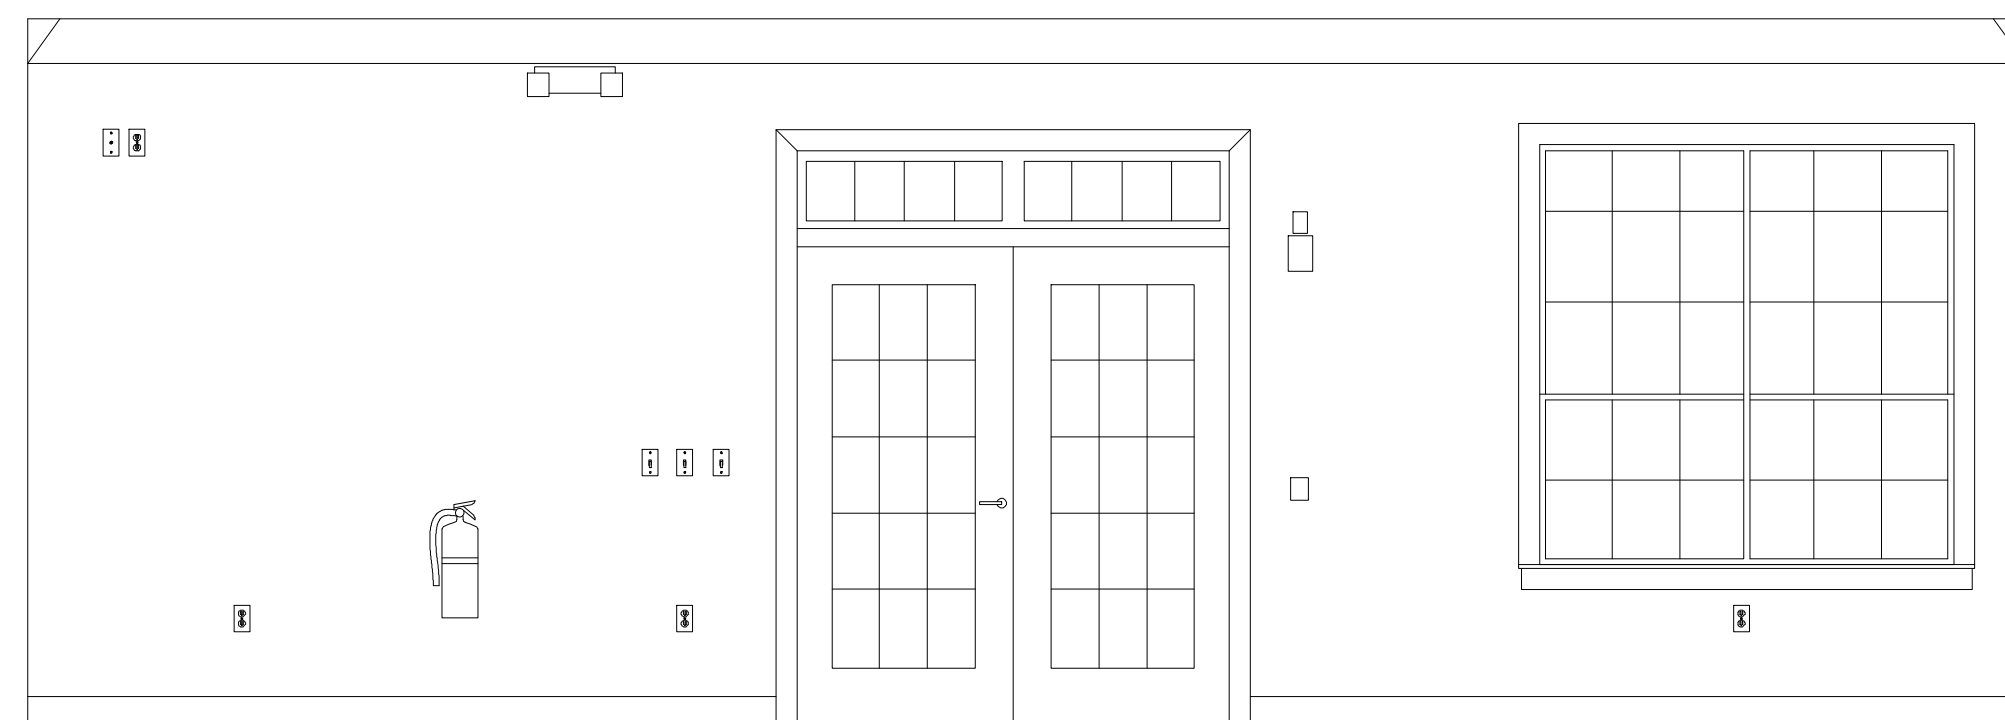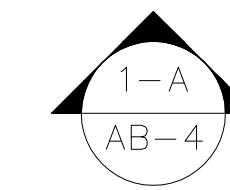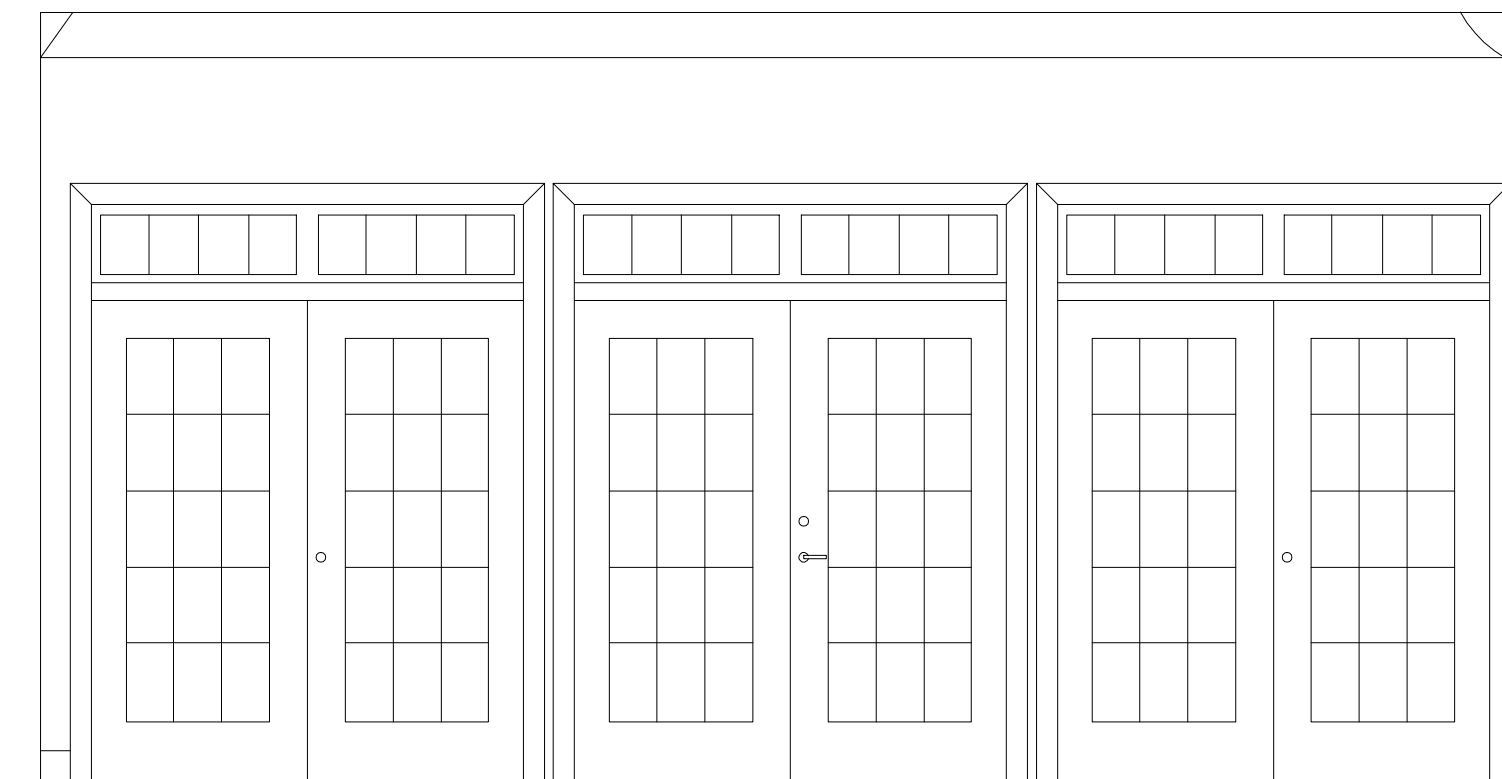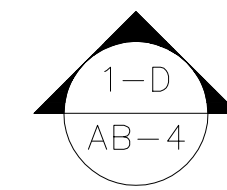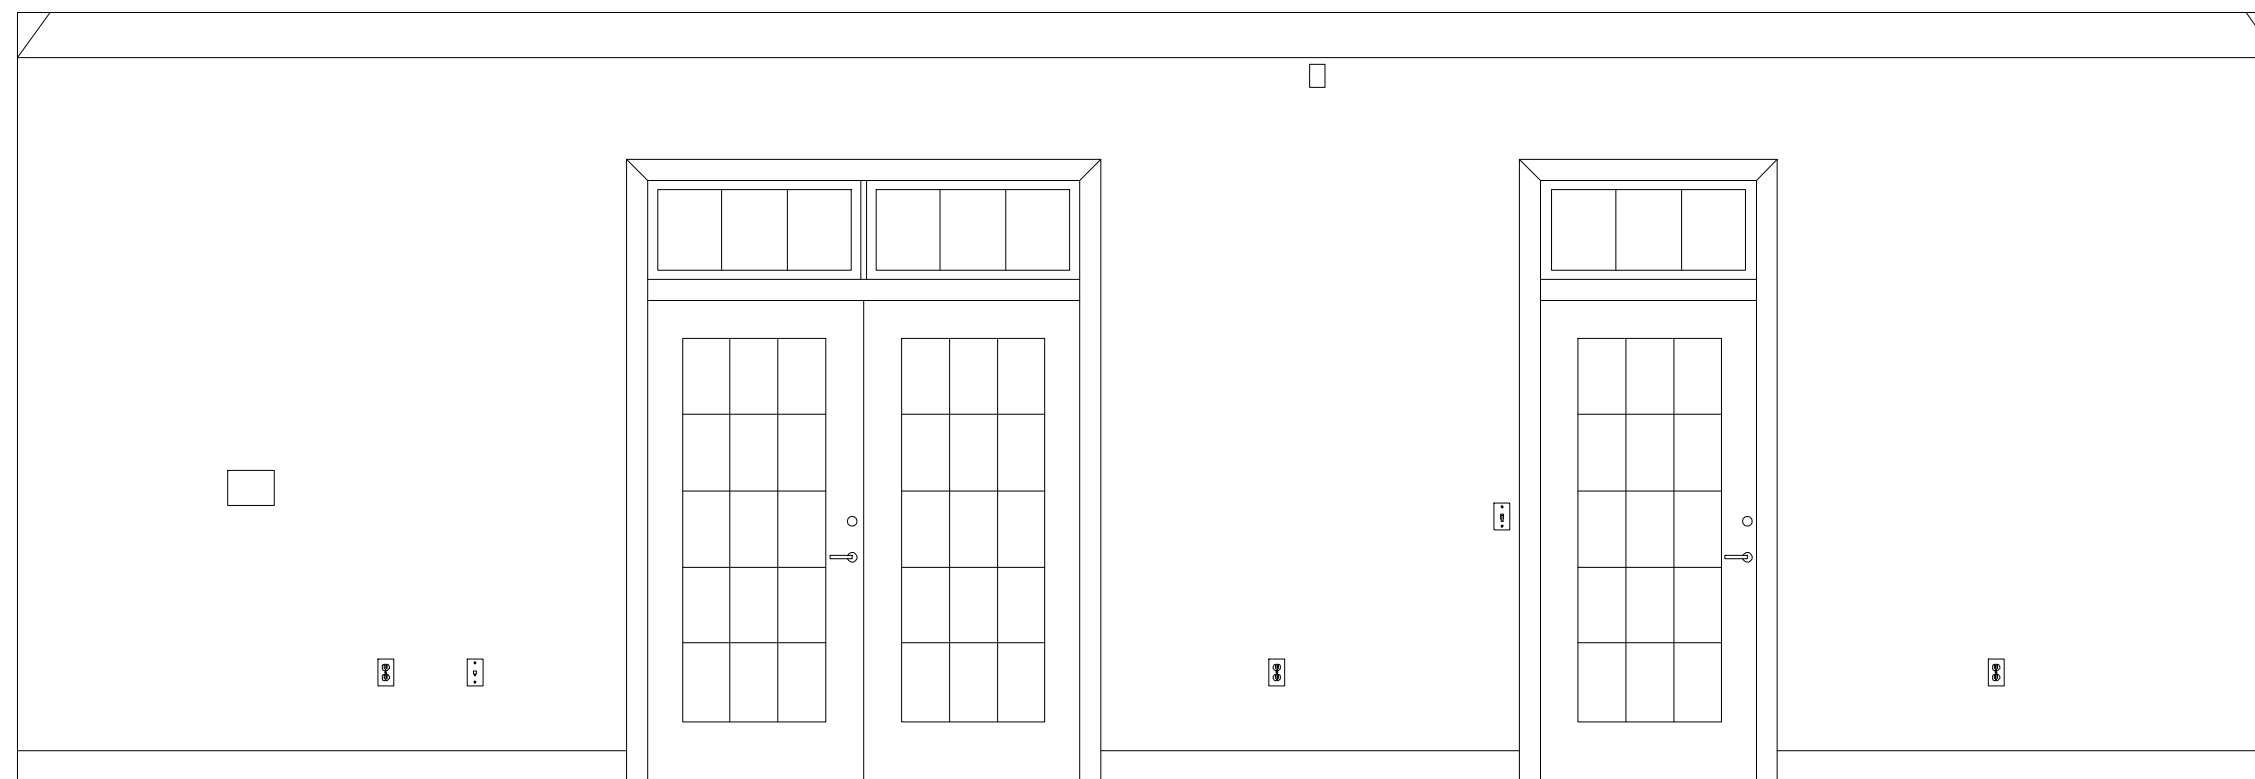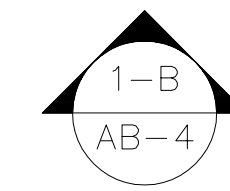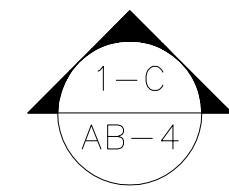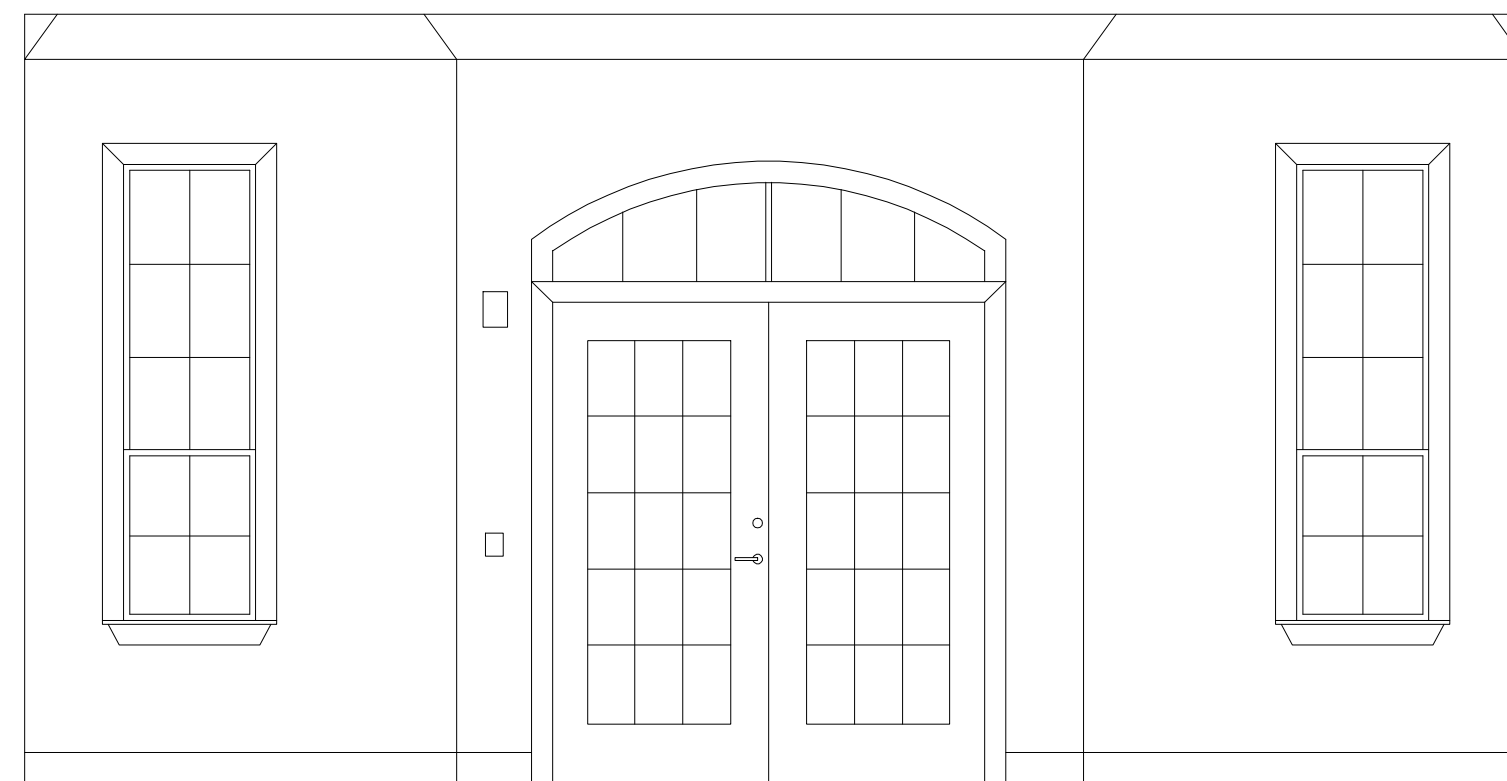

**ARCHITECTURAL AS BUILT
ROCKY CREEK APARTMENTS
Tampa, FL 33634**

01		
NO.	ISSUES REVISIONS	DATE
		SHEET TITLE
CLUBHOUSE ELEVATIONS		
HL	PROJECT MANAGER	
HL	PROJECT DIRECTOR	
012.317-1	PROJECT NUMBER	
3/8"=1'-0"		SCALE
BB	DRAWN BY	
	SHEET NUMBER	

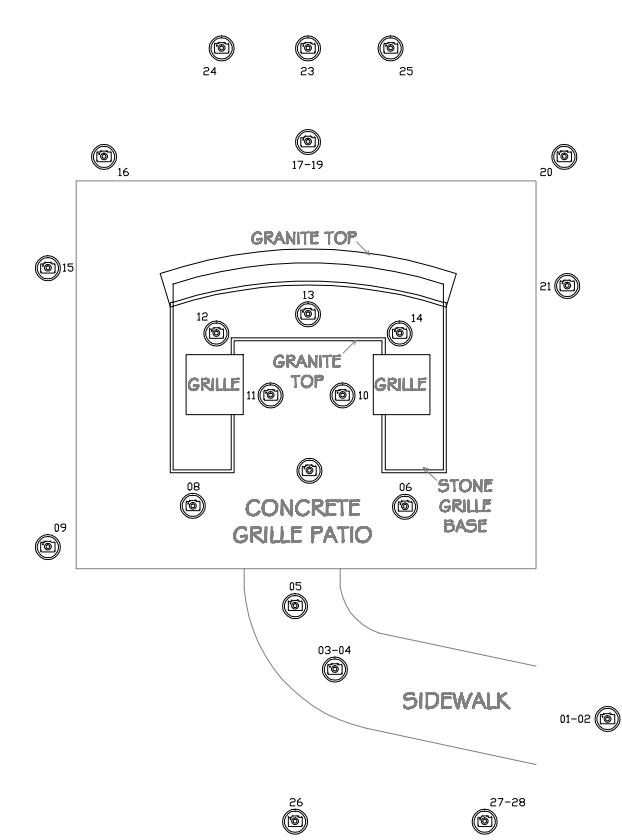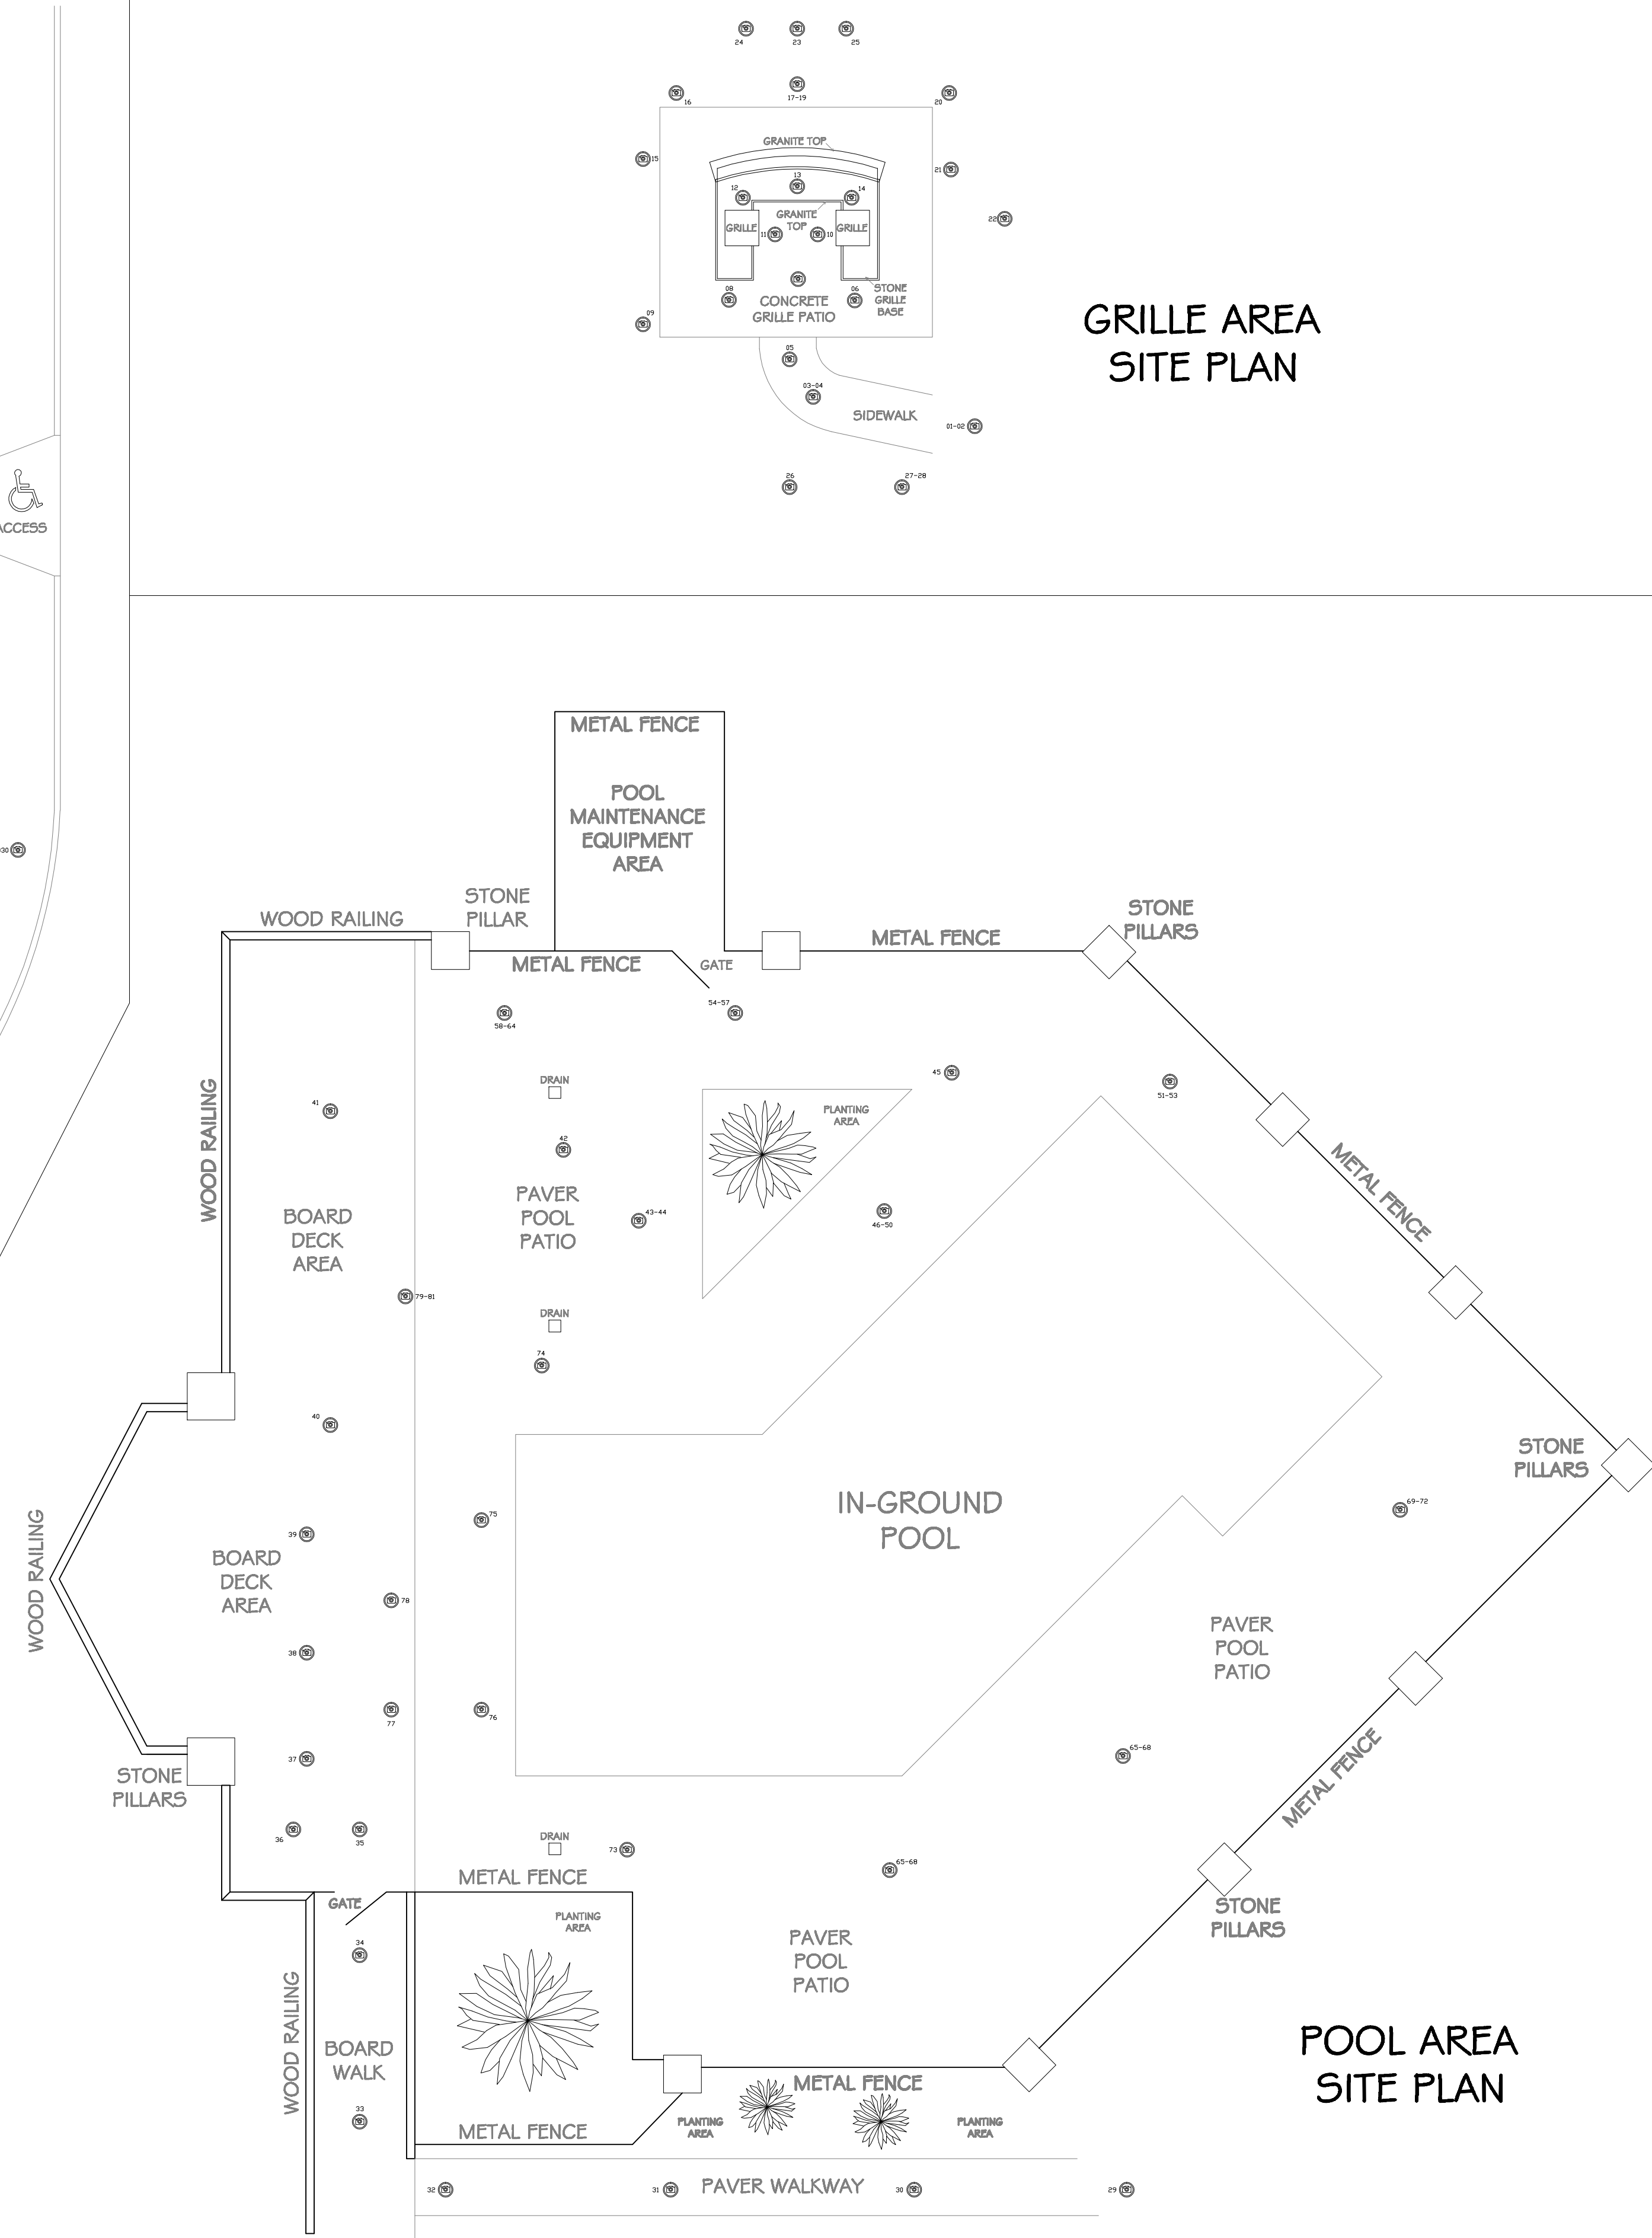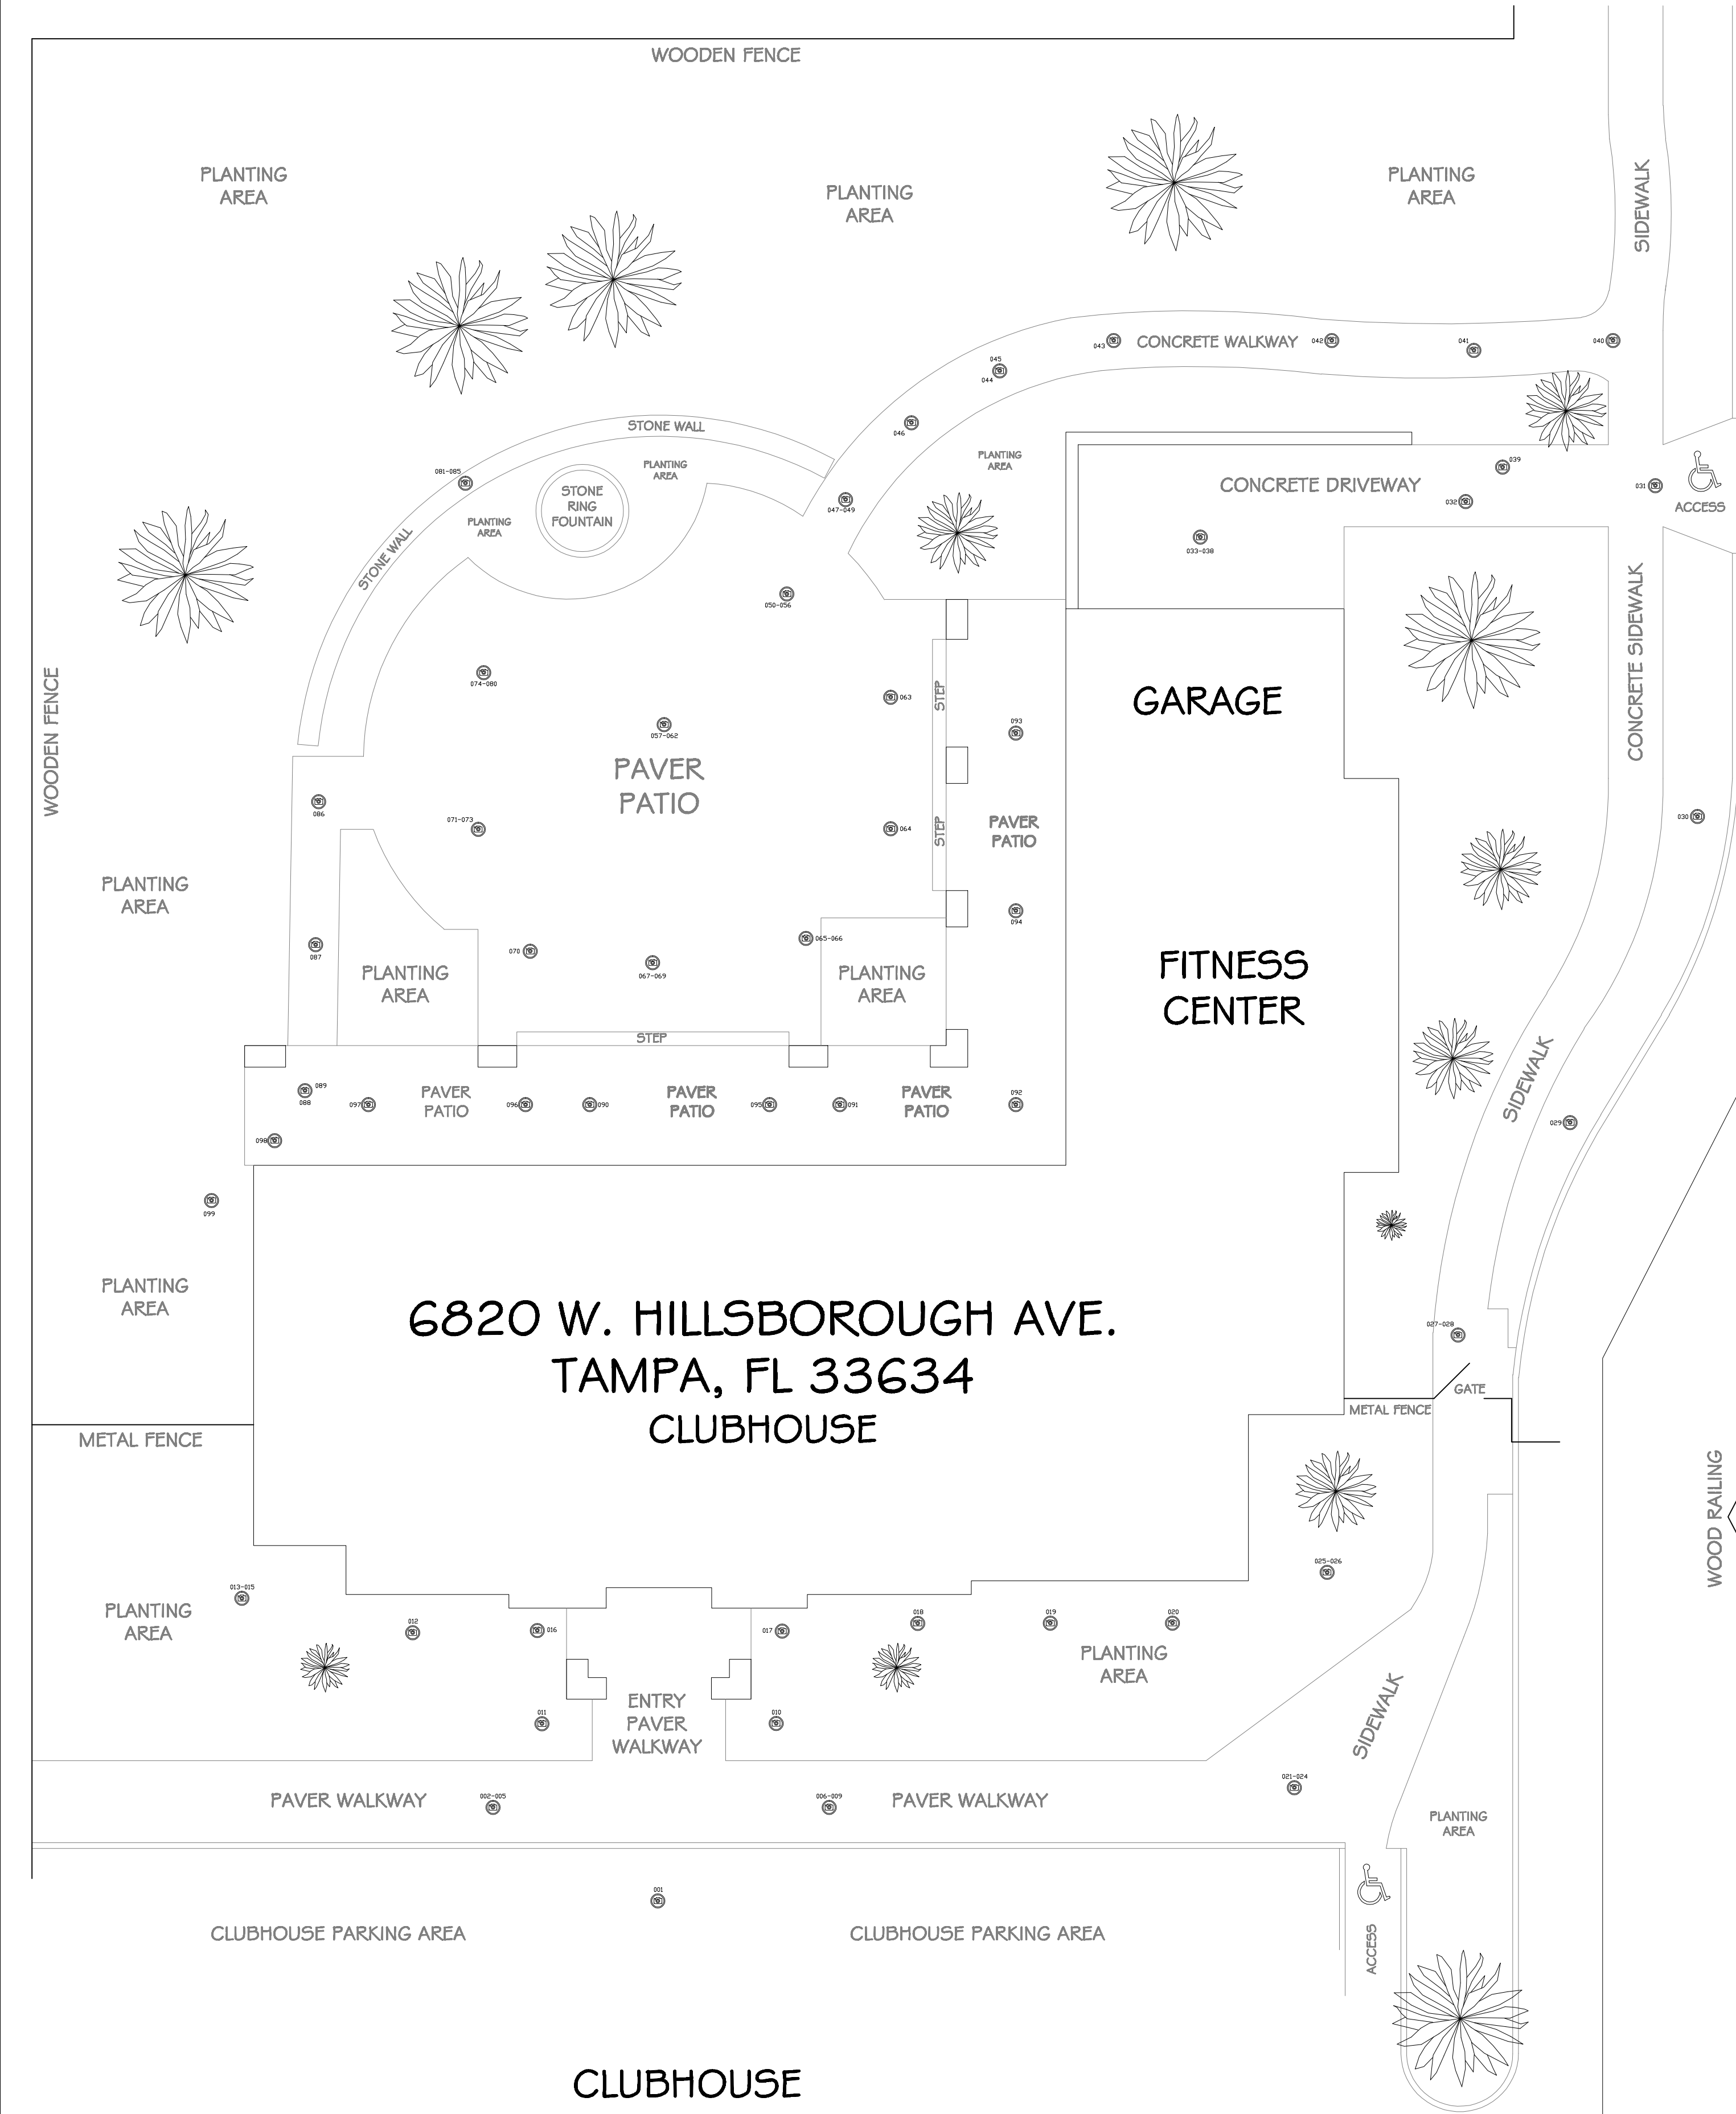

**ARCHITECTURAL AS BUILT
ROCKY CREEK APARTMENTS**

Tampa, FL 33634






01		
NO.	ISSUES REVISIONS	DATE
		SHEET TITLE

SITE PLANS

HL	PROJECT MANAGER
HL	PROJECT DIRECTOR
012317-1	PROJECT NUMBER
1/8"=1'-0"	SCALE
BB	DRAWN BY
	SHEET NUMBER

AB-6

FEATURES AND ATTRIBUTES LIST

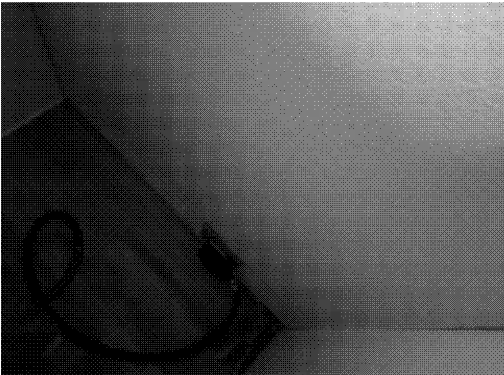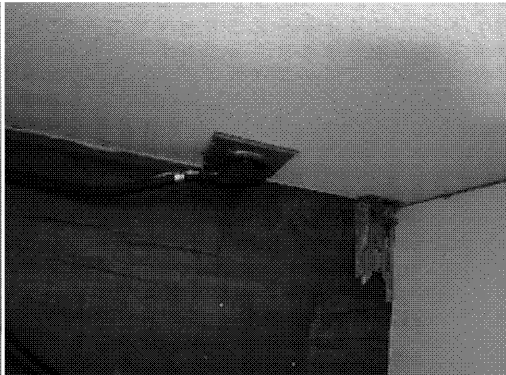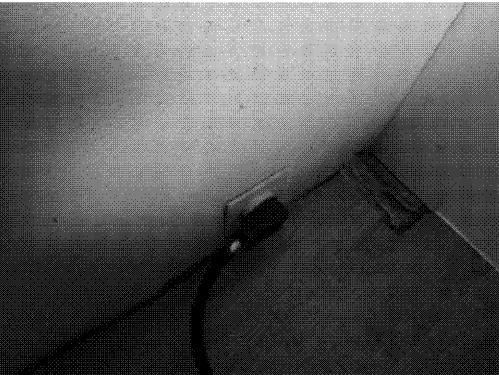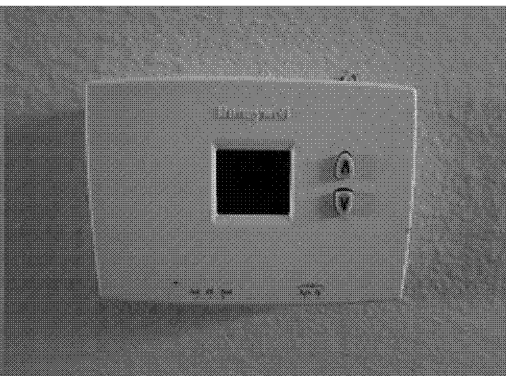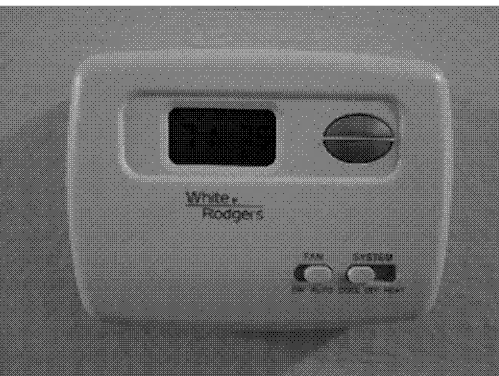FEATURE	ATTRIBUTE	1BR	2BR	3BR	CLUB
Ceiling Fan	Diameter	NONE	NONE	NONE	FITNESS ONLY - 42"
Ceiling Light	Diameter	12" LR / OTHERS 8"	12" LR / OTHERS 8"	12" LR / OTHERS 8"	32"
Dishwasher	Width	24"	24"	24"	24"
					
Dryer Receptacle	PHOTO				NONE
Garbage Disposal	Yes / No	YES	YES	YES	YES
Ice Maker	Yes / No	YES	YES	YES	YES
Medicine Cabinet	Width / Height	15.25" X 19.5"	15.25" X 19.5"	15.25" X 19.5"	NONE
					
Range Receptacle	PHOTO				NONE
Vent/Register	Width / Length	8" X 12" / 4" X 8" BATH	8" X 12" / 4" X 8" BATH	8" X 12" / 4" X 8" BATH	8" X 12"
					
Thermostat	PHOTO				
Toilet Bowl	Round or Elongated	ELONGATED	ELONGATED	ELONGATED	ELONGATED
Towel Bar	Length	24"	24"	24"	NONE
Vanity Mirror	Width / Height	32" X 42"	32" X 46" / 32" x 42"	32" X 46" / 32" x 42"	78" x 42" / 32" x 42"
Vanity Sink	Oval or Round/Dim	OVAL - 18" X 20"	OVAL - 18" X 20"	OVAL - 18" X 20"	OVAL - 18" X 20"
					
Viewer/Knocker	PHOTO				NONE

DOOR SIZES LISTED ON FLOOR PLANS

WINDOW SCHEDULE

Window Schedule

Window	Width	Height	Sill Ht.	Header Ht.
W1	5'-9.5"	4'-11"	1'-10"	6'-9"
W2	2'-10.5"	4'-11"	1'-10"	6'-9"
W3	5'-9.5"	4'-11"	1'-10"	6'-9"
W4	2'-10.5"	4'-11"	1'-10"	6'-9"
W5	2'-10.5"	4'-11"	1'-10"	6'-9"
W6	5'-9.5"	4'-11"	1'-10"	6'-9"
W7	4'-11.5"	2'-4"	4'-5"	6'-9"
W8	5'-9.5"	4'-11"	1'-10"	6'-9"
W9	2'-10.5"	4'-11"	1'-10"	6'-9"
W10	5'-9.5"	4'-11"	1'-10"	6'-9"
W11	4'-11.5"	2'-4"	4'-5"	6'-9"
W12	5'-9.5"	4'-11"	1'-10"	6'-9"

CABINET SCHEDULE


Cabinet Schedule

Cabinet	Width	Height	Door Size	Opening	Drawer Size	Drawer Opening
C1	20"	30"	20"x30"	18.5"x20.5"	NONE	NONE
C2	30"	17"	15"x17" (2)	29"x16"	NONE	NONE
C3	36"	30"	18"x30" (2)	35"x28.5"	NONE	NONE
C4	30"	15"	15"x15" (2)	29"x14"	NONE	NONE
C5	20"	30"	20"x23.5"	18.5"x22.5"	20"X6.5"	19"X5.5"
C6	36.5"	30"	18"x23.5" (2)	35"x22.5"	18"x6.5" (2)	17"x5'-5"
C7	30"	30"	15"x30" (2)	29"x28.5"	NONE	NONE
C8	30"	30"	15"X23.5" (2)	29"X22.5"	15"x6.5" (2)	14"x5'-5"
C9	36"	30"	18"x23.5" (2)	35"x22.5"	18"x6.5" (2)	17"x5'-5"
C10	30"	30"	15"X23.5" (2)	29"X22.5"	15"x6.5" (2)	NONE



As BUILT
PROFESSIONALS
www.asbuiltprofessionals.com

A DIVISION OF:

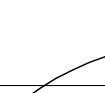

AEC
□
CONSULTANTS INC

844.272.8458
844 AS BUILT

© 2020 AEC CONSULTANTS INC

**ARCHITECTURAL AS BUILT
ROCKY CREEK APARTMENTS
Tampa, FL 33634**

01		
No.	ISSUES REVISIONS	DATE
		SHEET TITLE
SCHEDULES		
HL		PROJECT MANAGER
HL		PROJECT DIRECTOR
012317-1		PROJECT NUMBER
NTS		SCALE
BB		DRAWN BY
		SHEET NUMBER

AB-7