

# AS-BUILT DOCUMENTATION


## SAN FRANCISCO, CA 94109



**100% SUBMITTAL**

### DRAWING INDEX

- 0CA COVER
- 0SL SYMBOL LEGEND
- AB-1 EXISTING SITE PLAN
- AB-2 BASEMENT PLAN
- AB-3 FIRST FLOOR PLAN
- AB-4 SECOND FLOOR PLAN
- AB-5 ROOF PLAN
- AB-6 BASEMENT & FIRST FLOOR REFLECTED CEILING PLAN
- AB-7 SECOND FLOOR REFLECTED CEILING PLAN
- AB-8 EXTERIOR ELEVATIONS
- AB-9 3D VIEW
- AB-10 3D VIEW
- AB-11 3D SECTIONS
- AB-12 3D SECTION
- AB-13 3D SECTION

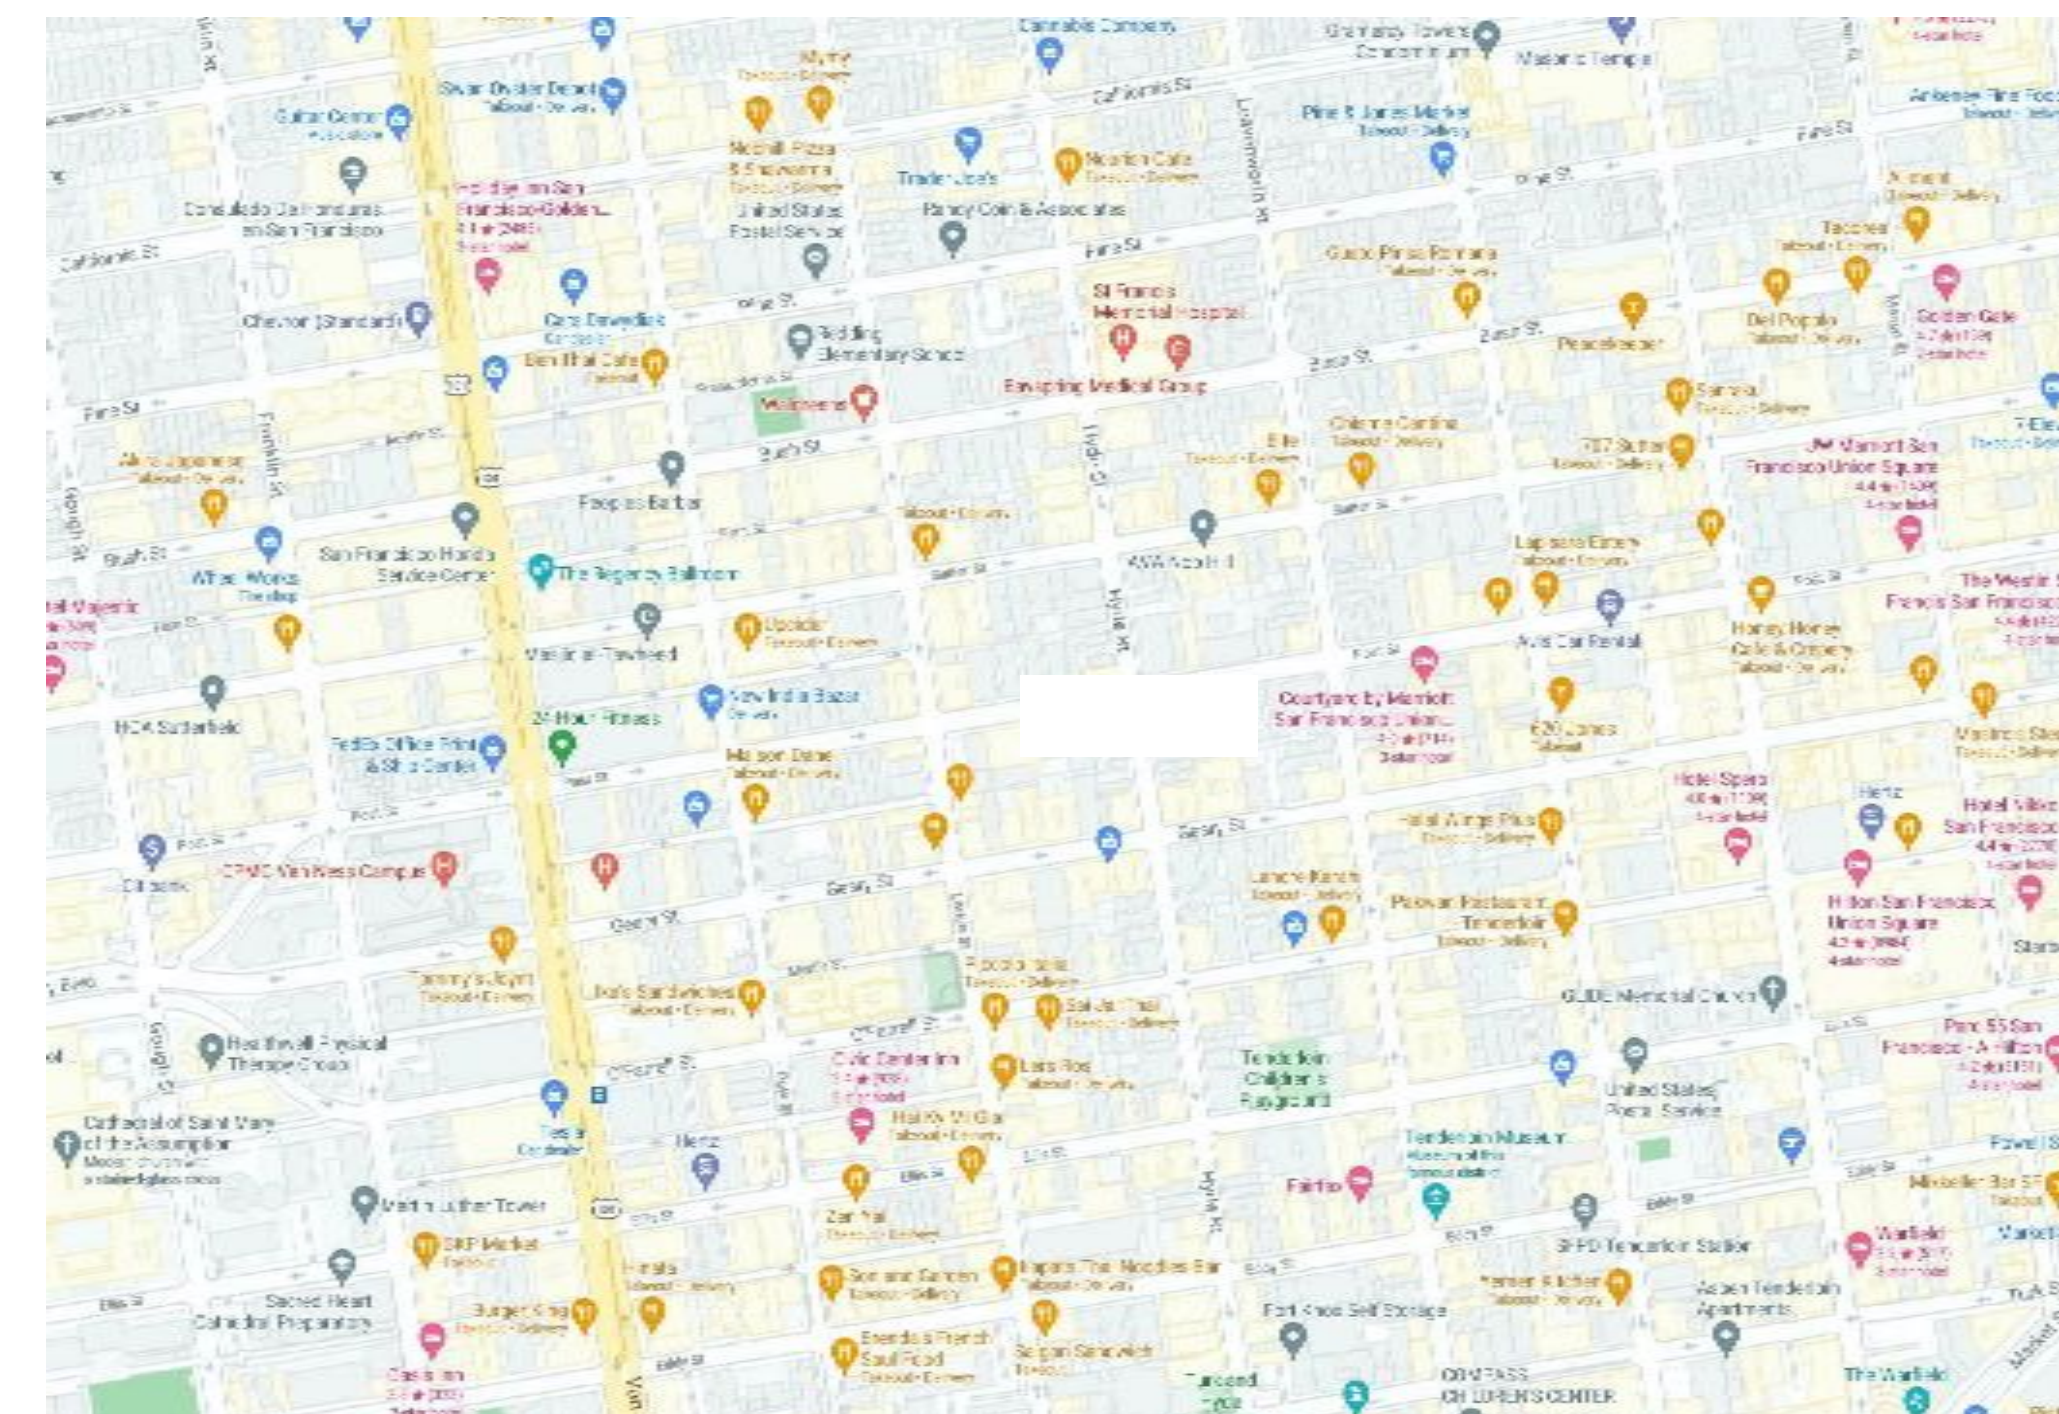

### AREA DATA

BASEMENT	5492 SF
FIRST FLOOR	5594 SF
SECOND FLOOR	1086 SF
GRAND TOTAL	12172 SF



**ARCHITECTURAL AS BUILT**

**SAN FRANCISCO, CA 94109**

01 100% SUBMISSION SEE COVER SHEET

NO. ISSUES / REVISIONS SHEET TITLE

**COVER**

C.A. PROJECT MANAGER

A.D. PROJECT DIRECTOR

21-28 PROJECT NUMBER

SCALE

A.K. DRAWN BY

SHEET NUMBER

**OCA**



# SYMBOLS LEGEND

## RCP

EXH	EXHAUST VENT	VL	TRACK LIGHT OR VANITY LIGHT
L1	CEILING MOUNTED LIGHT FIXTURE	WL	WALL-MOUNTED LIGHT FIXTURE
L	CEILING MOUNTED DIRECTIONAL LIGHT	ES	EMERGENCY EXIT SIGN
RC	RECESSED CAN LIGHT	EL	EMERGENCY EXIT LIGHT
EYE	EYEBALL OR SMALL CAN LIGHT	EEL	EMERGENCY EXIT LIGHT W/ SIGN
HPL	PENDANT LIGHT	STAIR	LIGHTED STAIR SIGN
FL	INDIVIDUAL FLUOR. LAY-IN FIXTURE 4 BULB	F	FLOOD LIGHT
FL2	INDIVIDUAL FLUOR. HANGING FIXTURE 2 BULB	PC	PHOTO CELL
FL3	INDIVIDUAL FLUOR. FLUSH MOUNT FIXTURE 4 BULB	F1	CEILING FAN
C	CAMERA	F1LK	CEILING FAN W/ LIGHT KIT
M	MOTION DET.	7-2-6	CEILING HEIGHT AND TRIM 7'-2" ABOVE FLOOR BELOW WITH 6" CROWN MOULDING. NOTE: ALL CEILINGS NOT LABELED ARE PLASTER. CEILINGS SHOWN WITH A GRID ARE LAY IN ACOUSTICAL TILE..
SUP	SUPPLY VENT	J	JUNCTION BOX
SUP2	SUPPLY VENT		
RET	RETURN VENT		
RET2	RETURN VENT		
spe	SPEAKER		

## ELECTRIC

DAT	DATA OUTLET
TEL	TELEPHONE JACK
S1	ELECTRIC SWITCH
TV	CABLE TELEVISION OUTLET
P1	DUPLEX RECEPTACLE OUTLET
P3	SPECIAL PURPOSE CONNECTION OR OUTLET
PQ	QUADRUPLEX RECEPTACLE OUTLET
PF	FLOOR DUPLEX RECEPTACLE OUTLET
PNL	ELECTRIC PANEL
MTR	ELECTRIC METER
BUT	BUTTON SWITCH
DISC	DISCONNECT SWITCH
LG	GROUND/FLOOR LIGHT
KP	KEY PAD

## FIRE PROTECTION




FE	FIRE EXTINGUISHER
FP	FIRE PULL
AS	FIRE ALARM (HORN/SRTOBE)
SD	SMOKE DETECTOR
SS	SMOKE ALARM SPEAKER
SP	SPRINKLER HEAD CEILING MOUNT
SPW	SPRINKLER HEAD WALL MOUNT

## MEP

TH	THERMOSTAT
FD	FLOOR DRAIN
V	VALVE
HB	HOSE BIB
WS	WATER SUPPLY
HEAT	SUSPENDED GAS HEATER

## MISC

BOLLARD	BOLLARD
ELEVATION SYMBOL	11-4-11/16 SPOT ELEVATION

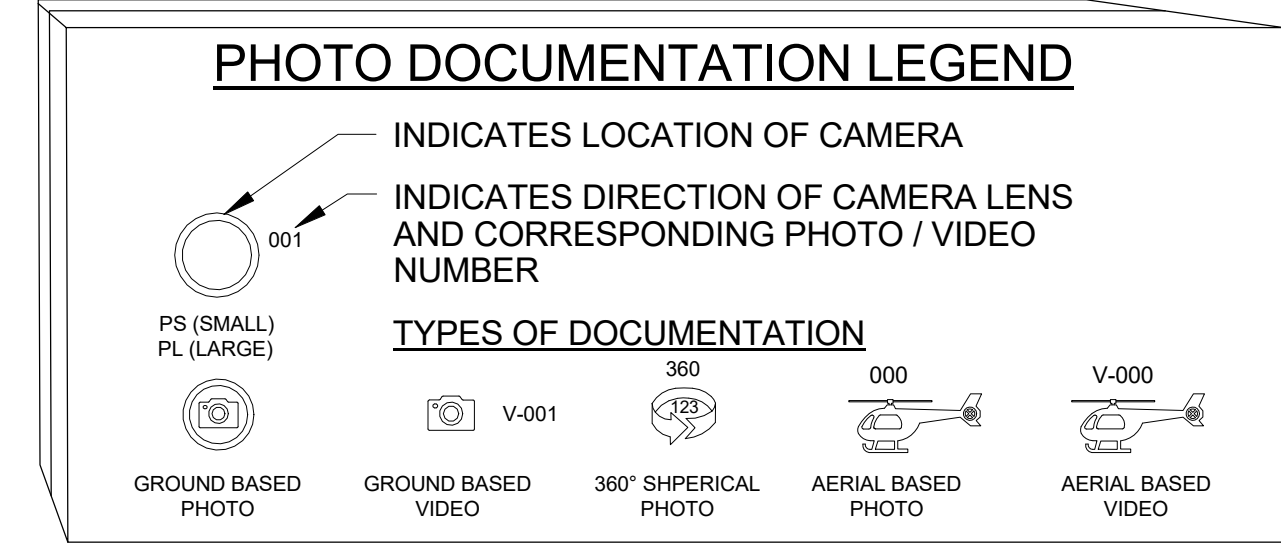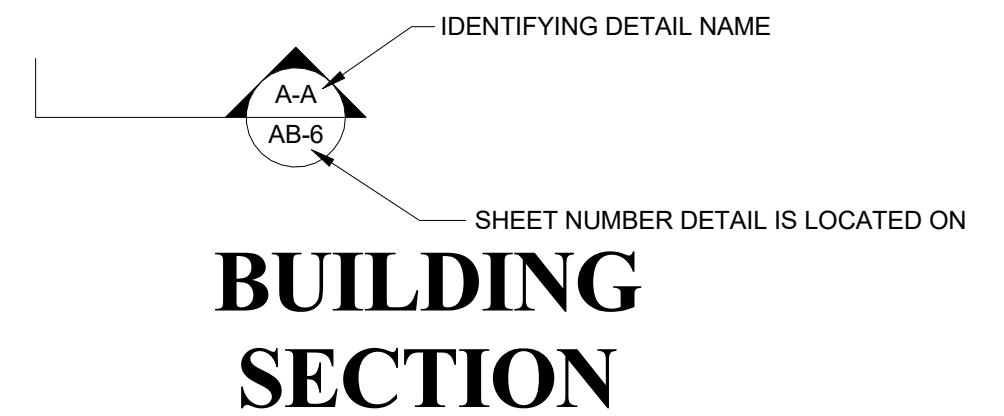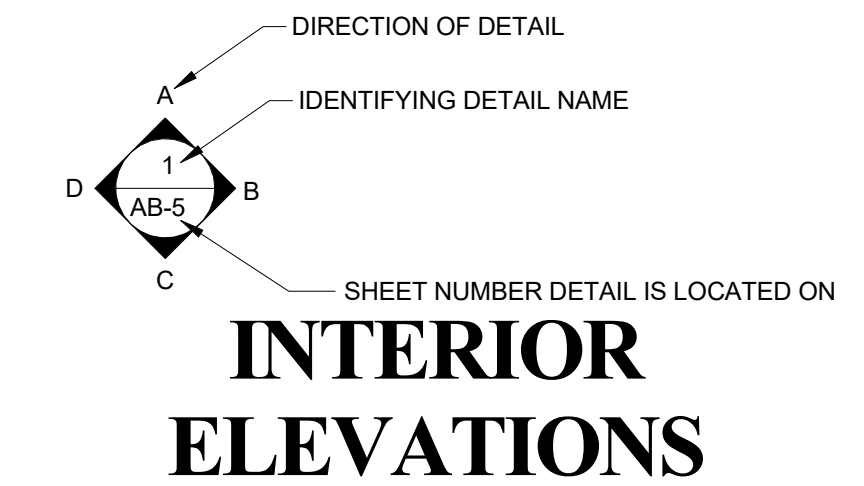

**ARCHITECTURAL AS BUILT**  
**SAN FRANCISCO, CA 94109**

NO.	ISSUES / REVISIONS	SHEET TITLE
01	100% SUBMISSION	SEE COVER SHEET

### SYMBOL LEGEND


C.A.	PROJECT MANAGER
A.D.	PROJECT DIRECTOR
21-28	PROJECT NUMBER
	SCALE
A.K.	DRAWN BY
	SHEET NUMBER

**OSL**





**ARCHITECTURAL AS BUILT**  
**SAN FRANCISCO, CA 94109**

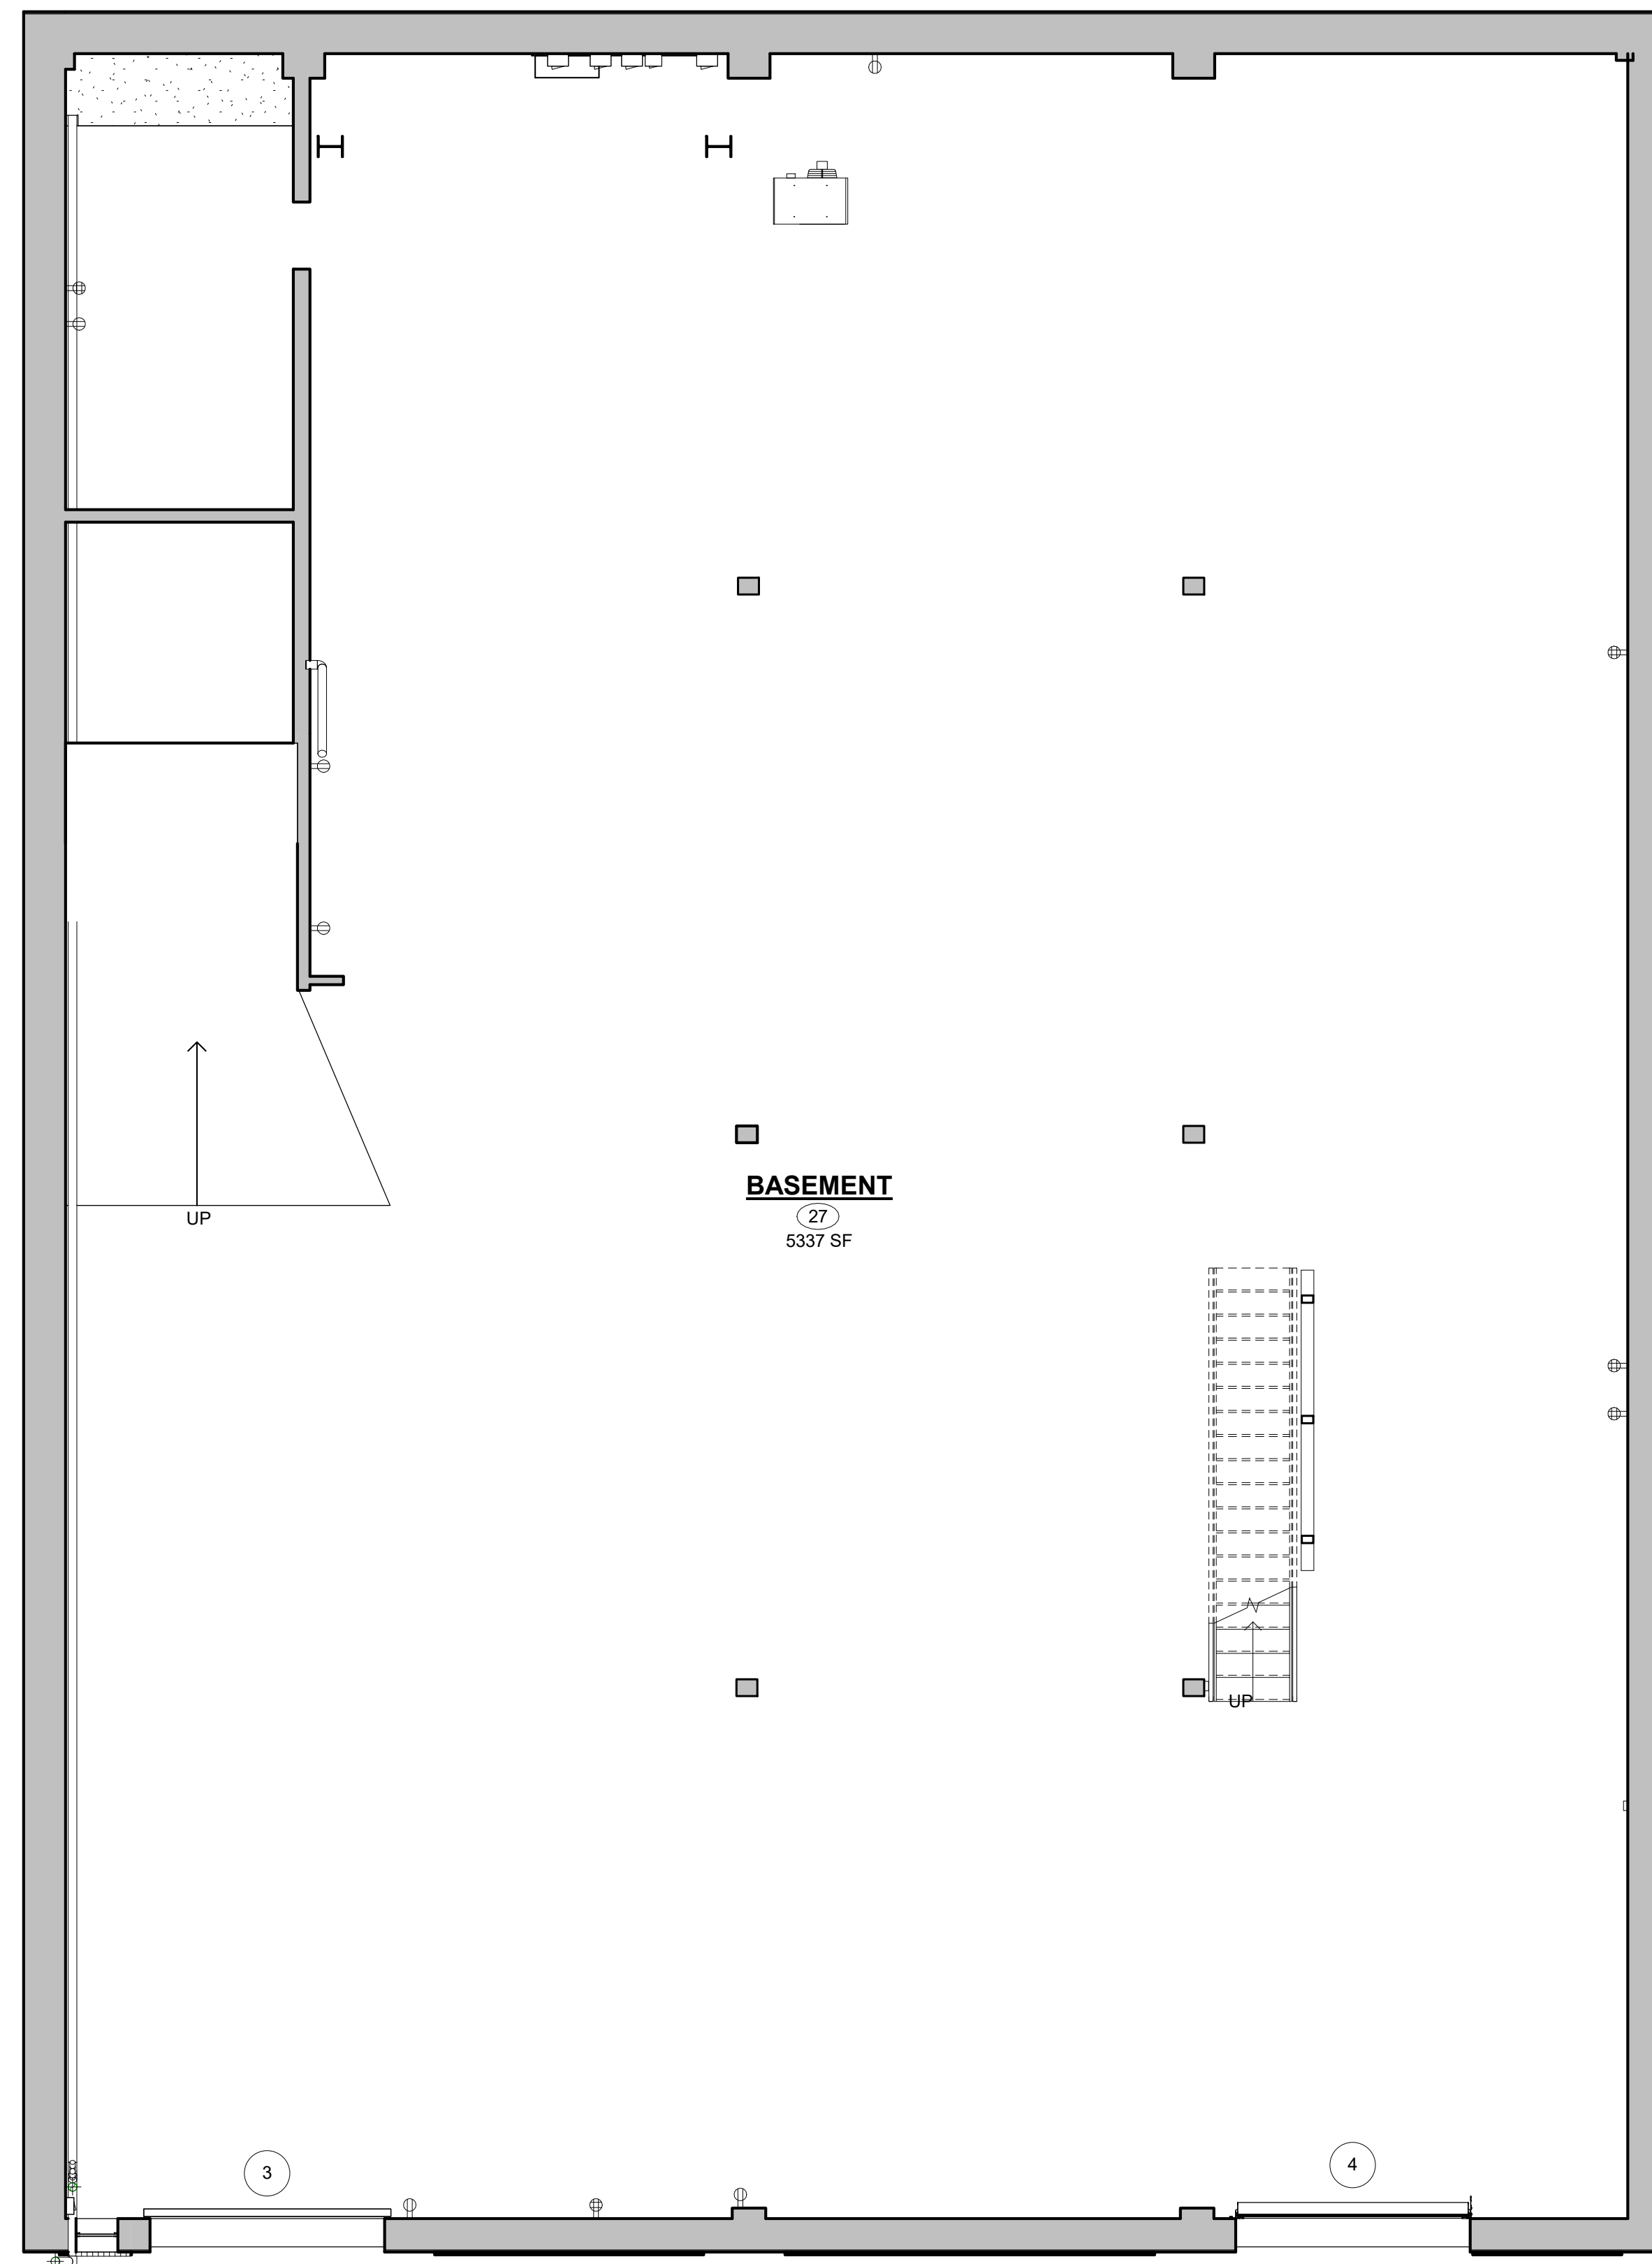

**1 EXISTING BASEMENT PLAN**  
 SCALE: 3/16" = 1'-0"

NO.	ISSUES / REVISIONS	SHEET TITLE
01	100% SUBMISSION	SEE COVER SHEET

**BASEMENT PLAN**

C.A.	PROJECT MANAGER
A.D.	PROJECT DIRECTOR
21-28	PROJECT NUMBER
	SCALE
A.K.	DRAWN BY
	SHEET NUMBER


**AB-2**



**ARCHITECTURAL AS BUILT**  
**SAN FRANCISCO, CA 94109**

DOOR SCHEDULE			
TAG	WIDTH	HEIGHT	COUNT
1	2' - 8"	6' - 8"	3
2	2' - 4"	6' - 8"	2
3	9' - 4"	7' - 0"	1
4	9' - 4"	8' - 8"	1
5	3' - 0"	6' - 8"	2
6	6' - 0"	6' - 8"	1
7	8' - 8"	11' - 0"	1

GRAND TOTAL: 11

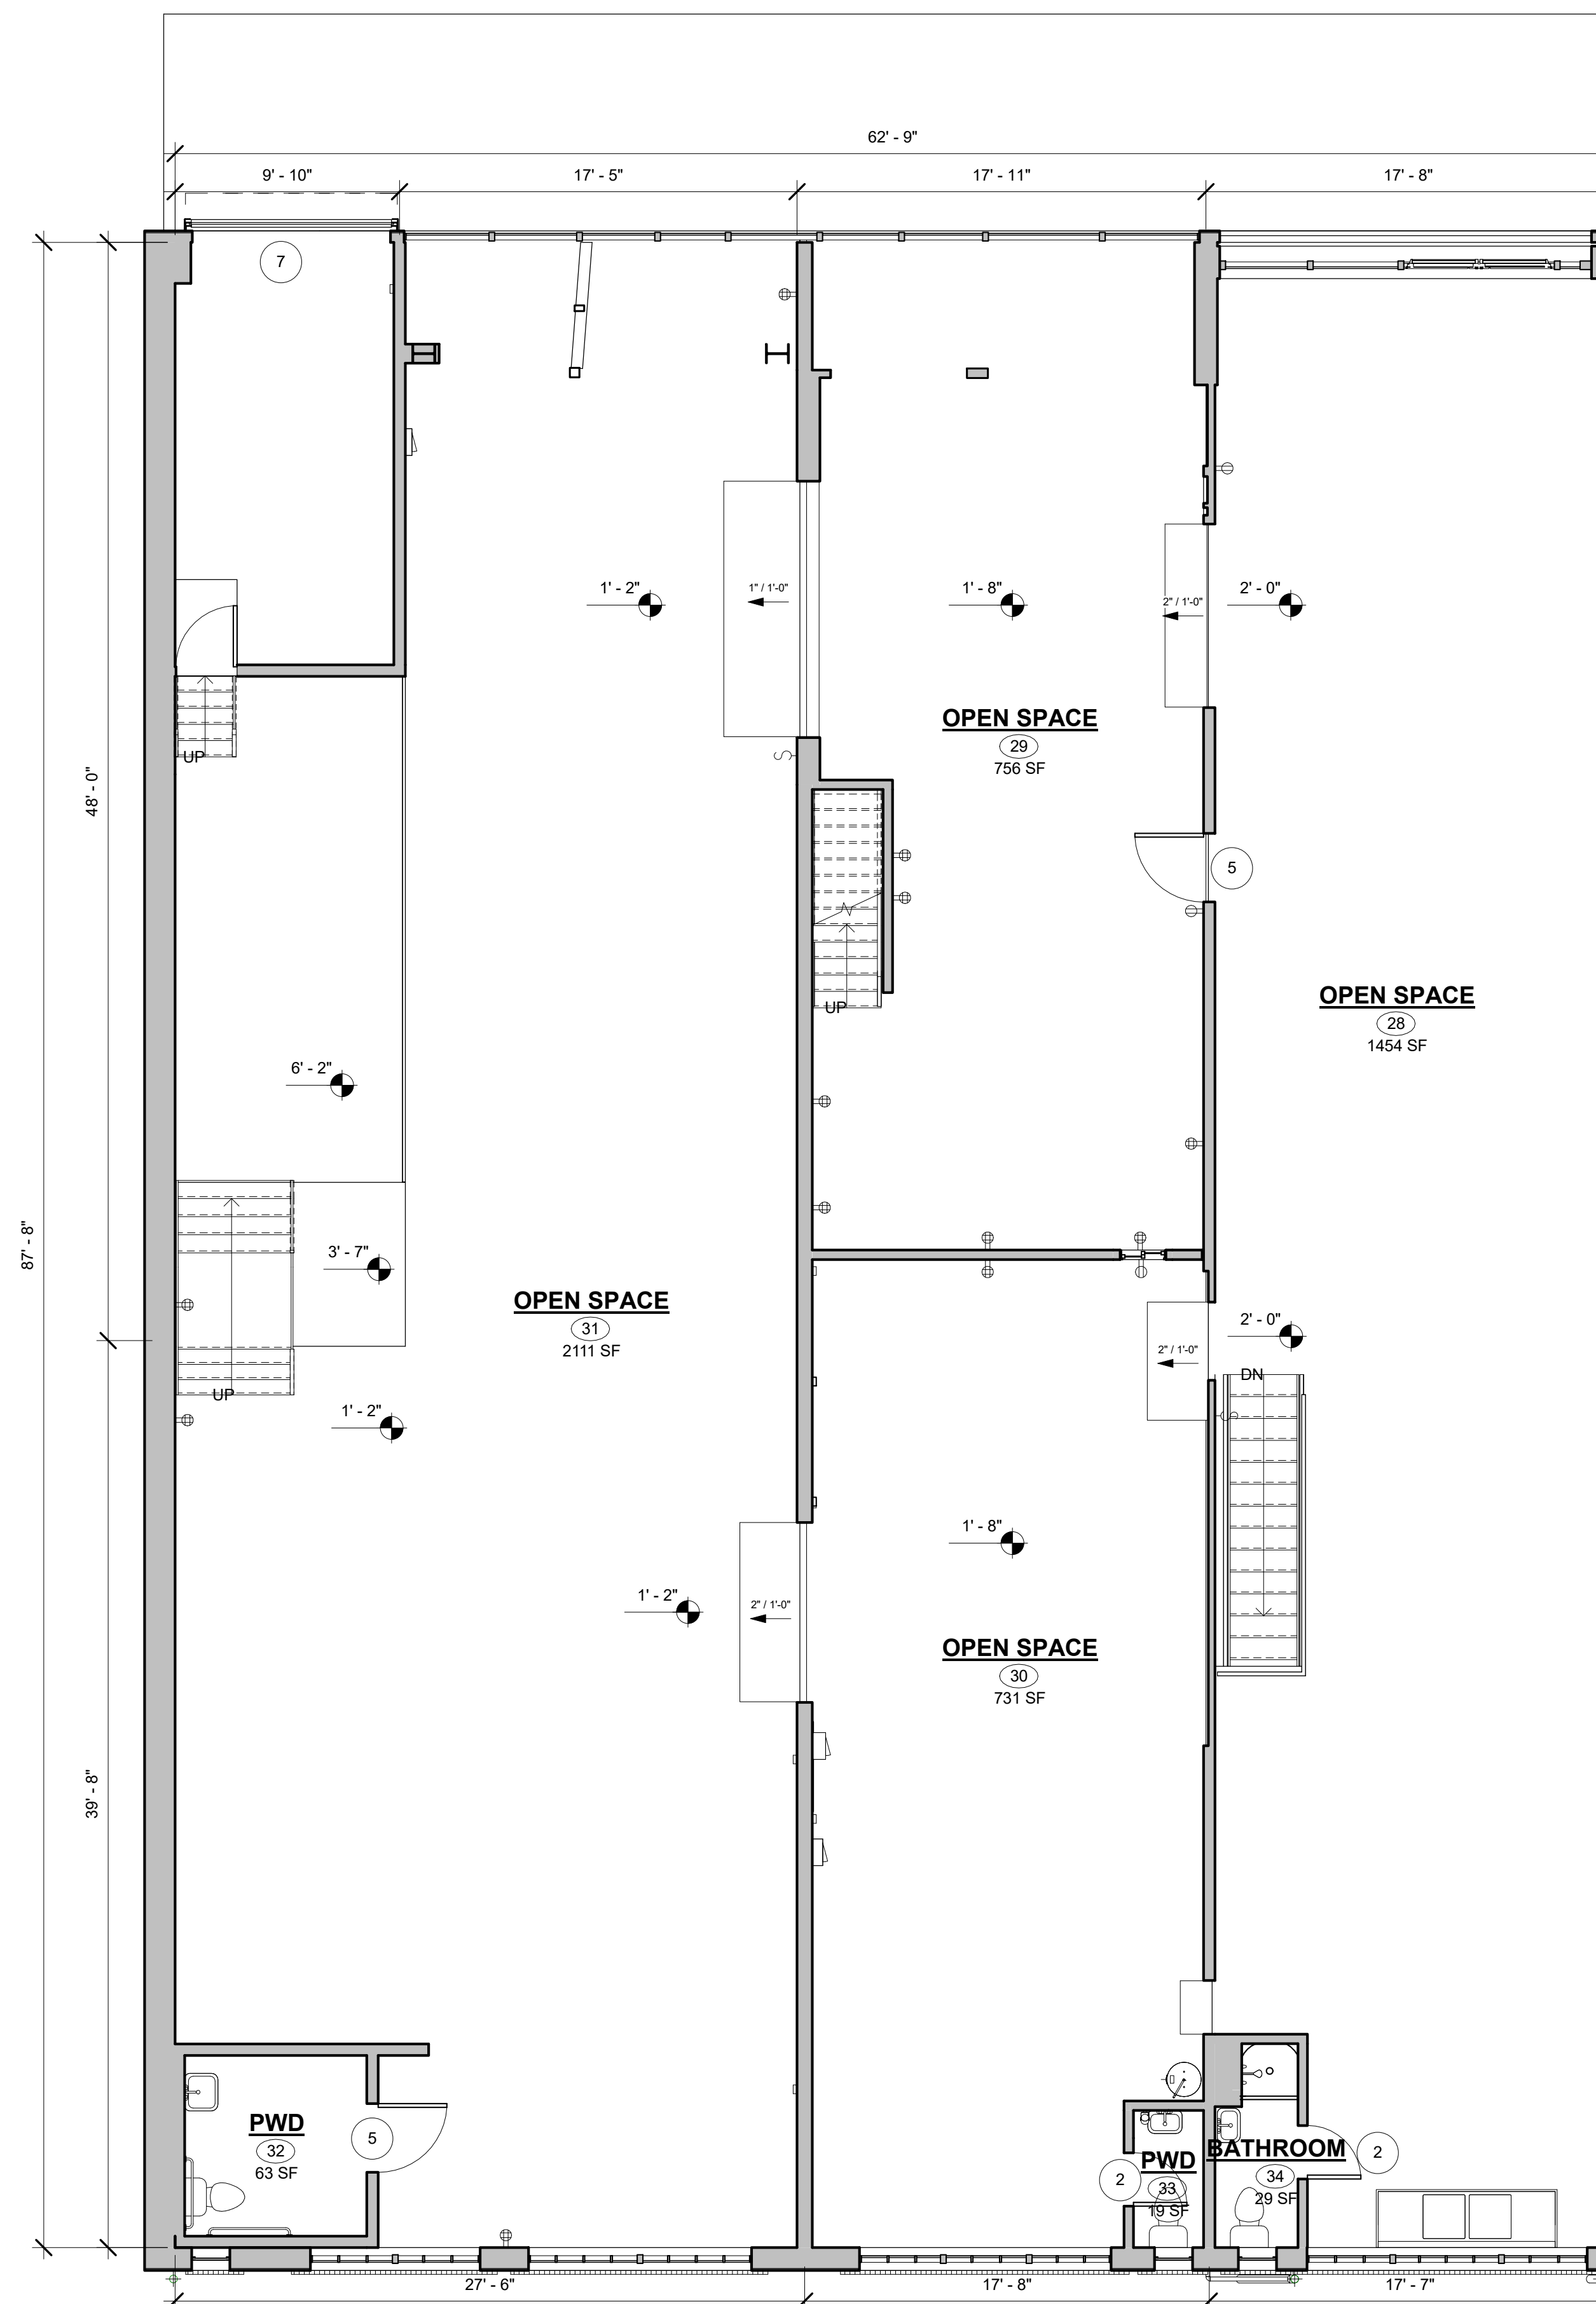

**1 EXISTING FIRST FLOOR PLAN**  
SCALE: 3/16" = 1'-0"



01	100% SUBMISSION	SEE COVER SHEET
NO.	ISSUES / REVISIONS	

**FIRST FLOOR PLAN**

C.A.	PROJECT MANAGER
A.D.	PROJECT DIRECTOR
21-28	PROJECT NUMBER
	SCALE
A.K.	DRAWN BY
	SHEET NUMBER

**AB-3**




**ARCHITECTURAL AS BUILT**  
**SAN FRANCISCO, CA 94109**

NO.	ISSUES / REVISIONS	SHEET TITLE
01	100% SUBMISSION	SEE COVER SHEET

**SECOND FLOOR PLAN**


C.A.	PROJECT MANAGER
A.D.	PROJECT DIRECTOR
21-28	PROJECT NUMBER
	SCALE
A.K.	DRAWN BY
	SHEET NUMBER

**AB-4**

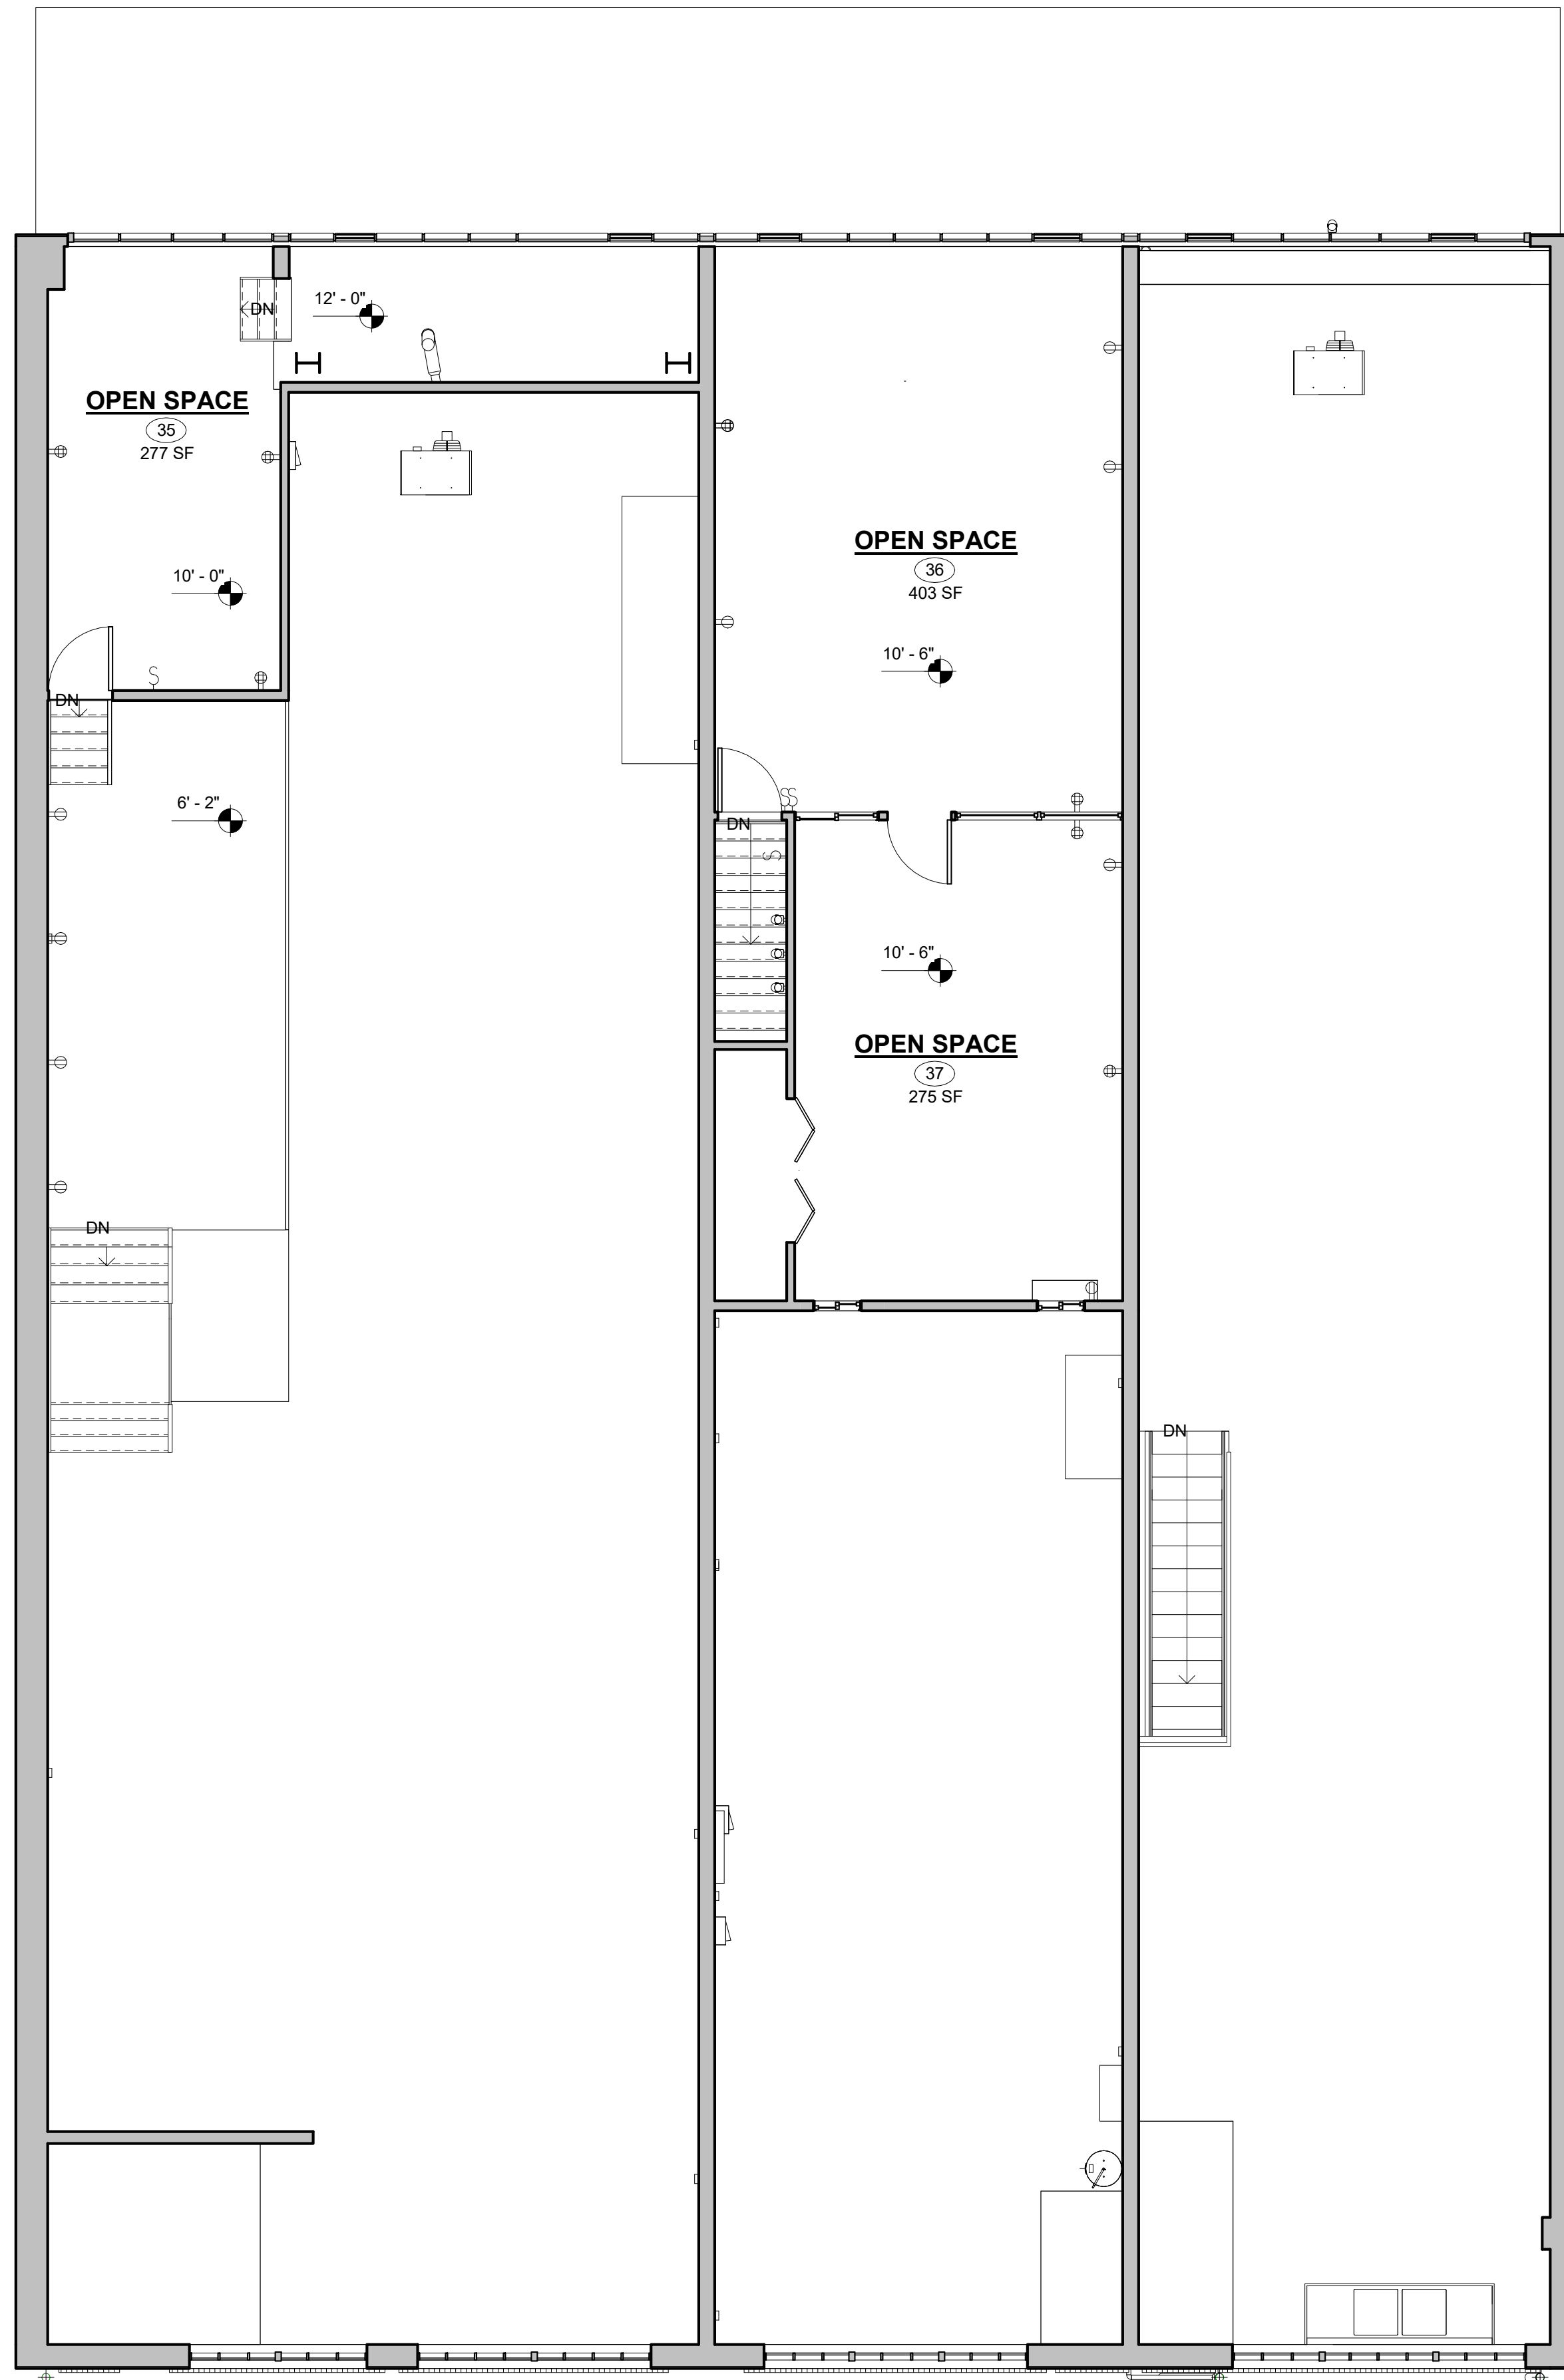


**1 EXISTING SECOND FLOOR PLAN**

SCALE: 3/16" = 1'-0"

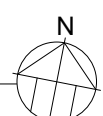




 **ARCHITECTURAL AS BUILT**  
**SAN FRANCISCO, CA 94109**



**1 EXISTING ROOF PLAN**  
 SCALE: 3/16" = 1'-0"

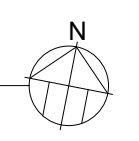

NO.	ISSUES / REVISIONS	SHEET TITLE
01	100% SUBMISSION	SEE COVER SHEET


**ROOF PLAN**

C.A.	PROJECT MANAGER
A.D.	PROJECT DIRECTOR
21-28	PROJECT NUMBER
	SCALE
A.K.	DRAWN BY
	SHEET NUMBER



**AB-5**




**ARCHITECTURAL AS BUILT**  
**SAN FRANCISCO, CA 94109**

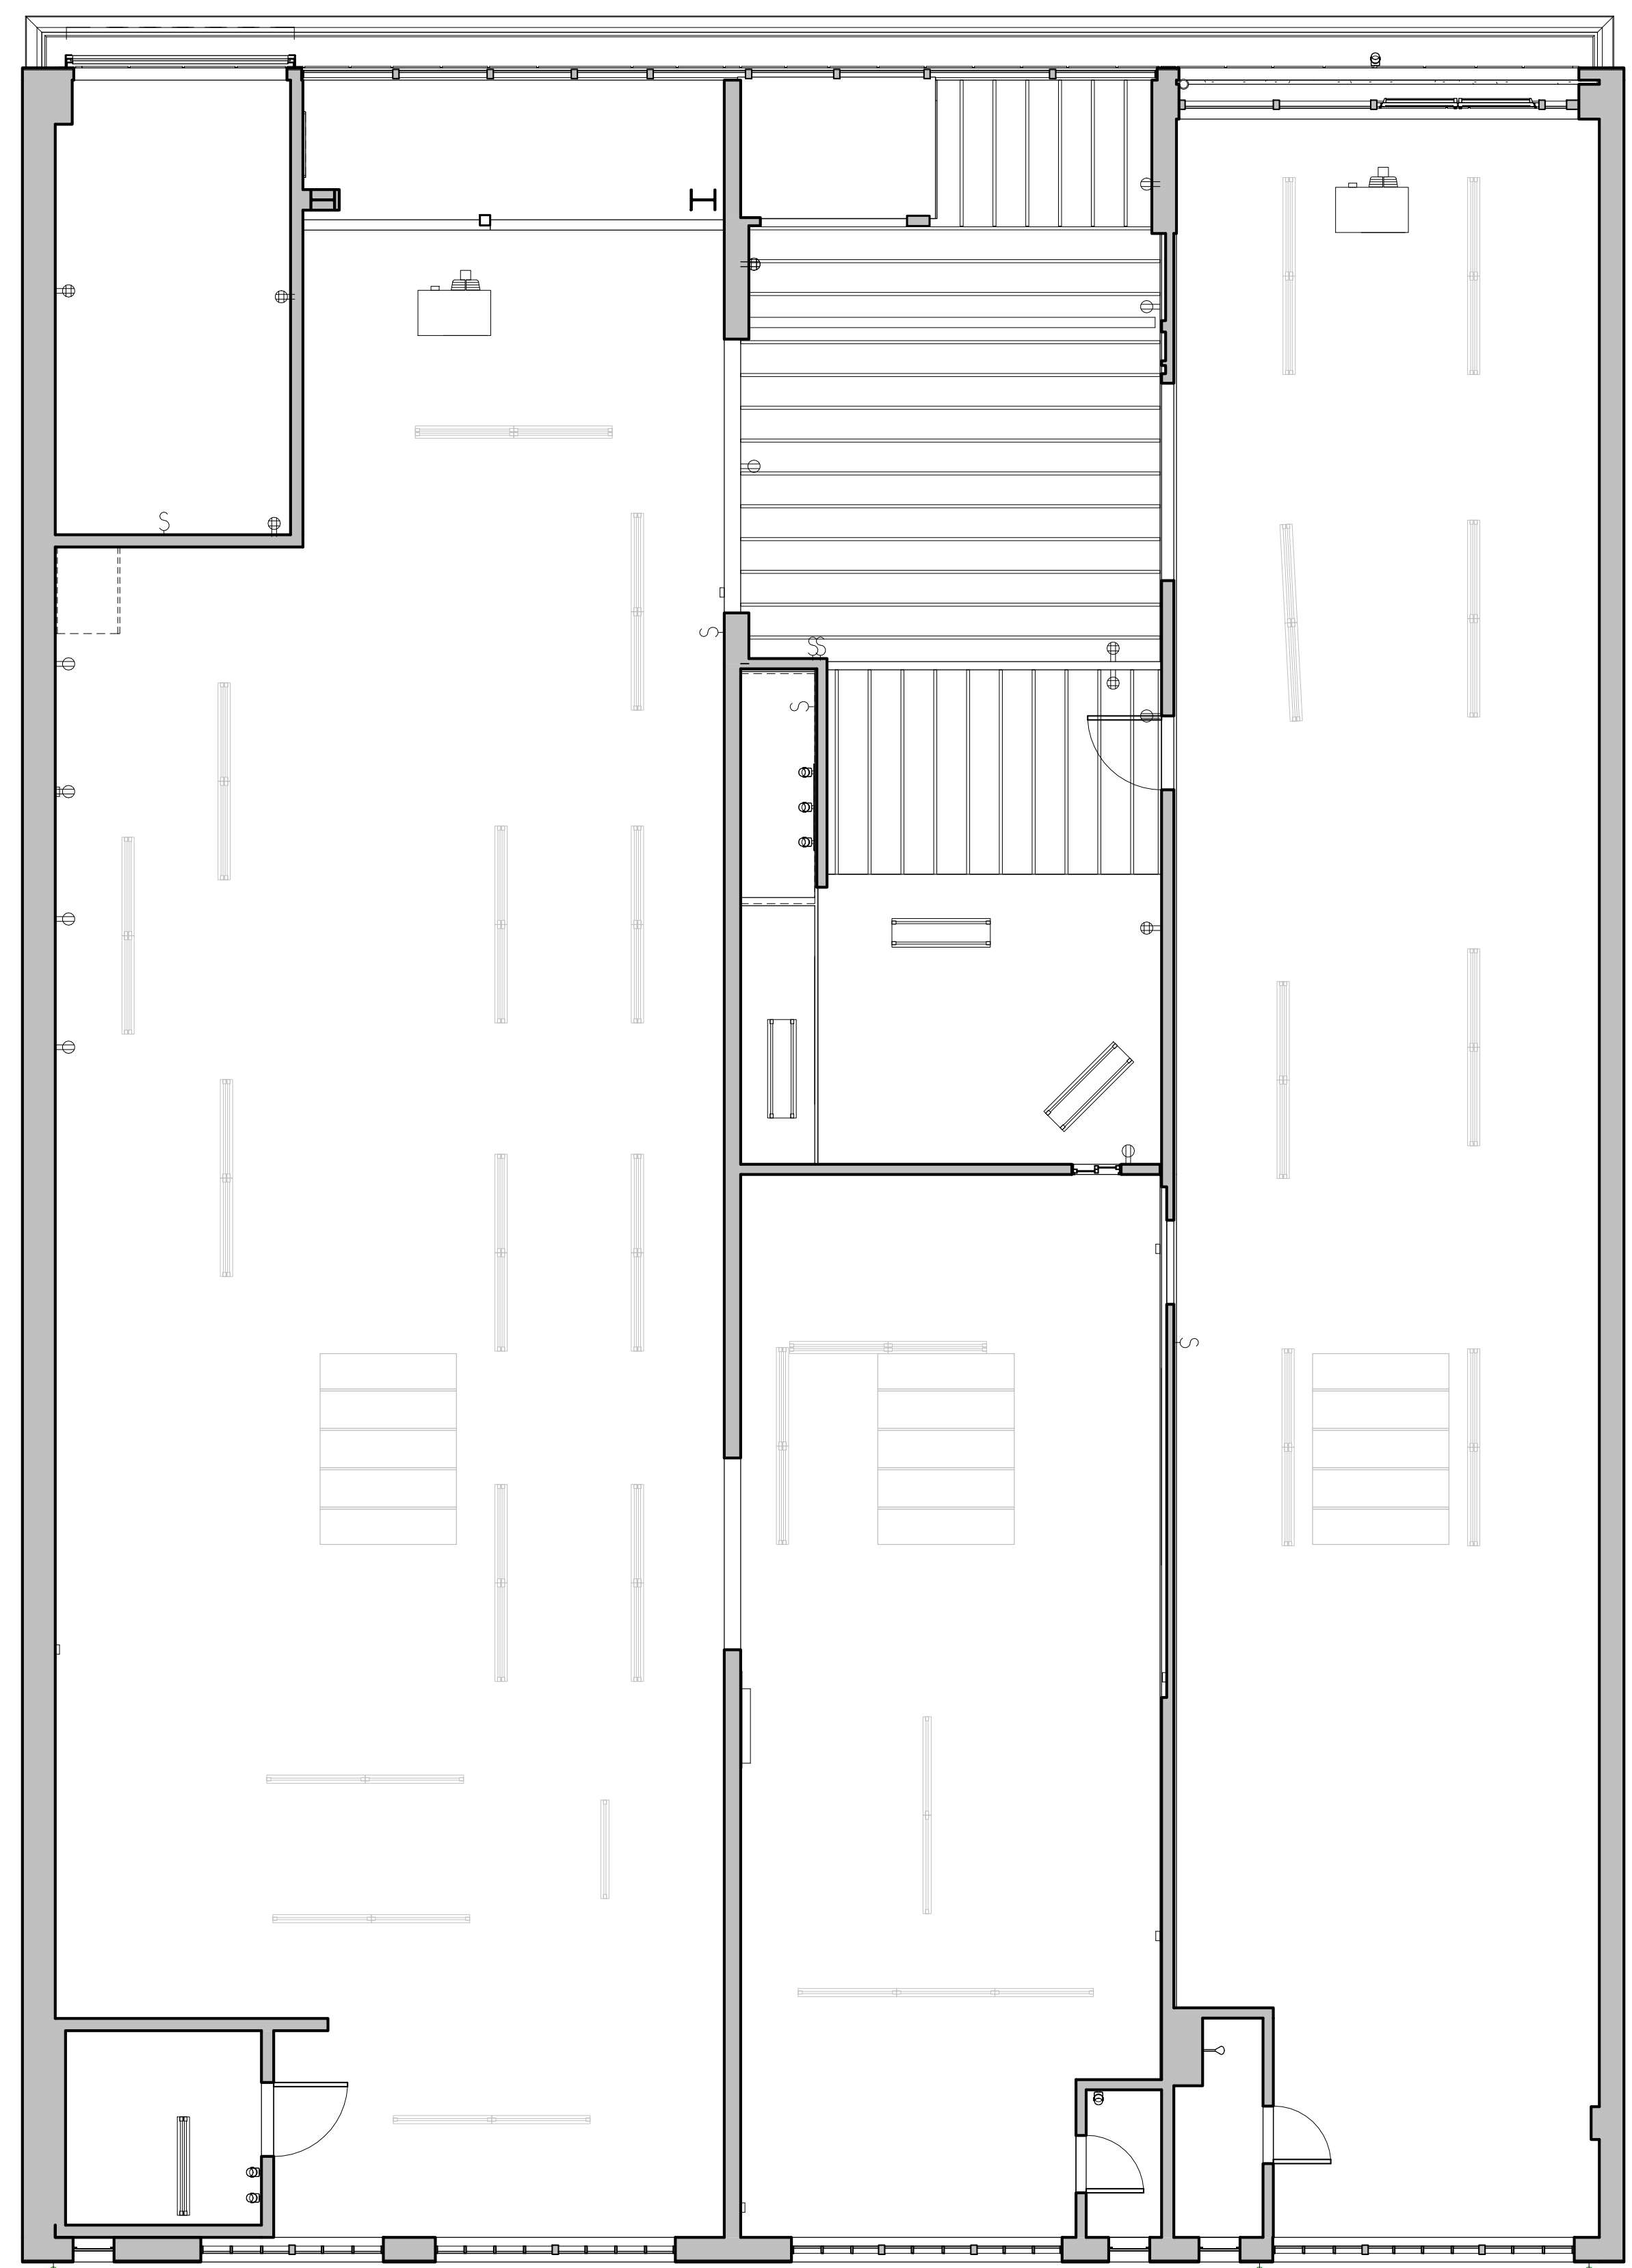

**2 EXISTING FIRST FLOOR REFLECTED CEILING PLAN**  
SCALE: 3/16" = 1'-0"

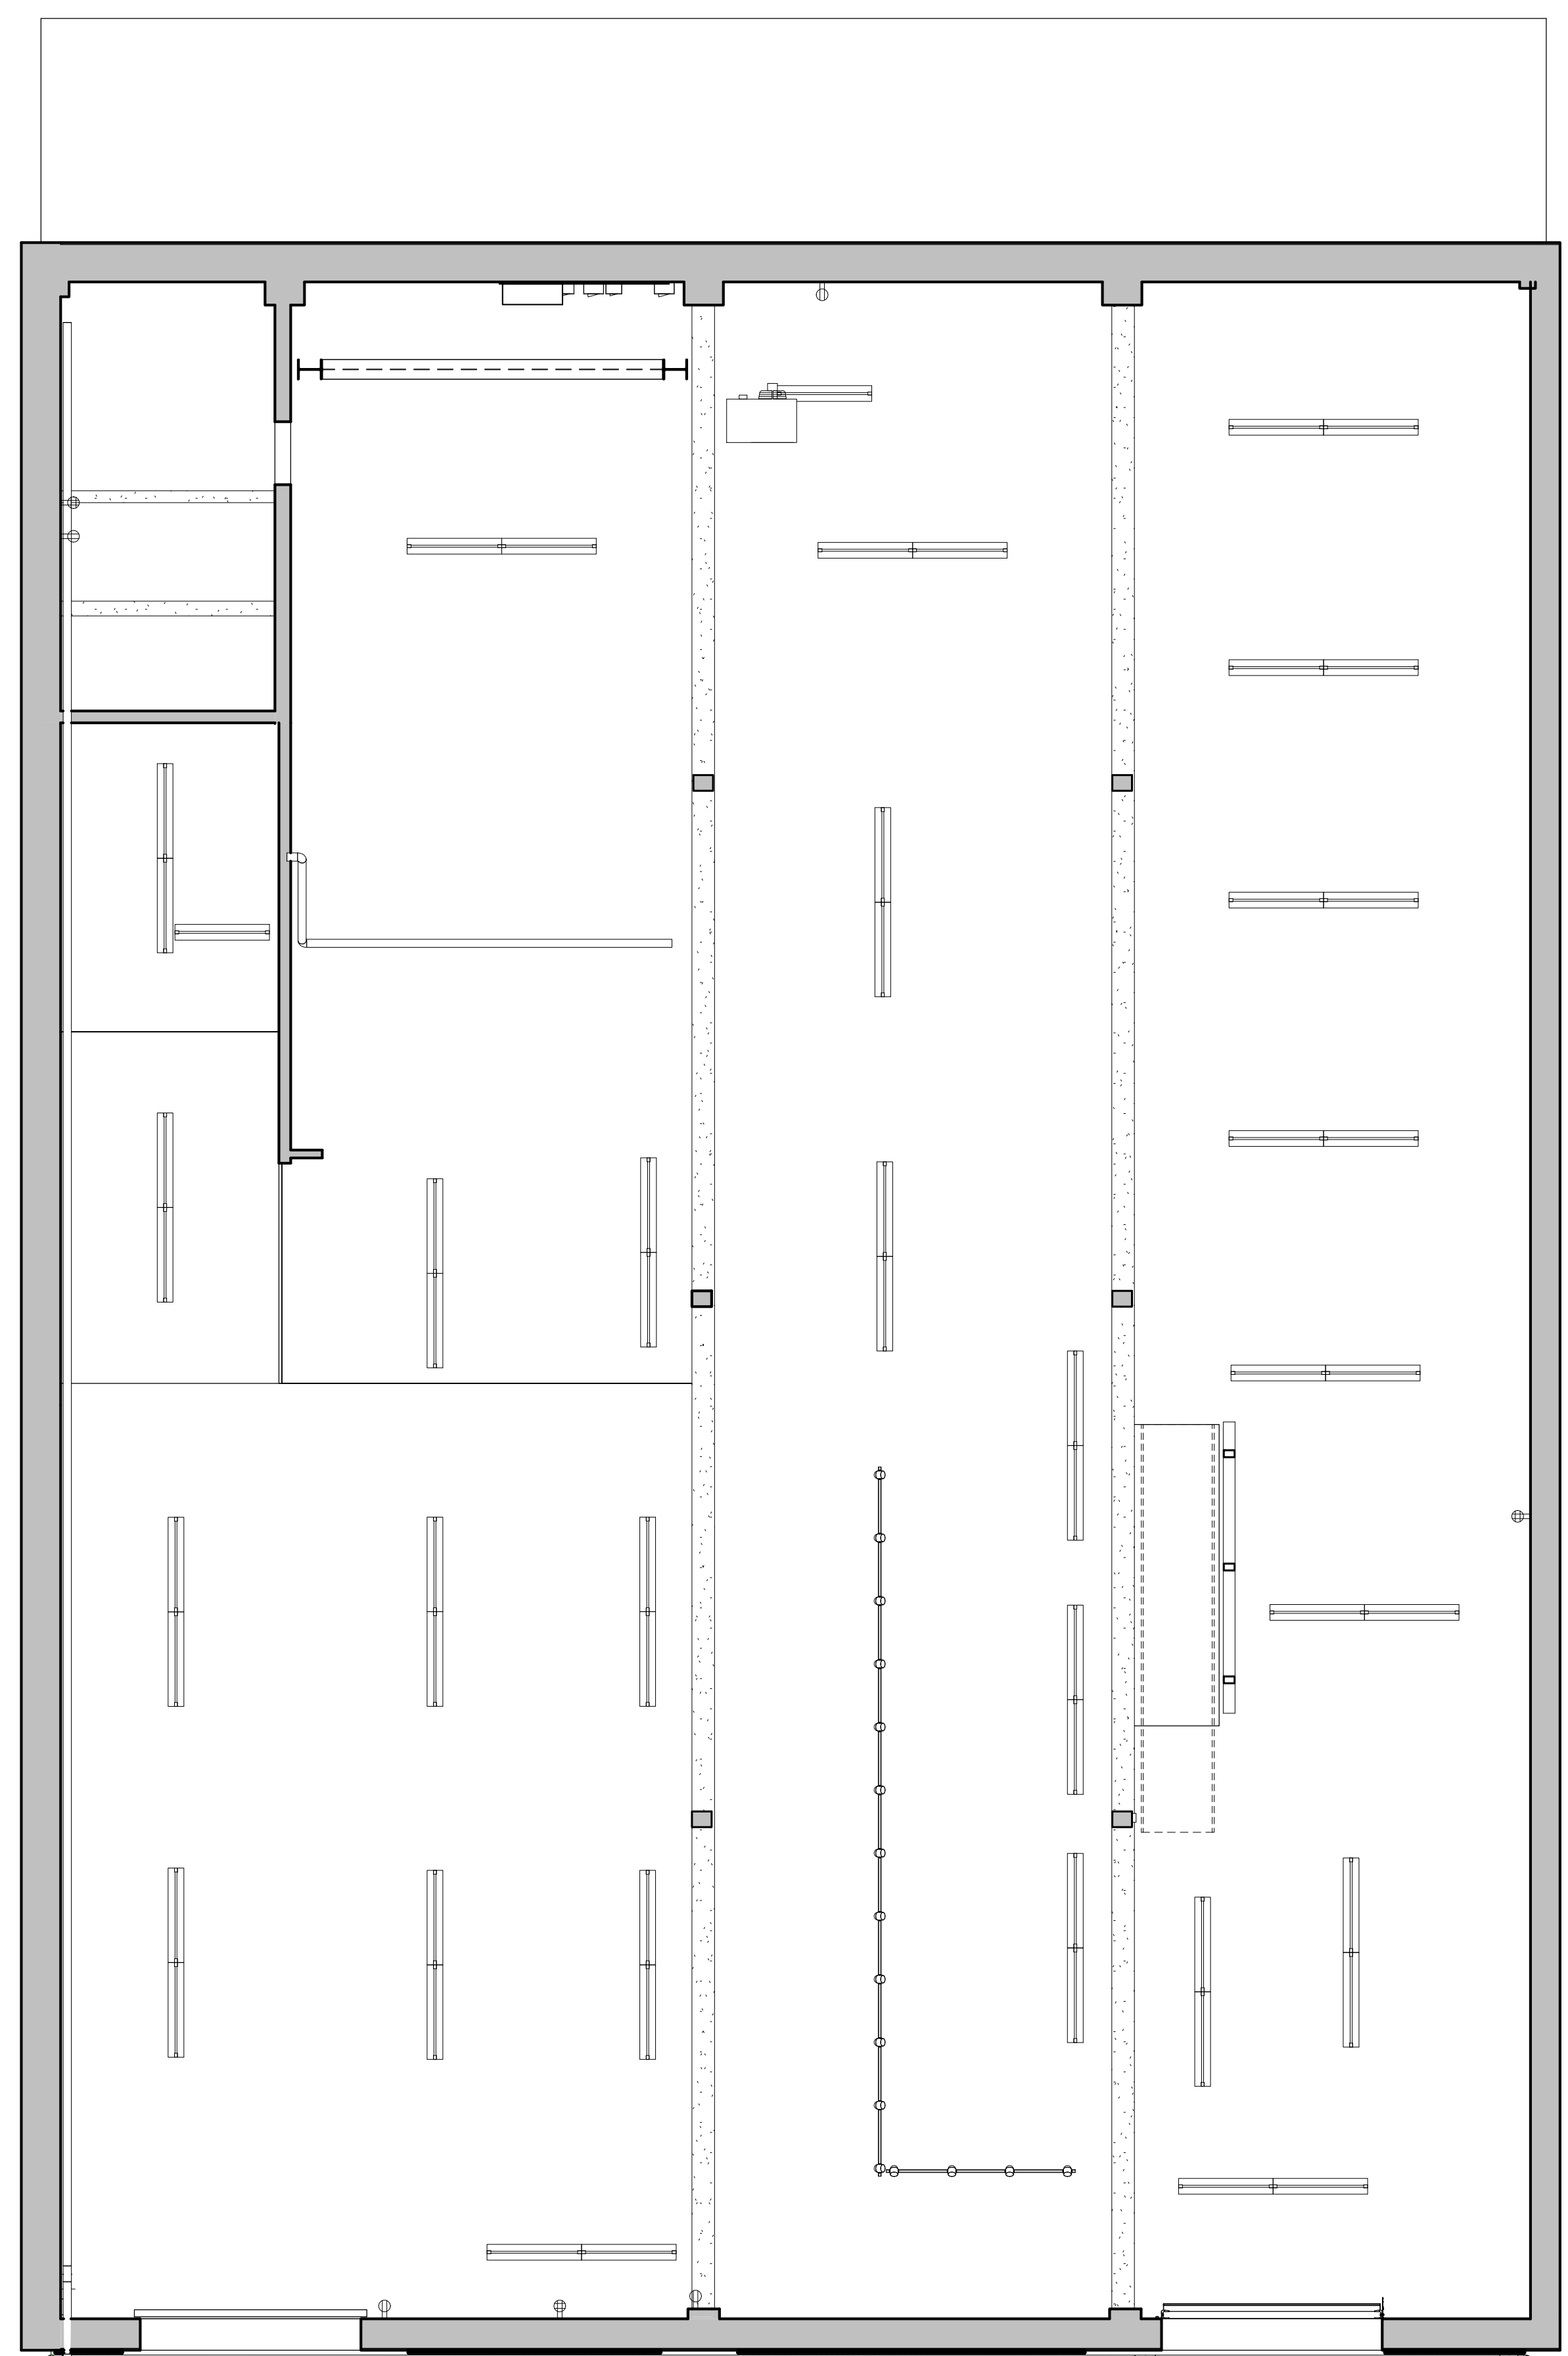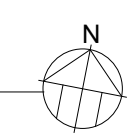

**1 EXISTING BASEMENT REFLECTED CEILING PLAN**  
SCALE: 3/16" = 1'-0"

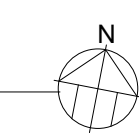


01	100% SUBMISSION	SEE COVER SHEET
NO.	ISSUES / REVISIONS	

**BASEMENT & FIRST FLOOR  
REFLECTED CEILING PLAN**


C.A.	PROJECT MANAGER
A.D.	PROJECT DIRECTOR
21-28	PROJECT NUMBER
	SCALE
A.K.	DRAWN BY
	SHEET NUMBER

**AB-6**



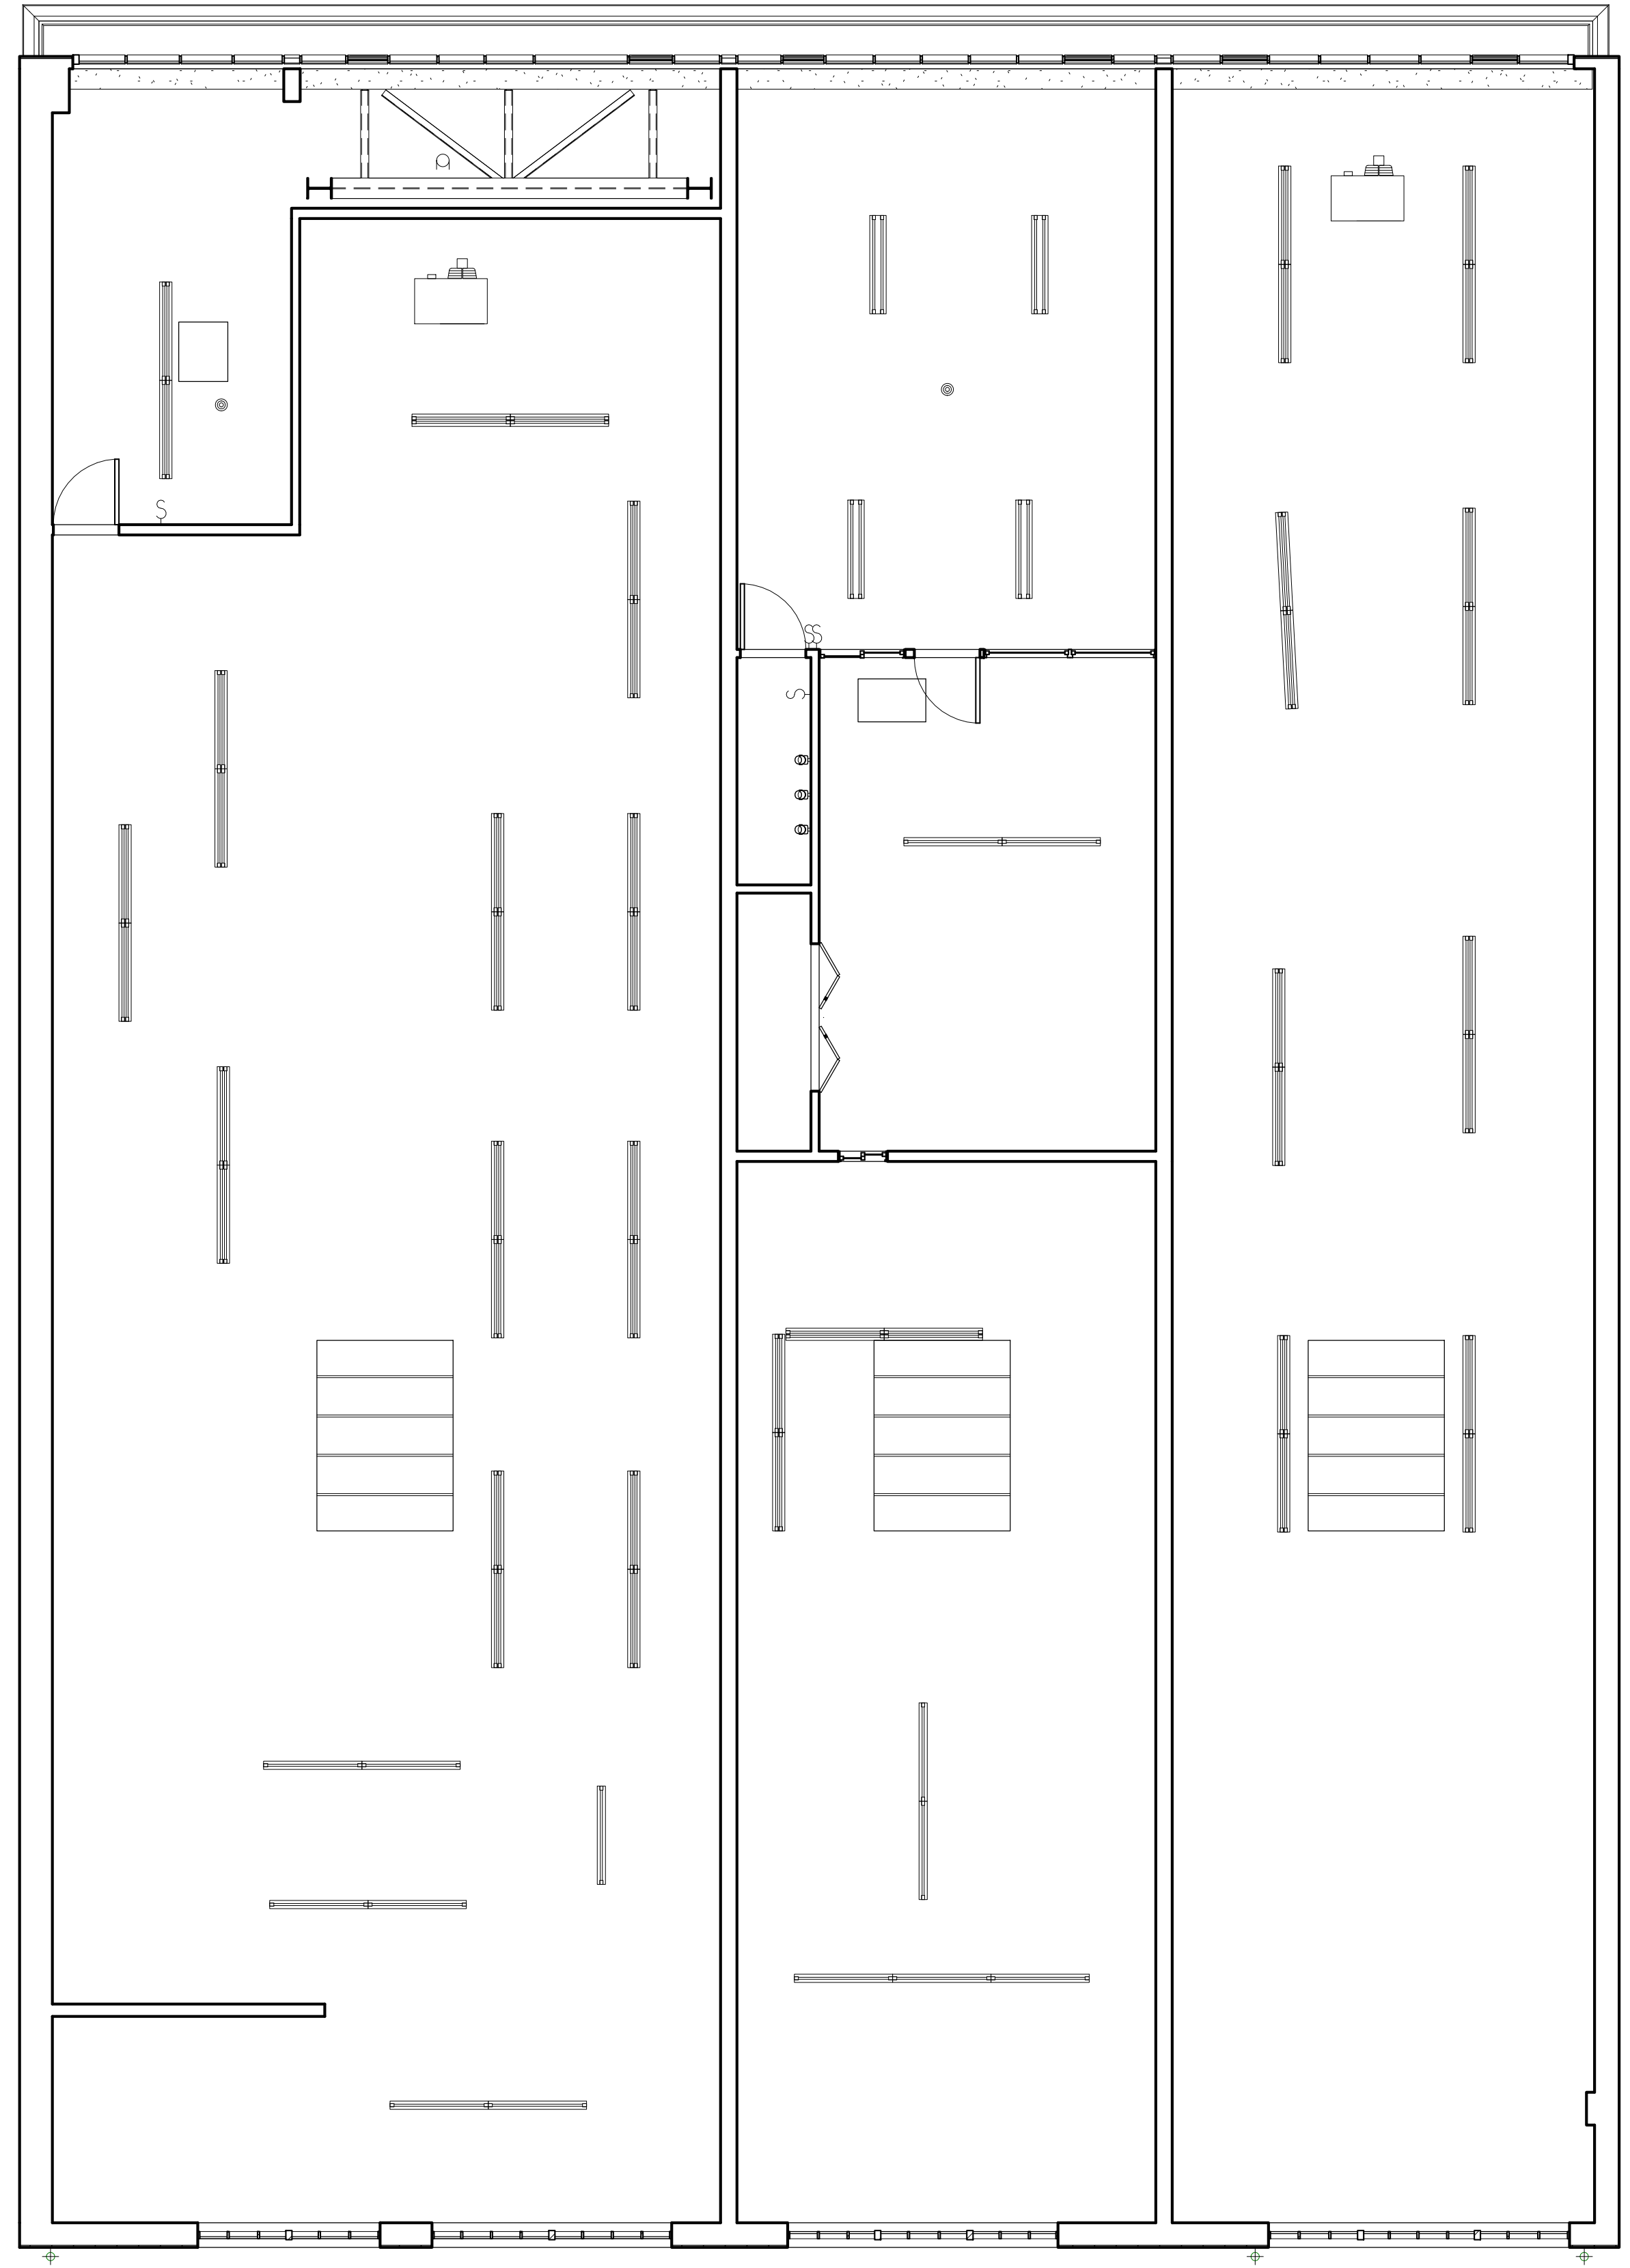

**1** EXISTING SECOND FLOOR REFLECTED CEILING PLAN  
 SCALE: 3/16" = 1'-0"

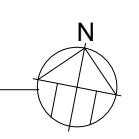


**ARCHITECTURAL AS BUILT**  
**SAN FRANCISCO, CA 94109**

NO.	ISSUES / REVISIONS	SHEET TITLE
01	100% SUBMISSION	SEE COVER SHEET


**SECOND FLOOR  
 REFLECTED CEILING PLAN**

C.A.	PROJECT MANAGER
A.D.	PROJECT DIRECTOR
21-28	PROJECT NUMBER
	SCALE
A.K.	DRAWN BY
	SHEET NUMBER

**AB-7**

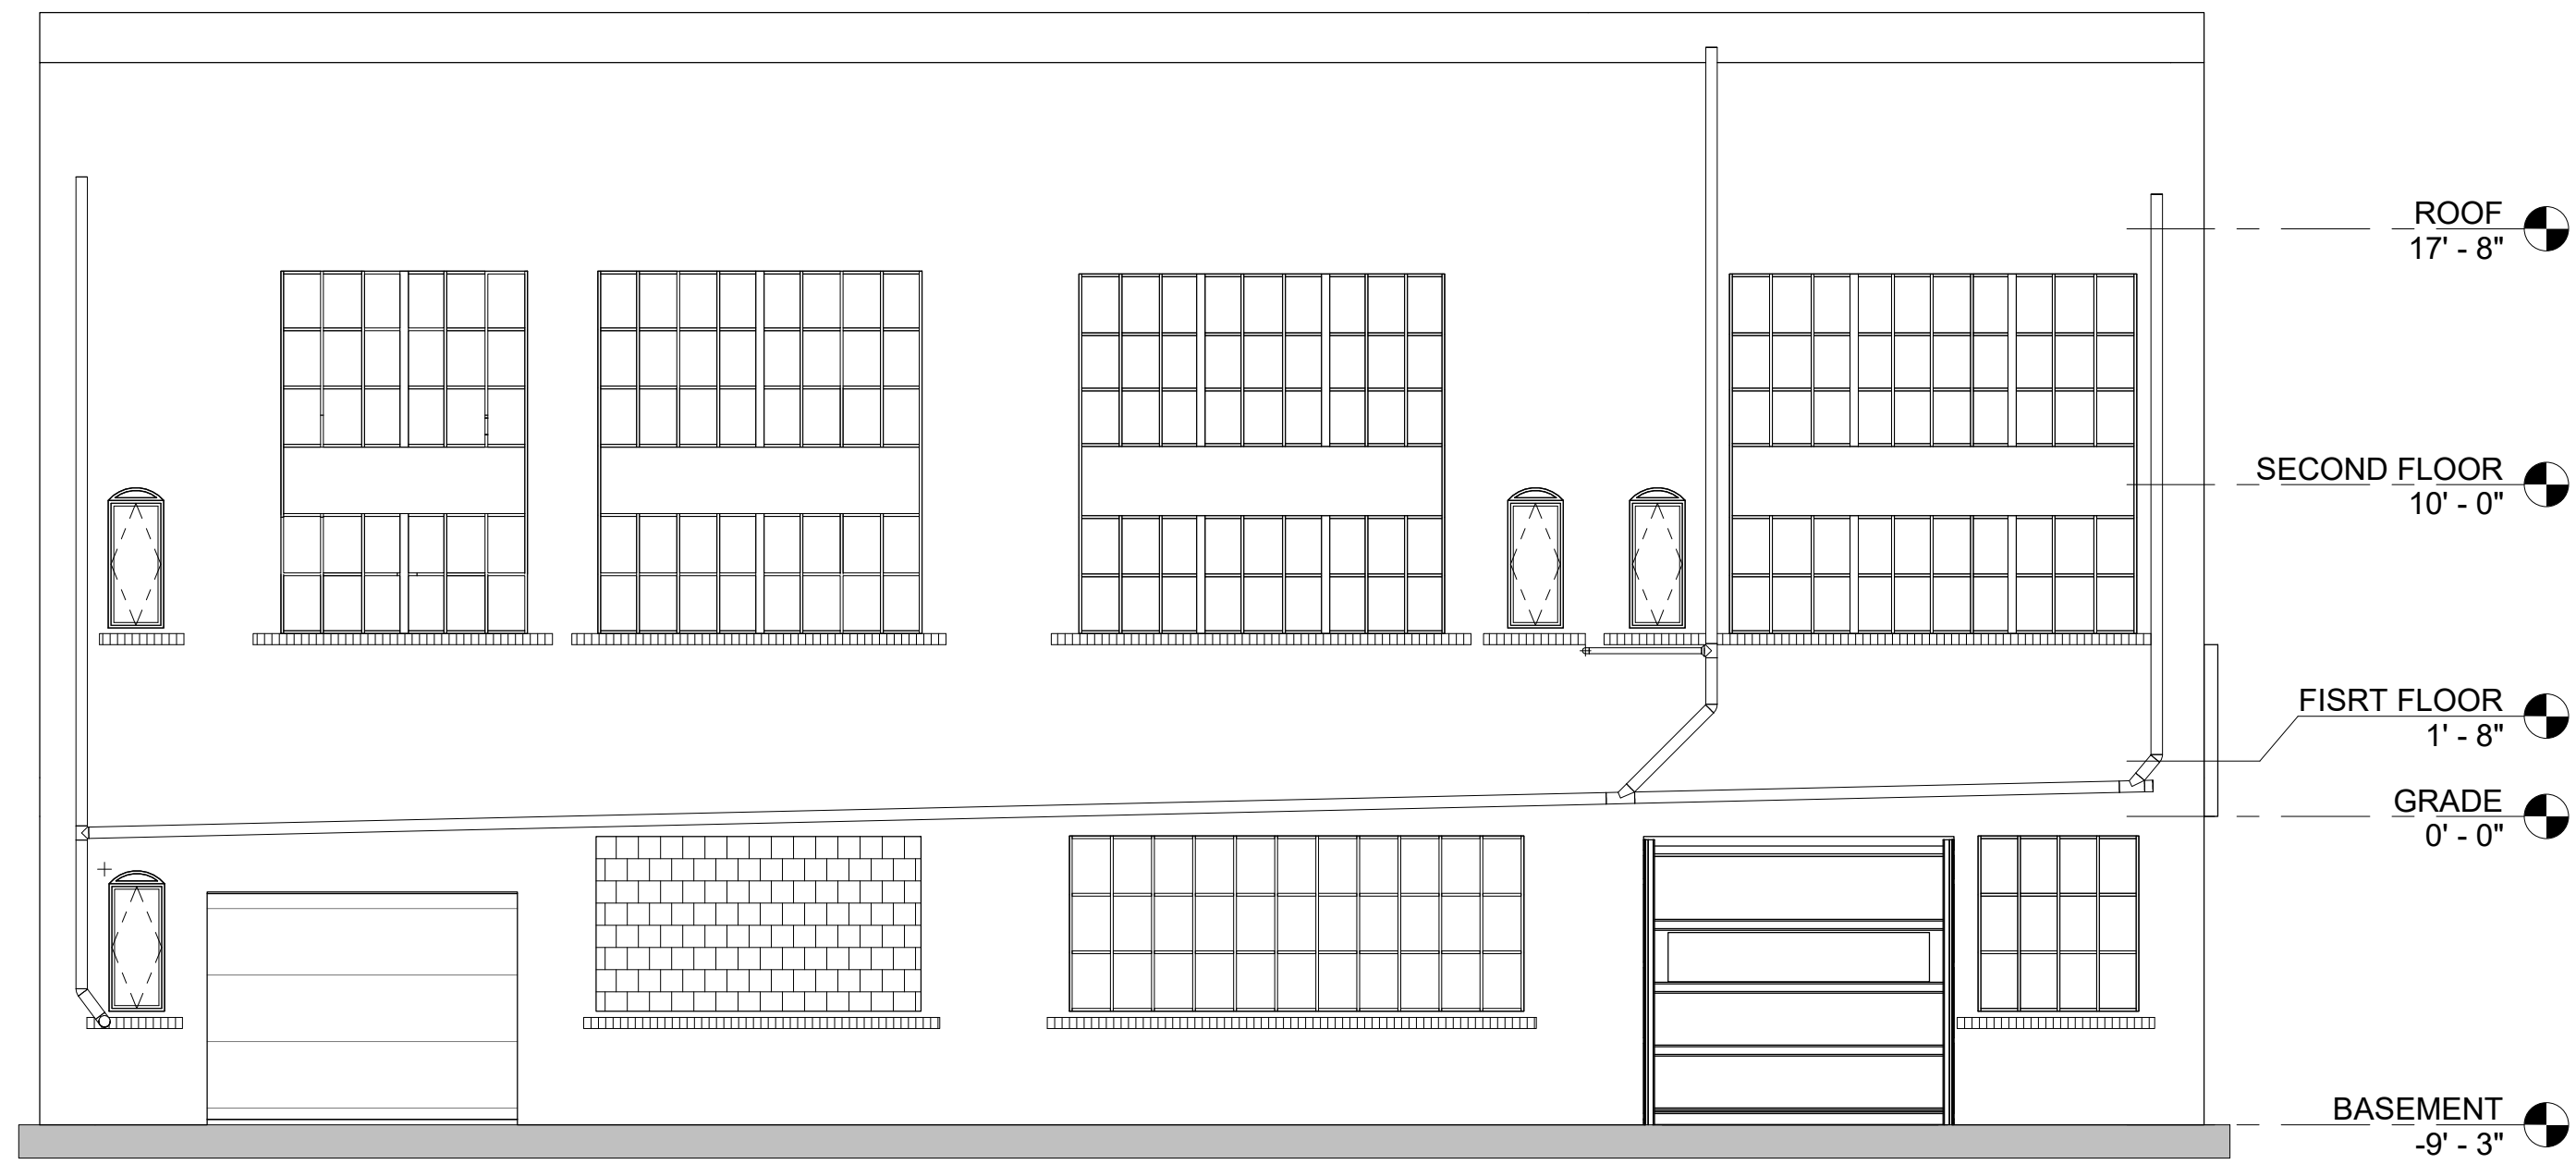

**2** EXISTING REAR ELEVATION  
SCALE: 3/16" = 1'-0"

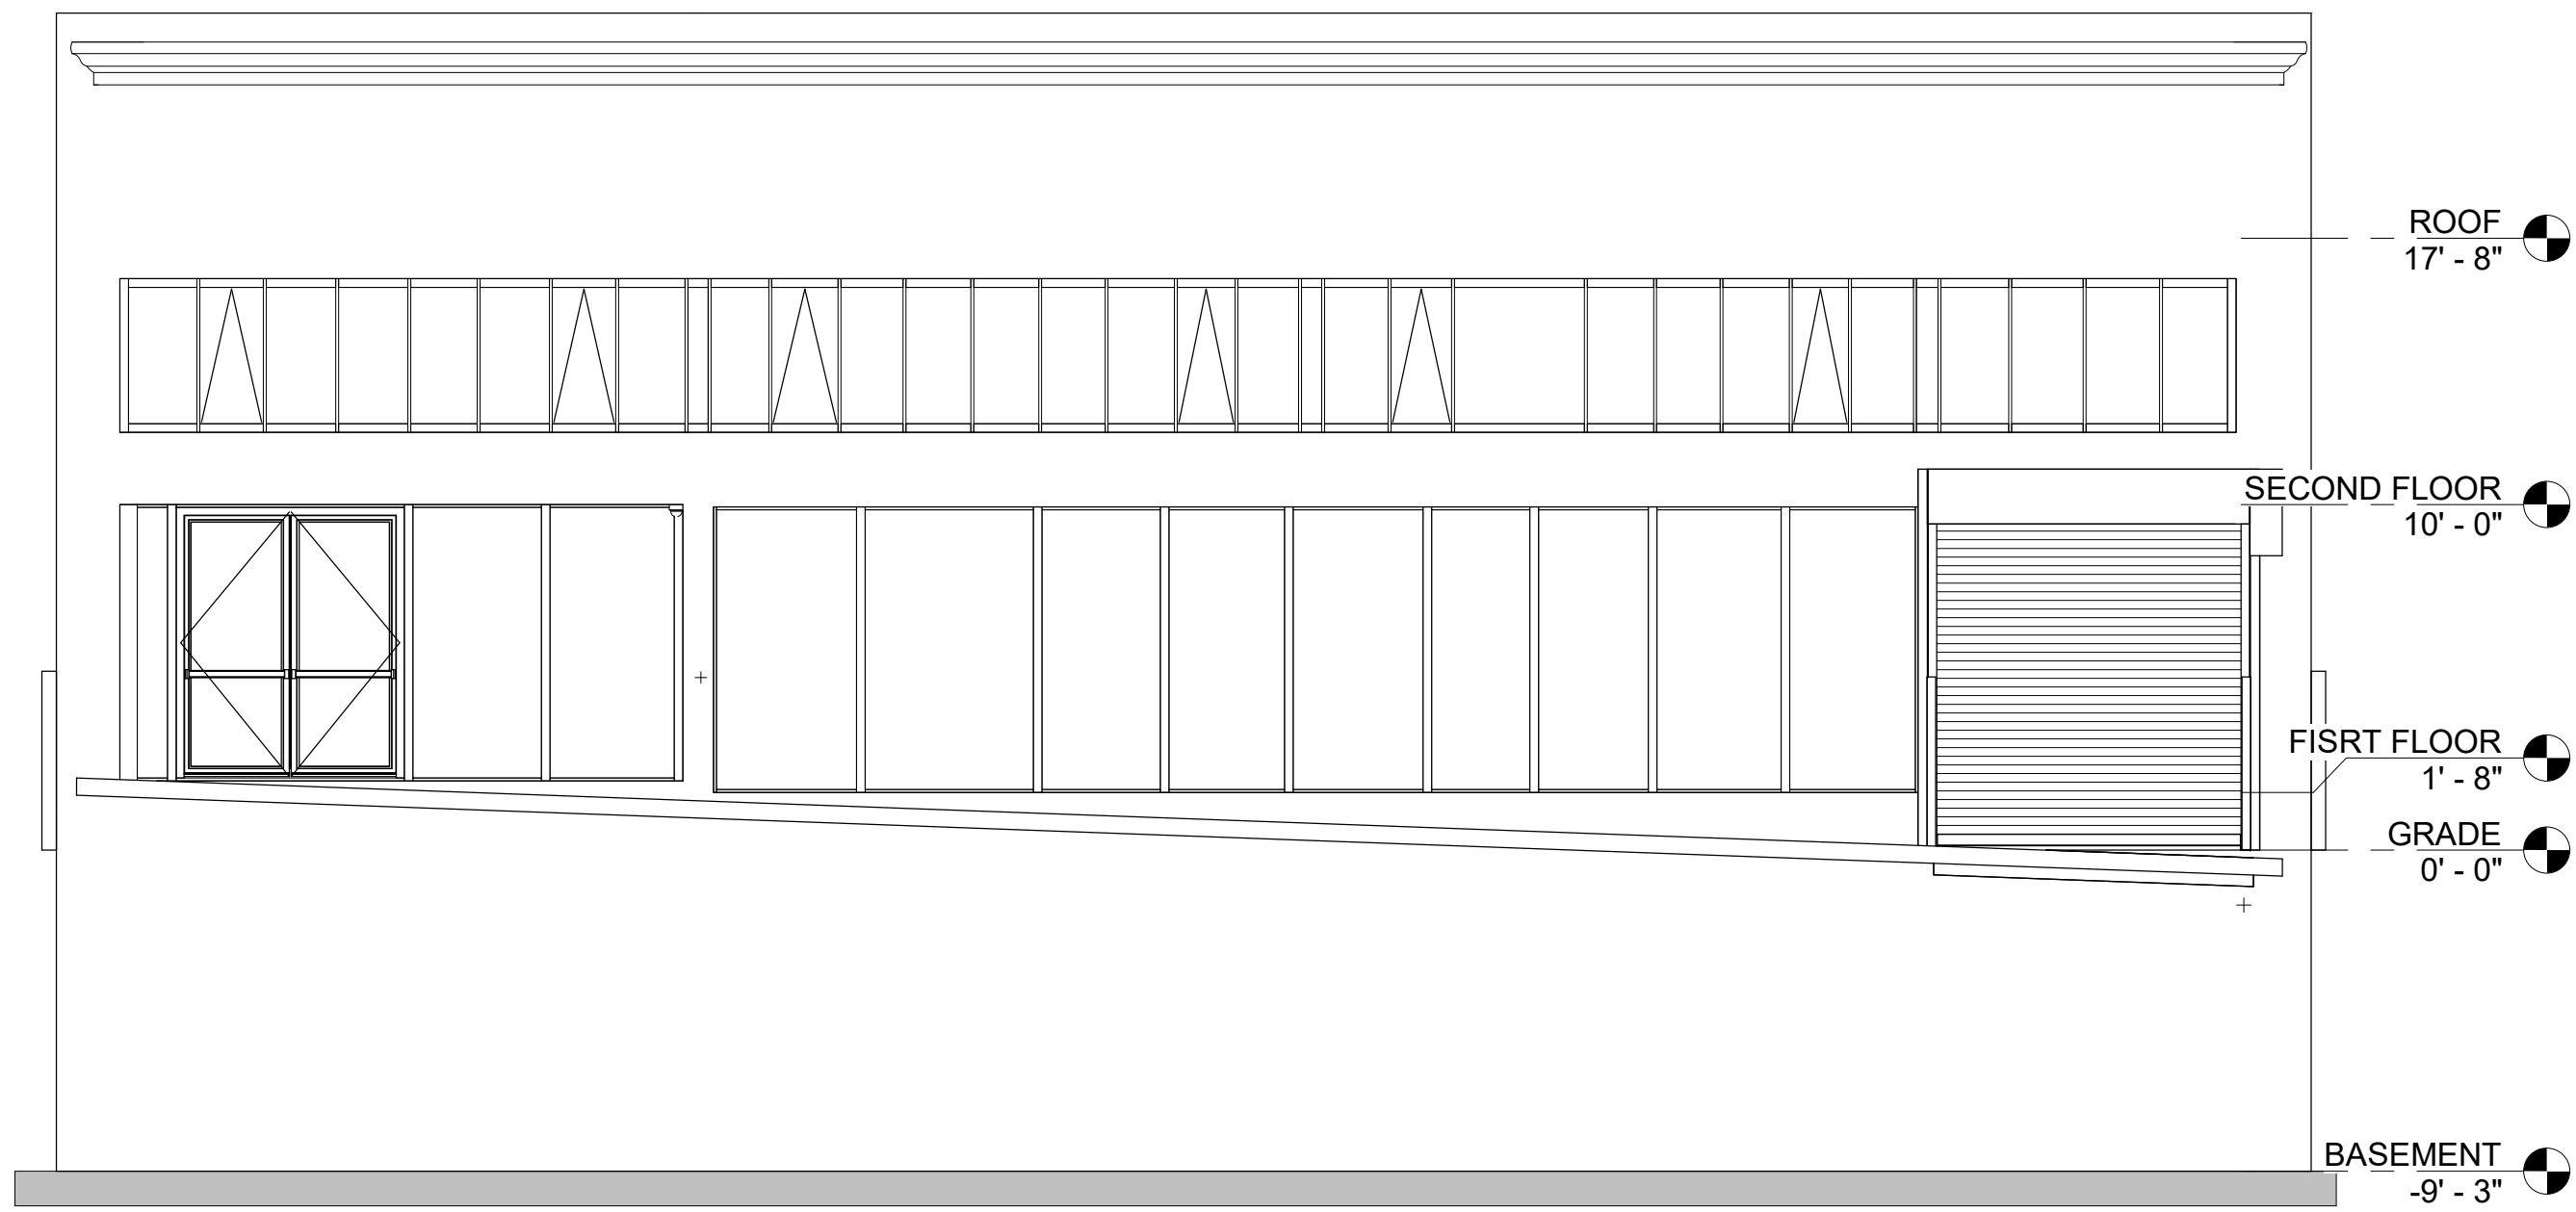

**1** EXISTING FRONT ELEVATION  
SCALE: 3/16" = 1'-0"

**ARCHITECTURAL AS BUILT**  
**SAN FRANCISCO, CA 94109**

01	100% SUBMISSION	SEE COVER SHEET
NO.	ISSUES / REVISIONS	

SHEET TITLE

**EXTERIOR ELEVATIONS**


C.A.	PROJECT MANAGER
A.D.	PROJECT DIRECTOR
21-28	PROJECT NUMBER
	SCALE
A.K.	DRAWN BY
	SHEET NUMBER

**AB-8**







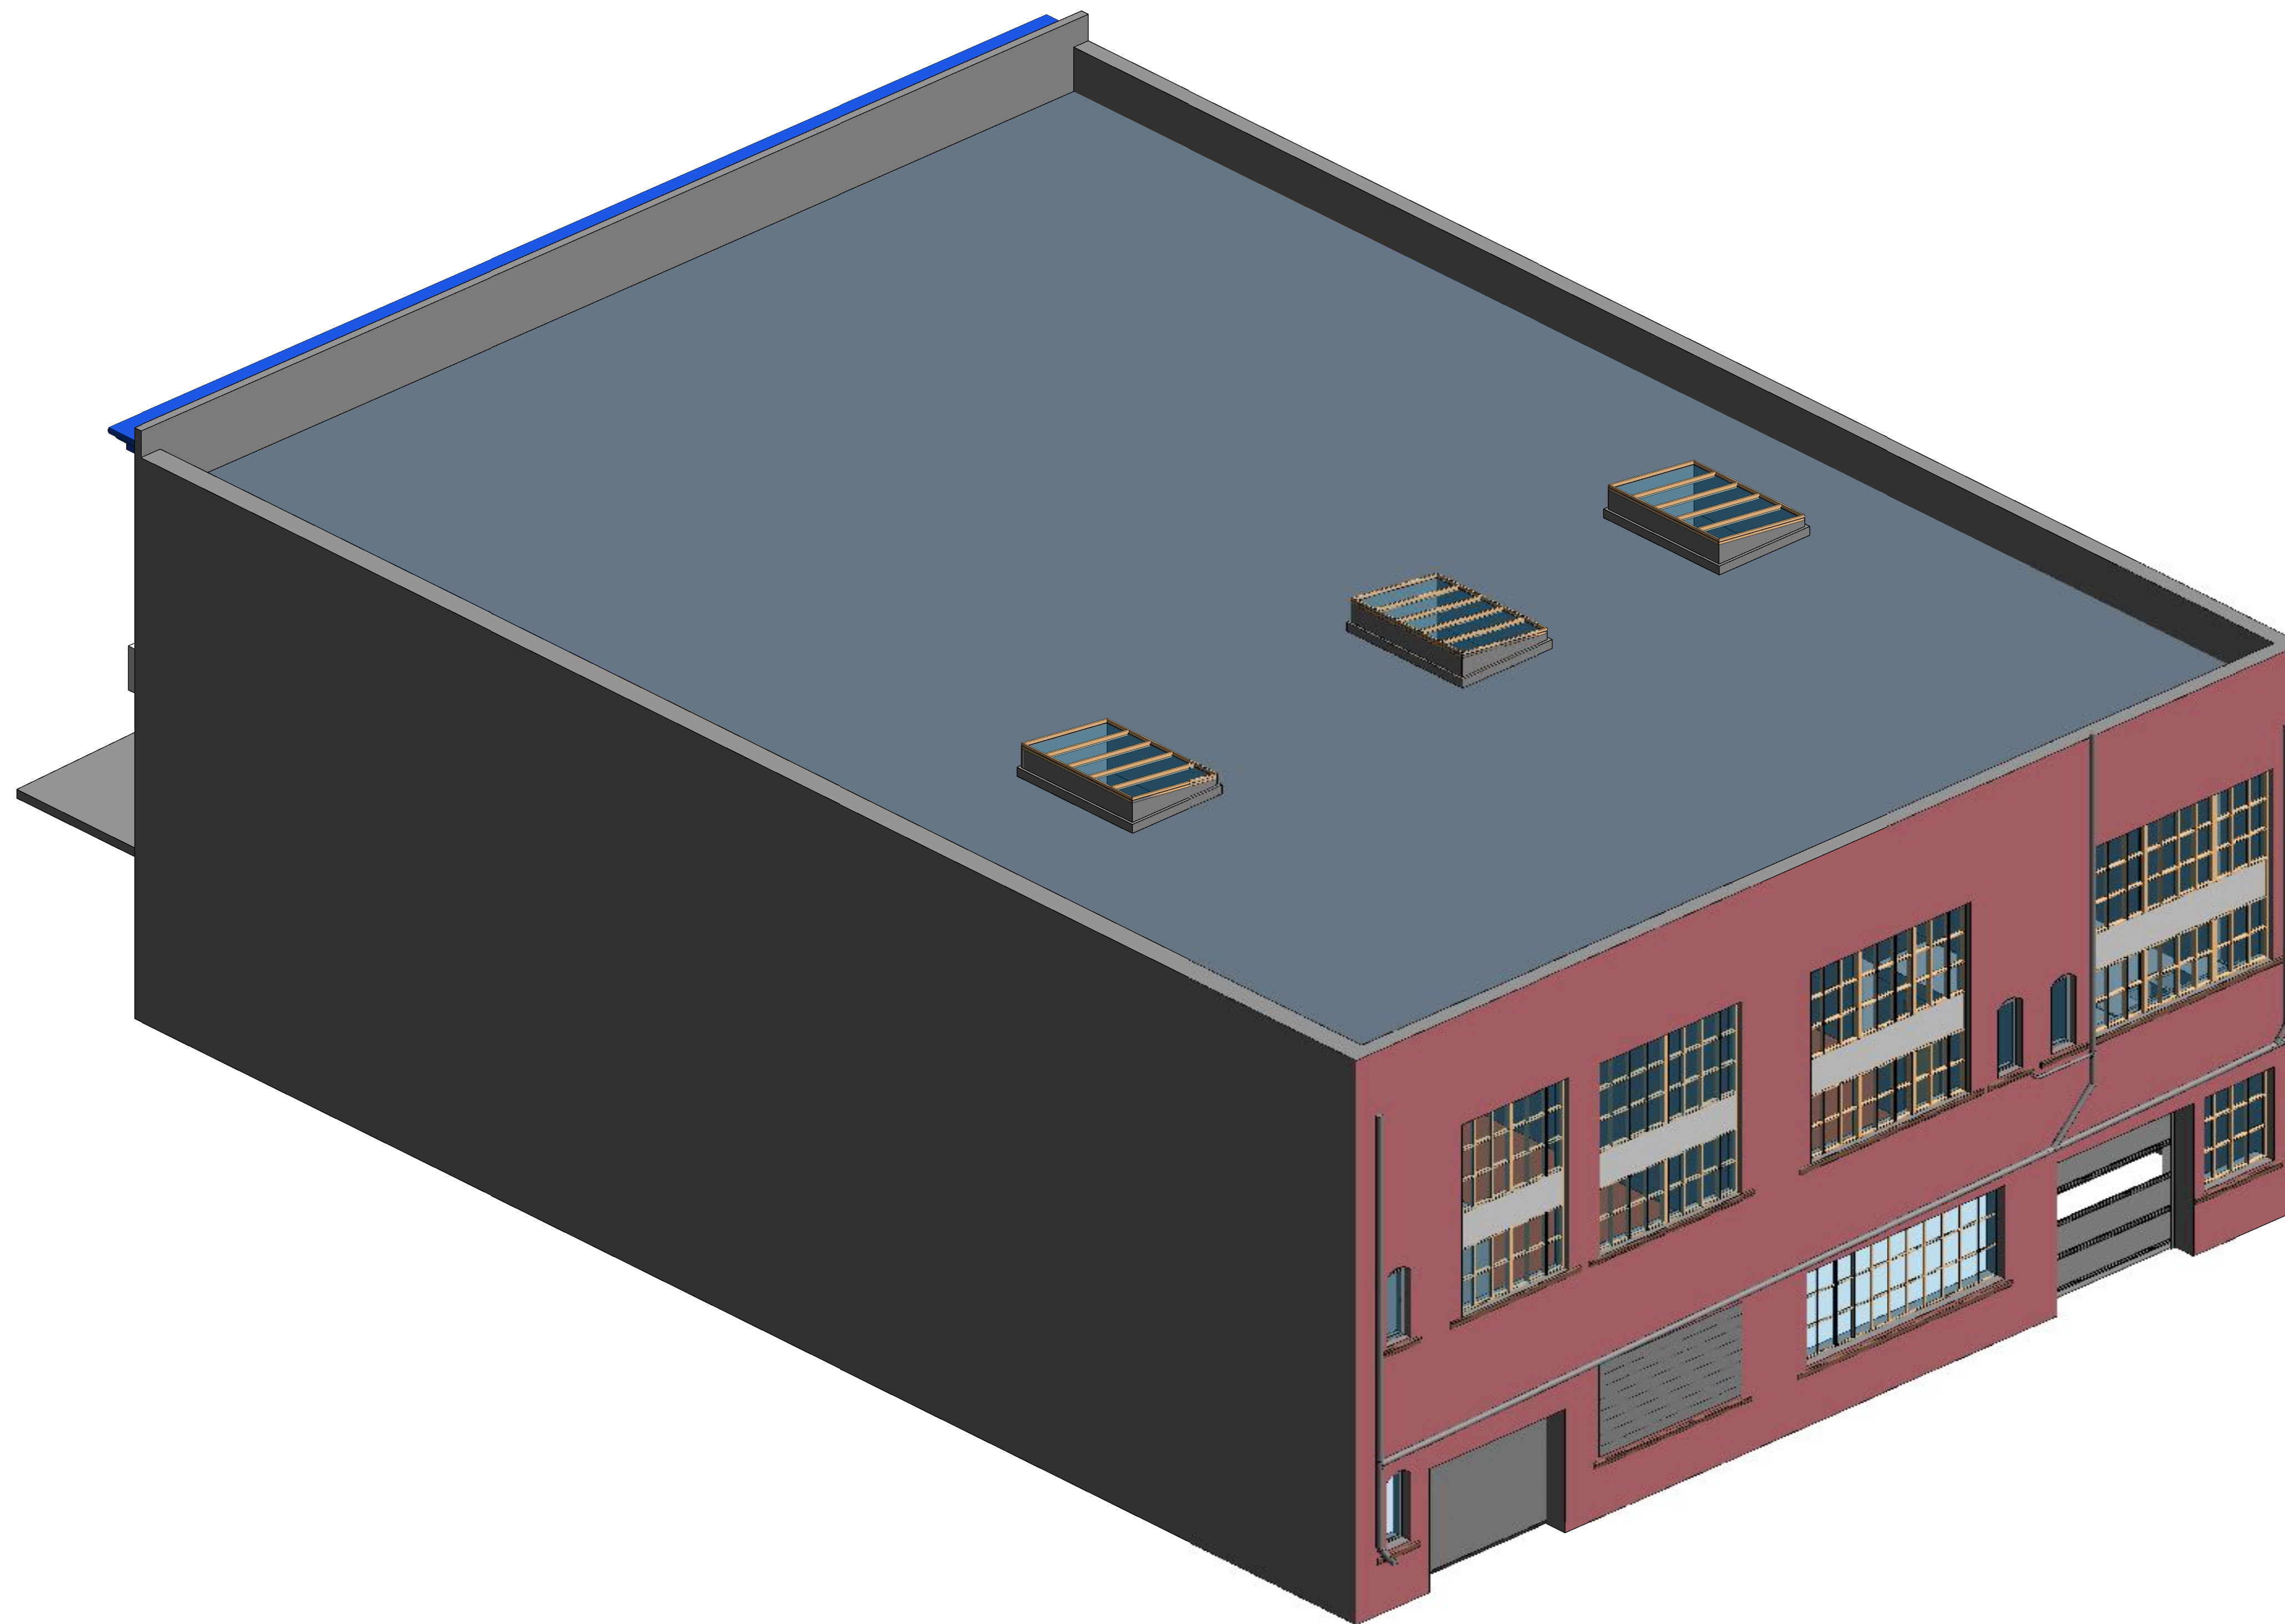

**1 3D VIEW REAR - RIGHT**  
SCALE:

**ARCHITECTURAL AS BUILT**  
**SAN FRANCISCO, CA 94109**

NO.	ISSUES / REVISIONS	DATE	SHEET TITLE
01	100% SUBMISSION		SEE COVER SHEET

**3D VIEW**


C.A.	PROJECT MANAGER
A.D.	PROJECT DIRECTOR
21-28	PROJECT NUMBER
	SCALE
A.K.	DRAWN BY
	SHEET NUMBER

**AB-10**







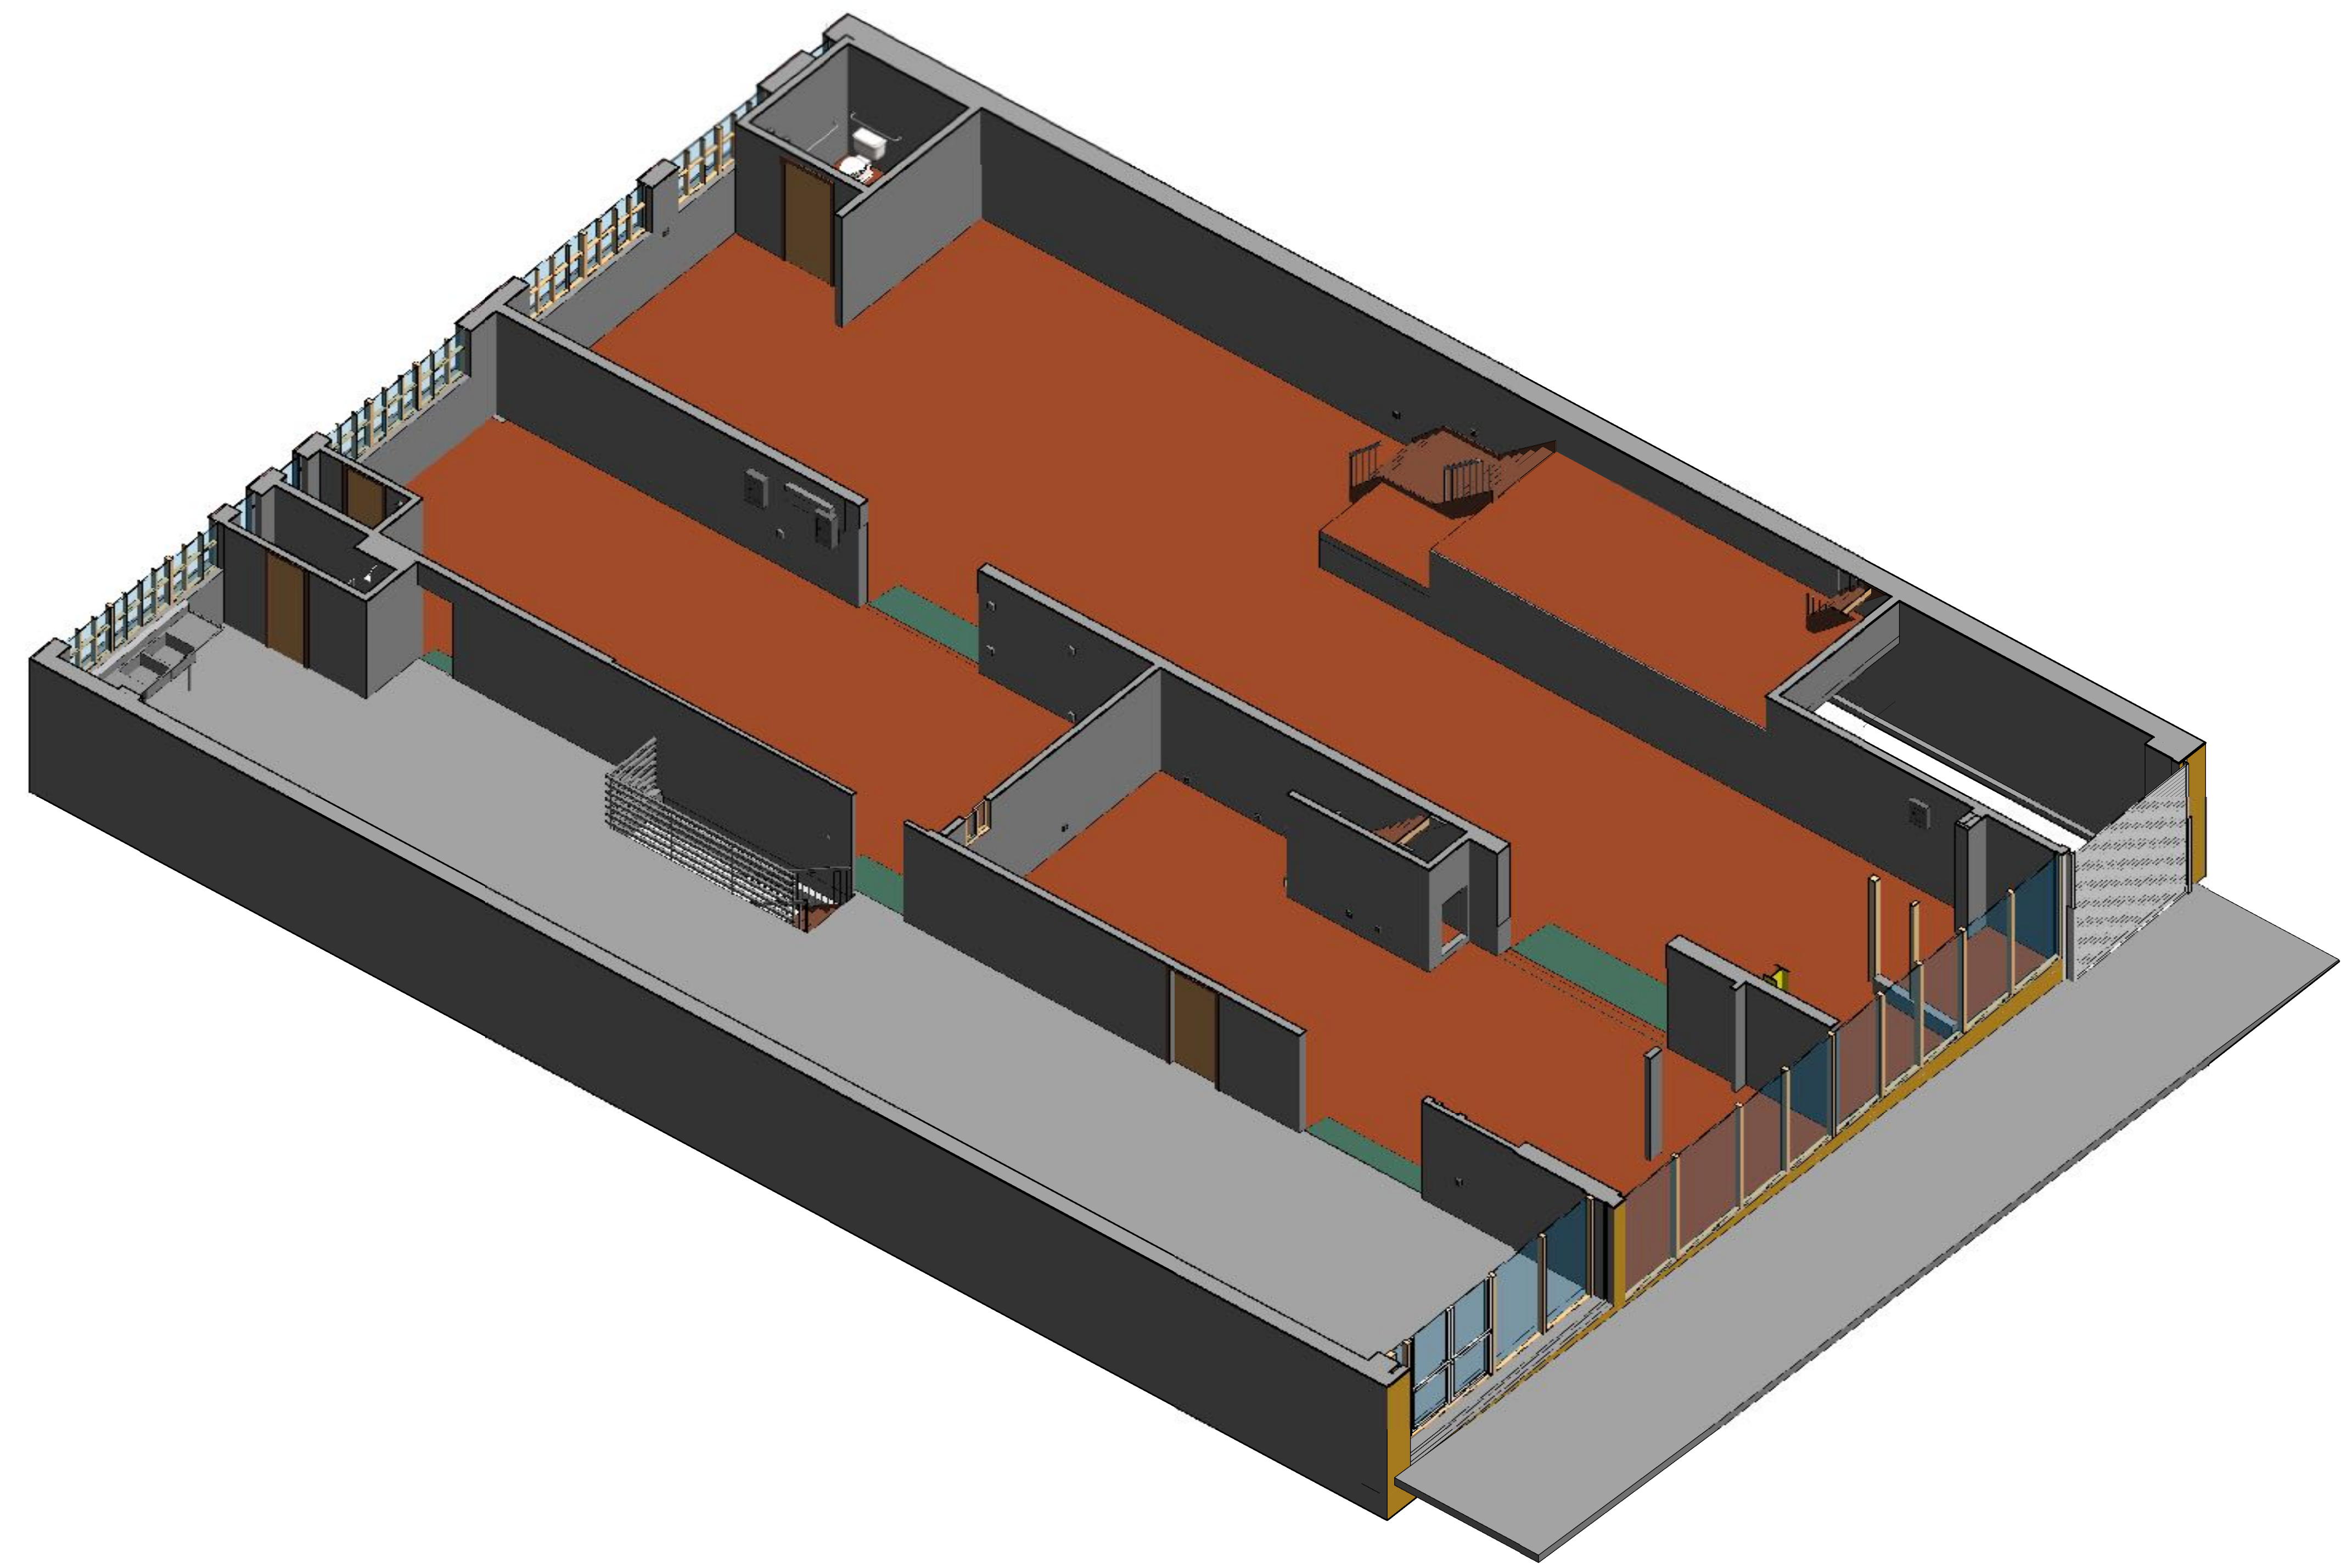

**1 3D FIRST FLOOR**  
 SCALE:

**ARCHITECTURAL AS BUILT**  
**SAN FRANCISCO, CA 94109**


NO.	ISSUES / REVISIONS	DATE	SHEET TITLE
01	100% SUBMISSION		SEE COVER SHEET

**3D SECTION**

C.A.	PROJECT MANAGER
A.D.	PROJECT DIRECTOR
21-28	PROJECT NUMBER
	SCALE
A.K.	DRAWN BY
	SHEET NUMBER

**AB-12**



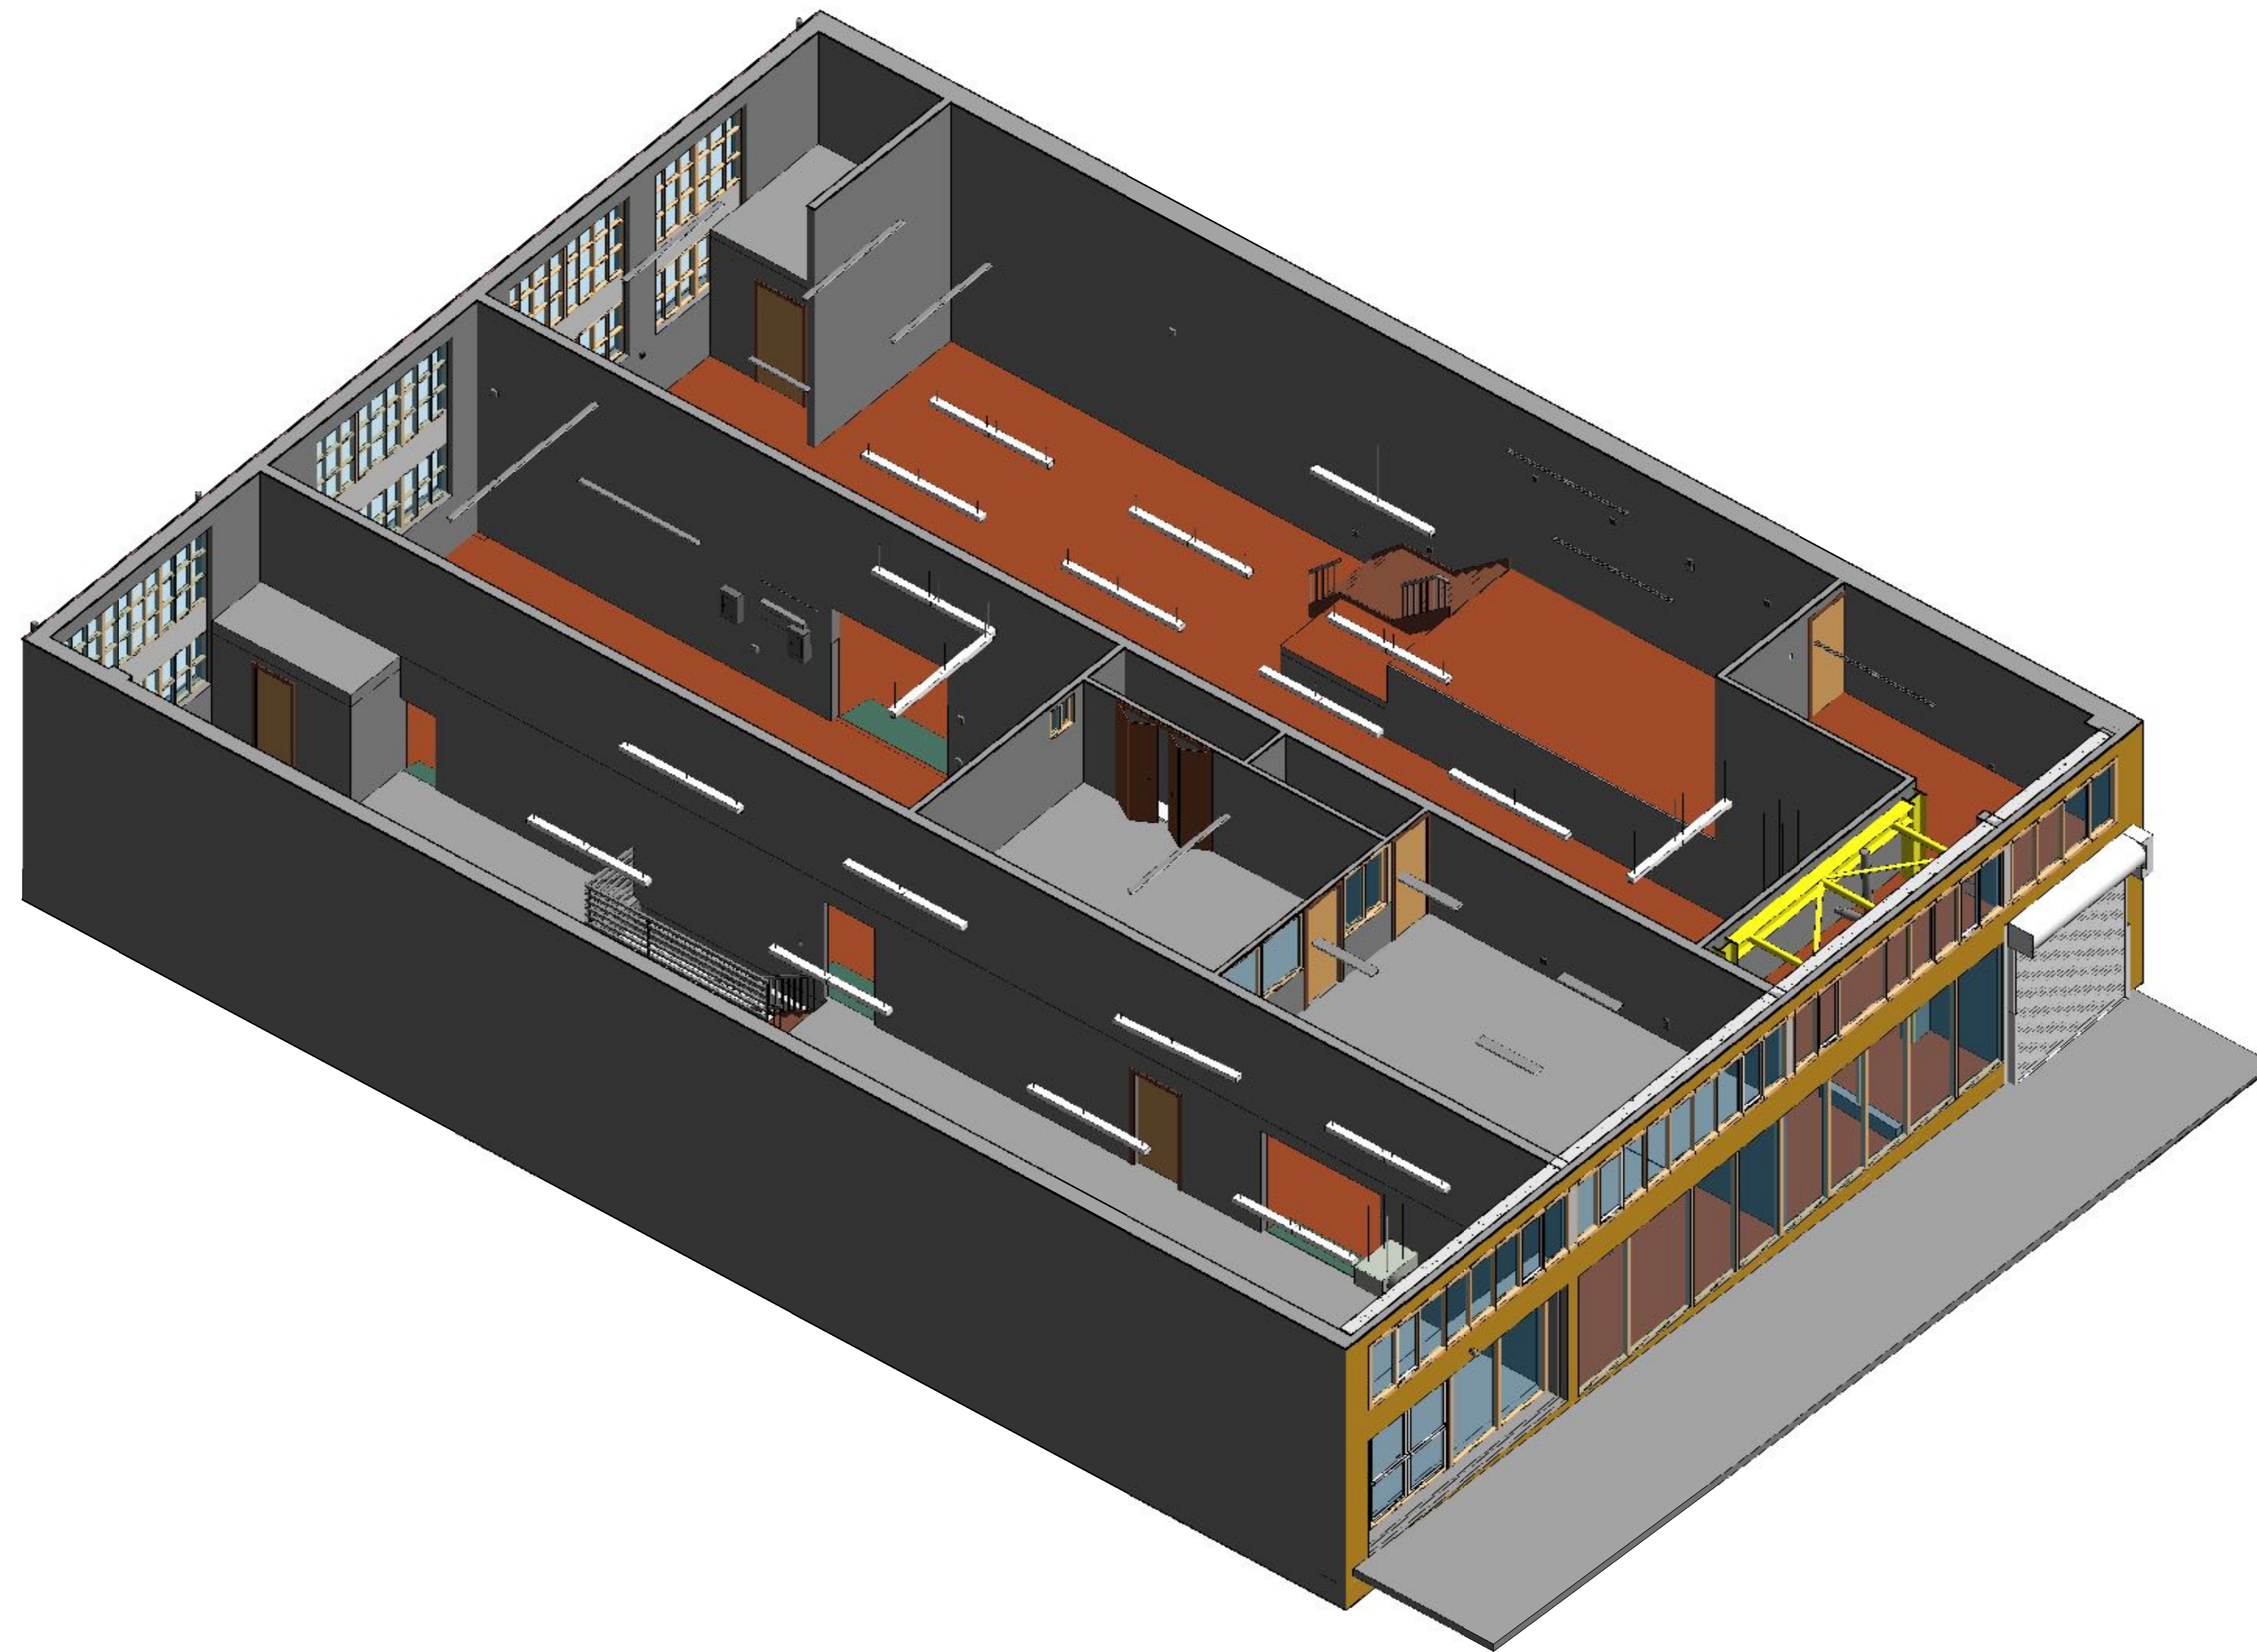

**1** 3D SECOND FLOOR  
SCALE:

**ARCHITECTURAL AS BUILT**  
**SAN FRANCISCO, CA 94109**

01	100% SUBMISSION	SEE COVER SHEET
NO.	ISSUES / REVISIONS	

**3D SECTION**

C.A.	PROJECT MANAGER
A.D.	PROJECT DIRECTOR
21-28	PROJECT NUMBER
	SCALE
A.K.	DRAWN BY
	SHEET NUMBER

**AB-13**