


San Francisco, CA 94107



100% SUBMITTAL

DRAWING INDEX	
0CA	COVER
0SL	SYMBOL LEGEND
AB-1	BASEMENT FLOOR PLAN
AB-2	FIRST FLOOR PLAN
AB-3	SECOND FLOOR PLAN
AB-4	BASEMENT FLOOR REFLECTION CEILING PLAN
AB-5	FIRST FLOOR REFLECTION CEILING PLAN
AB-6	SECOND FLOOR REFLECTION CEILING PLAN
AB-7	EXTERIOR ELEVATIONS
AB-8	EXTERIOR ELEVATIONS
AB-9	3D VIEW
AB-10	3D SECTIONS
AB-11	3D SECTIONS

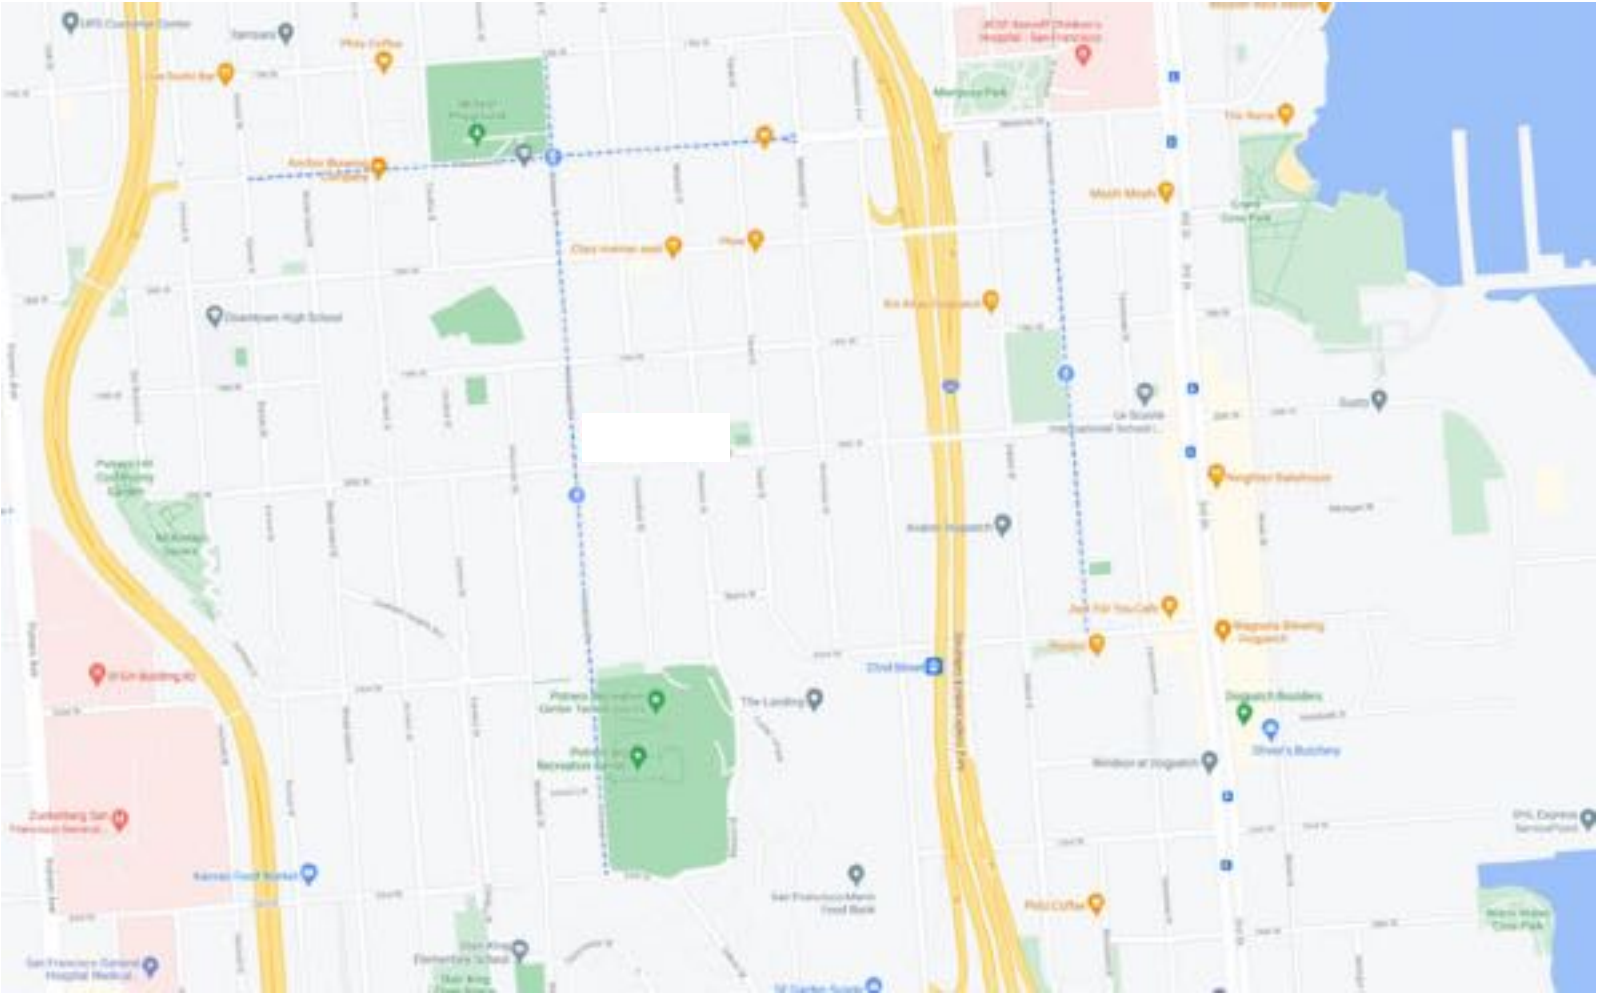

AREA DATA	
BASEMENT	1102 SF
FIRST FLOOR	1218 SF
SECOND FLOOR	1260 SF
GRAND TOTAL	3580 SF

As BUILT

PROFESSIONALS

www.asbuiltprofessionals.com

A DIVISION OF:

AEC

CONSULTANTS INC

844.272.8458

844.ASBUILT

© 2020 AEC CONSULTANTS INC

ARCHITECTURAL AS BUILT

San Francisco, CA 94107

01	100% SUBMISSION	SEE COVER SHEET
NO.	ISSUES / REVISIONS	SHEET TITLE
COVER		
DESIGNER	PROJECT MANAGER	
DESIGNER	PROJECT DIRECTOR	
21-29	PROJECT NUMBER	
	SCALE	
T.H.	DRAWN BY	
SHEET NUMBER		
OCA		



SYMBOLS LEGEND

RCP

EXH		EXHAUST VENT	VL		TRACK LIGHT OR VANITY LIGHT
L1		CEILING MOUNTED LIGHT FIXTURE	WL		WALL-MOUNTED LIGHT FIXTURE
L		CEILING MOUNTED DIRECTIONAL LIGHT	ES		EMERGENCY EXIT SIGN
RC		RECESSED CAN LIGHT	EL		EMERGENCY EXIT LIGHT
EYE		EYEBALL OR SMALL CAN LIGHT	EEL		EMERGENCY EXIT LIGHT W/ SIGN
HPL		PENDANT LIGHT	STAIR		LIGHTED STAIR SIGN
FL		INDIVIDUAL FLUOR. LAY-IN FIXTURE 4 BULB	F		FLOOD LIGHT
FL2		INDIVIDUAL FLUOR. HANGING FIXTURE 2 BULB	PC		PHOTO CELL
FL3		INDIVIDUAL FLUOR. FLUSH MOUNT FIXTURE 4 BULB	F1		CEILING FAN
C		CAMERA	F1LK		CEILING FAN W/ LIGHT KIT
M		MOTION DET.	7-2-6		CEILING HEIGHT AND TRIM 7'-2" ABOVE FLOOR BELOW WITH 6" CROWN MOULDING. NOTE: ALL CEILINGS NOT LABELED ARE PLASTER. CEILINGS SHOWN WITH A GRID ARE LAY IN ACOUSTICAL TILE..
SUP		SUPPLY VENT	J		JUNCTION BOX
SUP2		SUPPLY VENT			
RET		RETURN VENT			
RET2		RETURN VENT			
spe		SPEAKER			

ELECTRIC

DAT		DATA OUTLET
TEL		TELEPHONE JACK
S1		ELECTRIC SWITCH
TV		CABLE TELEVISION OUTLET
P1		DUPLEX RECEPTACLE OUTLET
P3		SPECIAL PURPOSE CONNECTION OR OUTLET
PQ		QUADRUPLUX RECEPTACLE OUTLET
PF		FLOOR DUPLEX RECEPTACLE OUTLET
PNL		ELECTRIC PANEL
MTR		ELECTRIC METER
BUT		BUTTON SWITCH
DISC		DISCONNECT SWITCH
LG		GROUND/FLOOR LIGHT
KP		KEY PAD

FIRE PROTECTION


FE		FIRE EXTINGUISHER
FP		FIRE PULL
AS		FIRE ALARM (HORN/SRTOBE)
SD		SMOKE DETECTOR
SS		SMOKE ALARM SPEAKER
SP		SPRINKLER HEAD CEILING MOUNT
SPW		SPRINKLER HEAD WALL MOUNT

MEP


TH		THERMOSTAT
FD		FLOOR DRAIN
V		VALVE
HB		HOSE BIB
WS		WATER SUPPLY
HEAT		SUSPENDED GAS HEATER

MISC

BOLLARD		BOLLARD
ELEVATION SYMBOL		11-4-11/16 SPOT ELEVATION

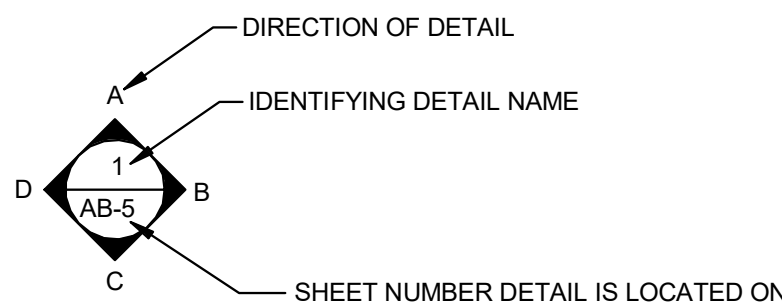


INTERIOR ELEVATIONS

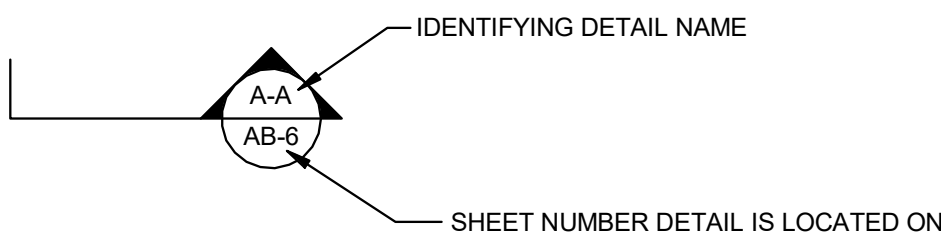

BUILDING SECTION

PHOTO DOCUMENTATION LEGEND

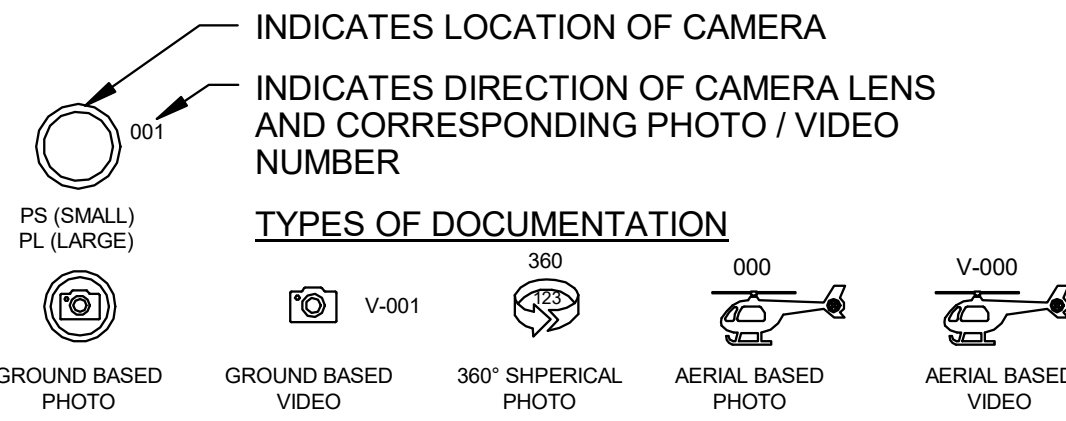

ARCHITECTURAL AS BUILT

San Francisco, CA 94107

SYMBOL LEGEND

DESIGNER	PROJECT MANAGER
DESIGNER	PROJECT DIRECTOR
21-29	PROJECT NUMBER
	SCALE
T.H.	DRAWN BY
	SHEET NUMBER

OSL

DOOR SCHEDULE		
TAG	WIDTH	HEIGHT


1	8' - 11 1/2"	7' - 3 1/2"
2	2' - 6"	7' - 3 1/2"
3	5' - 2 1/2"	7' - 3 1/2"
4	6' - 0"	6' - 8"
5	3' - 0"	7' - 8"
6	2' - 2 1/2"	7' - 5 1/2"
7	2' - 4"	6' - 4 1/2"
8	2' - 4"	6' - 2 1/2"
9	2' - 8"	6' - 2"
10	2' - 2"	6' - 8"
11	3' - 4"	7' - 0"
12	2' - 4"	6' - 5"
13	2' - 4"	6' - 5"
14	5' - 11"	6' - 6 1/2"
15	2' - 8"	6' - 8"
16	2' - 10"	6' - 4"
17	0' - 0"	0' - 0"
18	2' - 4"	6' - 5"
19	8' - 0"	7' - 6"
21	2' - 4"	6' - 2 1/2"
22	2' - 8"	6' - 4"
23	2' - 2"	6' - 2 1/2"
24	3' - 0"	6' - 8"
25	2' - 2"	6' - 8"
26	2' - 8"	6' - 8"
27	2' - 8"	6' - 8"
28	2' - 8"	6' - 2"
29	2' - 8"	6' - 9"
30	1' - 2"	6' - 8"
31	3' - 4"	6' - 3"
32	3' - 4"	6' - 3"
33	1' - 9"	6' - 7"

WINDOW SCHEDULE			
TAG	WIDTH	HEIGHT	Operation

1	8' - 11 1/2"	5' - 11 1/2"	Casement
2	4' - 0"	3' - 2 1/2"	Casement
3	7' - 8"	4' - 5"	Casement
4	1' - 6"	6' - 6"	Fixed
5	1' - 6"	6' - 6"	Fixed
6	3' - 2"	3' - 0"	Double-Hung
7	10' - 0"	5' - 0"	Double-Sliding
8	8' - 0"	5' - 0"	Double-Sliding
9	3' - 0"	4' - 2"	Casement
10	2' - 7"	6' - 0"	Casement
11	4' - 0"	6' - 0"	Casement
12	2' - 2"	3' - 10"	Double-Hung
13	8' - 8 1/2"	1' - 3"	Fixed
14	2' - 8"	1' - 3"	Casement
15	3' - 2 1/2"	5' - 10 1/2"	Fixed
16	3' - 1"	1' - 6 1/2"	Fixed
17	3' - 1"	1' - 6 1/2"	Fixed
18	1' - 10"	4' - 2"	Casement
19	2' - 7"	0' - 2 1/2"	TopHungCasement
20	2' - 7"	0' - 2 1/2"	TopHungCasement
21	2' - 7"	0' - 2 1/2"	TopHungCasement

ARCH WINDOW SCHEDULE		
TAG	WIDTH	HEIGHT

1	7'-10"	6'-11"
2	7'-10"	6'-11"
3	7'-10"	6'-11"
4	7'-10"	6'-11"

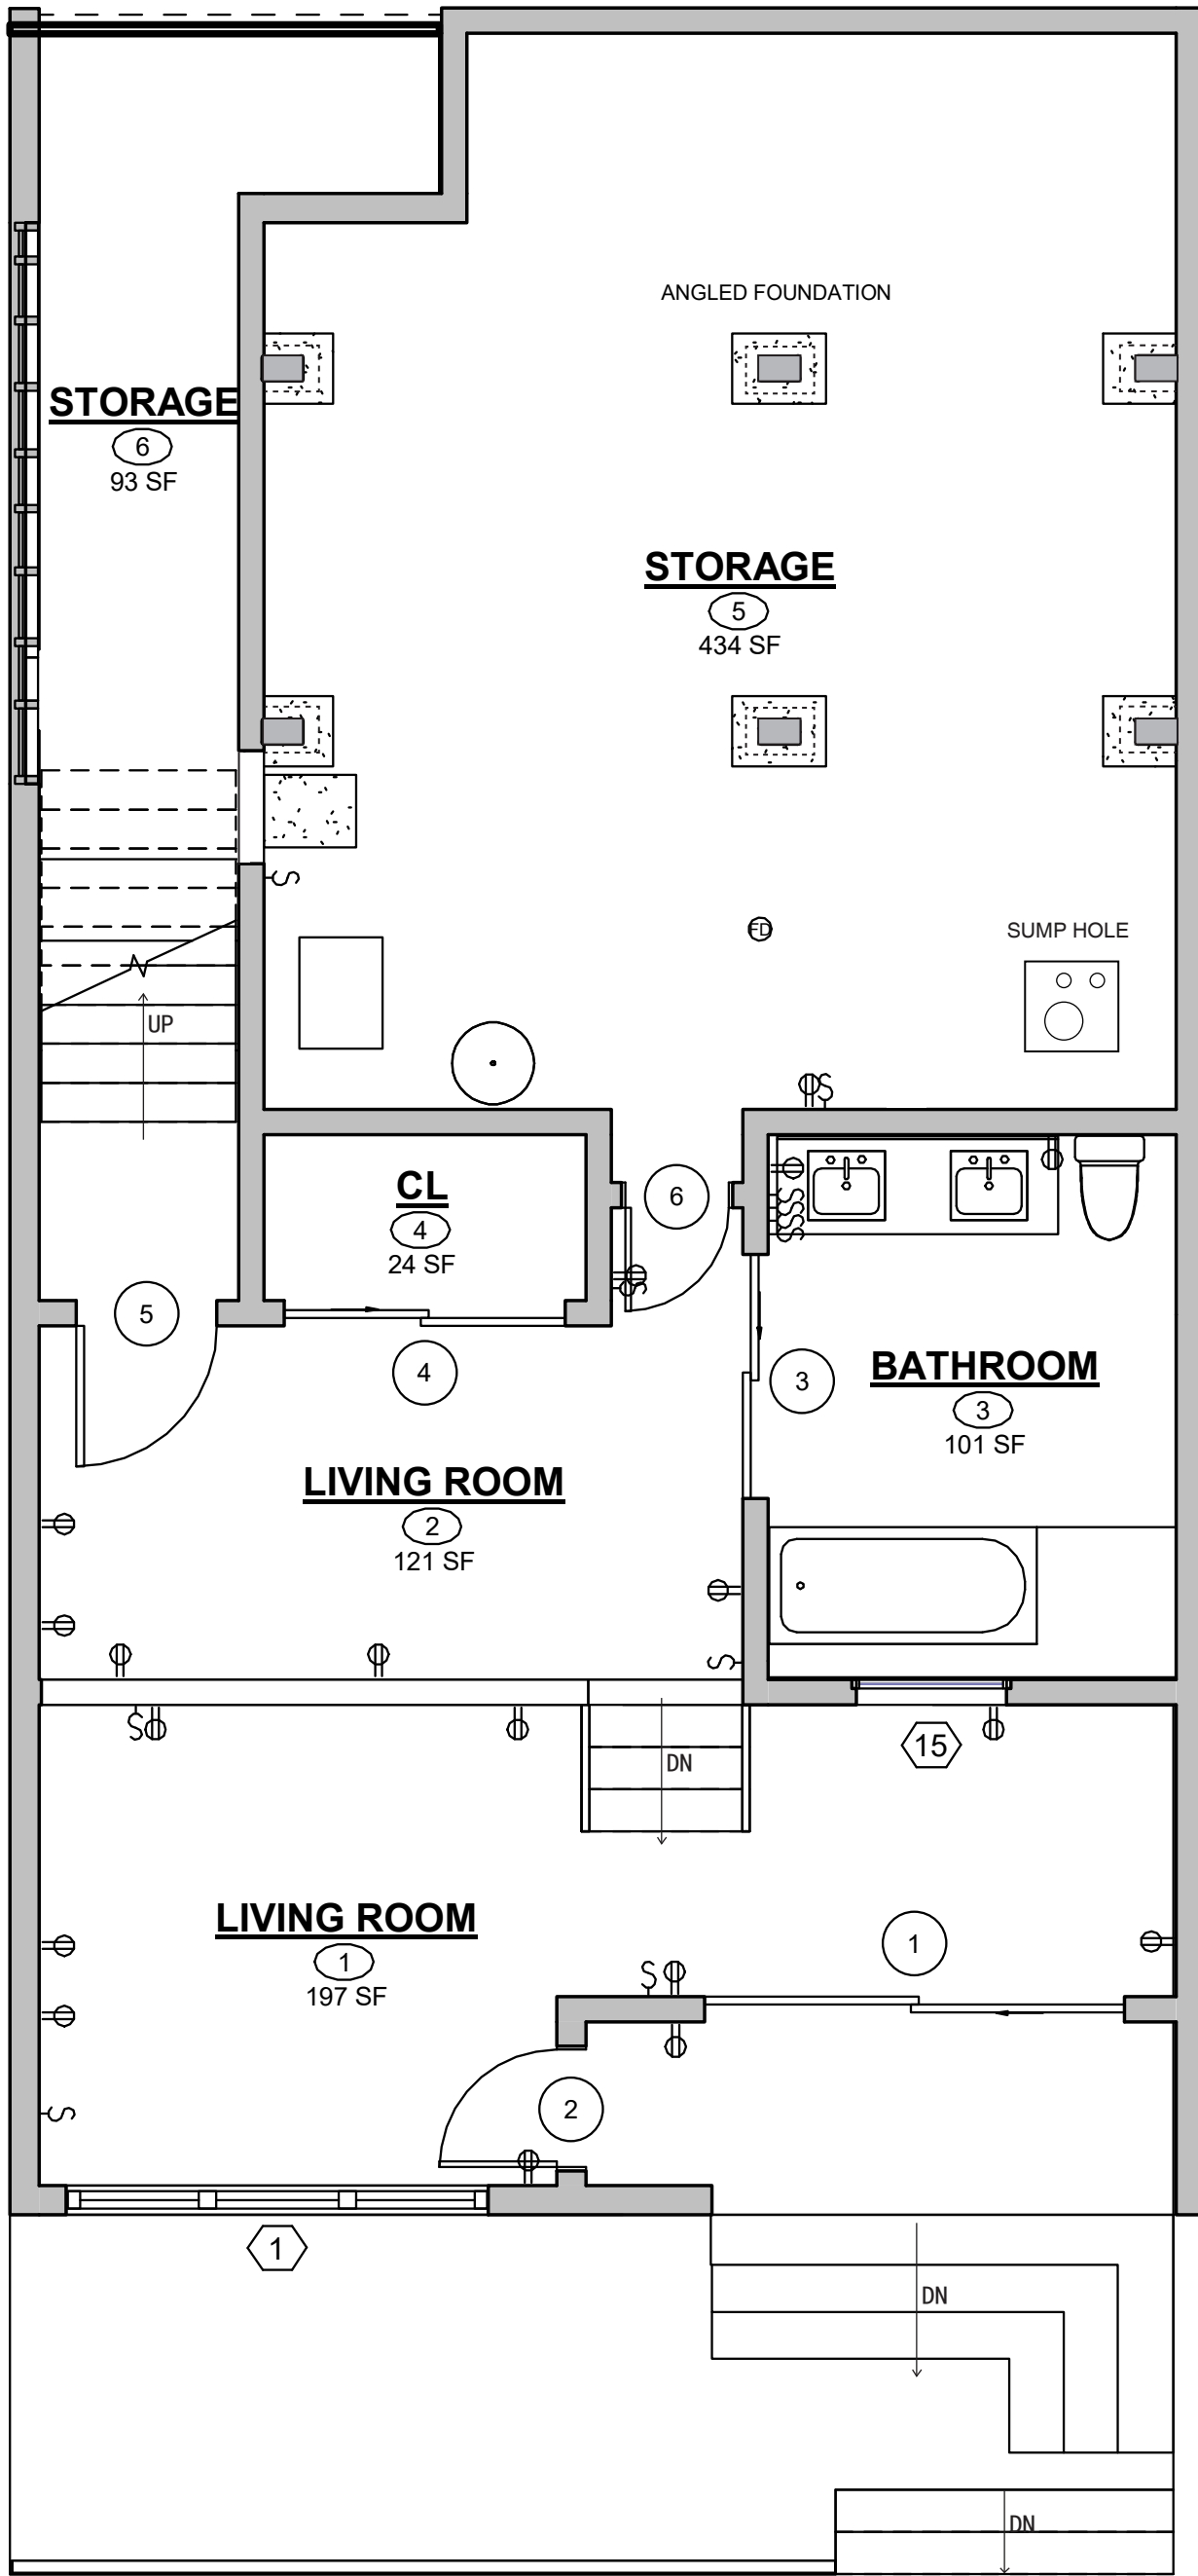

1

EXISTING BASEMENT FLOOR PLAN

1/4" = 1'-0"

N

As BUILT

PROFESSIONALS

www.asbuiltprofessionals.com

A DIVISION OF:

AEC

CONSULTANTS INC

844.272.8458

844 AS BUILT

© 2020 AEC CONSULTANTS INC


ARCHITECTURAL AS BUILT

San Francisco, CA 94107

BASEMENT FLOOR PLAN

DESIGNER	PROJECT MANAGER
DESIGNER	PROJECT DIRECTOR
21-29	PROJECT NUMBER
	SCALE
T.H.	DRAWN BY
	SHEET NUMBER

AB-1

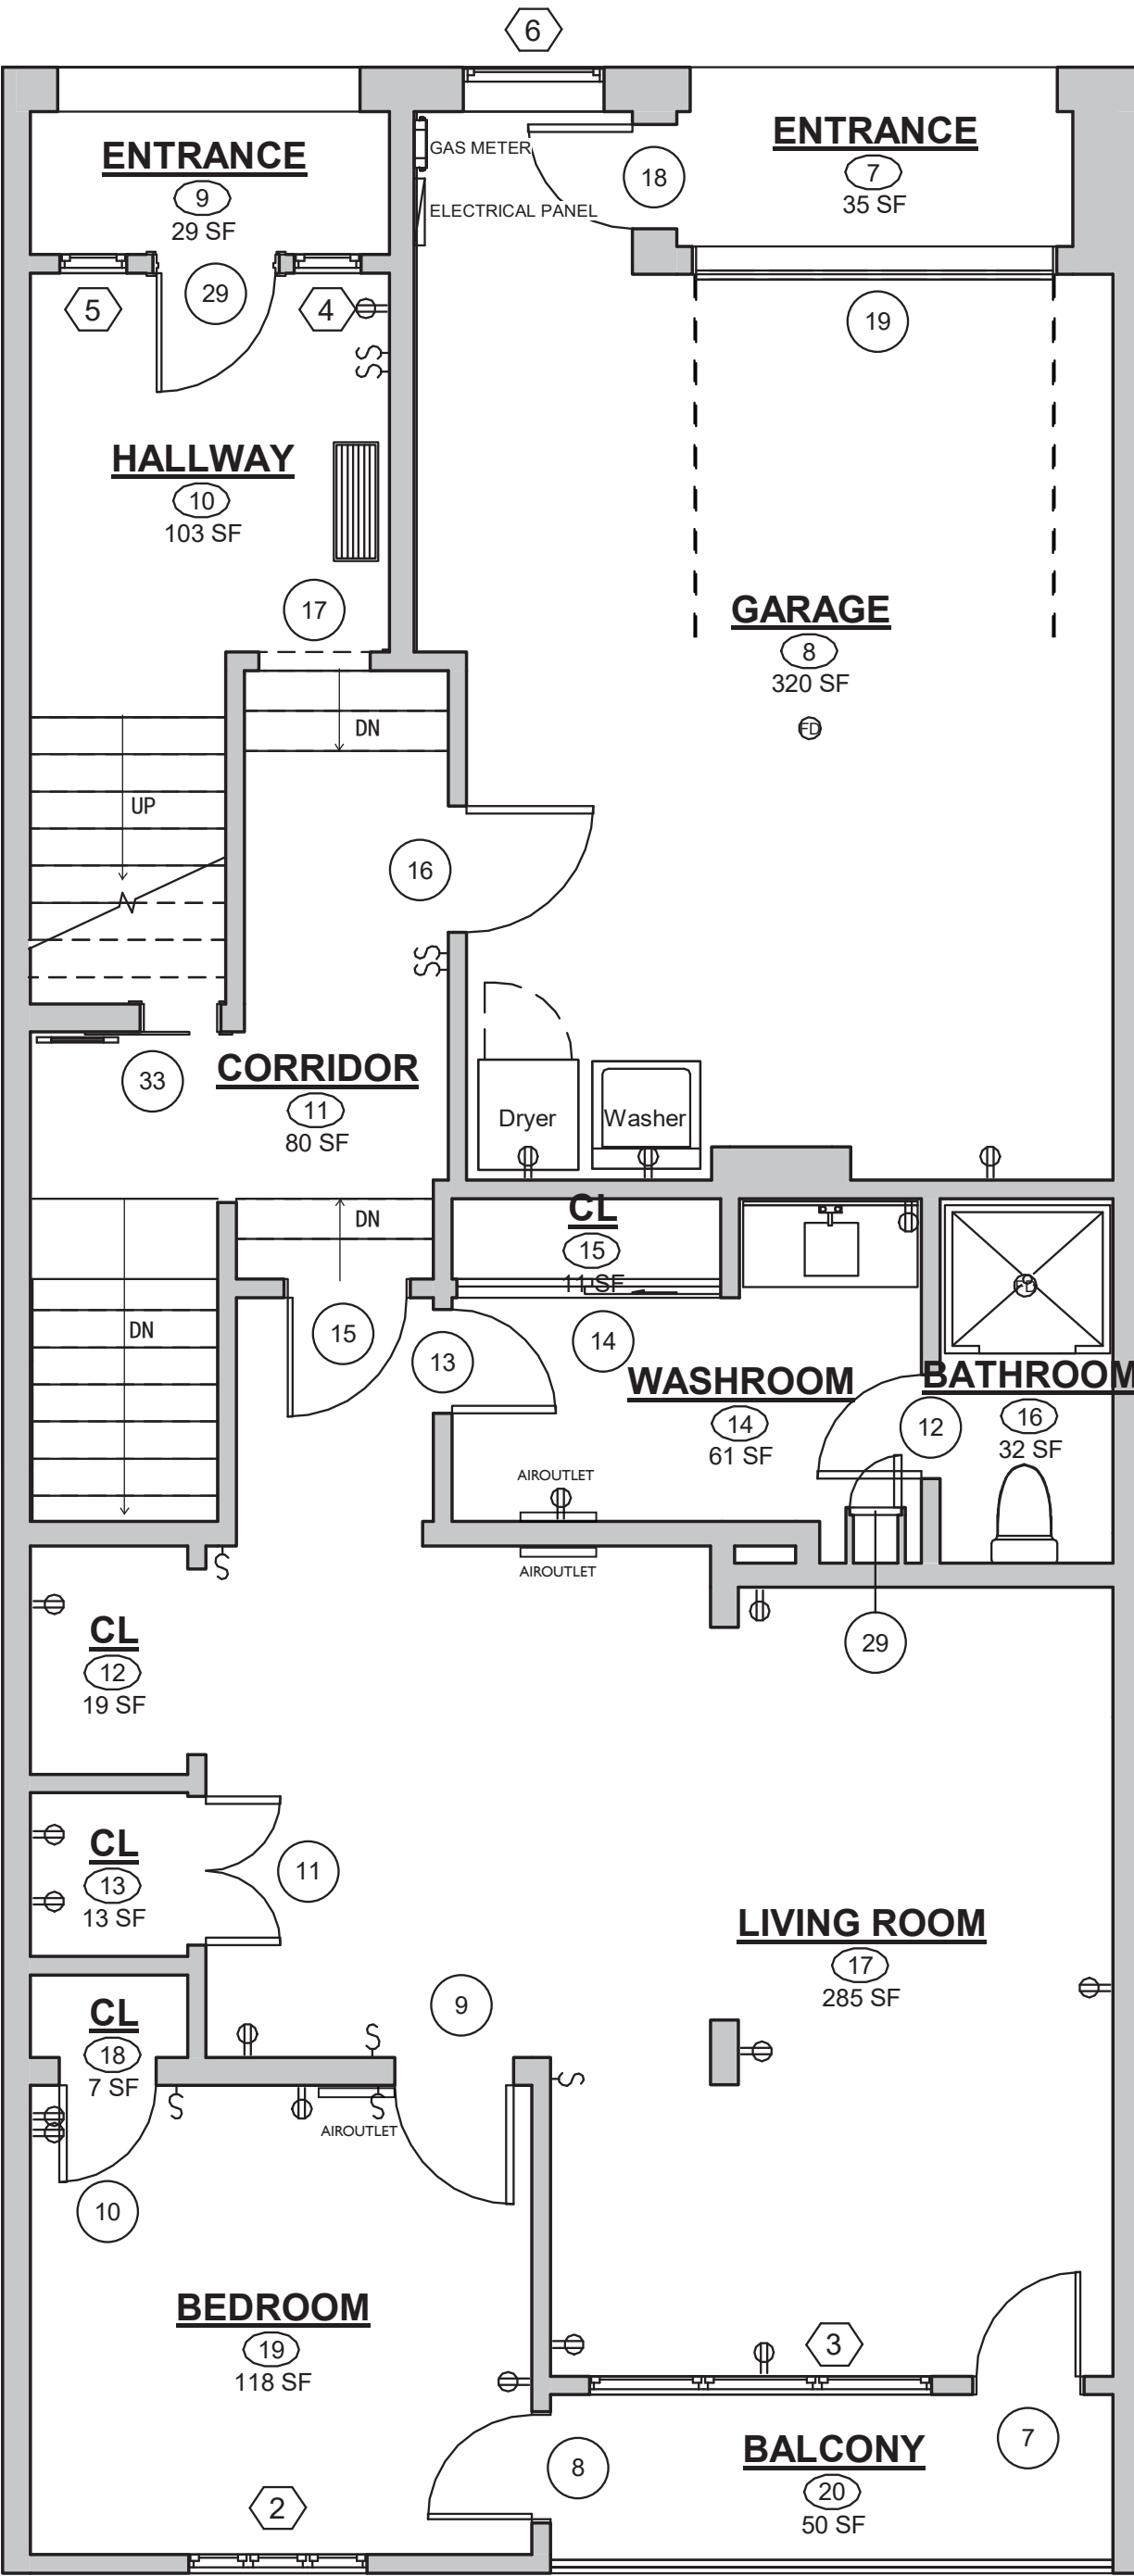

1

EXISTING FIRST FLOOR PLAN

1/4" = 1'-0"

N

ARCHITECTURAL AS BUILT


San Francisco, CA 94107

01	100% SUBMISSION	SEE COVER SHEET
NO.	ISSUES / REVISIONS	
SHEET TITLE		
FIRST FLOOR PLAN		
DESIGNER	PROJECT MANAGER	
DESIGNER	PROJECT DIRECTOR	
21-29	PROJECT NUMBER	
SCALE		
T.H.	DRAWN BY	
SHEET NUMBER		
AB-2		




ARCHITECTURAL AS BUILT

San Francisco, CA 94107

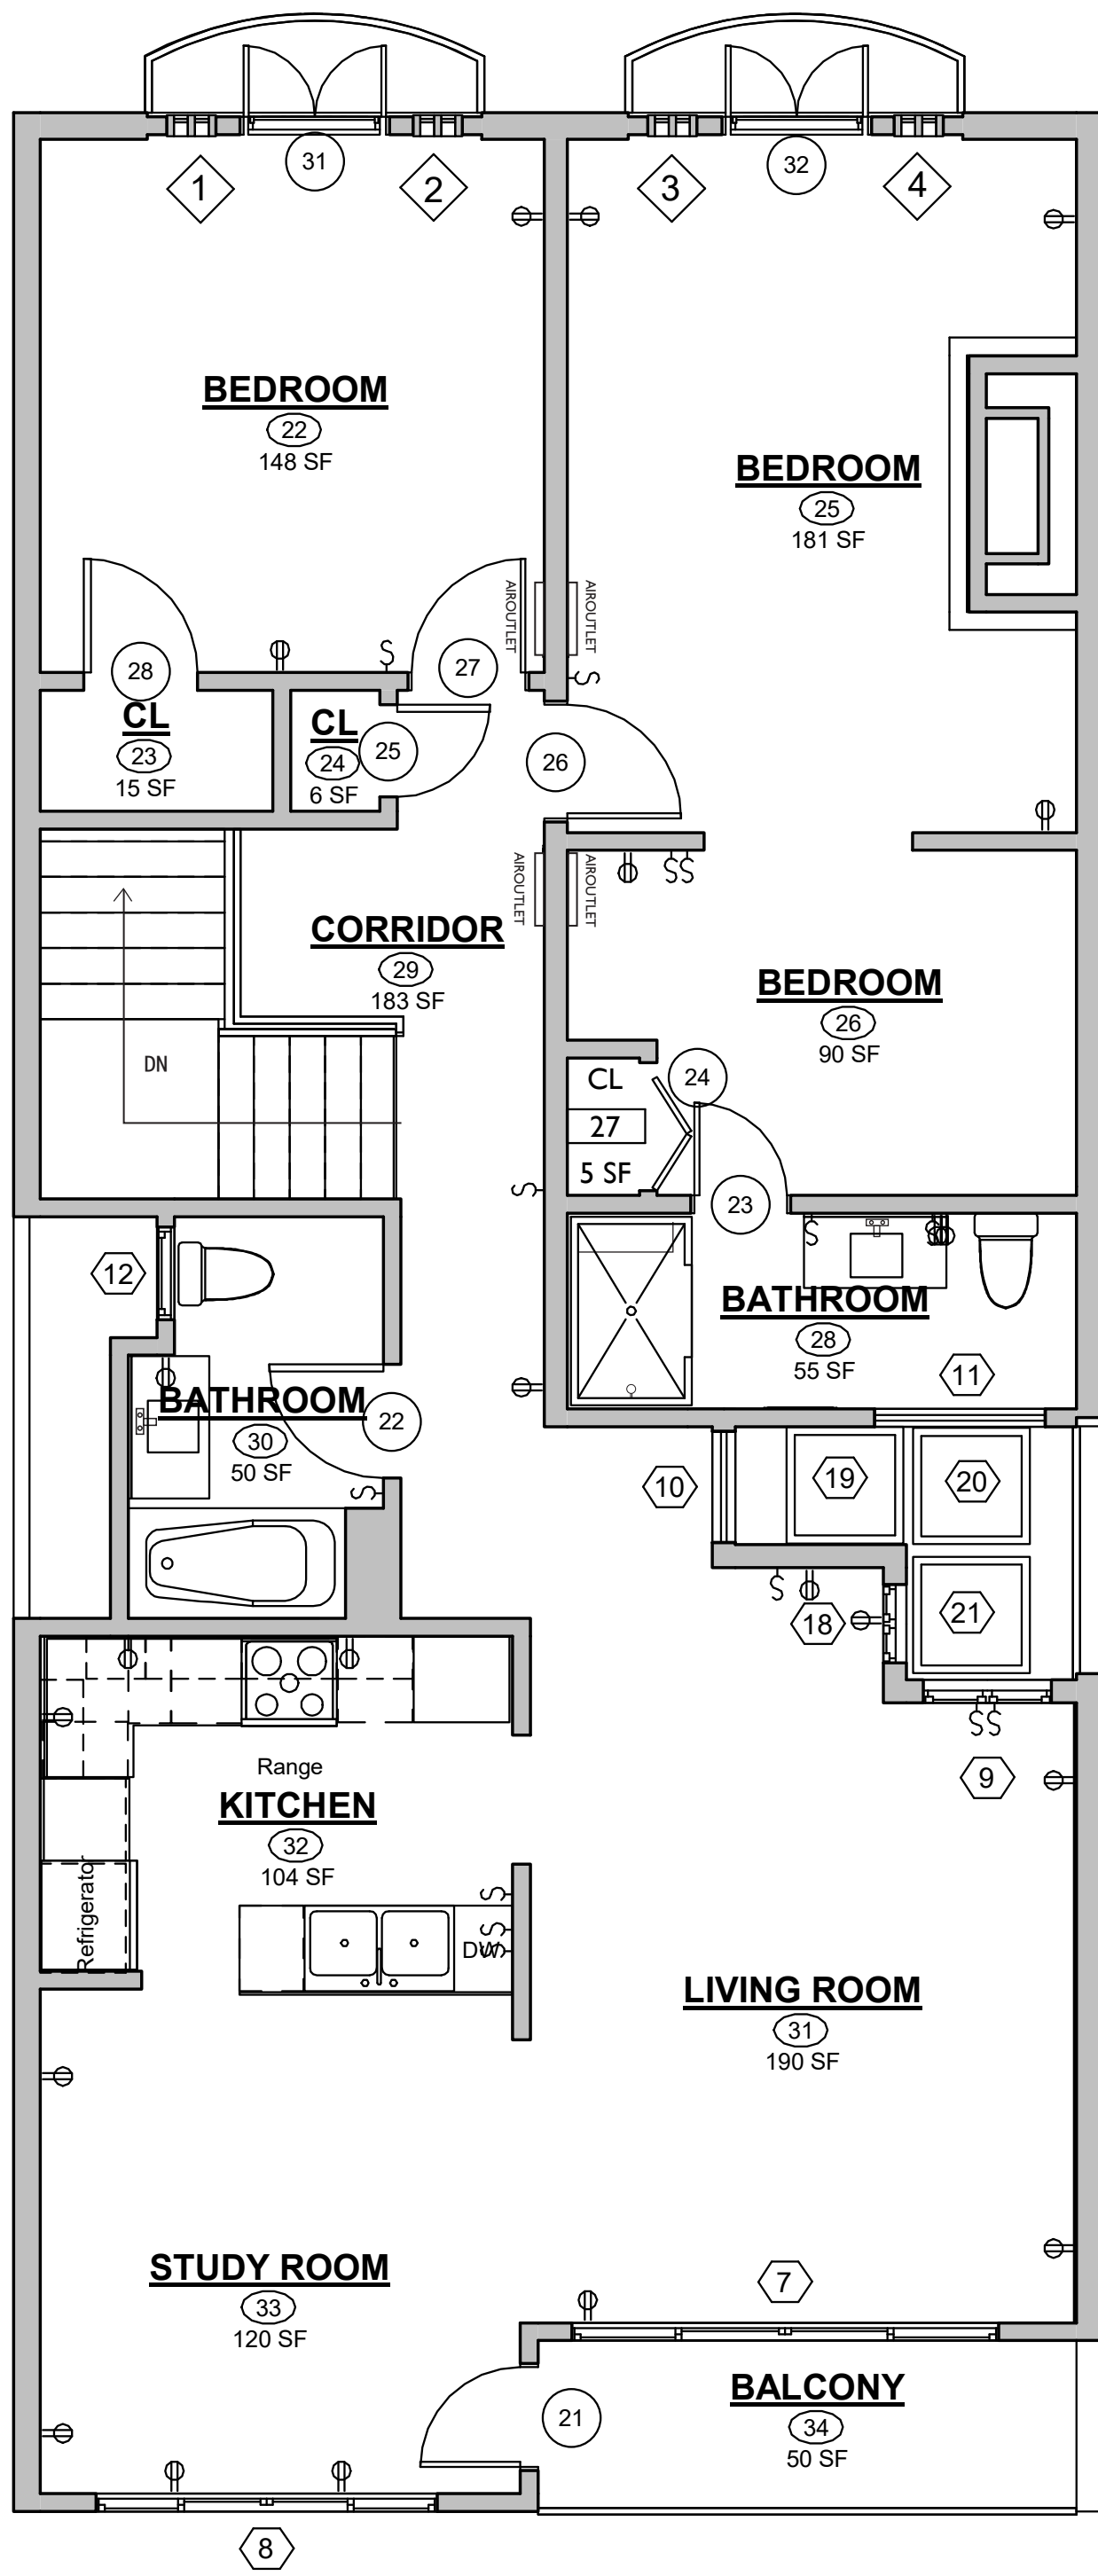

1 EXISTING SECOND FLOOR PLAN
1/4" = 1'-0"

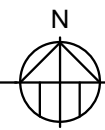

01 100% SUBMISSION SEE COVER SHEET

NO. ISSUES / REVISIONS

SHEET TITLE

SECOND FLOOR PLAN

DESIGNER PROJECT MANAGER

DESIGNER PROJECT DIRECTOR

21-29 PROJECT NUMBER

SCALE

T.H. DRAWN BY


SHEET NUMBER

AB-3



ARCHITECTURAL AS BUILT

San Francisco, CA 94107

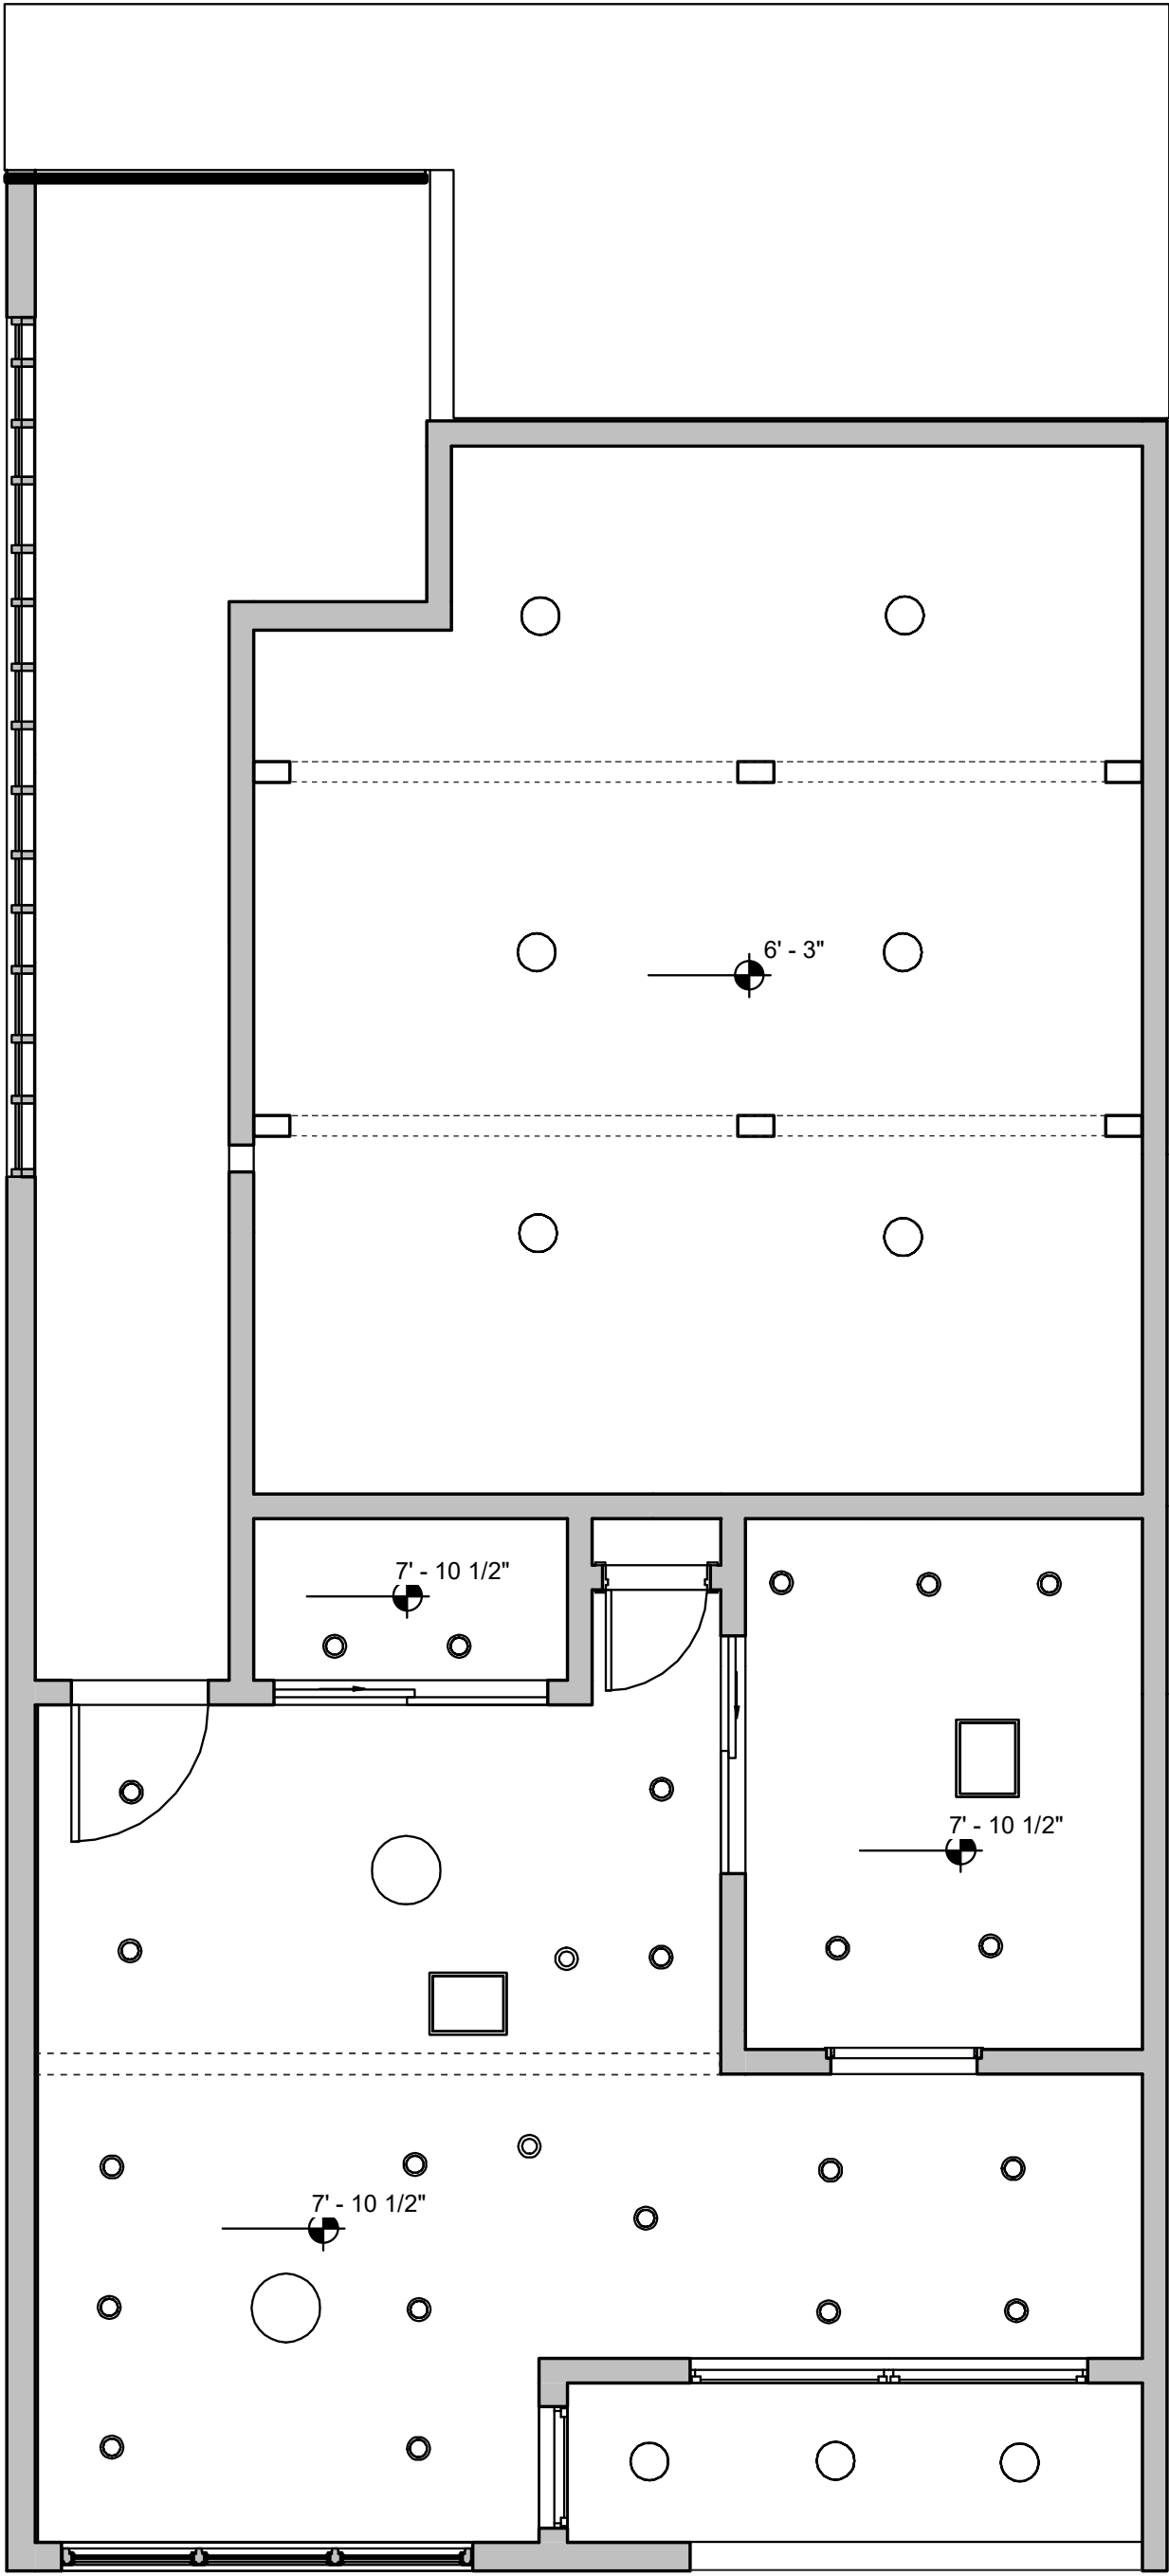

1 BASEMENT FLOOR REFLECTION CEILING PLAN
1/4" = 1'-0"

01	100% SUBMISSION	SEE COVER SHEET
NO.	ISSUES / REVISIONS	


BASEMENT FLOOR
REFLECTION CEILING
PLAN

DESIGNER	PROJECT MANAGER
DESIGNER	PROJECT DIRECTOR
21-29	PROJECT NUMBER
	SCALE
T.H.	DRAWN BY
	SHEET NUMBER

AB-4

ARCHITECTURAL AS BUILT

San Francisco, CA 94107

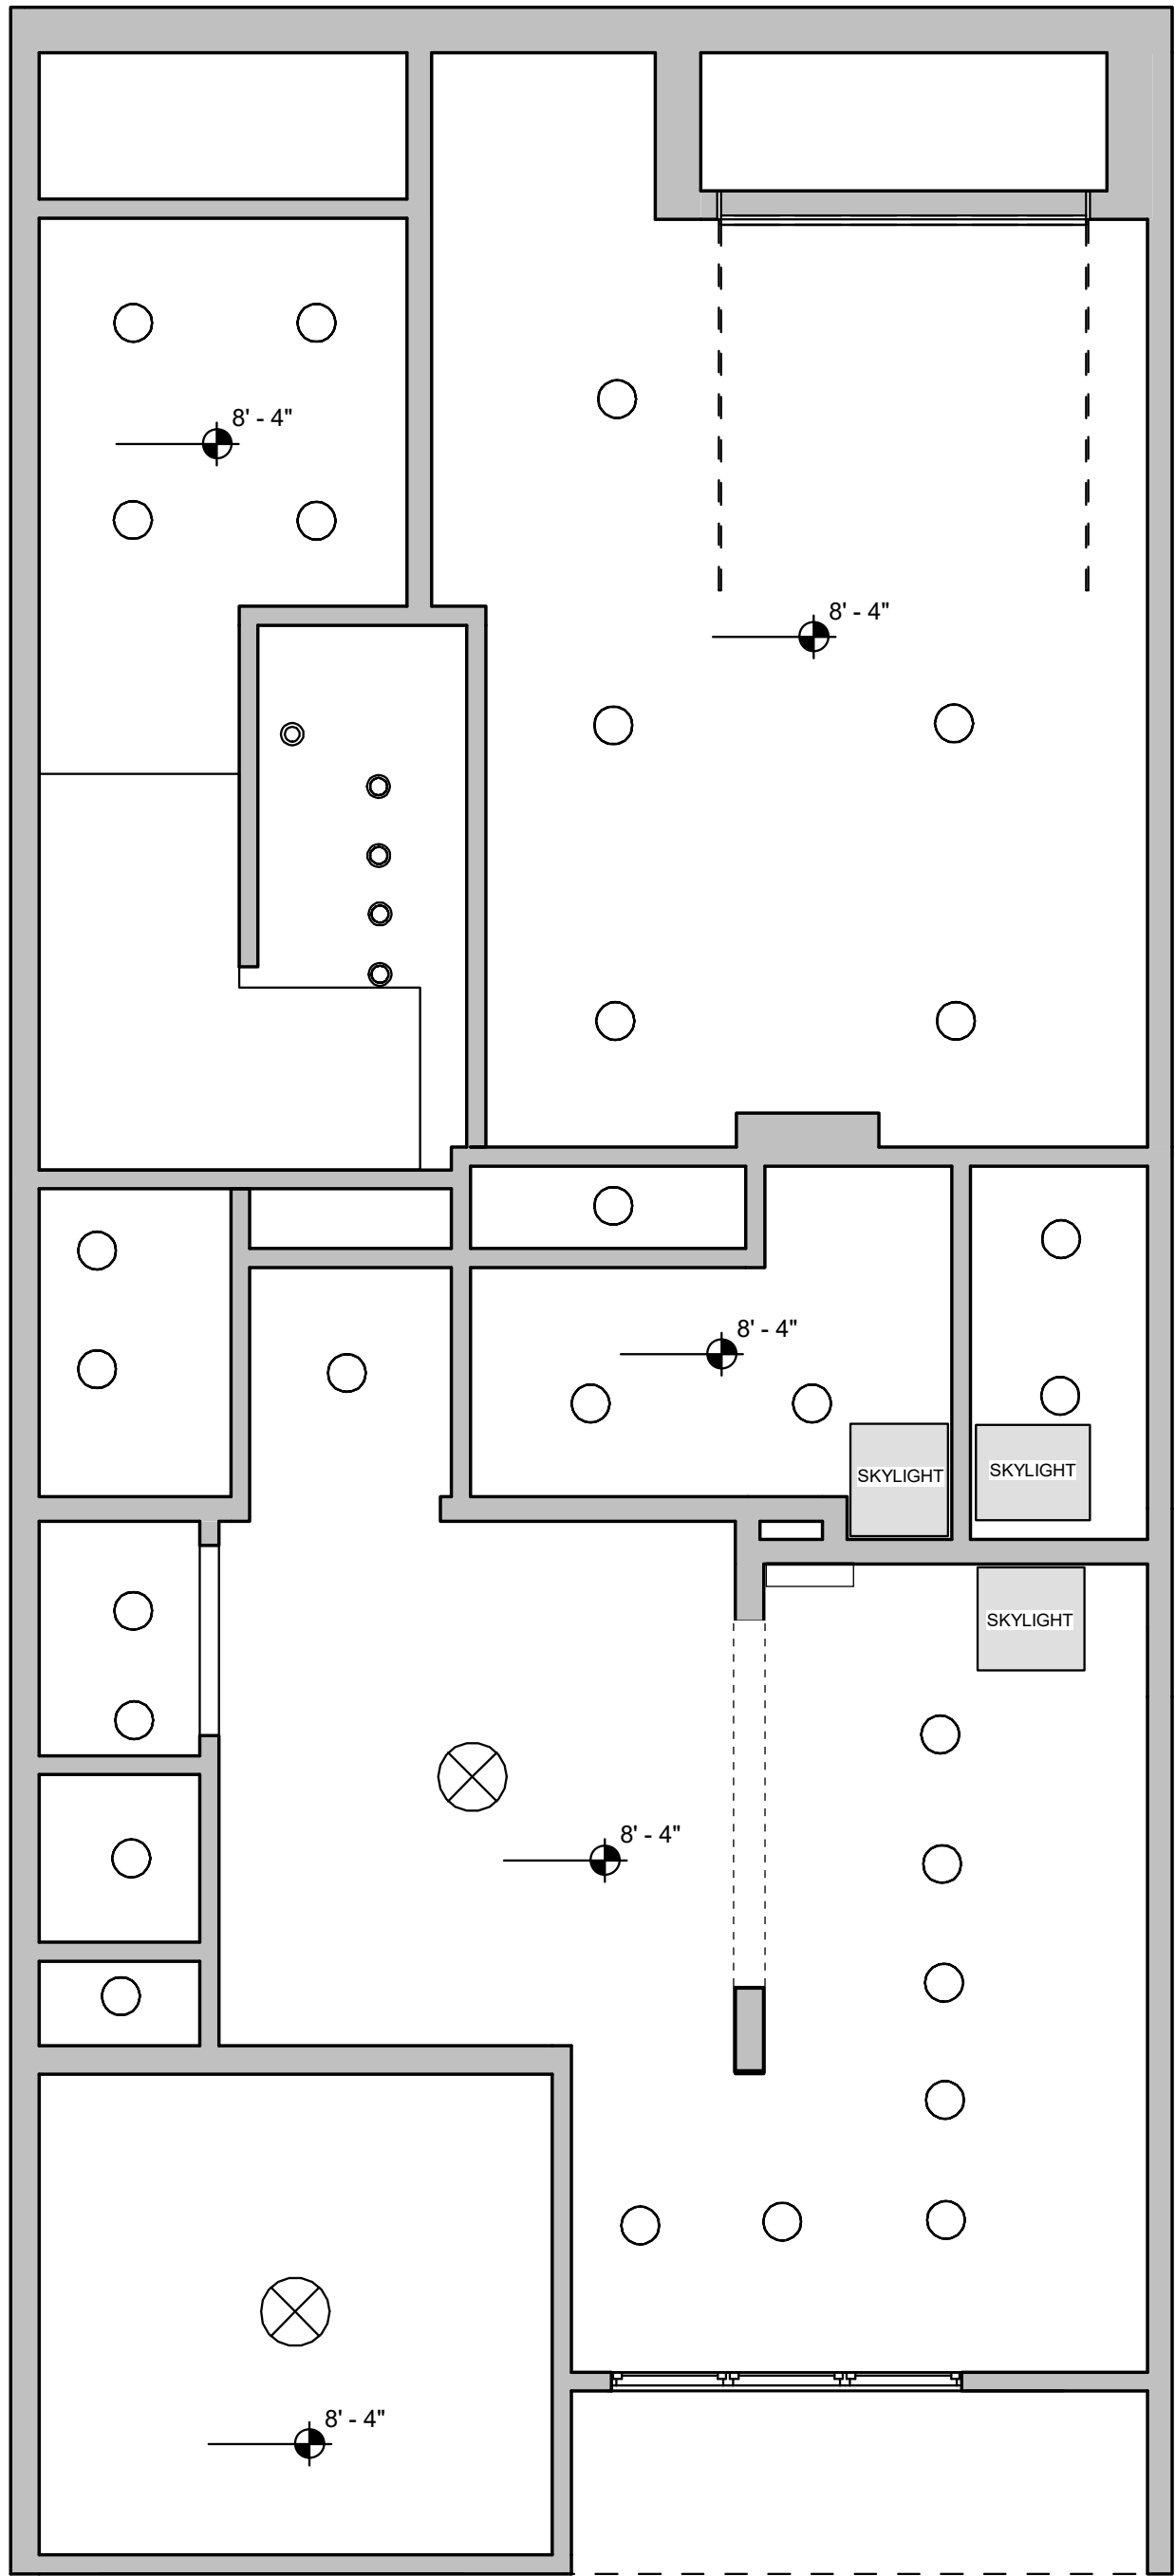


1 FIRST FLOOR REFLECTION CEILING PLAN
1/4" = 1'-0"



FIRST FLOOR REFLECTION
CEILING PLAN



DESIGNER	PROJECT MANAGER
DESIGNER	PROJECT DIRECTOR
21-29	PROJECT NUMBER
	SCALE
T.H.	DRAWN BY
	SHEET NUMBER

AB-5

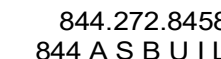

© 2020 AEC CONSULTANTS INC.

San Francisco, CA 94107

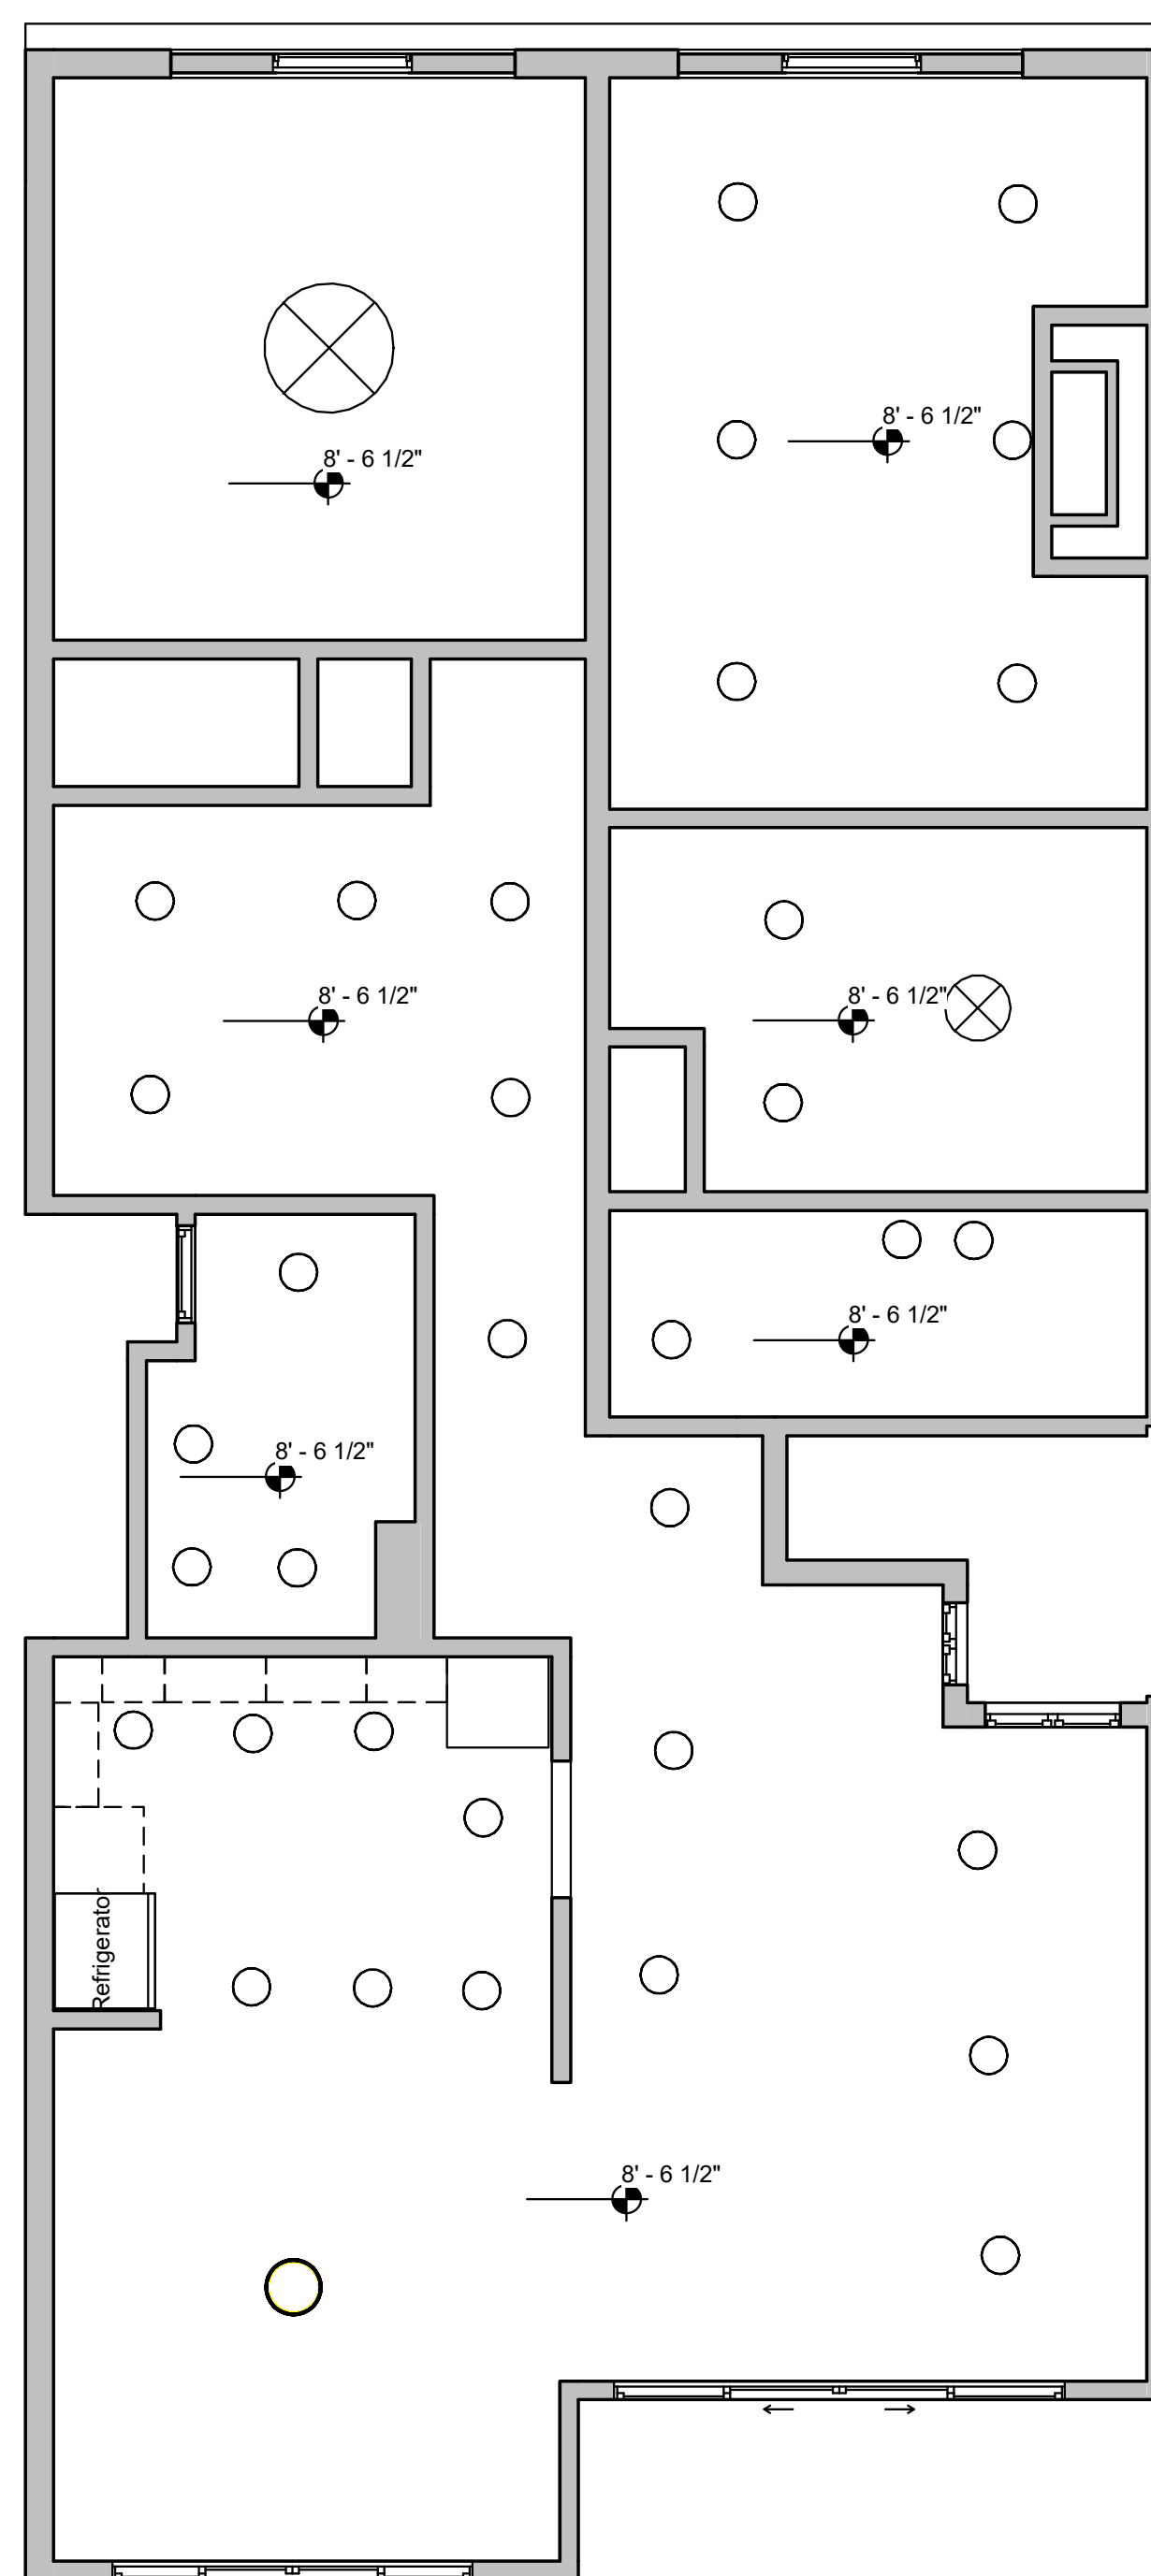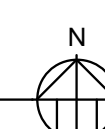
$$\frac{1}{4}'' = 1'-0''$$


SECRET DUE

PLAN

PROJECT MANAGER

PROJECT DIRECTOR


PROJECT NUMBER

SCALE


DRAWN BY

SHEET NUMBER

AB-6

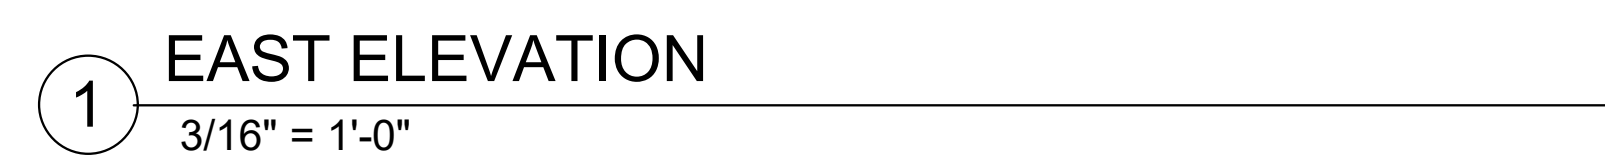

01	100% SUBMISSION	SEE COVER SHEET
NO.	ISSUES / REVISIONS	
		SHEET TITLE
EXTERIOR ELEVATIONS		
DESIGNER		PROJECT MANAGER
DESIGNER		PROJECT DIRECTOR
21-29		PROJECT NUMBER
		SCALE
T.H.		DRAWN BY
		SHEET NUMBER
AB-7		

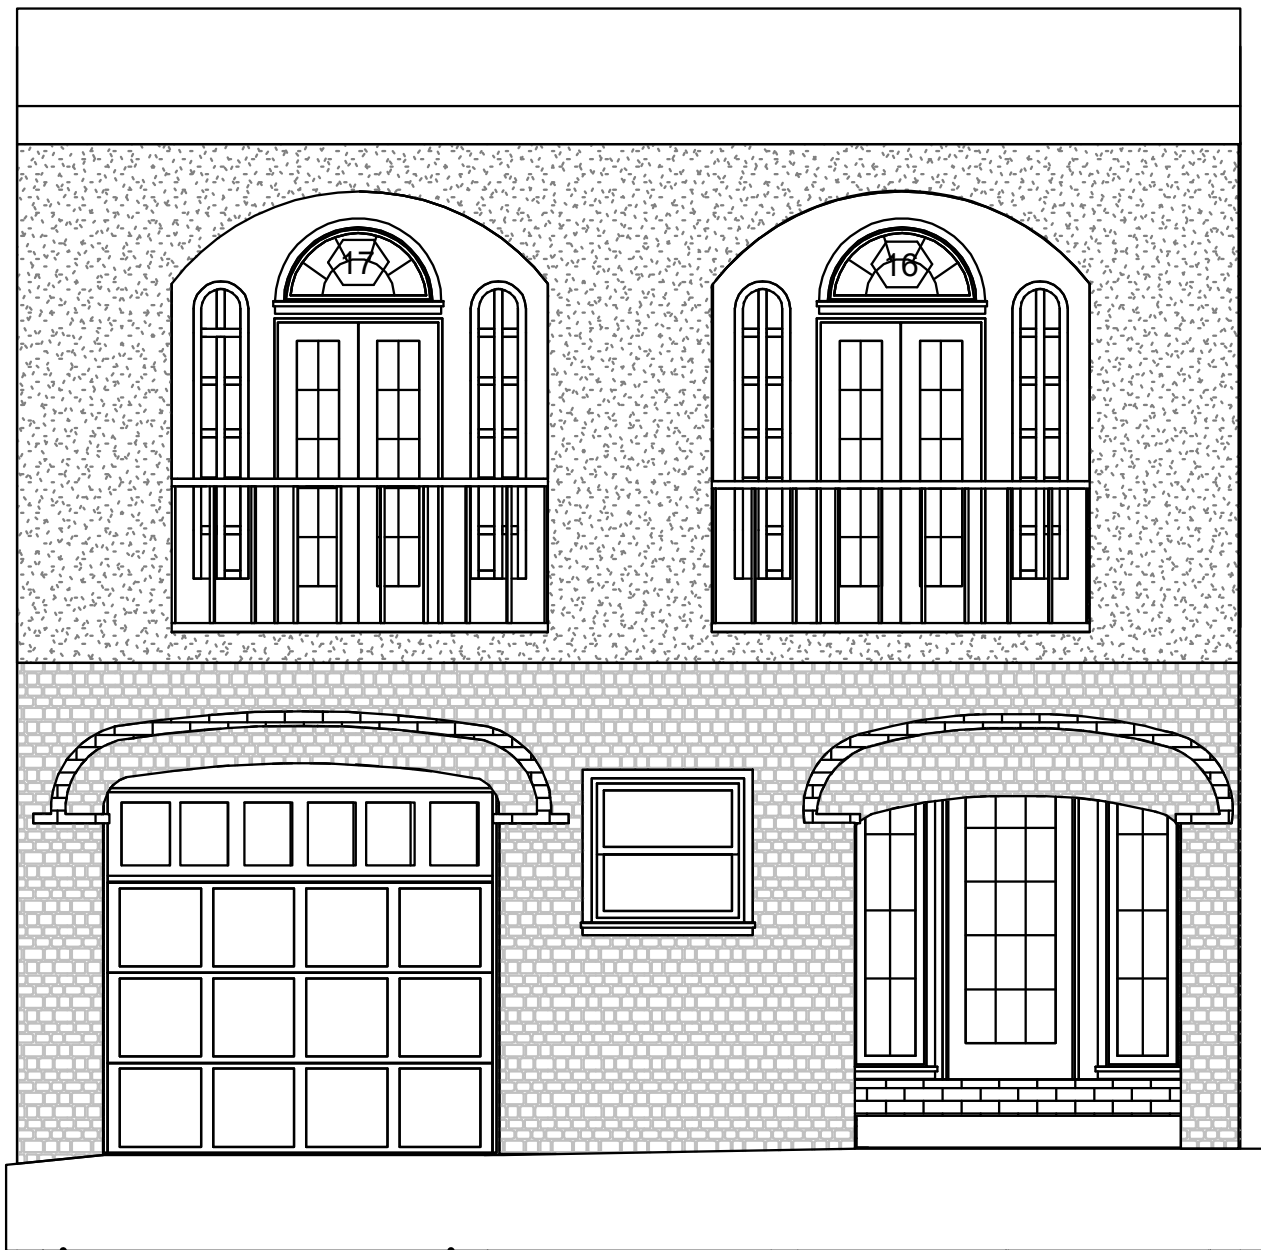


1 NORTH ELEVATION
1/4" = 1'-0"



2 SOUTH ELEVATION
1/4" = 1'-0"

ARCHITECTURAL AS BUILT
San Francisco, CA 94107

01	100% SUBMISSION	SEE COVER SHEET
NO.	ISSUES / REVISIONS	
SHEET TITLE		
EXTERIOR ELEVATIONS		
DESIGNER	PROJECT MANAGER	
DESIGNER	PROJECT DIRECTOR	
21-29	PROJECT NUMBER	
	SCALE	
T.H.	DRAWN BY	
	SHEET NUMBER	
AB-8		

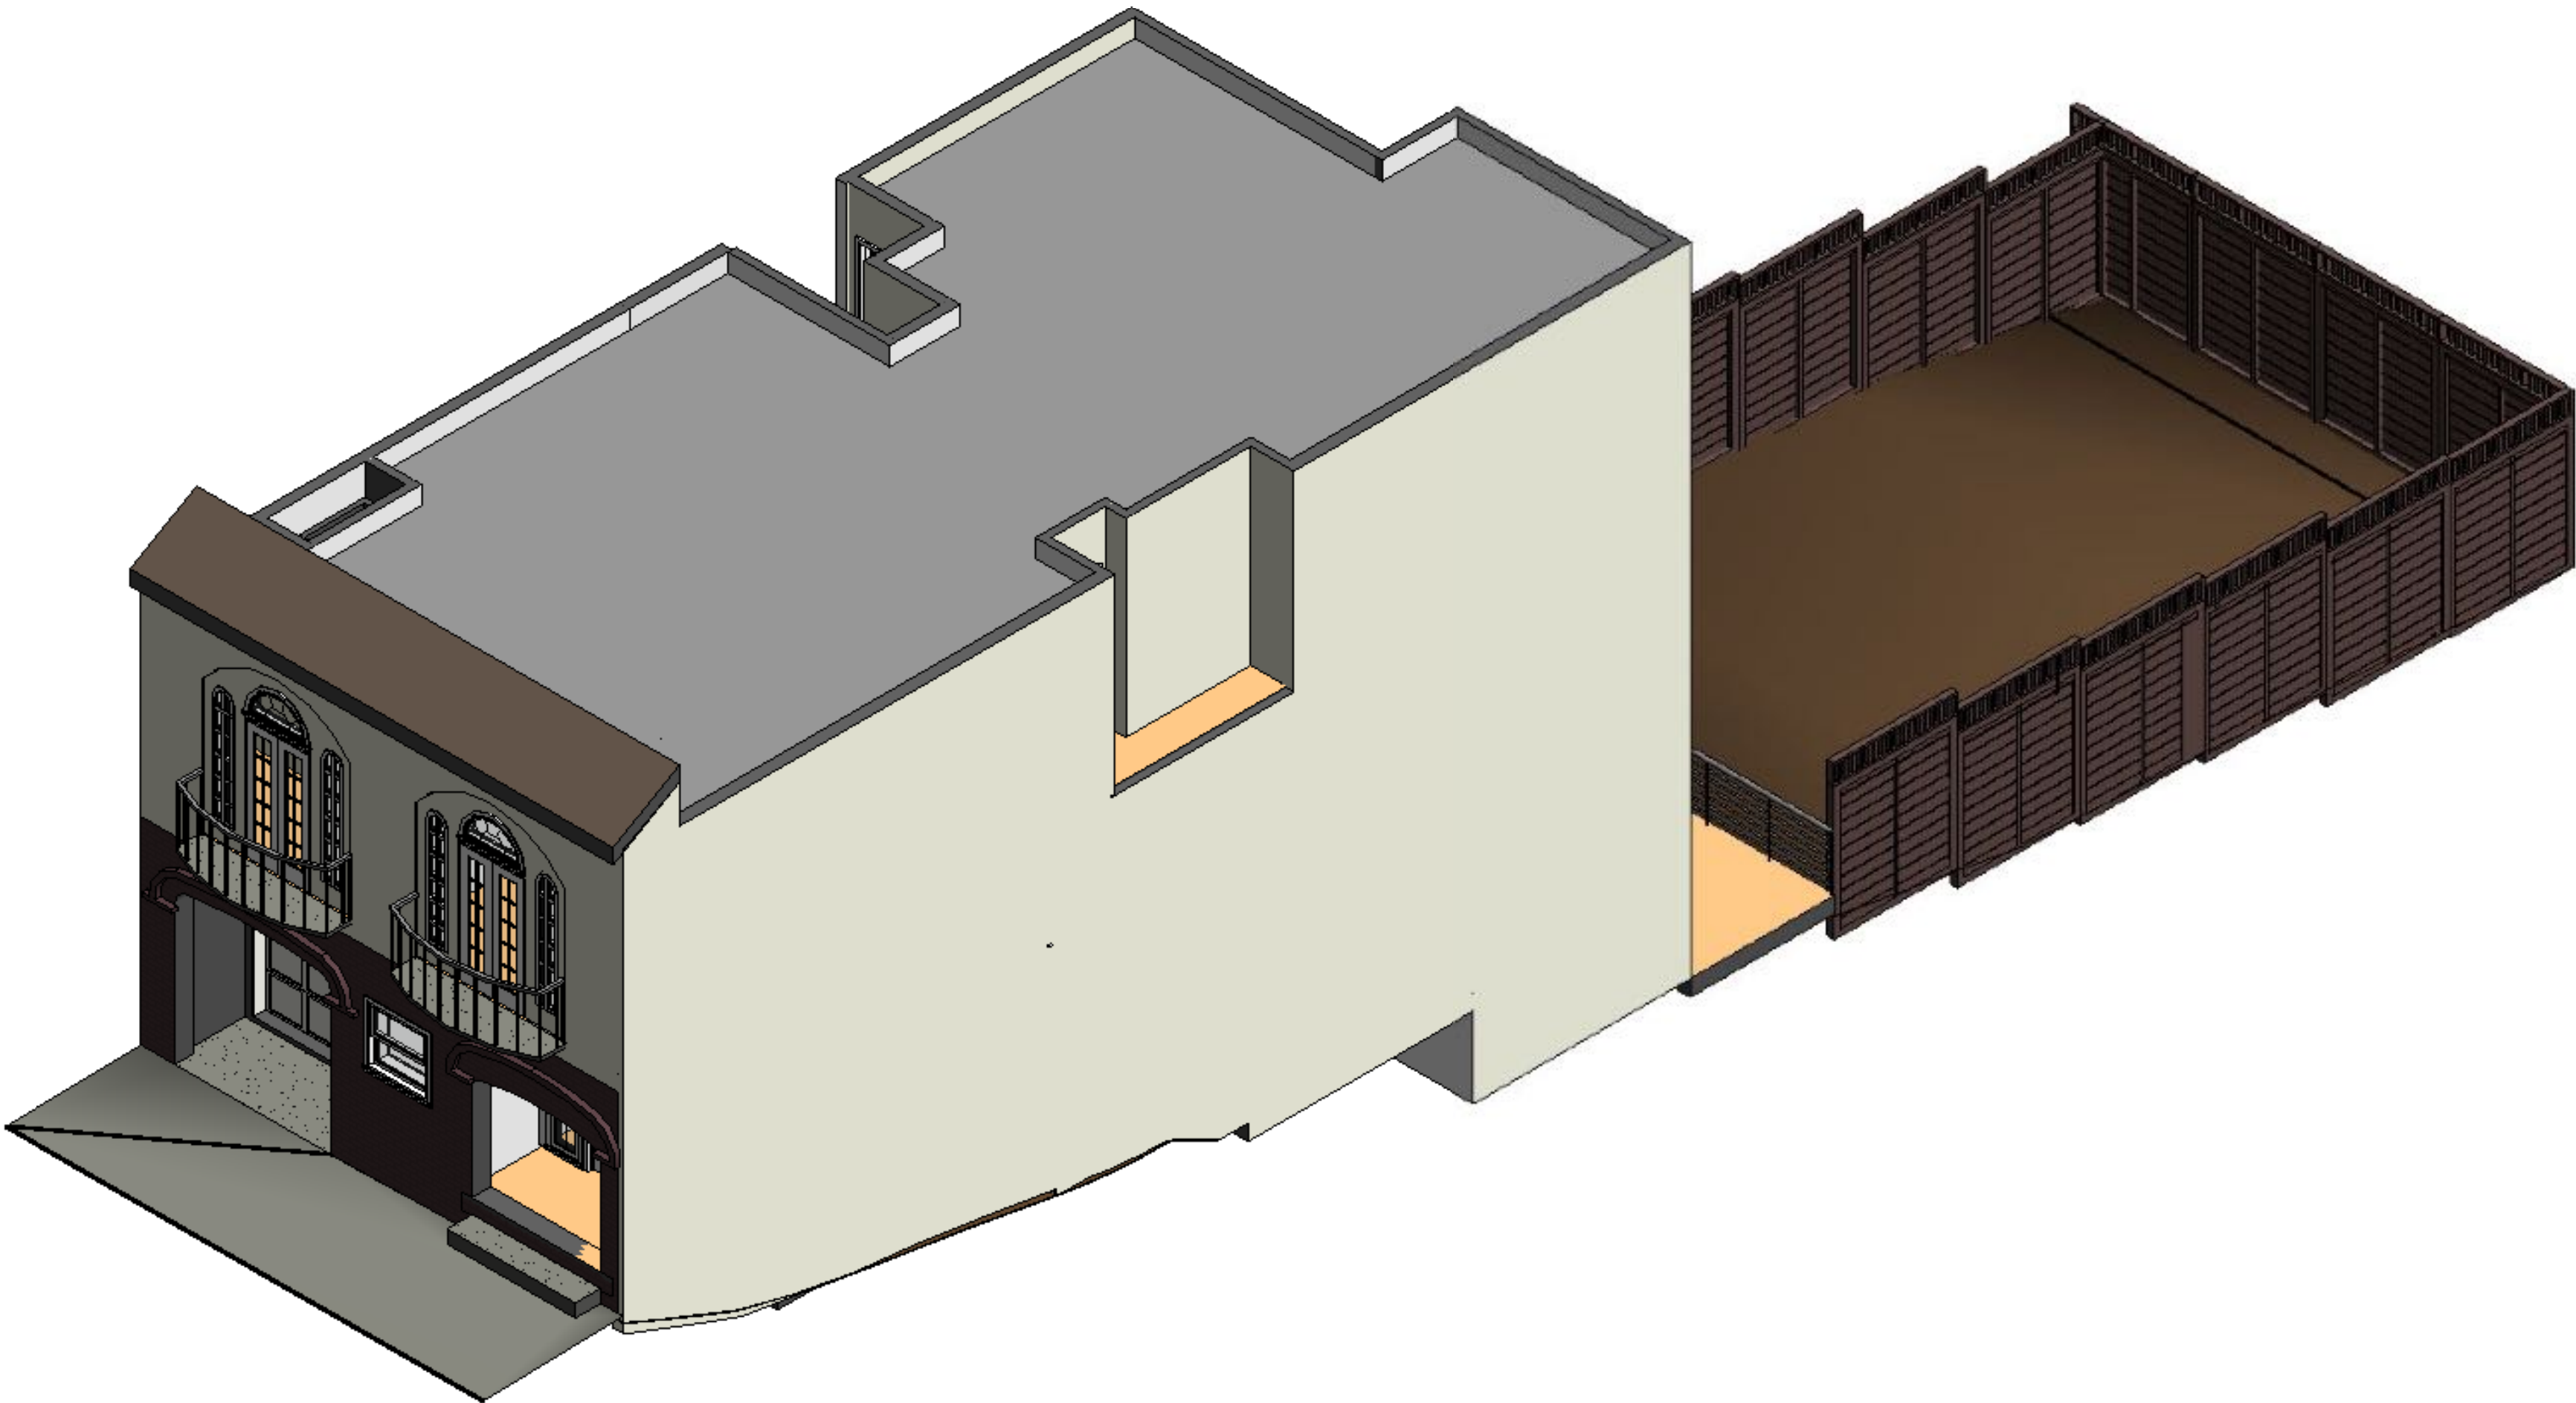

1 3D VIEW

ARCHITECTURAL AS BUILT

San Francisco, CA 94107

01	100% SUBMISSION	SEE COVER SHEET
NO.	ISSUES / REVISIONS	

3D VIEW

DESIGNER	PROJECT MANAGER
DESIGNER	PROJECT DIRECTOR
21-29	PROJECT NUMBER
	SCALE
T.H.	DRAWN BY
	SHEET NUMBER

AB-9



ARCHITECTURAL AS BUILT

San Francisco, CA 94107

01	100% SUBMISSION	SEE COVER SHEET
NO.	ISSUES / REVISIONS	
		SHEET TITLE
3D SECTIONS		
DESIGNER	PROJECT MANAGER	
DESIGNER	PROJECT DIRECTOR	
21-29	PROJECT NUMBER	
	SCALE	
T.H.	DRAWN BY	
	SHEET NUMBER	

AB-10

2 3D VIEW FIRST FLOOR

1 3D VIEW BASEMENT



AB-11