

AS-BUILT DOCUMENTATION


Brentwood, CA 94513




100% SUBMITTAL

DRAWING INDEX

- 0C1 COVERSHEET
- 0SL SYMBOLS
- AB-1 SITE PLAN
- AB-2 FLOOR PLAN
- AB-3 CEILING PLAN
- AB-4 ELEVATIONS
- AB-5 ELEVATIONS
- AB-6 PERSPECTIVE
- AB-7 3D SECTION VIEW
- AB-8 3D SECTION MEP

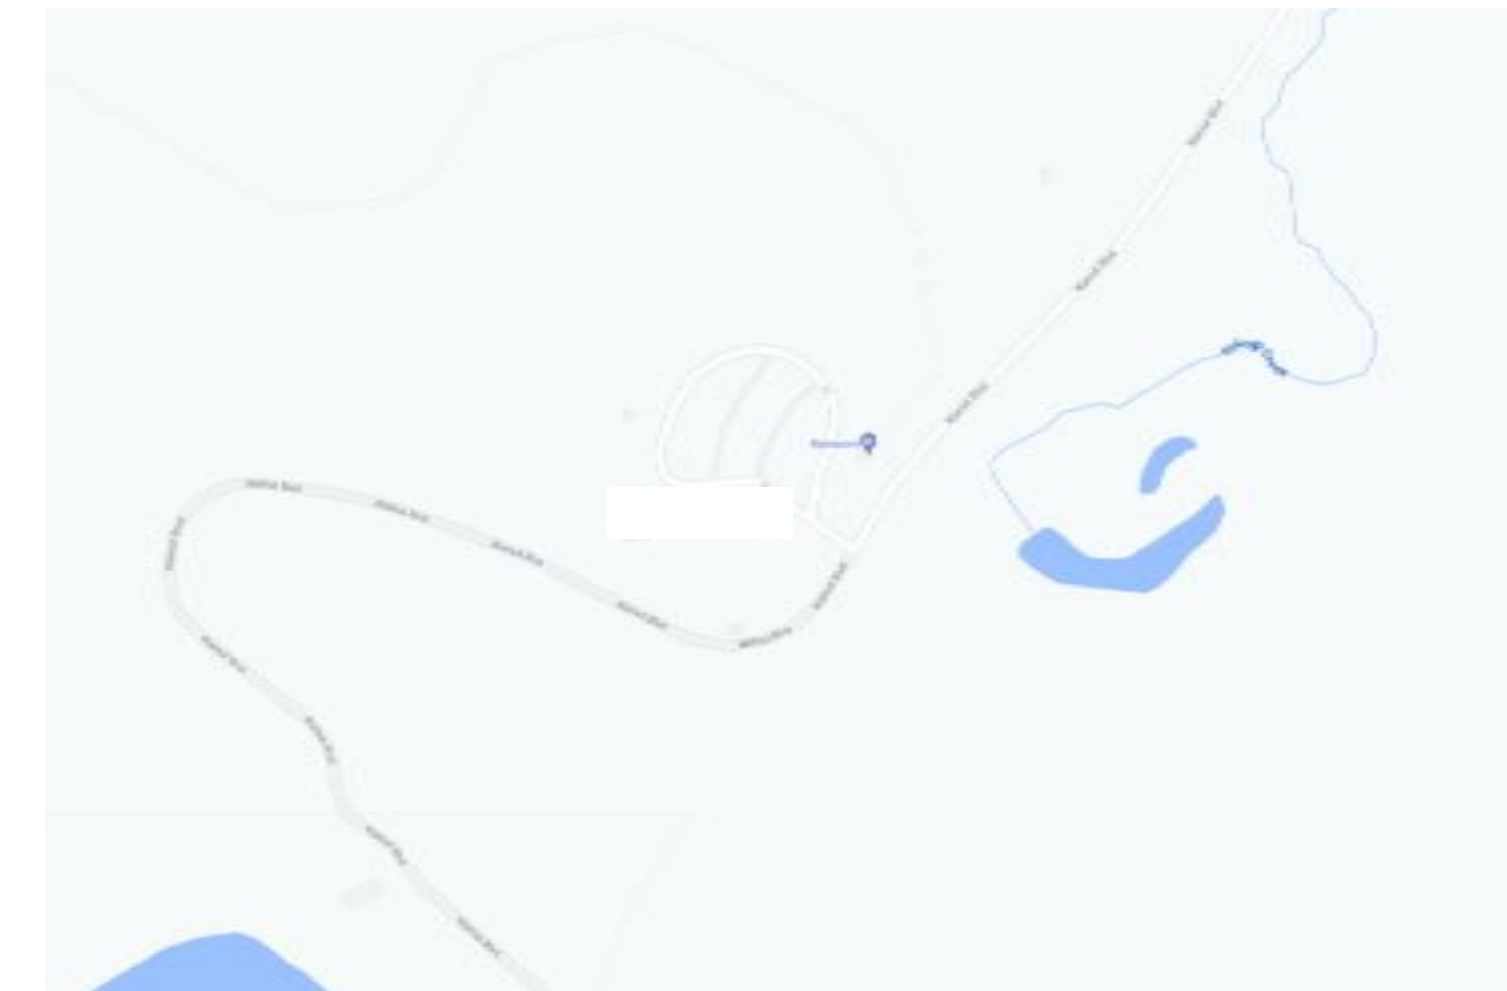

VICINITY MAP

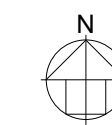

AREA DATA
Area 2733 SF

As BUILT
PROFESSIONALS
www.asbuiltprofessionals.com



© 2022 AEC CONSULTANTS INC

ARCHITECTURAL AS BUILT
Brentwood, CA 94513

NO.	ISSUES / REVISIONS	DATE
01	100% SUBMISSION	SEE COVER SHEET


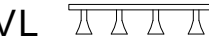
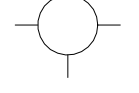

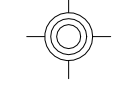
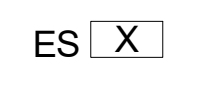
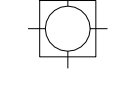
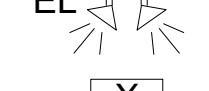















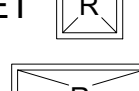
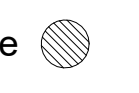

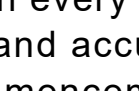
COVERSHEET

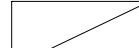A.D.	PROJECT MANAGER
A.D.	PROJECT DIRECTOR
22-05	PROJECT NUMBER
	SCALE
A.J.	DRAWN BY
	SHEET NUMBER

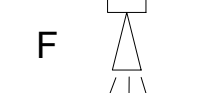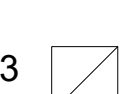





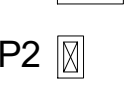







0C1

SYMBOLS LEGEND





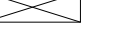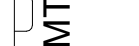


RCP

EXH 	EXHAUST VENT	VL 	TRACK LIGHT OR VANITY LIGHT
L1 	CEILING MOUNTED LIGHT FIXTURE	WL 	WALL-MOUNTED LIGHT FIXTURE
L 	CEILING MOUNTED DIRECTIONAL LIGHT	ES 	EMERGENCY EXIT SIGN
RC 	RECESSED CAN LIGHT	EL 	EMERGENCY EXIT LIGHT
EYE 	EYEBALL OR SMALL CAN LIGHT	EEL 	EMERGENCY EXIT LIGHT W/ SIGN
HPL 	PENDANT LIGHT	STAIR 	LIGHTED STAIR SIGN
FL 	INDIVIDUAL FLUOR. LAY-IN FIXTURE 4 BULB	F 	FLOOD LIGHT
FL2 	INDIVIDUAL FLUOR. HANGING FIXTURE 2 BULB	PC 	PHOTO CELL
FL3 	INDIVIDUAL FLUOR. FLUSH MOUNT FIXTURE 4 BULB	F1 	CEILING FAN
C 	CAMERA	F1LK 	CEILING FAN W/ LIGHT KIT
M 	MOTION DET.	7-2-6	CEILING HEIGHT AND TRIM 7'-2" ABOVE FLOOR BELOW WITH 6" CROWN MOULDING. NOTE: ALL CEILINGS NOT LABELED ARE PLASTER. CEILINGS SHOWN WITH A GRID ARE LAY IN ACOUSTICAL TILE..
SUP 	SUPPLY VENT	J 	JUNCTION BOX
SUP2 	SUPPLY VENT		
RET 	RETURN VENT		
RET2 	RETURN VENT		
spe 	SPEAKER		







ELECTRIC

DAT 	DATA OUTLET
TEL 	TELEPHONE JACK
S1 	ELECTRIC SWITCH
TV 	CABLE TELEVISION OUTLET
P1 	DUPLEX RECEPTACLE OUTLET
P3 	SPECIAL PURPOSE CONNECTION OR OUTLET
PQ 	QUADRUPLEX RECEPTACLE OUTLET
PF 	FLOOR DUPLEX RECEPTACLE OUTLET
PNL 	ELECTRIC PANEL
MTR 	ELECTRIC METER
BUT 	BUTTON SWITCH
DISC 	DISCONNECT SWITCH
LG 	GROUND/FLOOR LIGHT
KP 	KEY PAD


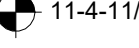
FIRE PROTECTION

FE 	FIRE EXTINGUISHER
FP 	FIRE PULL
AS 	FIRE ALARM (HORN/SRTOBE)
SD 	SMOKE DETECTOR
SS 	SMOKE ALARM SPEAKER
SP 	SPRINKLER HEAD CEILING MOUNT
SPW 	SPRINKLER HEAD WALL MOUNT


MEP

TH 	THERMOSTAT
FD 	FLOOR DRAIN
V 	VALVE
HB 	HOSE BIB
WS 	WATER SUPPLY
HEAT 	SUSPENDE GAS HEATER


MISC

BOLLARD 	BOLLARD
ELEVATION SYMBOL 	SPOT ELEVATION

Note:
Although every attempt has been made to ensure the quality and accuracy of these asbuilt drawings, prior to the commencement of any office or fieldwork these as built drawings must be field verified for any discrepancies. Asbuilt Professionals must be notified within 30 days of the date of delivery in writing as to any discrepancies. The discovery of any discrepancies after 30 days or after the commencement of any office or fieldwork is the full responsibility of the client to remedy.

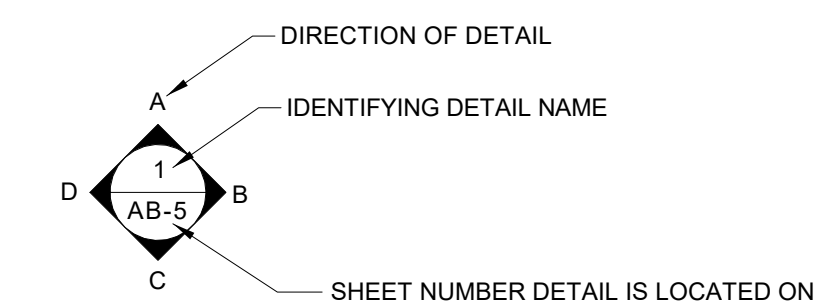

INTERIOR ELEVATIONS

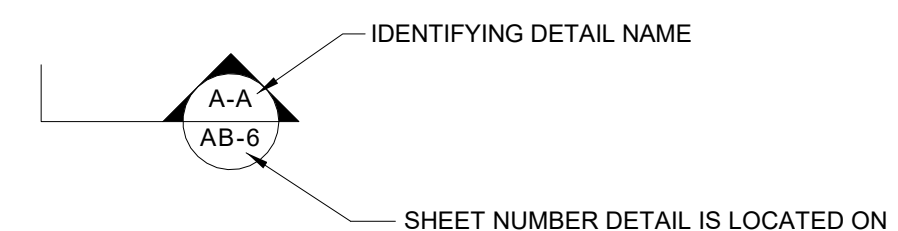






BUILDING SECTION

PHOTO DOCUMENTATION LEGEND

INDICATES LOCATION OF CAMERA

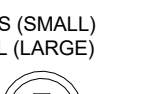INDICATES DIRECTION OF CAMERA LENS AND CORRESPONDING PHOTO / VIDEO NUMBER

TYPES OF DOCUMENTATION

	PS (SMALL)	001		V-001		360		000		V-000
GROUND BASED PHOTO			GROUND BASED VIDEO		360° SPHERICAL PHOTO		AERIAL BASED PHOTO		AERIAL BASED VIDEO	

ARCHITECTURAL AS BUILT
Brentwood, CA 94513


NO.	ISSUES / REVISIONS	DATE	SHEET TITLE
01	100% SUBMISSION		SEE COVER SHEET

SYMBOLS

A.D.	PROJECT MANAGER
A.D.	PROJECT DIRECTOR
22-05	PROJECT NUMBER
	SCALE
A.J.	DRAWN BY
	SHEET NUMBER

OSL

ARCHITECTURAL AS BUILT
Brentwood, CA 94513

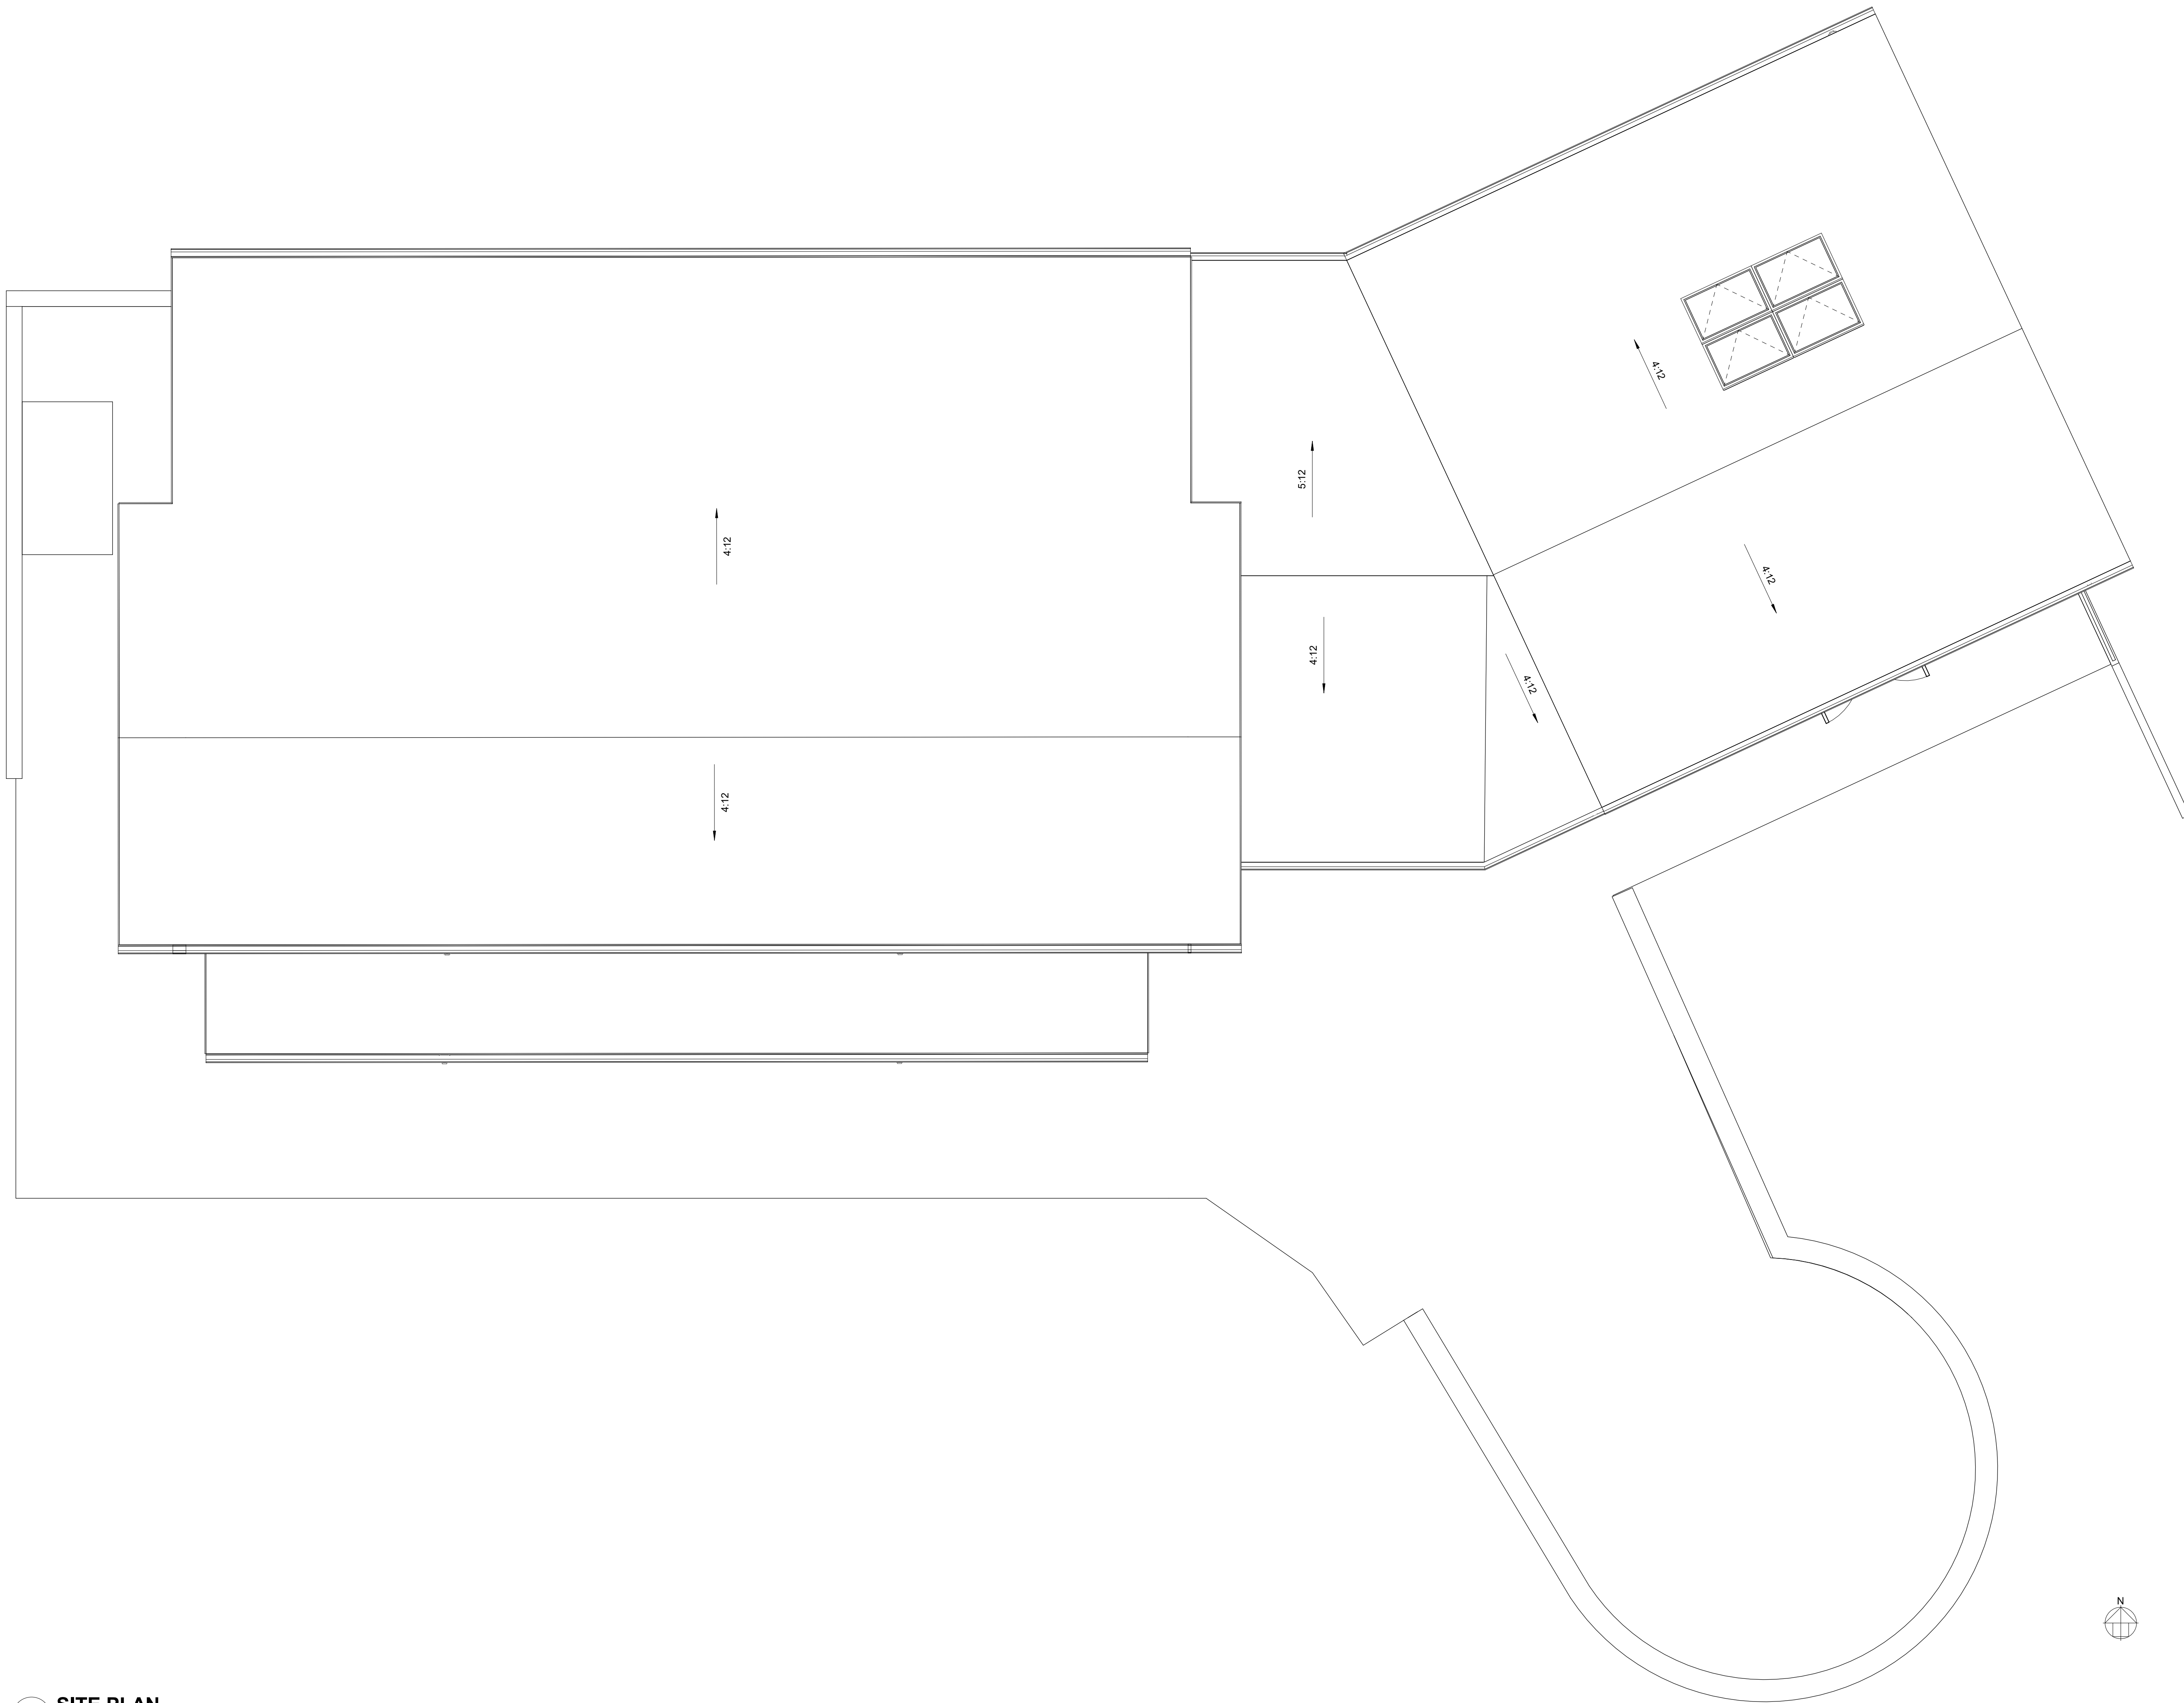

NO.	ISSUES / REVISIONS	DATE	SHEET TITLE
01	100% SUBMISSION		SEE COVER SHEET


SITE PLAN

A.D.	PROJECT MANAGER
A.D.	PROJECT DIRECTOR
22-05	PROJECT NUMBER
	SCALE
A.J.	DRAWN BY
	SHEET NUMBER

DOOR SCHEDULE			
Mark	Width	Height	Operation
1	5'-10"	7'-6"	SWING DOUBLE DOOR
2	6'-0"	7'-0"	SWING DOUBLE DOOR
3	6'-0"	6'-8"	SWING DOUBLE DOOR
4	6'-0"	6'-8"	SWING DOUBLE DOOR
5	5'-10"	7'-0"	SWING DOUBLE DOOR
6	5'-10"	7'-0"	SWING DOUBLE DOOR
7	9'-6"	8'-0"	SLIDING DOOR
8	6'-0"	7'-0"	SWING DOUBLE DOOR
9	9'-6"	8'-0"	SLIDING DOOR
10	3'-6"	6'-8"	OPENING
11	5'-10"	7'-0"	SWING DOUBLE DOOR
12	3'-0"	6'-8"	SWING SINGLE DOOR
13	5'-10"	7'-0"	SWING DOUBLE DOOR
14	3'-0"	6'-8"	SWING SINGLE DOOR
15	3'-0"	6'-8"	SWING SINGLE DOOR
16	3'-0"	6'-8"	SWING SINGLE DOOR
17	6'-0"	6'-8"	SWING DOUBLE DOOR
18	3'-0"	6'-8"	SWING SINGLE DOOR
19	3'-0"	6'-8"	SWING SINGLE DOOR
20	3'-0"	6'-8"	SWING SINGLE DOOR

WINDOW SCHEDULE					
Mark	Count	Width	Height	Operation	
1	4	2'-3"	4'-0"	FIXED	
2	2	1'-9"	6'-2"	FIXED	
3	1	9'-6"	2'-0"	FIXED	
4	1	1'-2"	6'-2"	FIXED	
5	1	3'-4"	6'-2"	FIXED	
6	2	3'-8"	6'-2"	FIXED	
7	1	4'-4"	6'-2"	FIXED	
8	1	1'-6"	1'-6"	FIXED	
9	1	2'-0"	4'-0"	FIXED	
10	2	2'-6"	3'-6"	FIXED	
11	1	2'-10"	5'-4"	FIXED	
12	4	2'-8"	5'-2"	FIXED	
13	1	3'-0"	4'-0"	FIXED	
14	2	2'-8"	1'-6"	FIXED	
15	4	4'-0"	2'-8"	SKY LIGHT	
16	1	3'-0"	5'-6"	FIXED	
17	1	1'-6"	6'-2"	FIXED	
18	1	5'-10"	1'-6"	FIXED	
19	2	3'-8"	1'-6"	FIXED	
20	1	4'-4"	1'-6"	FIXED	
21	4	2'-2"	6'-2"	FIXED	
22	24	3'-6"	3'-0"	FIXED	

FINISH SCHEDULE		
Number	Room	Floor Finish
1	EXHIBITION	CARPET
2	EXHIBITION	TILE
3	EXHIBITION	CARPET
4	LOBBY	TILE
5	STORAGE	TILE
6	OFFICE	TILE
7	MECH ROOM	TILE
8	CORRIDOR	TILE
9	MEN BATHROOM	TILE
10	WOMEN BATHROOM	TILE
11	EXHIBITION	

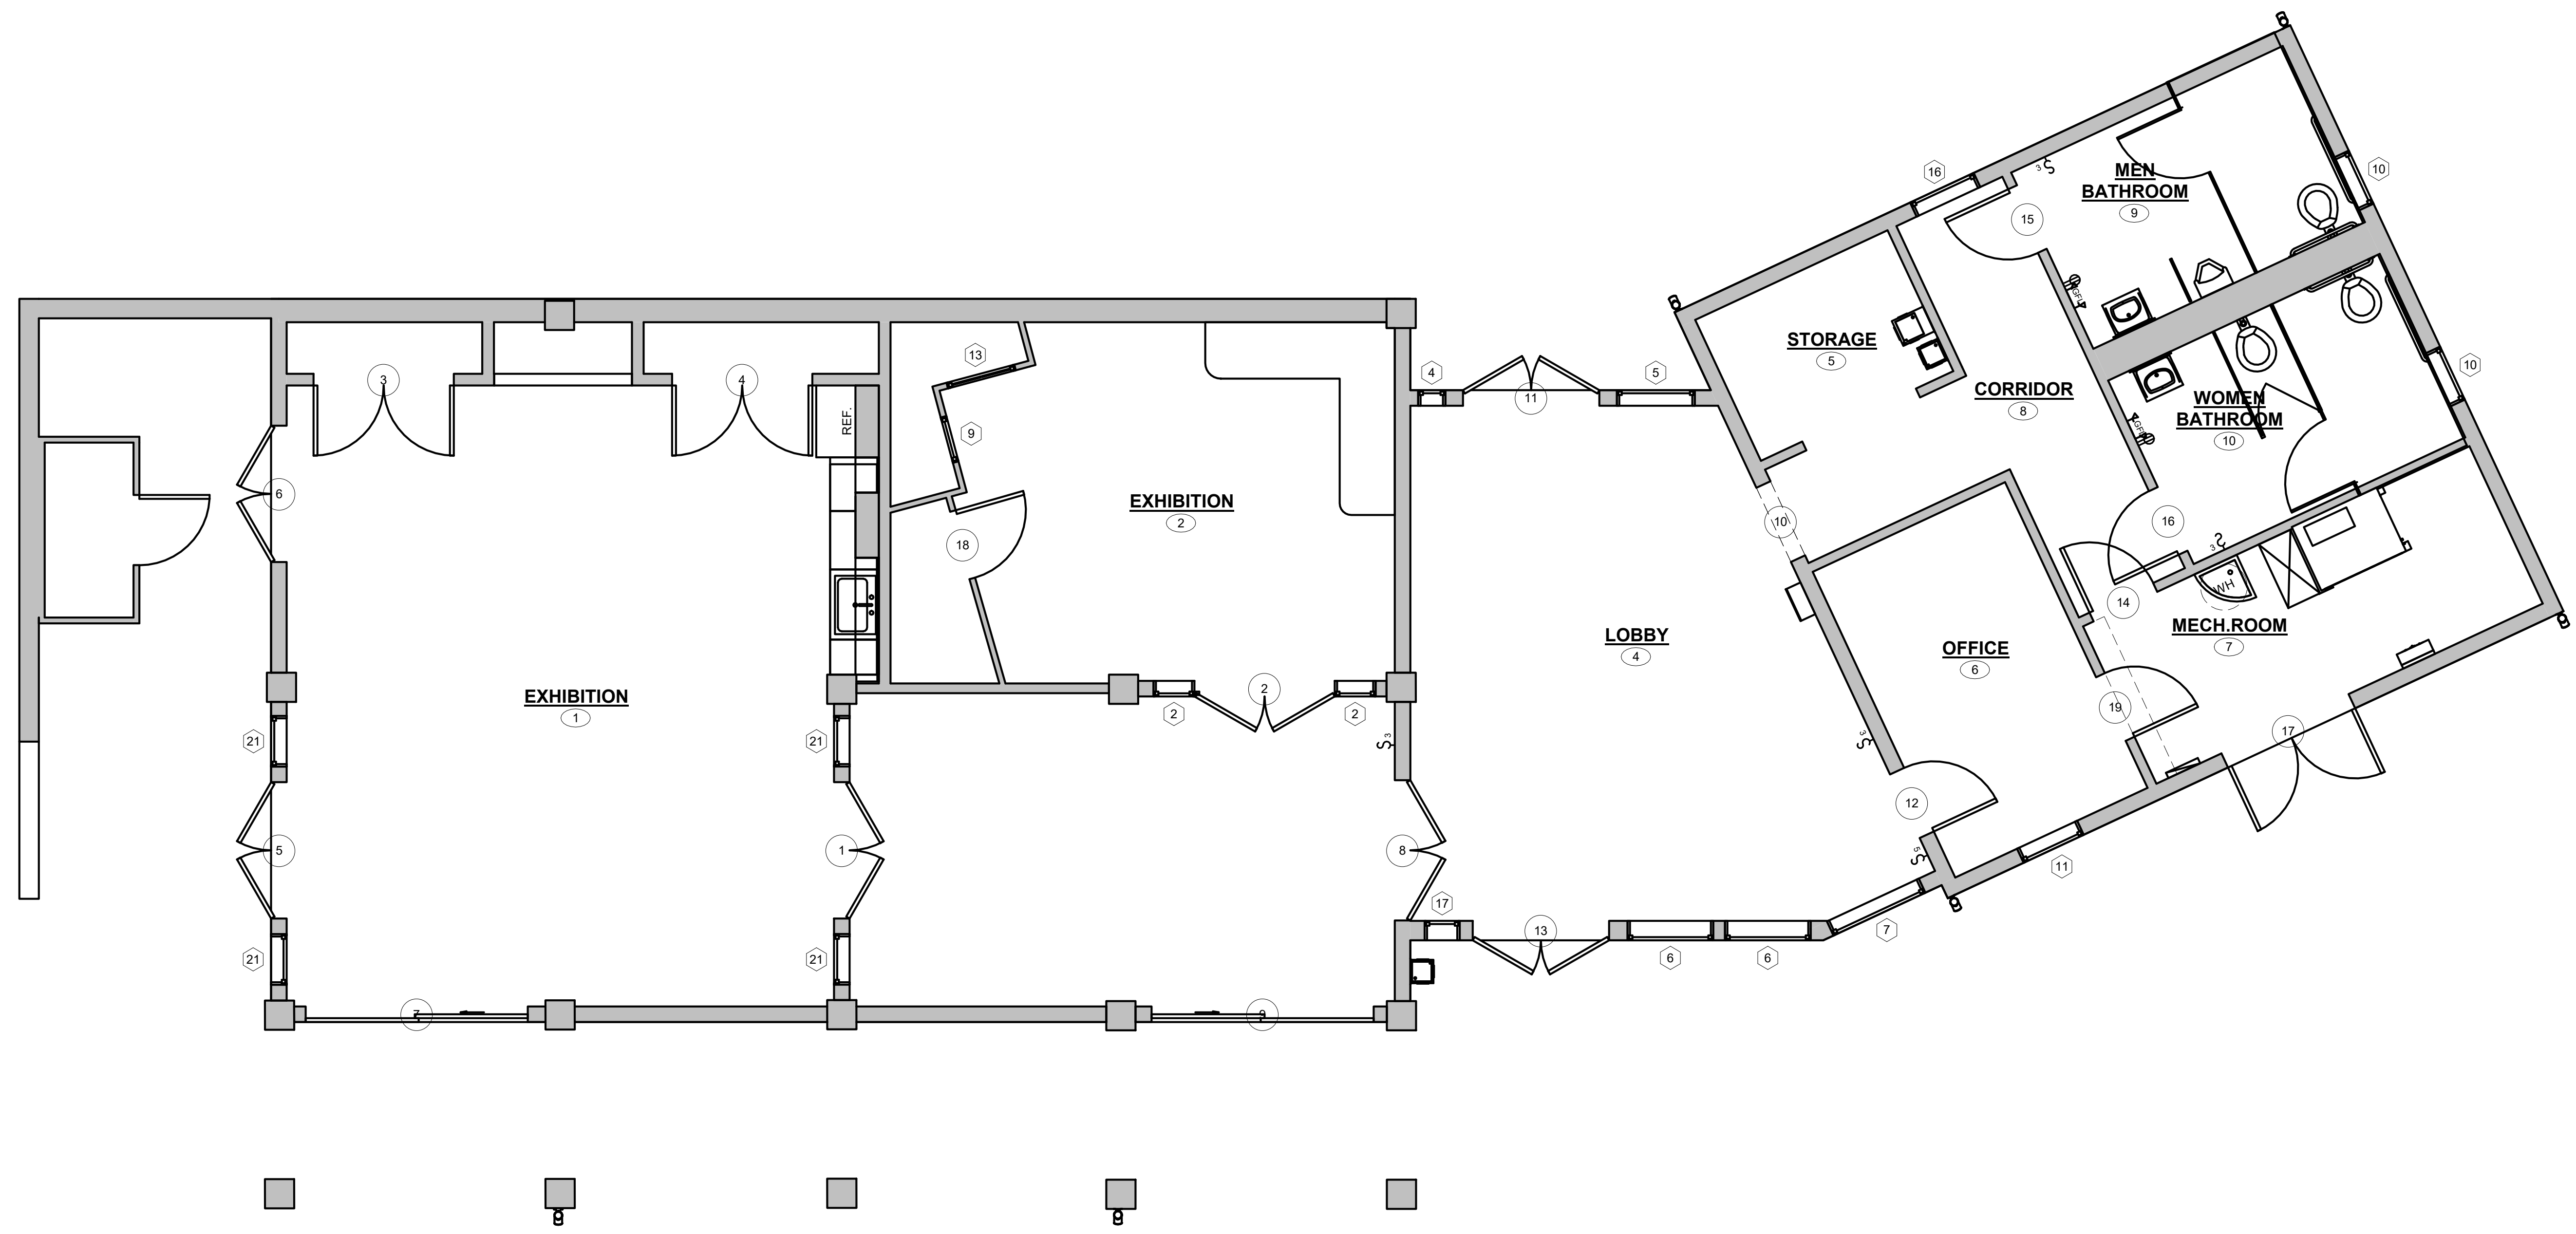

ARCHITECTURAL AS BUILT
Brentwood, CA 94513


01	100% SUBMISSION	SEE COVER SHEET
NO.	ISSUES / REVISIONS	DATE
		SHEET TITLE

FLOOR PLAN


A.D.	PROJECT MANAGER
A.D.	PROJECT DIRECTOR
22-05	PROJECT NUMBER
	SCALE
A.J.	DRAWN BY
	SHEET NUMBER

AB-2

ARCHITECTURAL AS BUILT
Brentwood, CA 94513

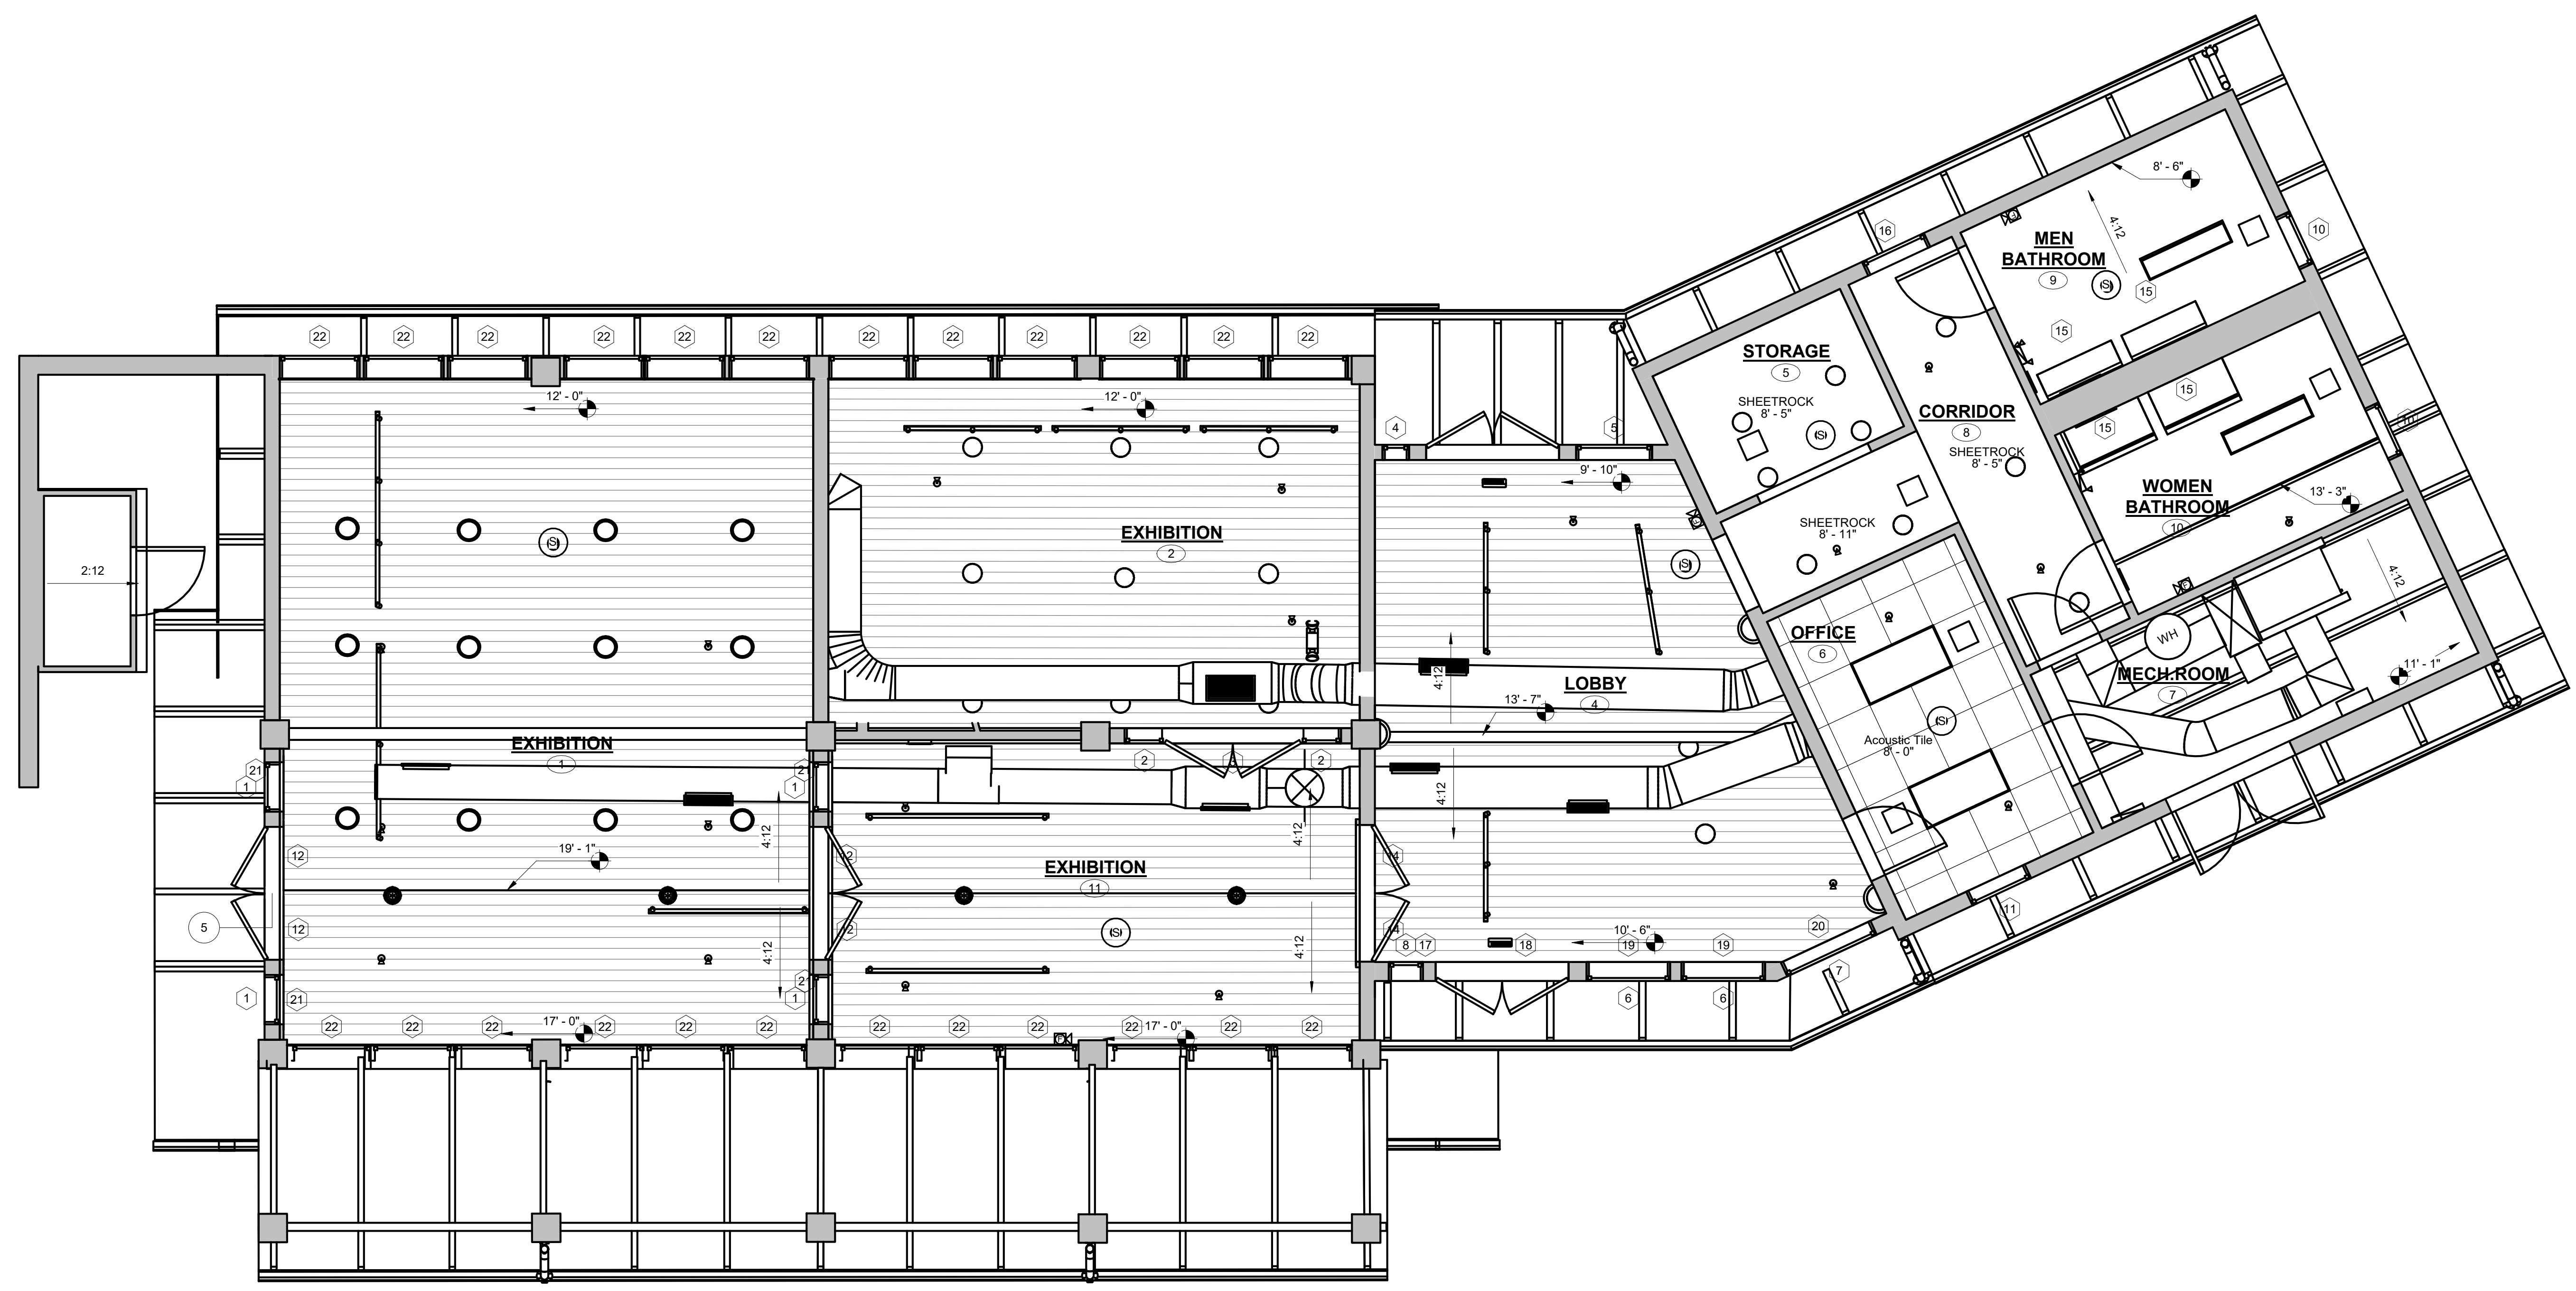

1 FIRST FLOOR
SCALE: 1/4" = 1'-0"

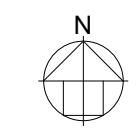


01	100% SUBMISSION	SEE COVER SHEET
NO.	ISSUES / REVISIONS	DATE


CEILING PLAN

A.D.	PROJECT MANAGER
A.D.	PROJECT DIRECTOR
22-05	PROJECT NUMBER
	SCALE
A.J.	DRAWN BY
	SHEET NUMBER

AB-3

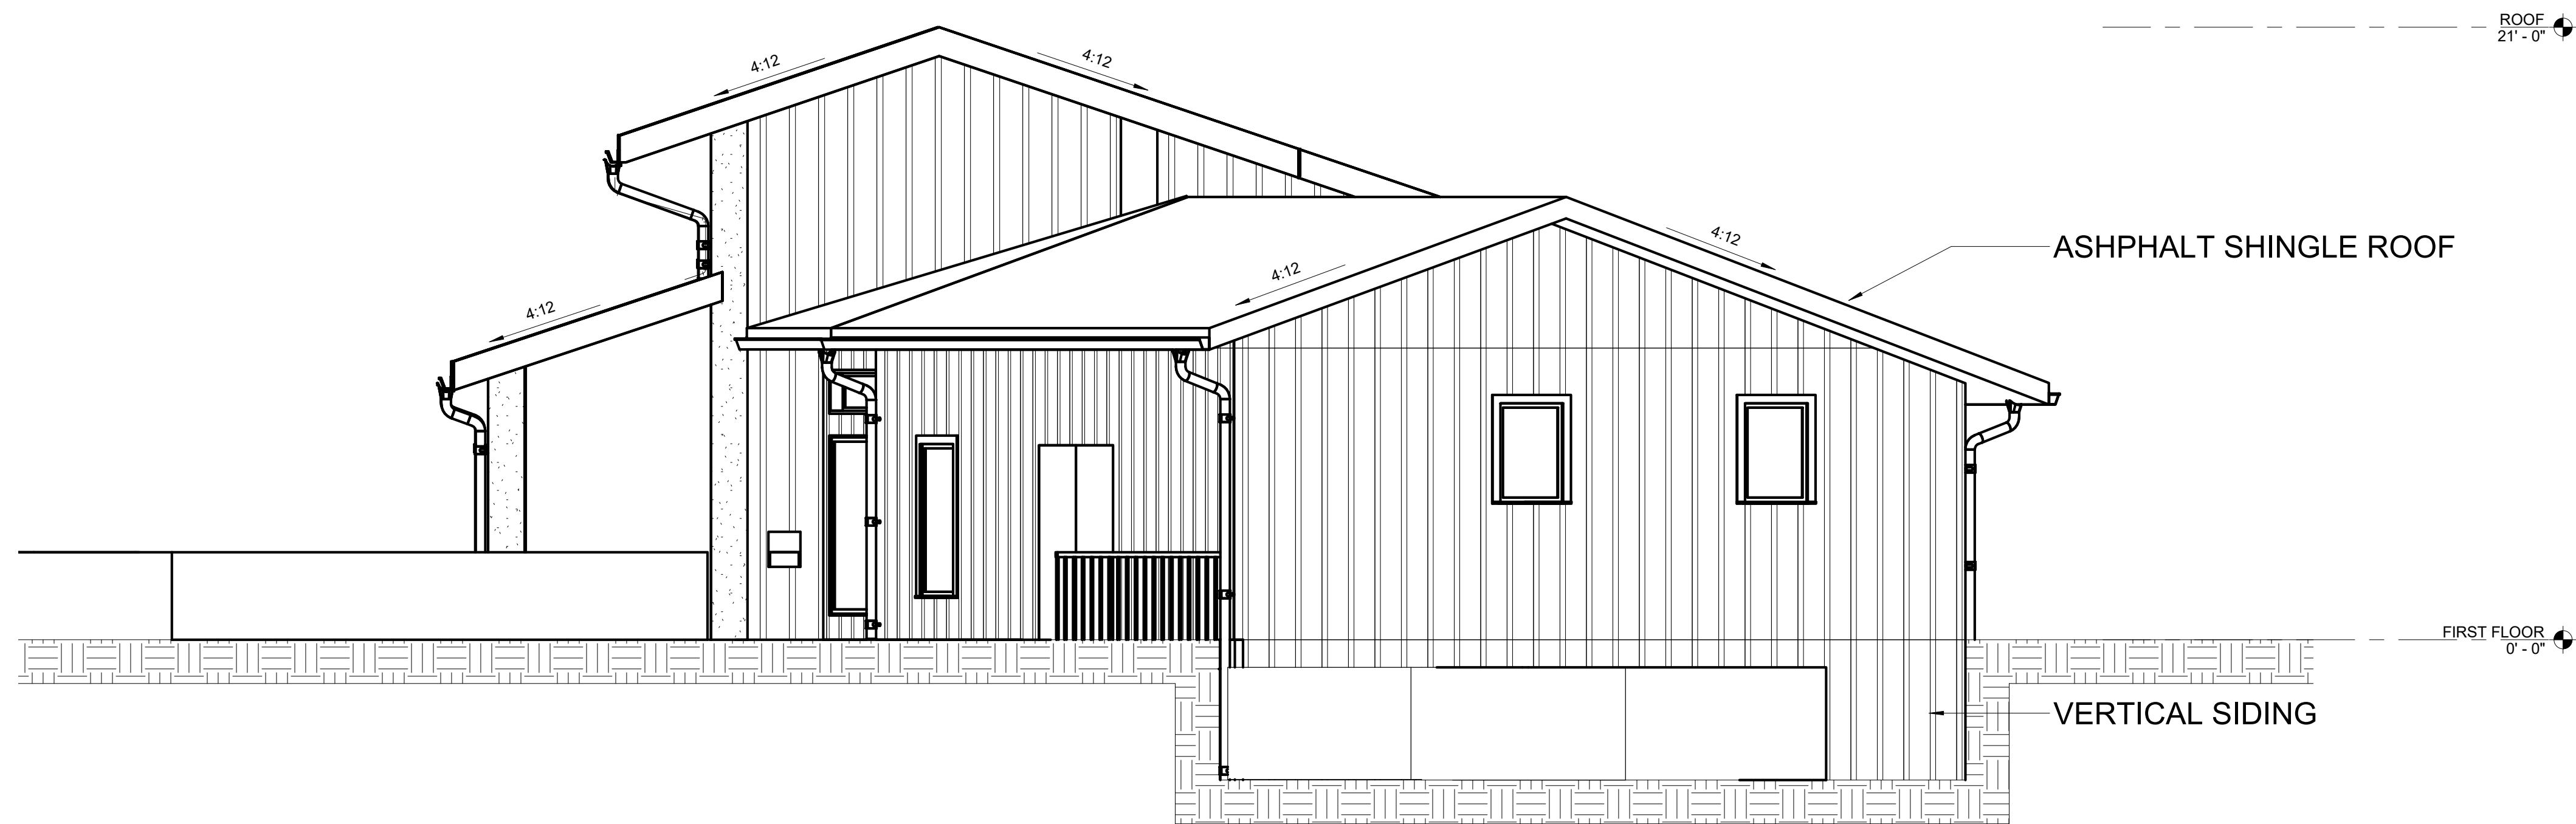

1 EAST
SCALE: 1/4" = 1'-0"

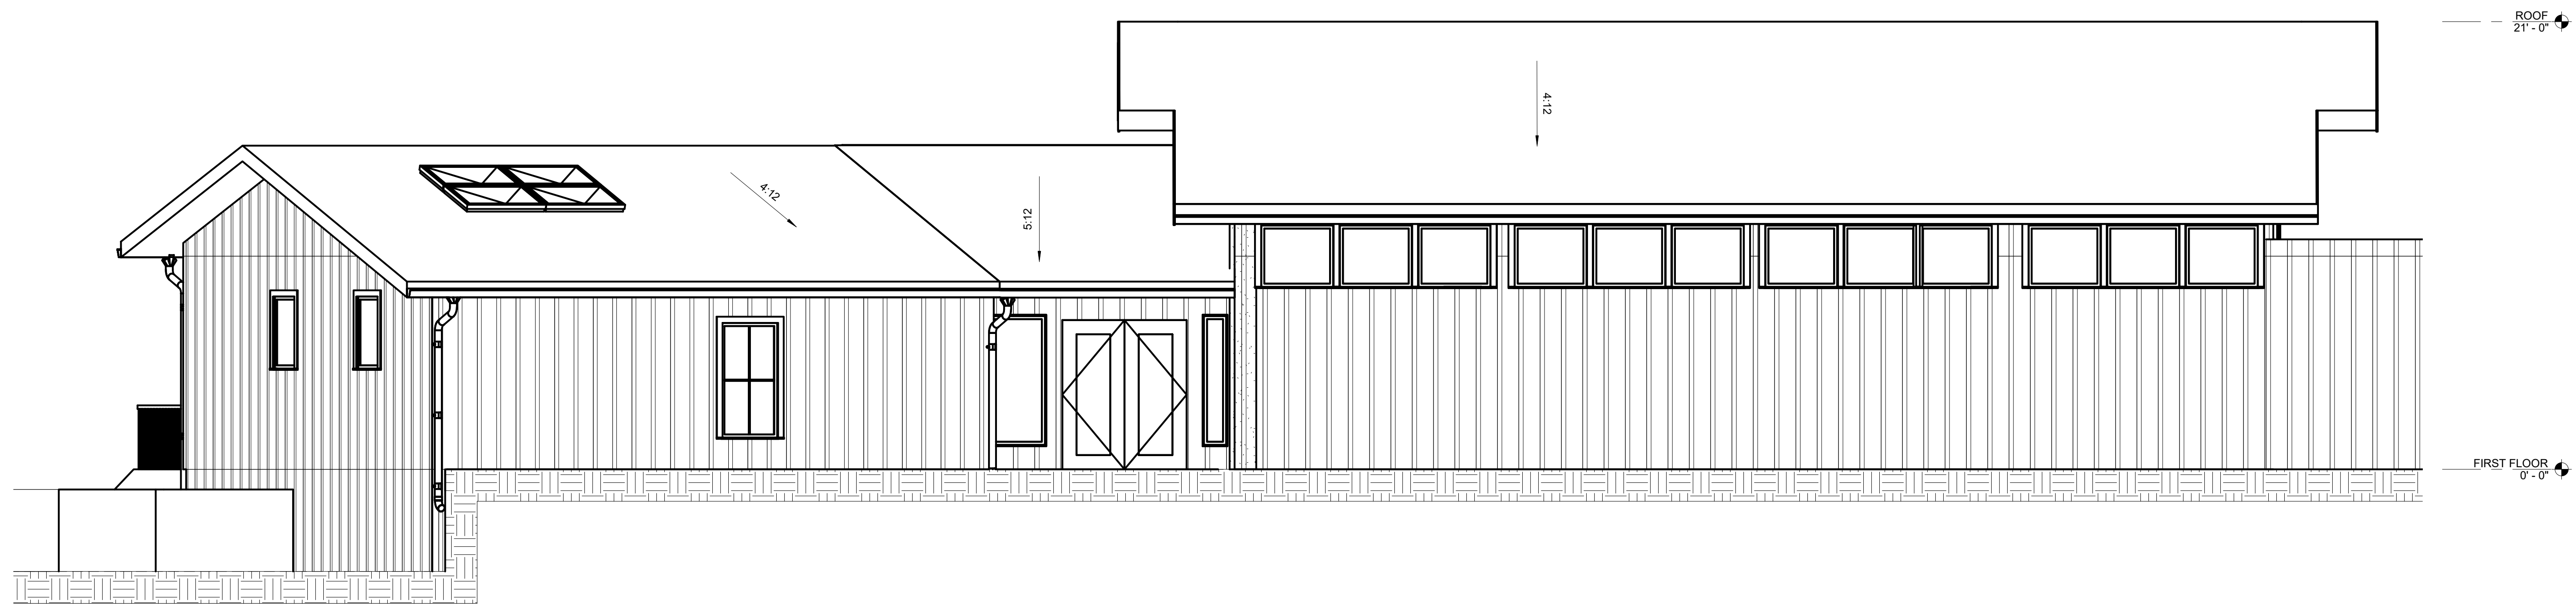

2 NORTH
SCALE: 1/4" = 1'-0"


ARCHITECTURAL AS BUILT
Brentwood, CA 94513

NO.	ISSUES / REVISIONS	DATE	SHEET TITLE
01	100% SUBMISSION		SEE COVER SHEET

ELEVATIONS

A.D.	PROJECT MANAGER
A.D.	PROJECT DIRECTOR
22-05	PROJECT NUMBER
	SCALE
A.J.	DRAWN BY
	SHEET NUMBER

AB-4

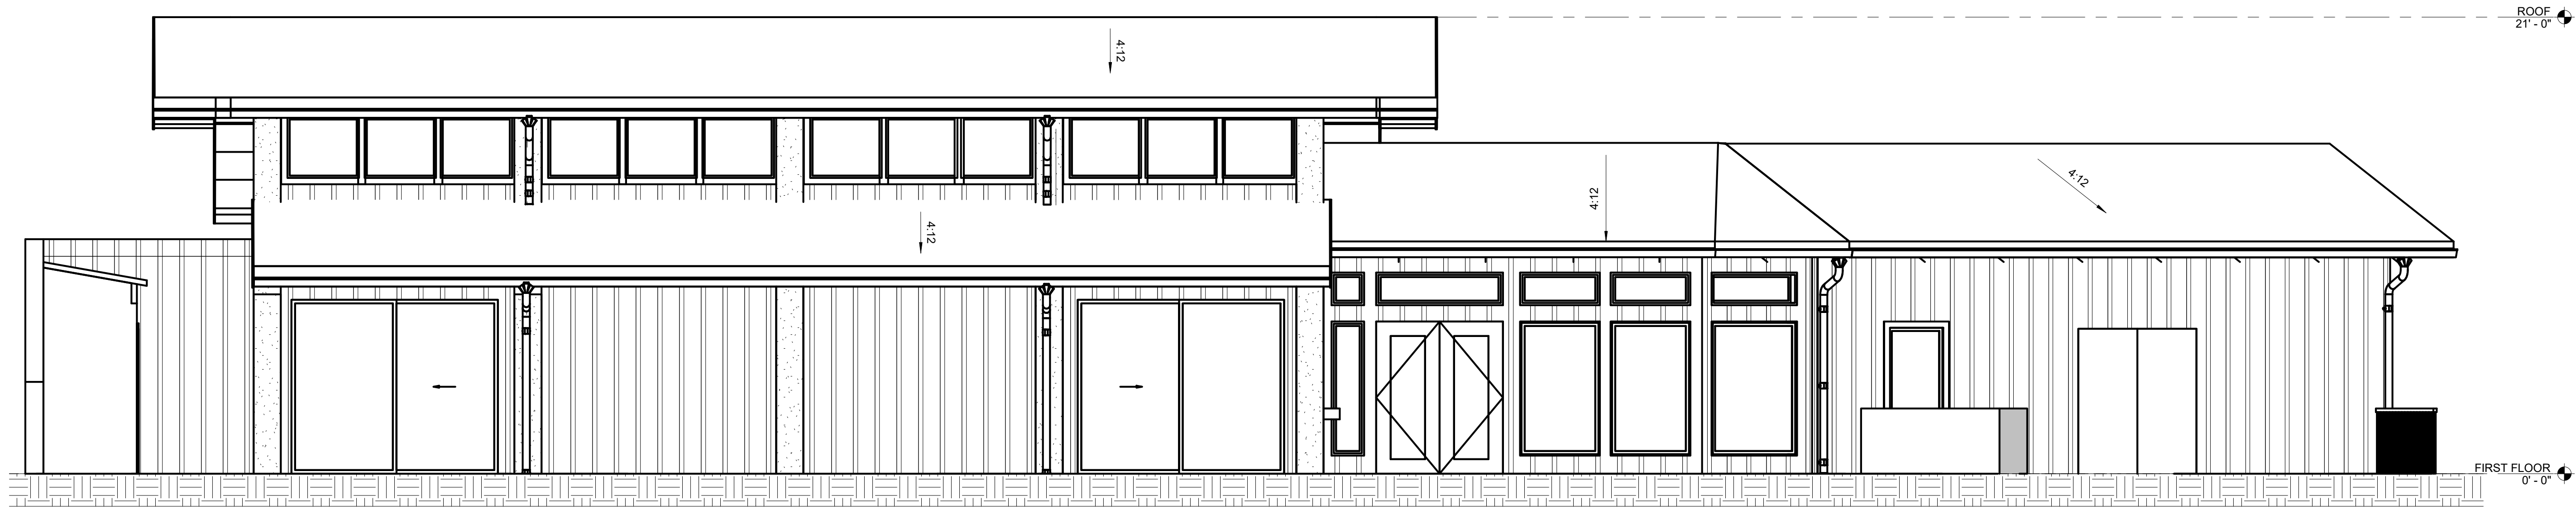

1 SOUTH
 SCALE: 1/4" = 1'-0"



2 WEST
 SCALE: 1/4" = 1'-0"


ARCHITECTURAL AS BUILT
Brentwood, CA 94513

01	100% SUBMISSION	SEE COVER SHEET
NO.	ISSUES / REVISIONS	DATE

ELEVATIONS

A.D.	PROJECT MANAGER
A.D.	PROJECT DIRECTOR
22-05	PROJECT NUMBER
	SCALE
A.J.	DRAWN BY
	SHEET NUMBER

AB-5

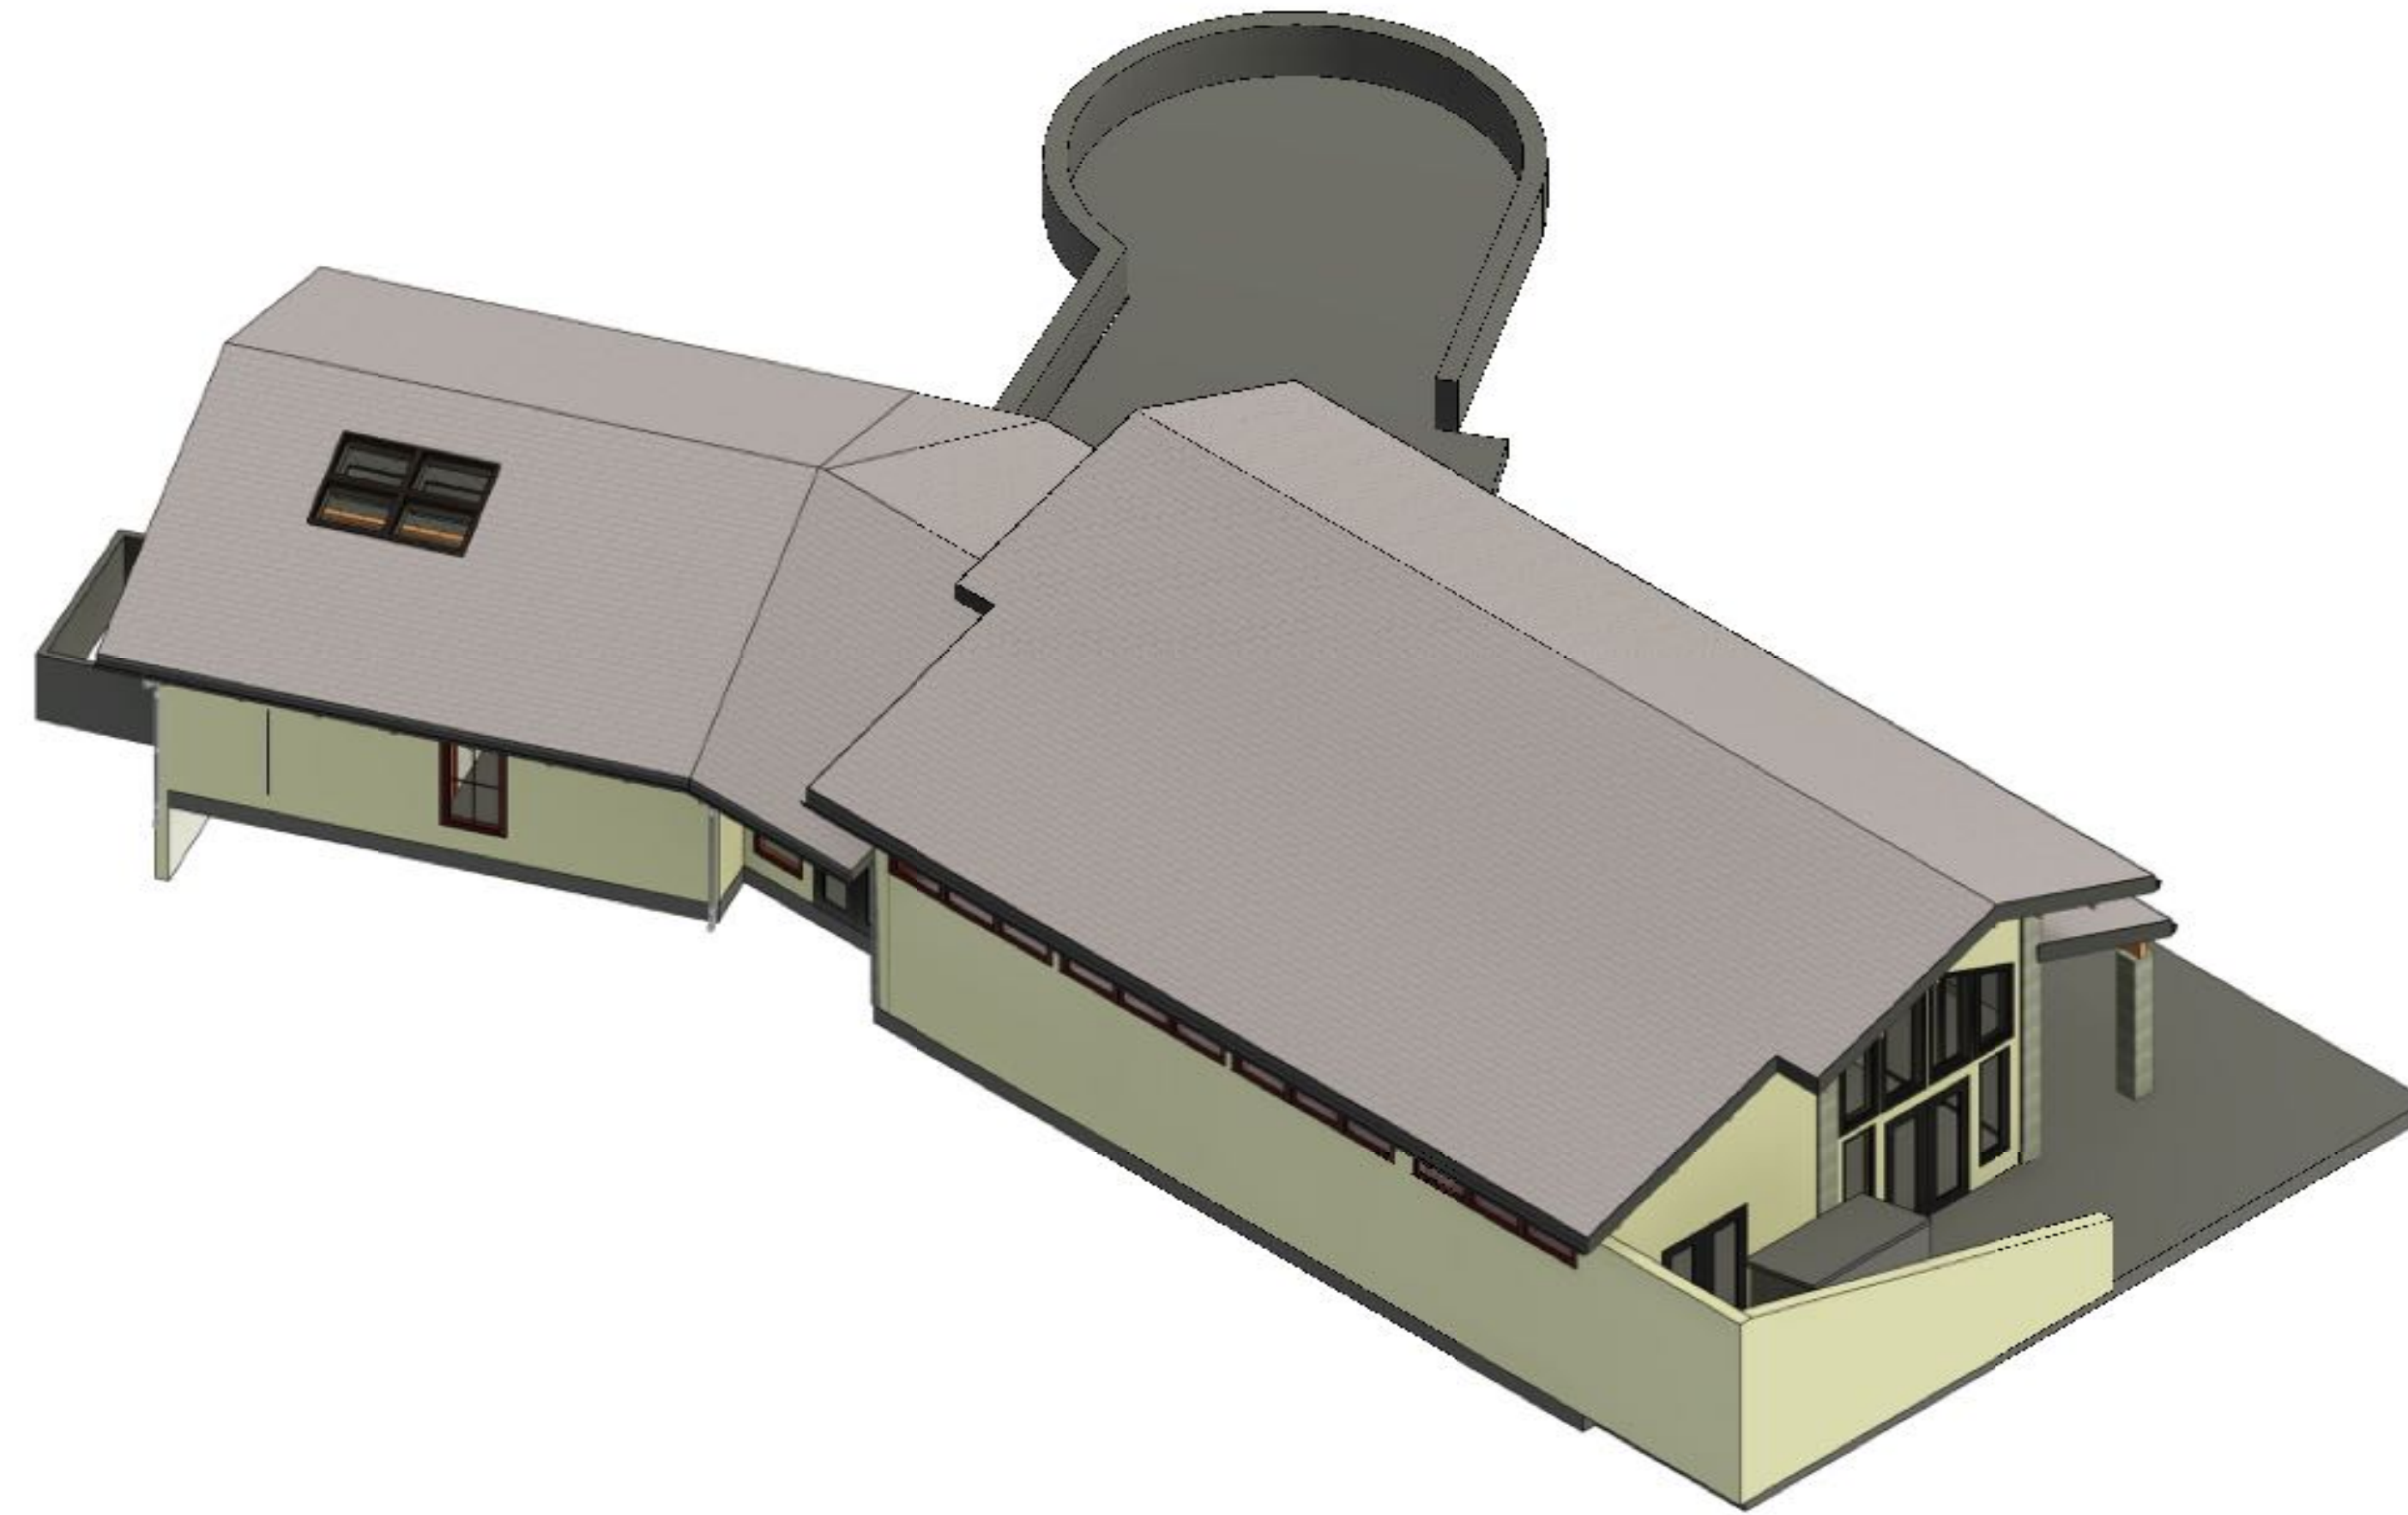

1 NORTH WEST VIEW
 SCALE:



2 SOUTH EAST VIEW
 SCALE:


ARCHITECTURAL AS BUILT
Brentwood, CA 94513

NO.	ISSUES / REVISIONS	DATE	SHEET TITLE
01	100% SUBMISSION		SEE COVER SHEET


PERSPECTIVE

A.D.	PROJECT MANAGER
A.D.	PROJECT DIRECTOR
22-05	PROJECT NUMBER
	SCALE
A.J.	DRAWN BY
	SHEET NUMBER

AB-6

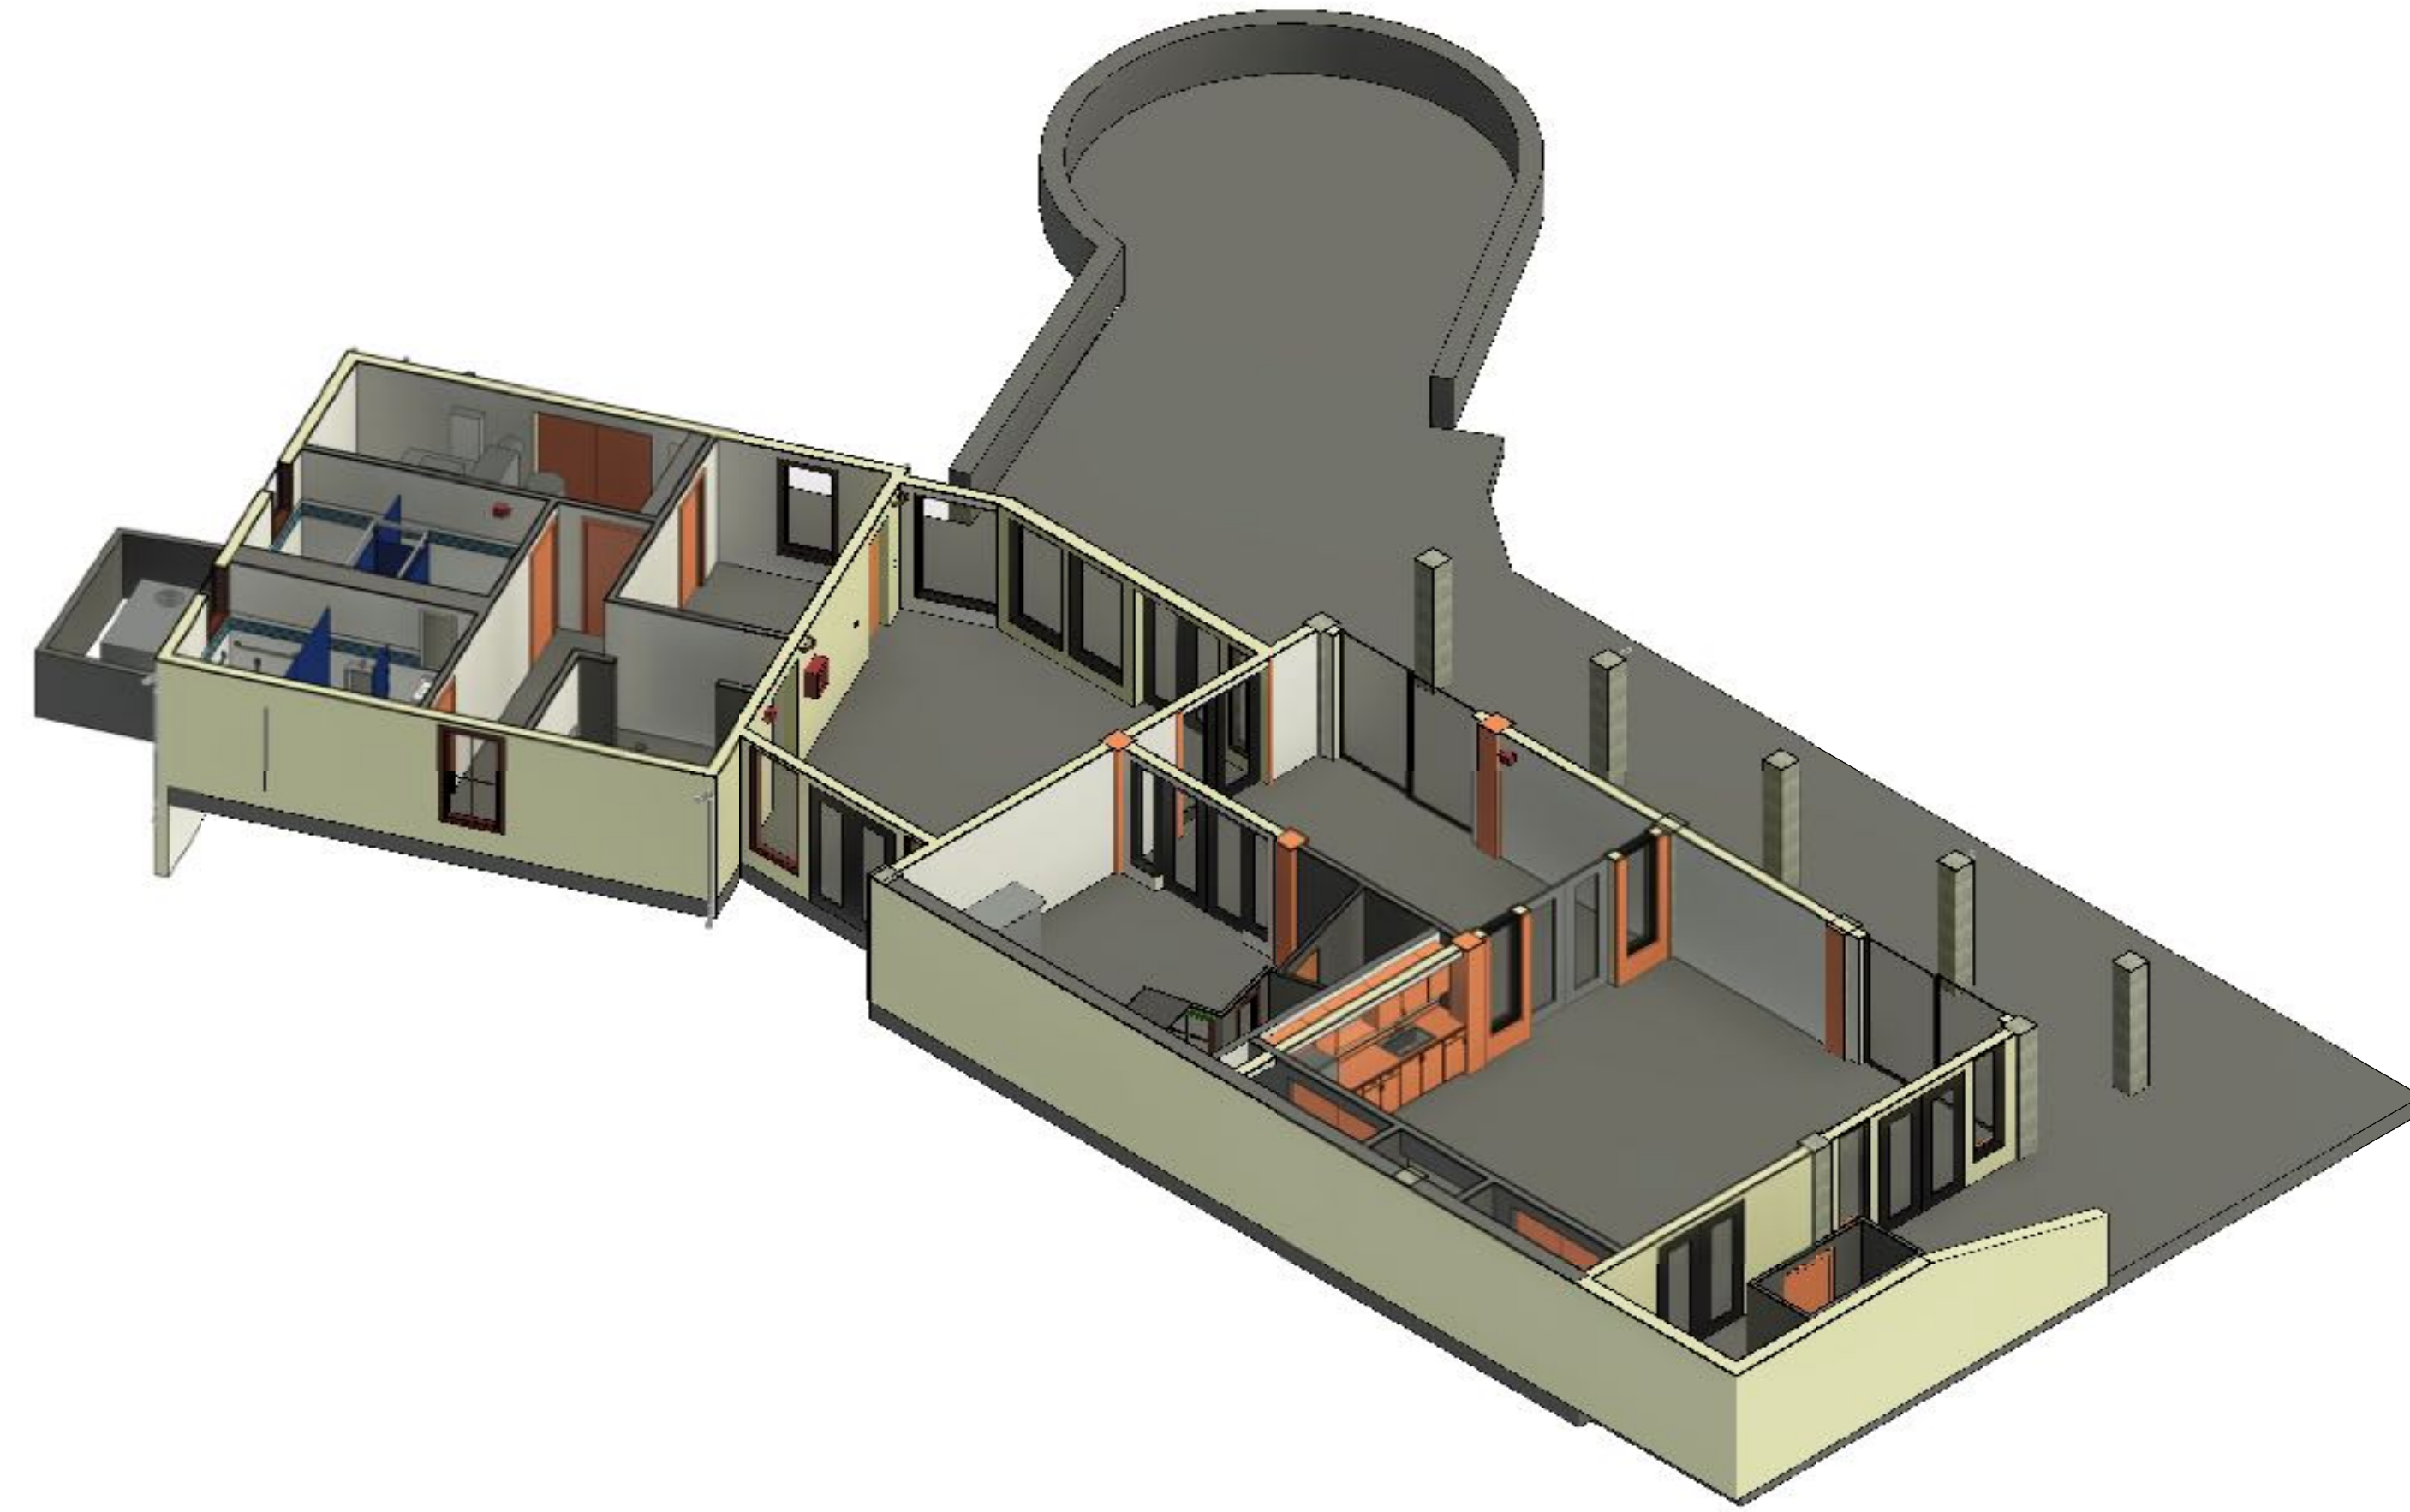

1 NORTH WEST 3D SECTION VIEW
SCALE:

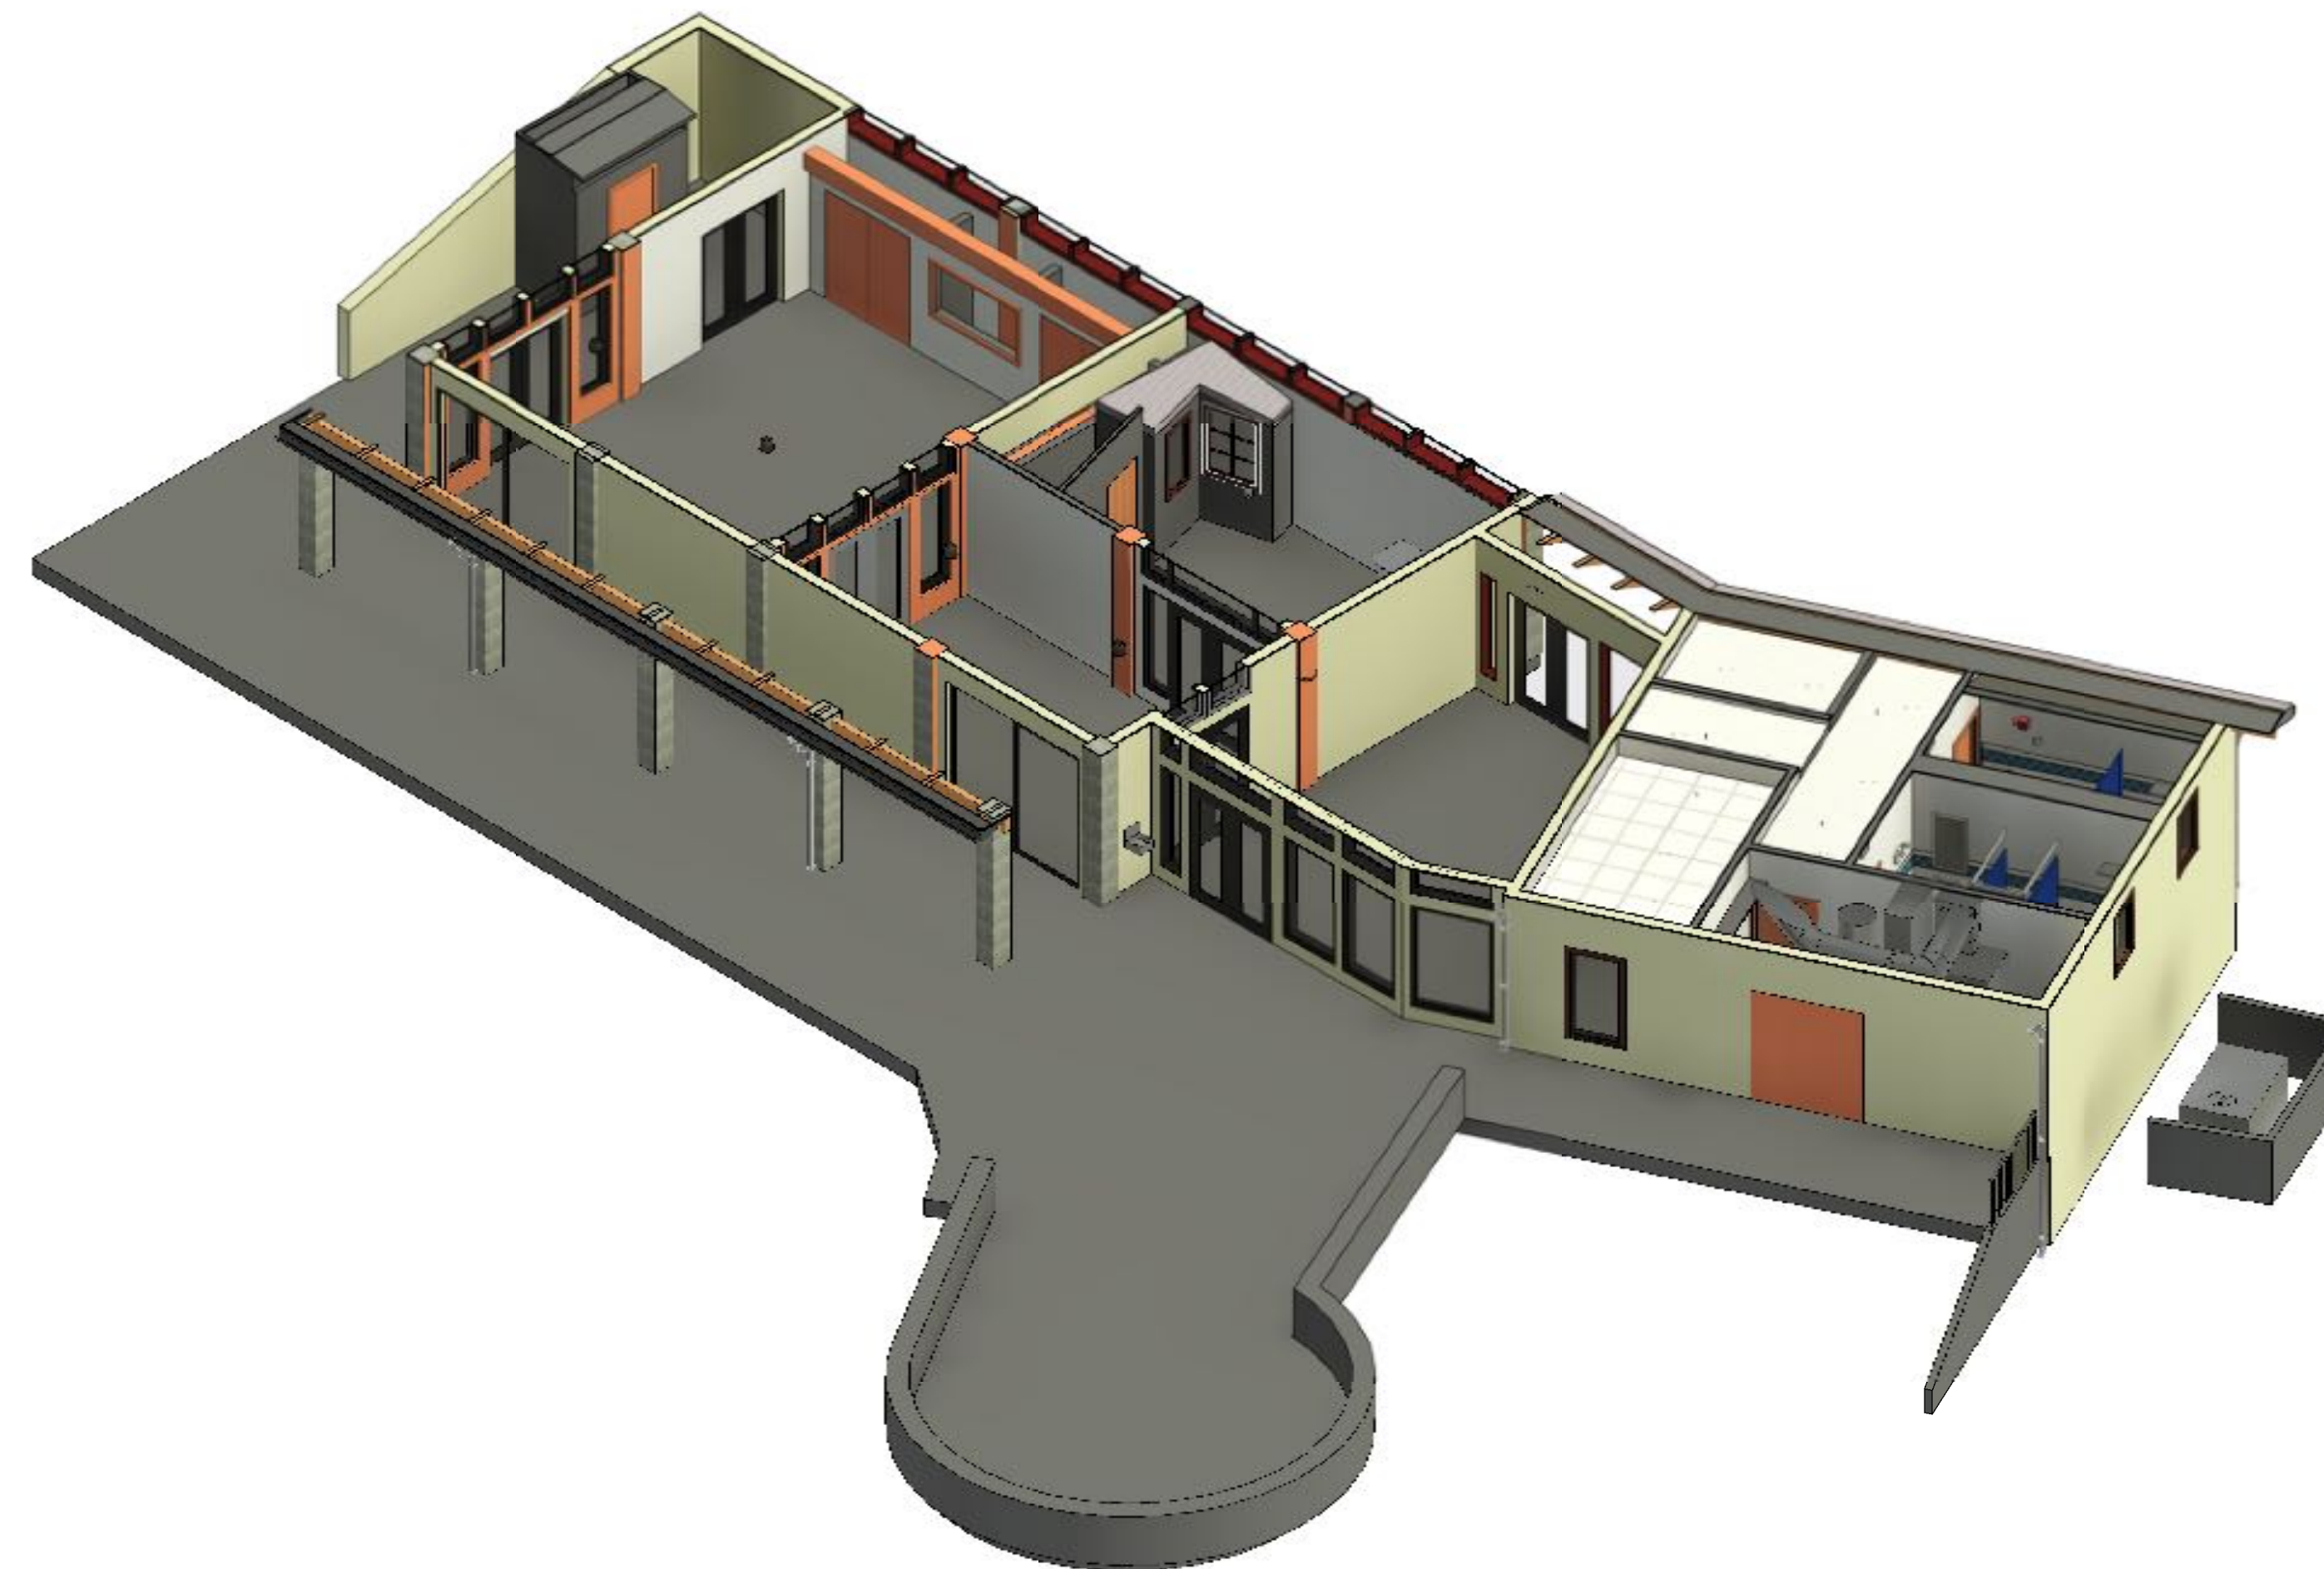

2 SOUTH EAST 3D SECTION VIEW
SCALE:


ARCHITECTURAL AS BUILT
Brentwood, CA 94513

NO.	ISSUES / REVISIONS	DATE	SHEET TITLE
01	100% SUBMISSION		SEE COVER SHEET


3D SECTION VIEW

A.D.	PROJECT MANAGER
A.D.	PROJECT DIRECTOR
22-05	PROJECT NUMBER
	SCALE
A.J.	DRAWN BY
	SHEET NUMBER

AB-7

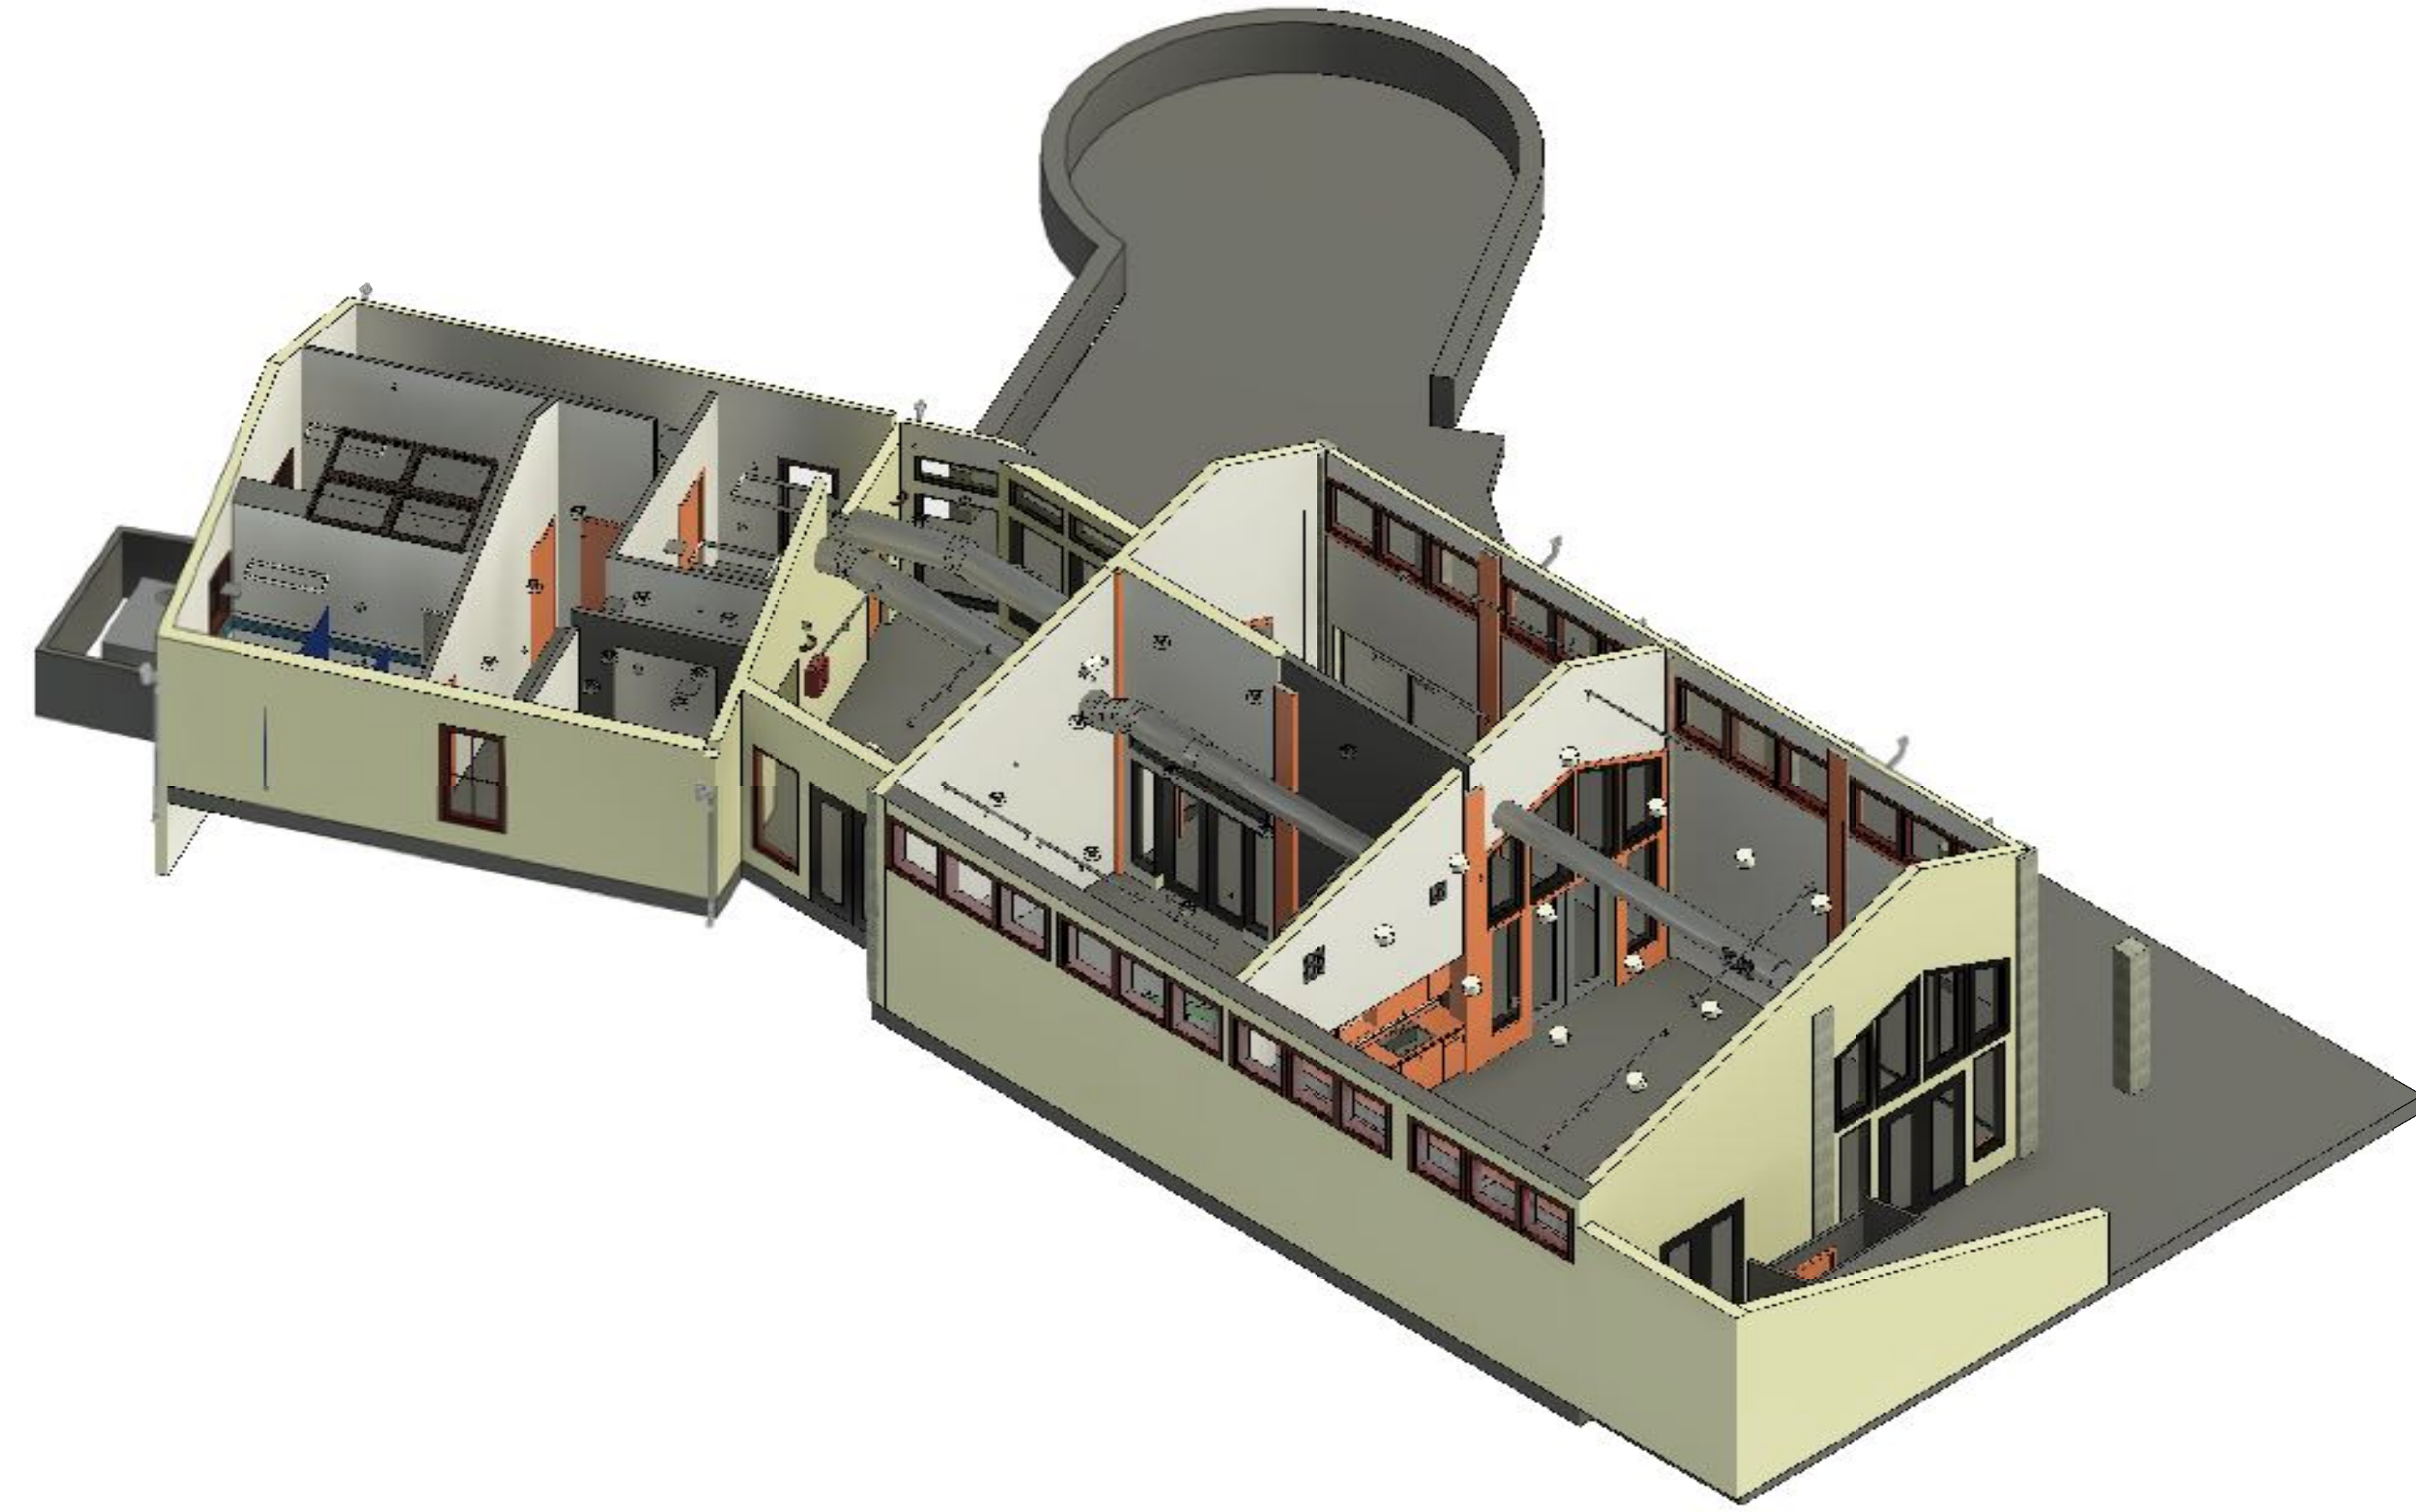

1 NORTH WEST 3D SECTION VIEW MEP
SCALE:

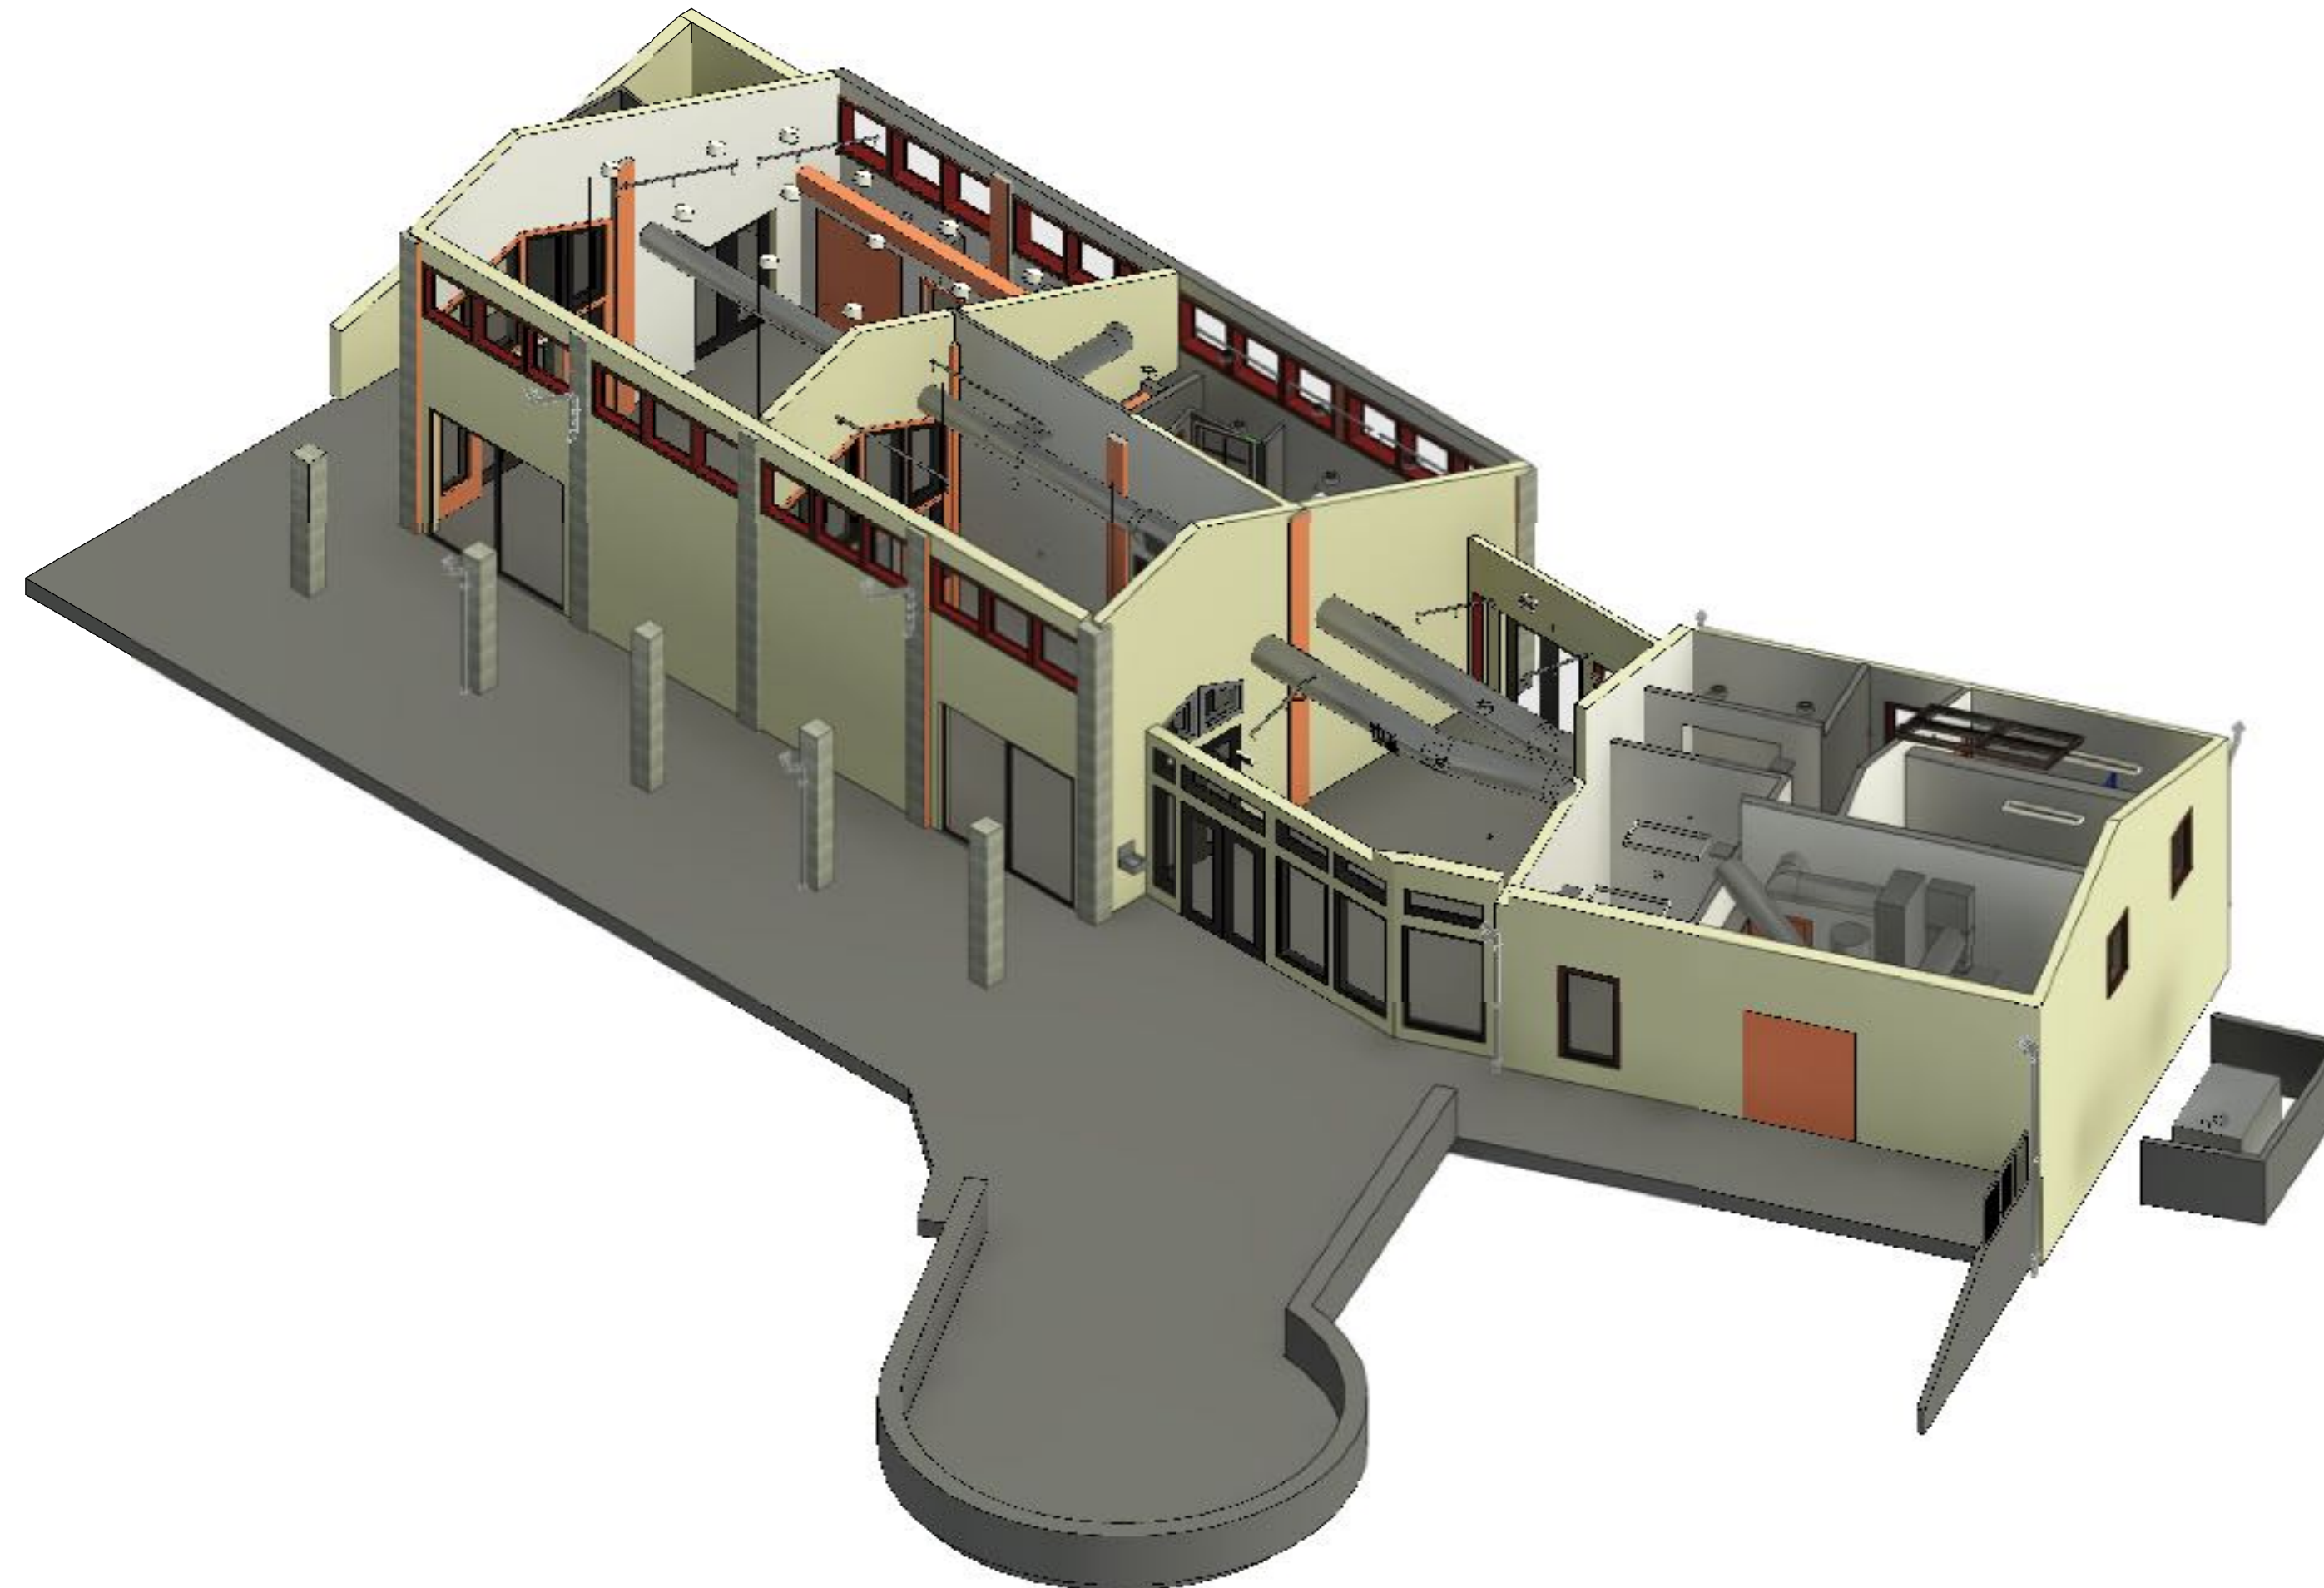

2 SOUTH EAST 3D SECTION VIEW MEP
SCALE:

ARCHITECTURAL AS BUILT
Brentwood, CA 94513

NO.	ISSUES / REVISIONS	DATE	SHEET TITLE
01	100% SUBMISSION		SEE COVER SHEET

3D SECTION MEP

A.D.	PROJECT MANAGER
A.D.	PROJECT DIRECTOR
22-05	PROJECT NUMBER
	SCALE
A.J.	DRAWN BY
	SHEET NUMBER