


# AS-BUILT DOCUMENTATION

## Cambridge, MA 02139

### DRAWING INDEX

- 0C1 COVER
- 0SL SYMBOLS LEGEND
- AB-0 BASEMENT
- AB-1 FIRST FLOOR
- AB-2 SECOND FLOOR
- AB-3 THIRD FLOOR
- AB-4 4TH, 5TH, & 6TH FLOORS
- AB-6 ROOF PLAN
- AB-7 3D EXTERIOR ELEVATIONS
- AB-8 3D SECTION
- AB-9 3D ROOF

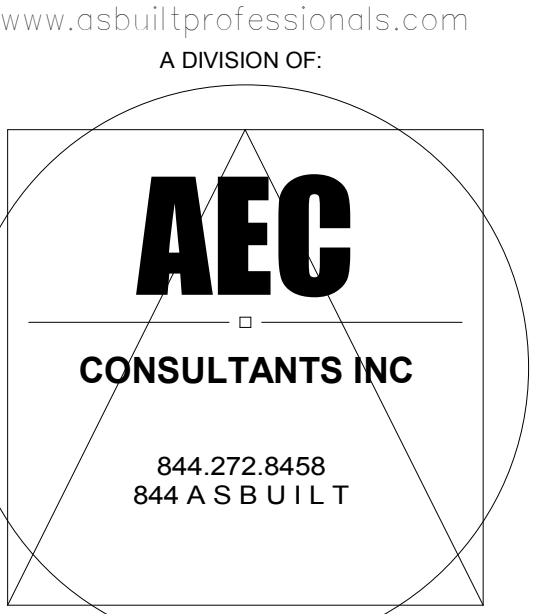

© 2020 AEC CONSULTANTS INC

**ARCHITECTURAL AS BUILT**

**Cambridge, MA 02139**



VICINITY MAP

AREA DATA	
Level	AREA
Not Placed	0 SF
Basement	49386 SF
Level 1	52311 SF
Level 2	24539 SF
Level 3	14233 SF
Level 4	14341 SF
Level 5	9304 SF
Level 6	7950 SF
Roof	52628 SF
Grand total	224708 SF

# 100% SUBMITTAL

01	100% SUBMISSION	SEE COVER SHEET
NO.	ISSUES / REVISIONS	DATE









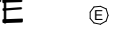

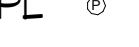

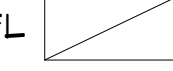
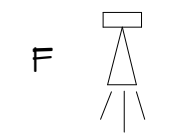
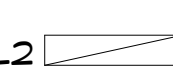
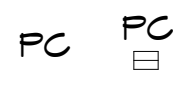
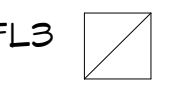
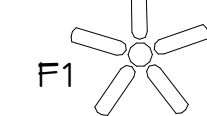

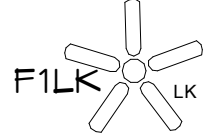



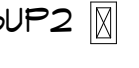



**COVER**

Designer	PROJECT MANAGER
Designer	PROJECT DIRECTOR
Project Number	PROJECT NUMBER
Author	DRAWN BY
	SHEET NUMBER



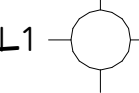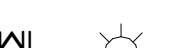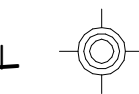
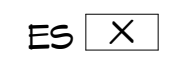
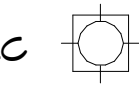







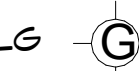
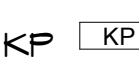
**0C1**

# SYMBOLS LEGEND



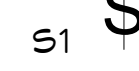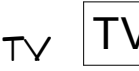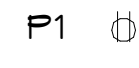

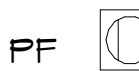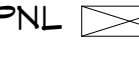


## RCP

EXH 	EXHAUST VENT	VL 	TRACK LIGHT OR VANITY LIGHT
L1 	CEILING MOUNTED LIGHT FIXTURE	WL 	WALL-MOUNTED LIGHT FIXTURE
L 	CEILING MOUNTED DIRECTIONAL LIGHT	ES 	EMERGENCY EXIT SIGN
RC 	RECESSED CAN LIGHT	EL 	EMERGENCY EXIT LIGHT
EYE 	EYEBALL OR SMALL CAN LIGHT	EEL 	EMERGENCY EXIT LIGHT W/ SIGN
HPL 	PENDANT LIGHT	STAIR 	LIGHTED STAIR SIGN
FL 	INDIVIDUAL FLUOR. LAY-IN FIXTURE 4 BULB	F 	FLOOD LIGHT
FL2 	INDIVIDUAL FLUOR. HANGING FIXTURE 2 BULB	PC 	PHOTO CELL
FL3 	INDIVIDUAL FLUOR. FLUSH MOUNT FIXTURE 4 BULB	F1 	CEILING FAN
C 	CAMERA	FILK 	CEILING FAN W/ LIGHT KIT
M 	MOTION DET.	7-2-6	CEILING HEIGHT AND TRIM 7'-2" ABOVE FLOOR BELOW WITH 6" CROWN MOULDING. NOTE: ALL CEILINGS NOT LABELED ARE PLASTER. CEILINGS SHOWN WITH A GRID ARE LAY IN ACOUSTICAL TILE..
SUP 	SUPPLY VENT	J 	JUNCTION BOX
SUP2 	SUPPLY VENT		
RET 	RETURN VENT		
RET2 	RETURN VENT		
spe 	SPEAKER		







## ELECTRIC

DAT 	DATA OUTLET
TEL 	TELEPHONE JACK
S1 	ELECTRIC SWITCH
TV 	CABLE TELEVISION OUTLET
P1 	DUPLEX RECEPTACLE OUTLET
P3 	SPECIAL PURPOSE CONNECTION OR OUTLET
PQ 	QUADRUPLEX RECEPTACLE OUTLET
PF 	FLOOR DUPLEX RECEPTACLE OUTLET
PNL 	ELECTRIC PANEL
MTR 	ELECTRIC METER
BUT 	BUTTON SWITCH
DISC 	DISCONNECT SWITCH
LG 	GROUND/FLOOR LIGHT
KP 	KEY PAD


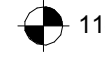
## FIRE PROTECTION


FE 	FIRE EXTINGUISHER
FP 	FIRE PULL
AS 	FIRE ALARM (HORN/SRTO)
SD 	SMOKE DETECTOR
SS 	SMOKE ALARM SPEAKER
SP 	SPRINKLER HEAD CEILING MOUNT
SPW 	SPRINKLER HEAD WALL MOUNT
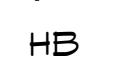
## MEP


TH 	THERMOSTAT
FD 	FLOOR DRAIN
V 	VALVE
HB 	HOSE BIB
WS 	WATER SUPPLY
HEAT 	SUSPENDED GAS HEATER

## MISC

BOLLARD 	BOLLARD
ELEVATION SYMBOL 	11-4-11/16 SPOT ELEVATION

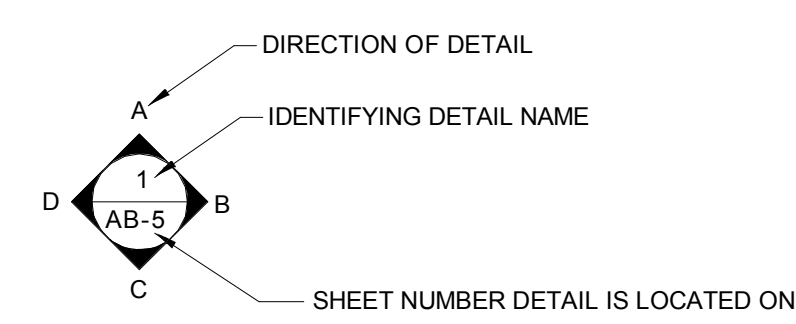

## INTERIOR ELEVATIONS

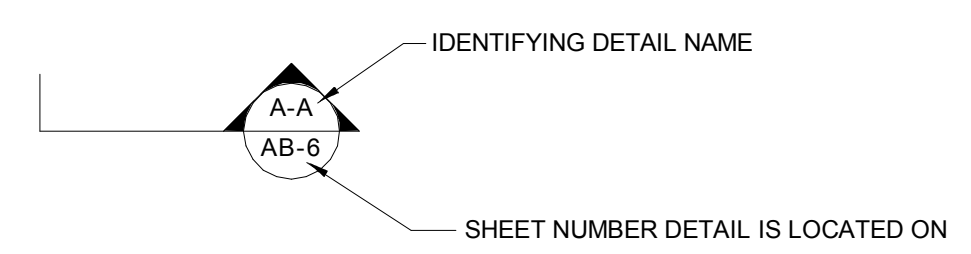

## BUILDING SECTION

**PHOTO DOCUMENTATION LEGEND**

INDICATES LOCATION OF CAMERA

INDICATES DIRECTION OF CAMERA LENS AND CORRESPONDING PHOTO / VIDEO NUMBER

PS (SMALL) PL (LARGE)

TYPES OF DOCUMENTATION

GROUND BASED PHOTO (001)

GROUND BASED VIDEO (V-001)

360° SPHERICAL PHOTO (360)

AERIAL BASED PHOTO (000)

AERIAL BASED VIDEO (V-000)

**ARCHITECTURAL AS BUILT**


**Cambridge, MA 02139**

01	100% SUBMISSION	SEE COVER SHEET
NO.	ISSUES / REVISIONS	DATE

## SYMBOLS LEGEND

Designer	PROJECT MANAGER
Designer	PROJECT DIRECTOR
Project Number	PROJECT NUMBER
Author	DRAWN BY
	SHEET NUMBER

**OSL**

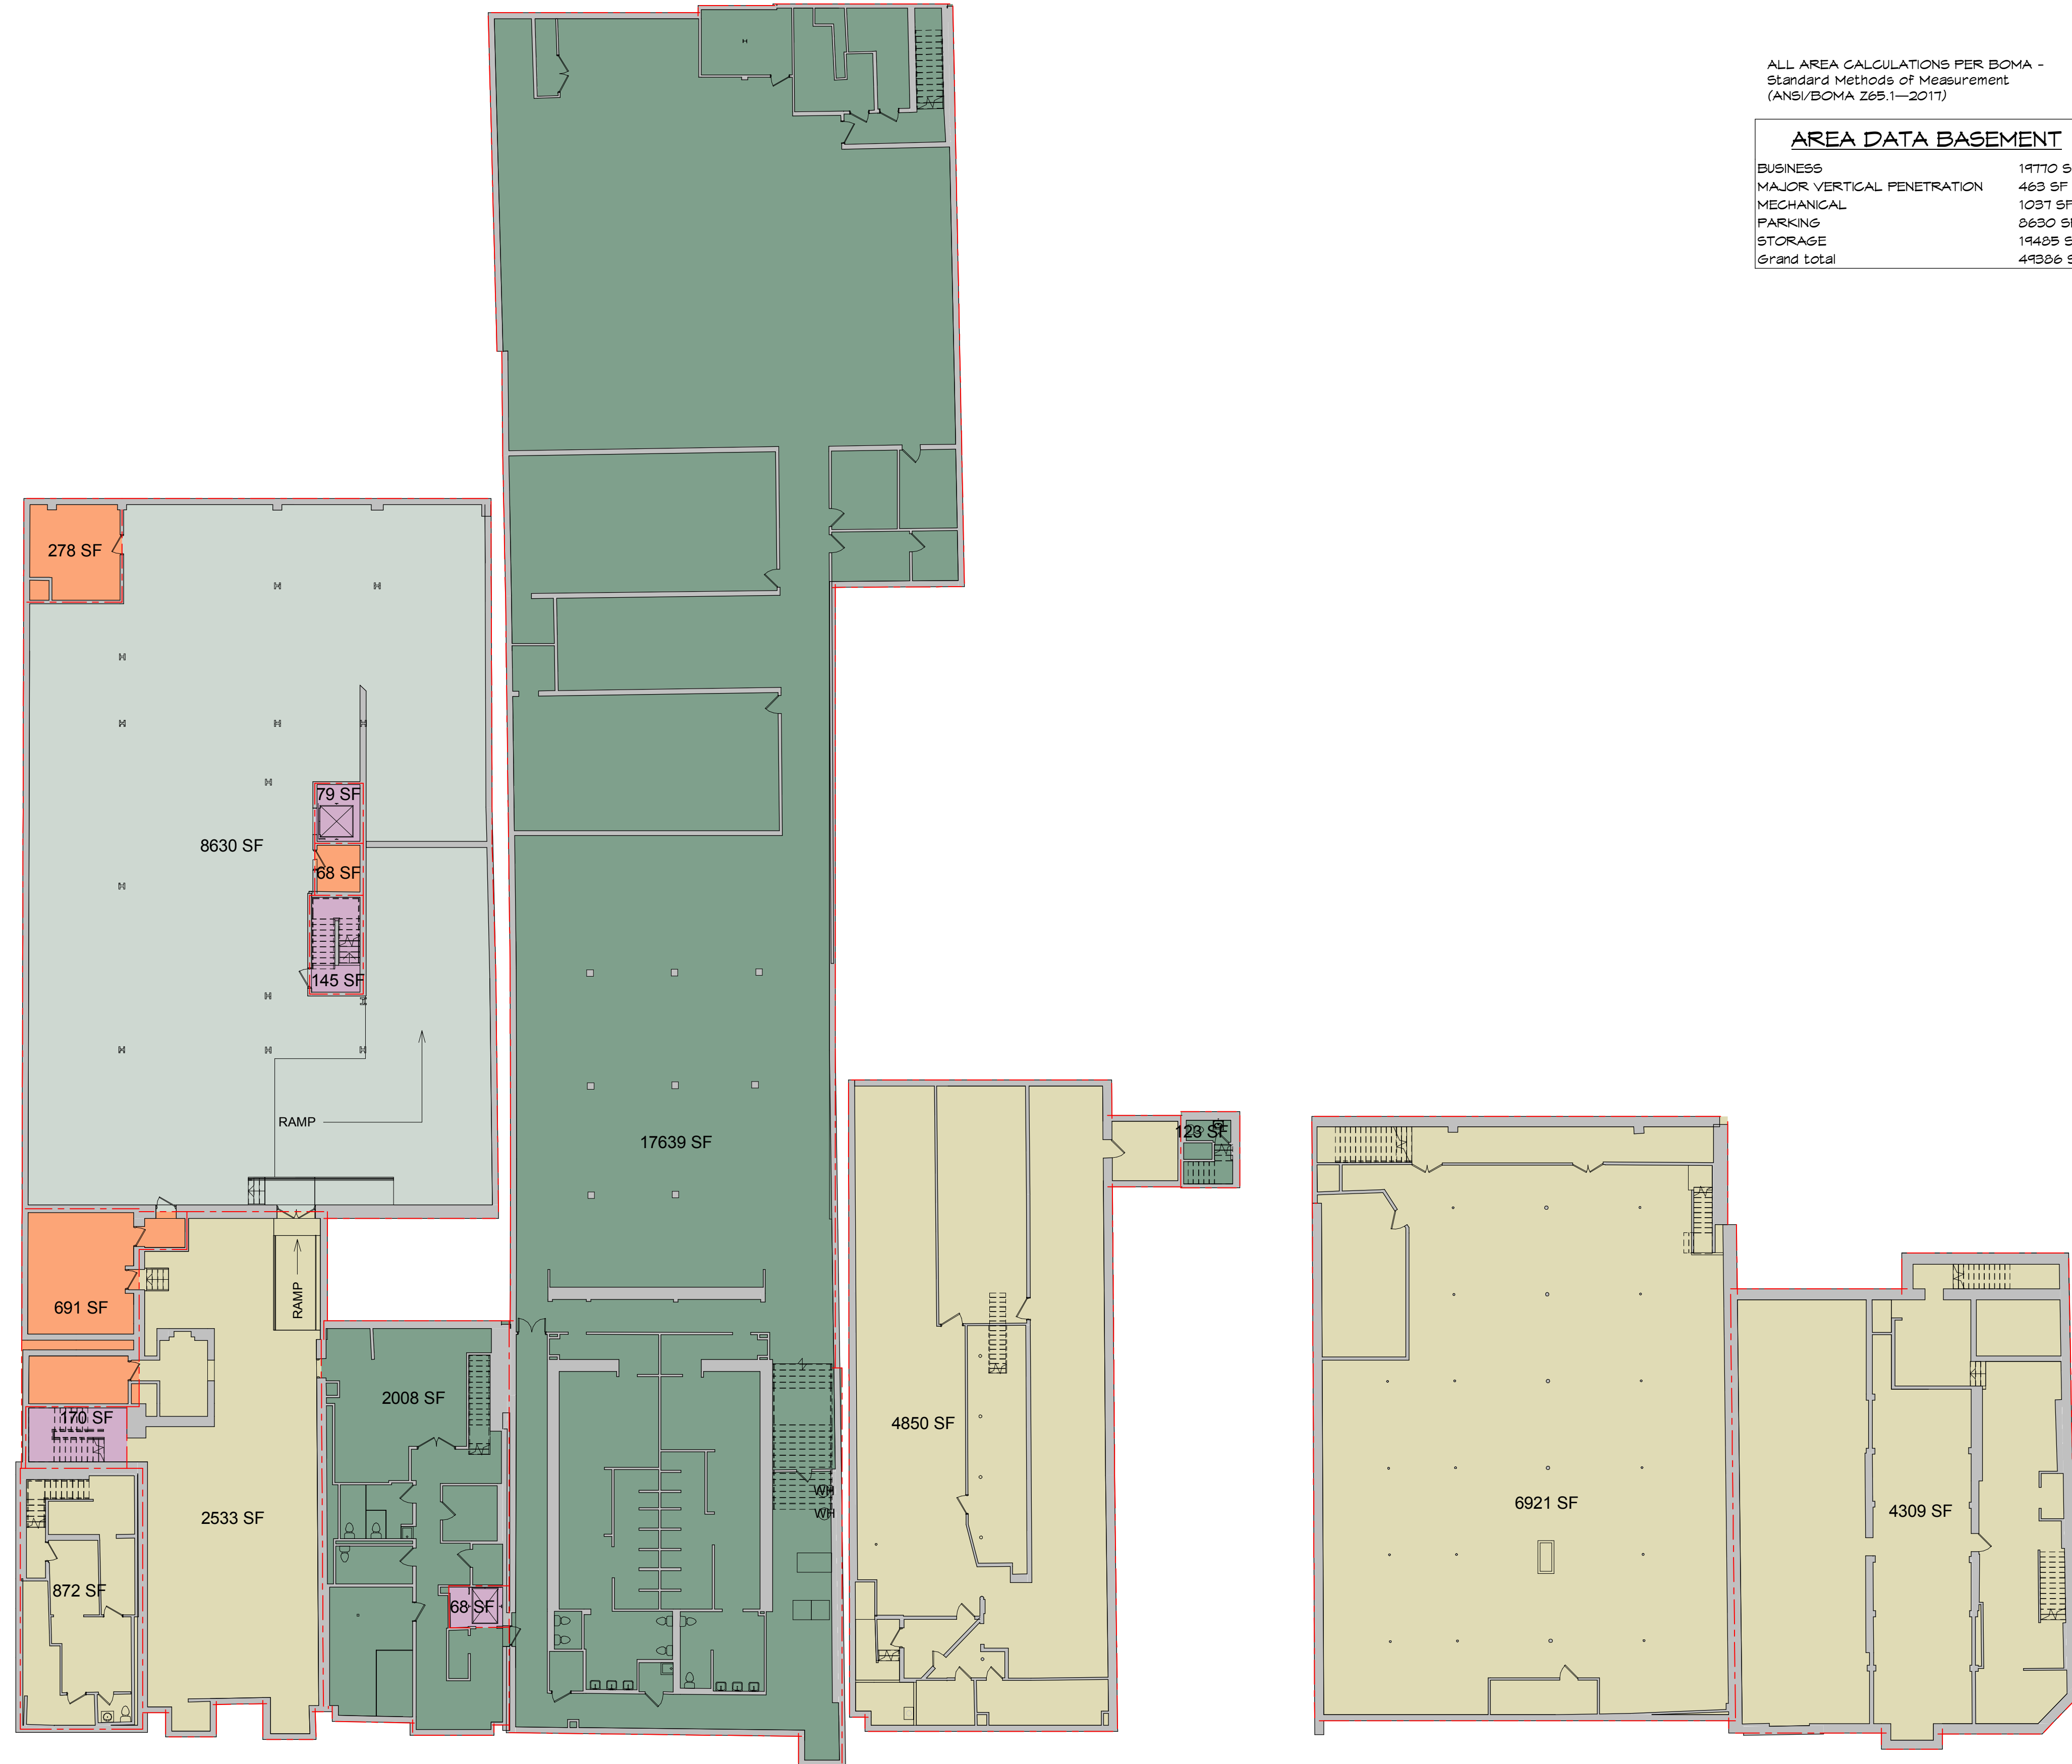

AREA LEGEND

- BUSINESS
- MAJOR VERTICAL PENETRATION
- MECHANICAL
- PARKING
- STORAGE

ALL AREA CALCULATIONS PER BOMA -  
Standard Methods of Measurement  
(ANSI/BOMA Z65.1-2017)

AREA DATA BASEMENT	
BUSINESS	19770 SF
MAJOR VERTICAL PENETRATION	463 SF
MECHANICAL	1037 SF
PARKING	8630 SF
STORAGE	19485 SF
<b>Grand Total</b>	<b>49385 SF</b>



© 2020 AEC CONSULTANTS INC

# ARCHITECTURAL AS BUILT

## Cambridge, MA 02139


NO.	ISSUES / REVISIONS	DATE	SHEET TITLE
01	100% SUBMISSION		SEE COVER SHEET

### BASEMENT

Designer	PROJECT MANAGER
Designer	PROJECT DIRECTOR
Project Number	PROJECT NUMBER
Author	DRAWN BY
	SHEET NUMBER

## AB-0

1 Basement  
1/16" = 1'-0"

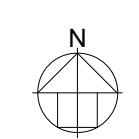


**AREA LEGEND**


- BUSINESS
- COMMON AREA
- MAJOR VERTICAL PENETRATION
- MECHANICAL
- PARKING

ALL AREA CALCULATIONS PER BOMA -  
 Standard Methods of Measurement  
 (ANSI/BOMA Z65.1-2017)

AREA DATA LEVEL 1	
BUSINESS	44832 SF
COMMON AREA	2465 SF
MAJOR VERTICAL PENETRATION	787 SF
MECHANICAL	823 SF
PARKING	3410 SF
<b>Grand Total</b>	<b>52317 SF</b>

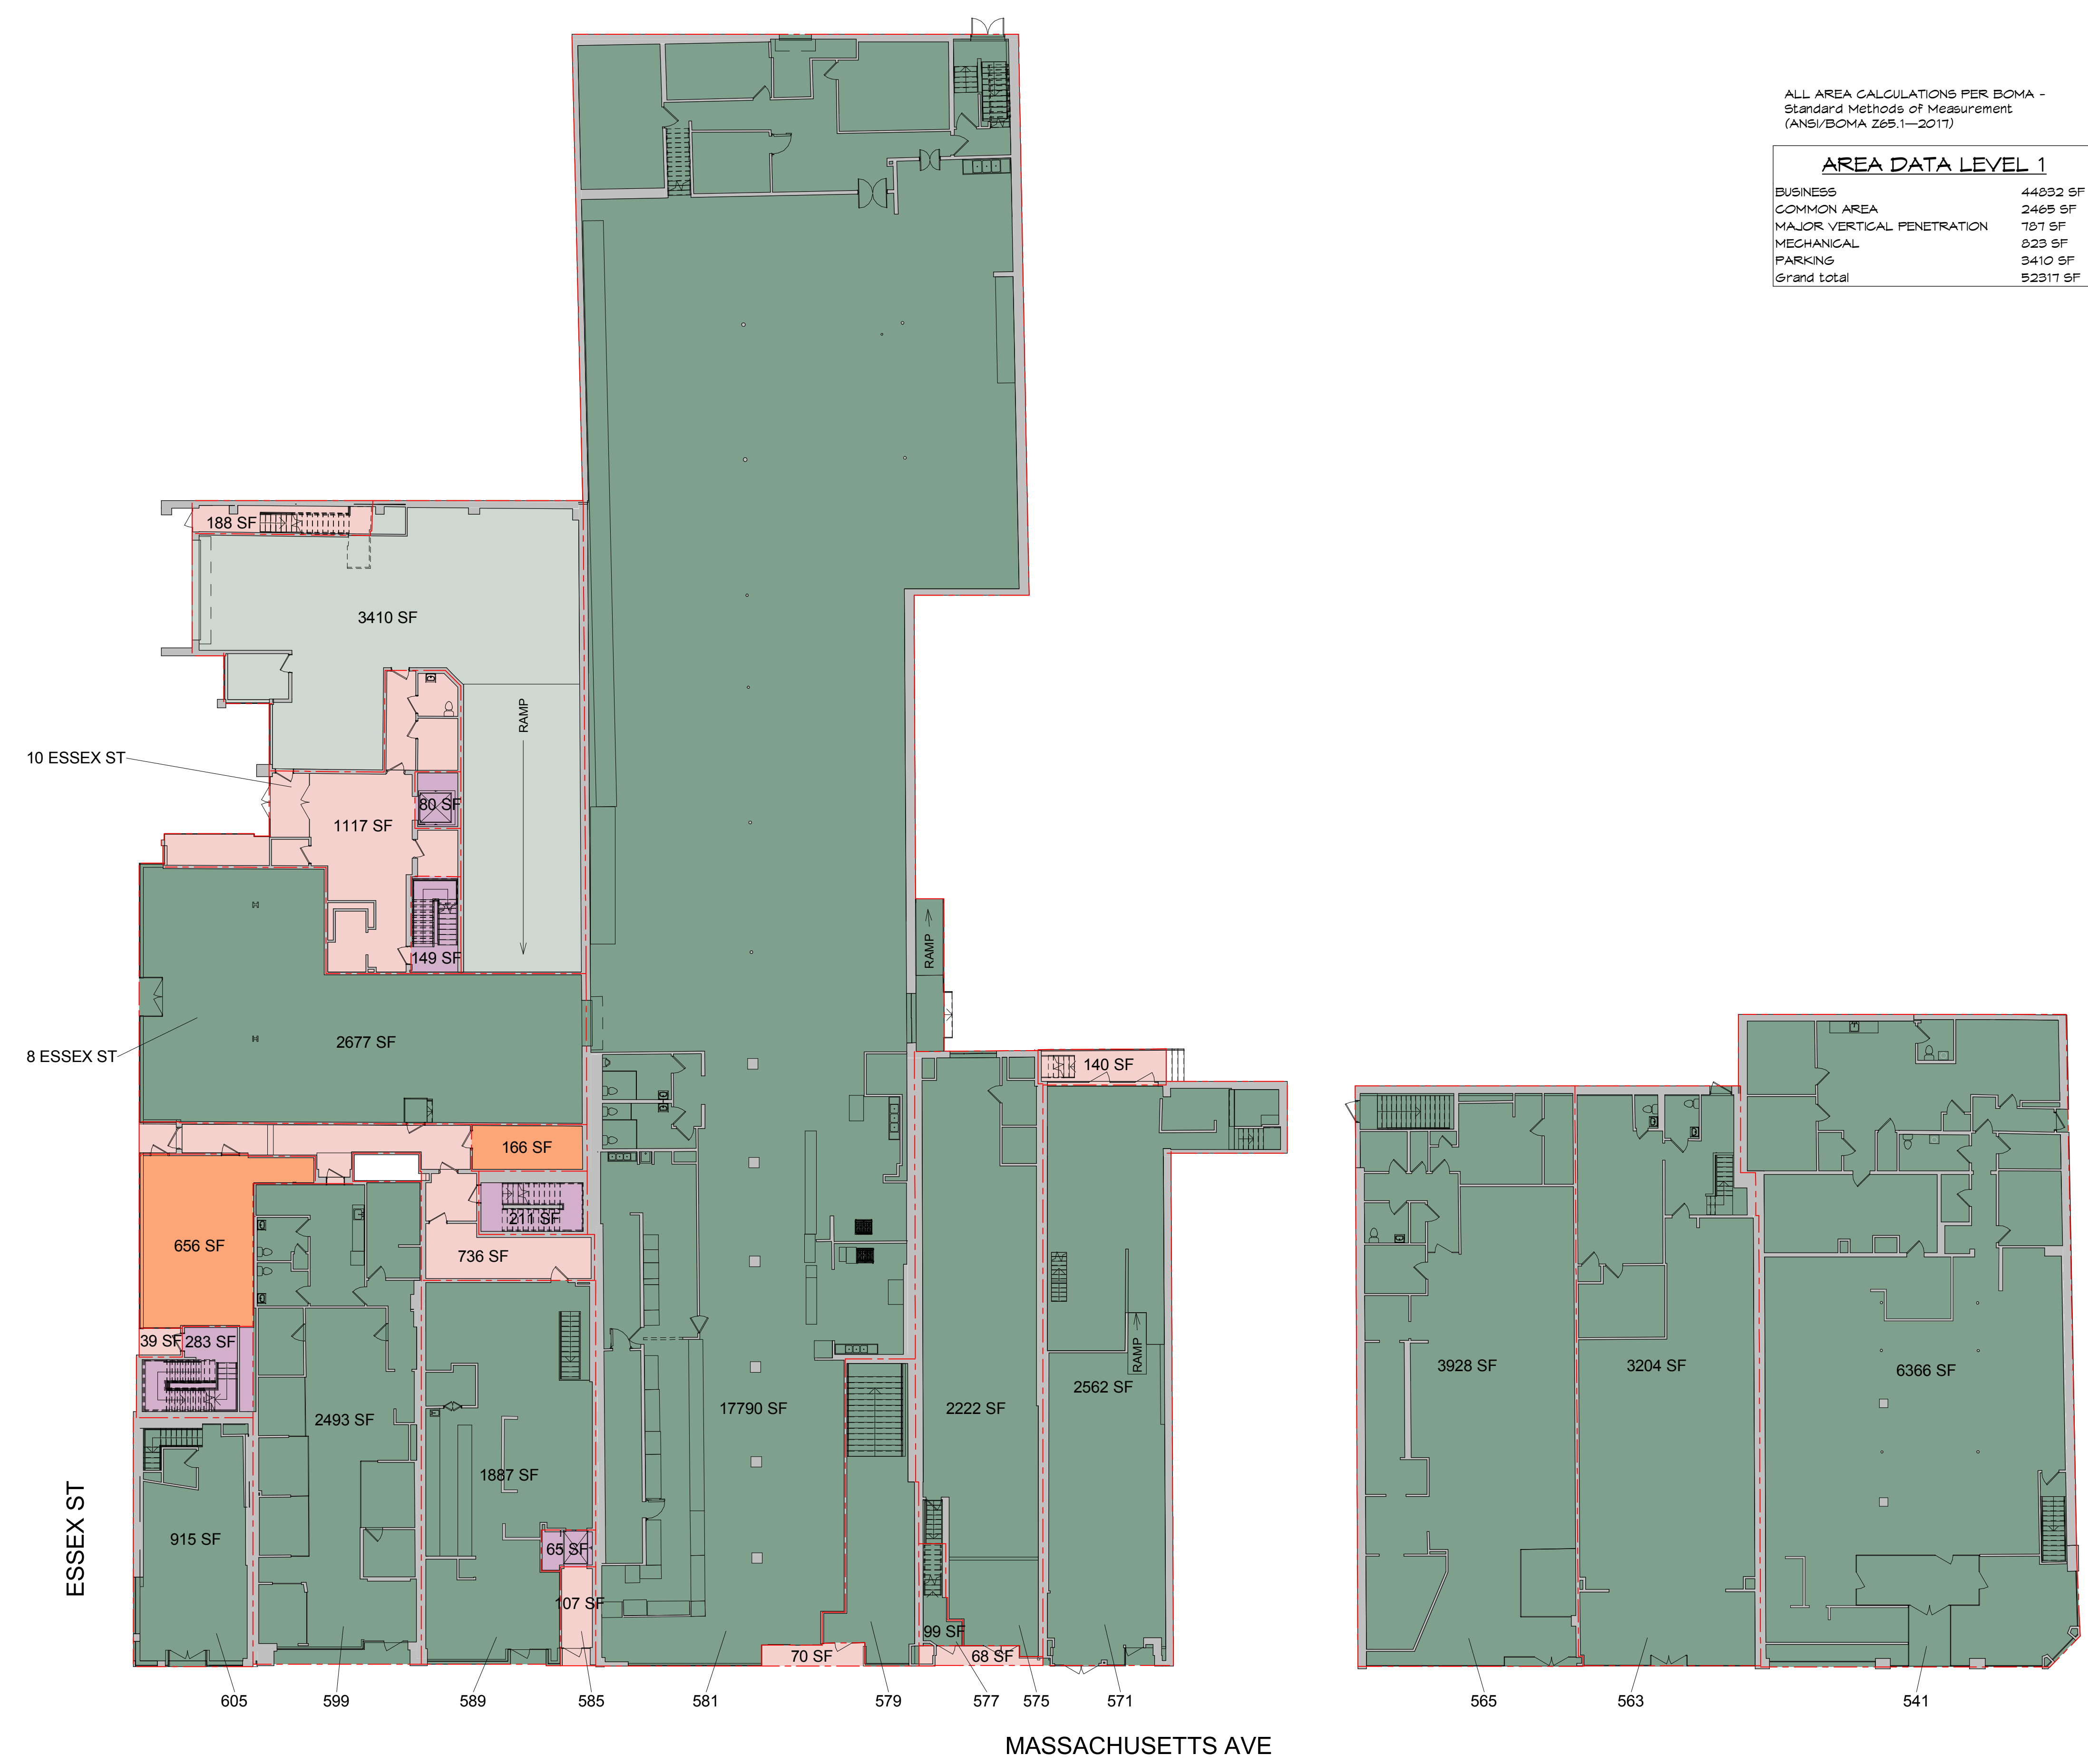

① Level 1  
 1/16" = 1'-0"

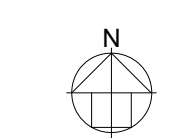


**ARCHITECTURAL AS BUILT**  
**Cambridge, MA 02139**

01	100% SUBMISSION	SEE COVER SHEET
NO.	ISSUES / REVISIONS	DATE
SHEET TITLE		

**FIRST FLOOR**

Designer	PROJECT MANAGER
Designer	PROJECT DIRECTOR
Project Number	PROJECT NUMBER
Author	DRAWN BY
	SHEET NUMBER

**AB-1**

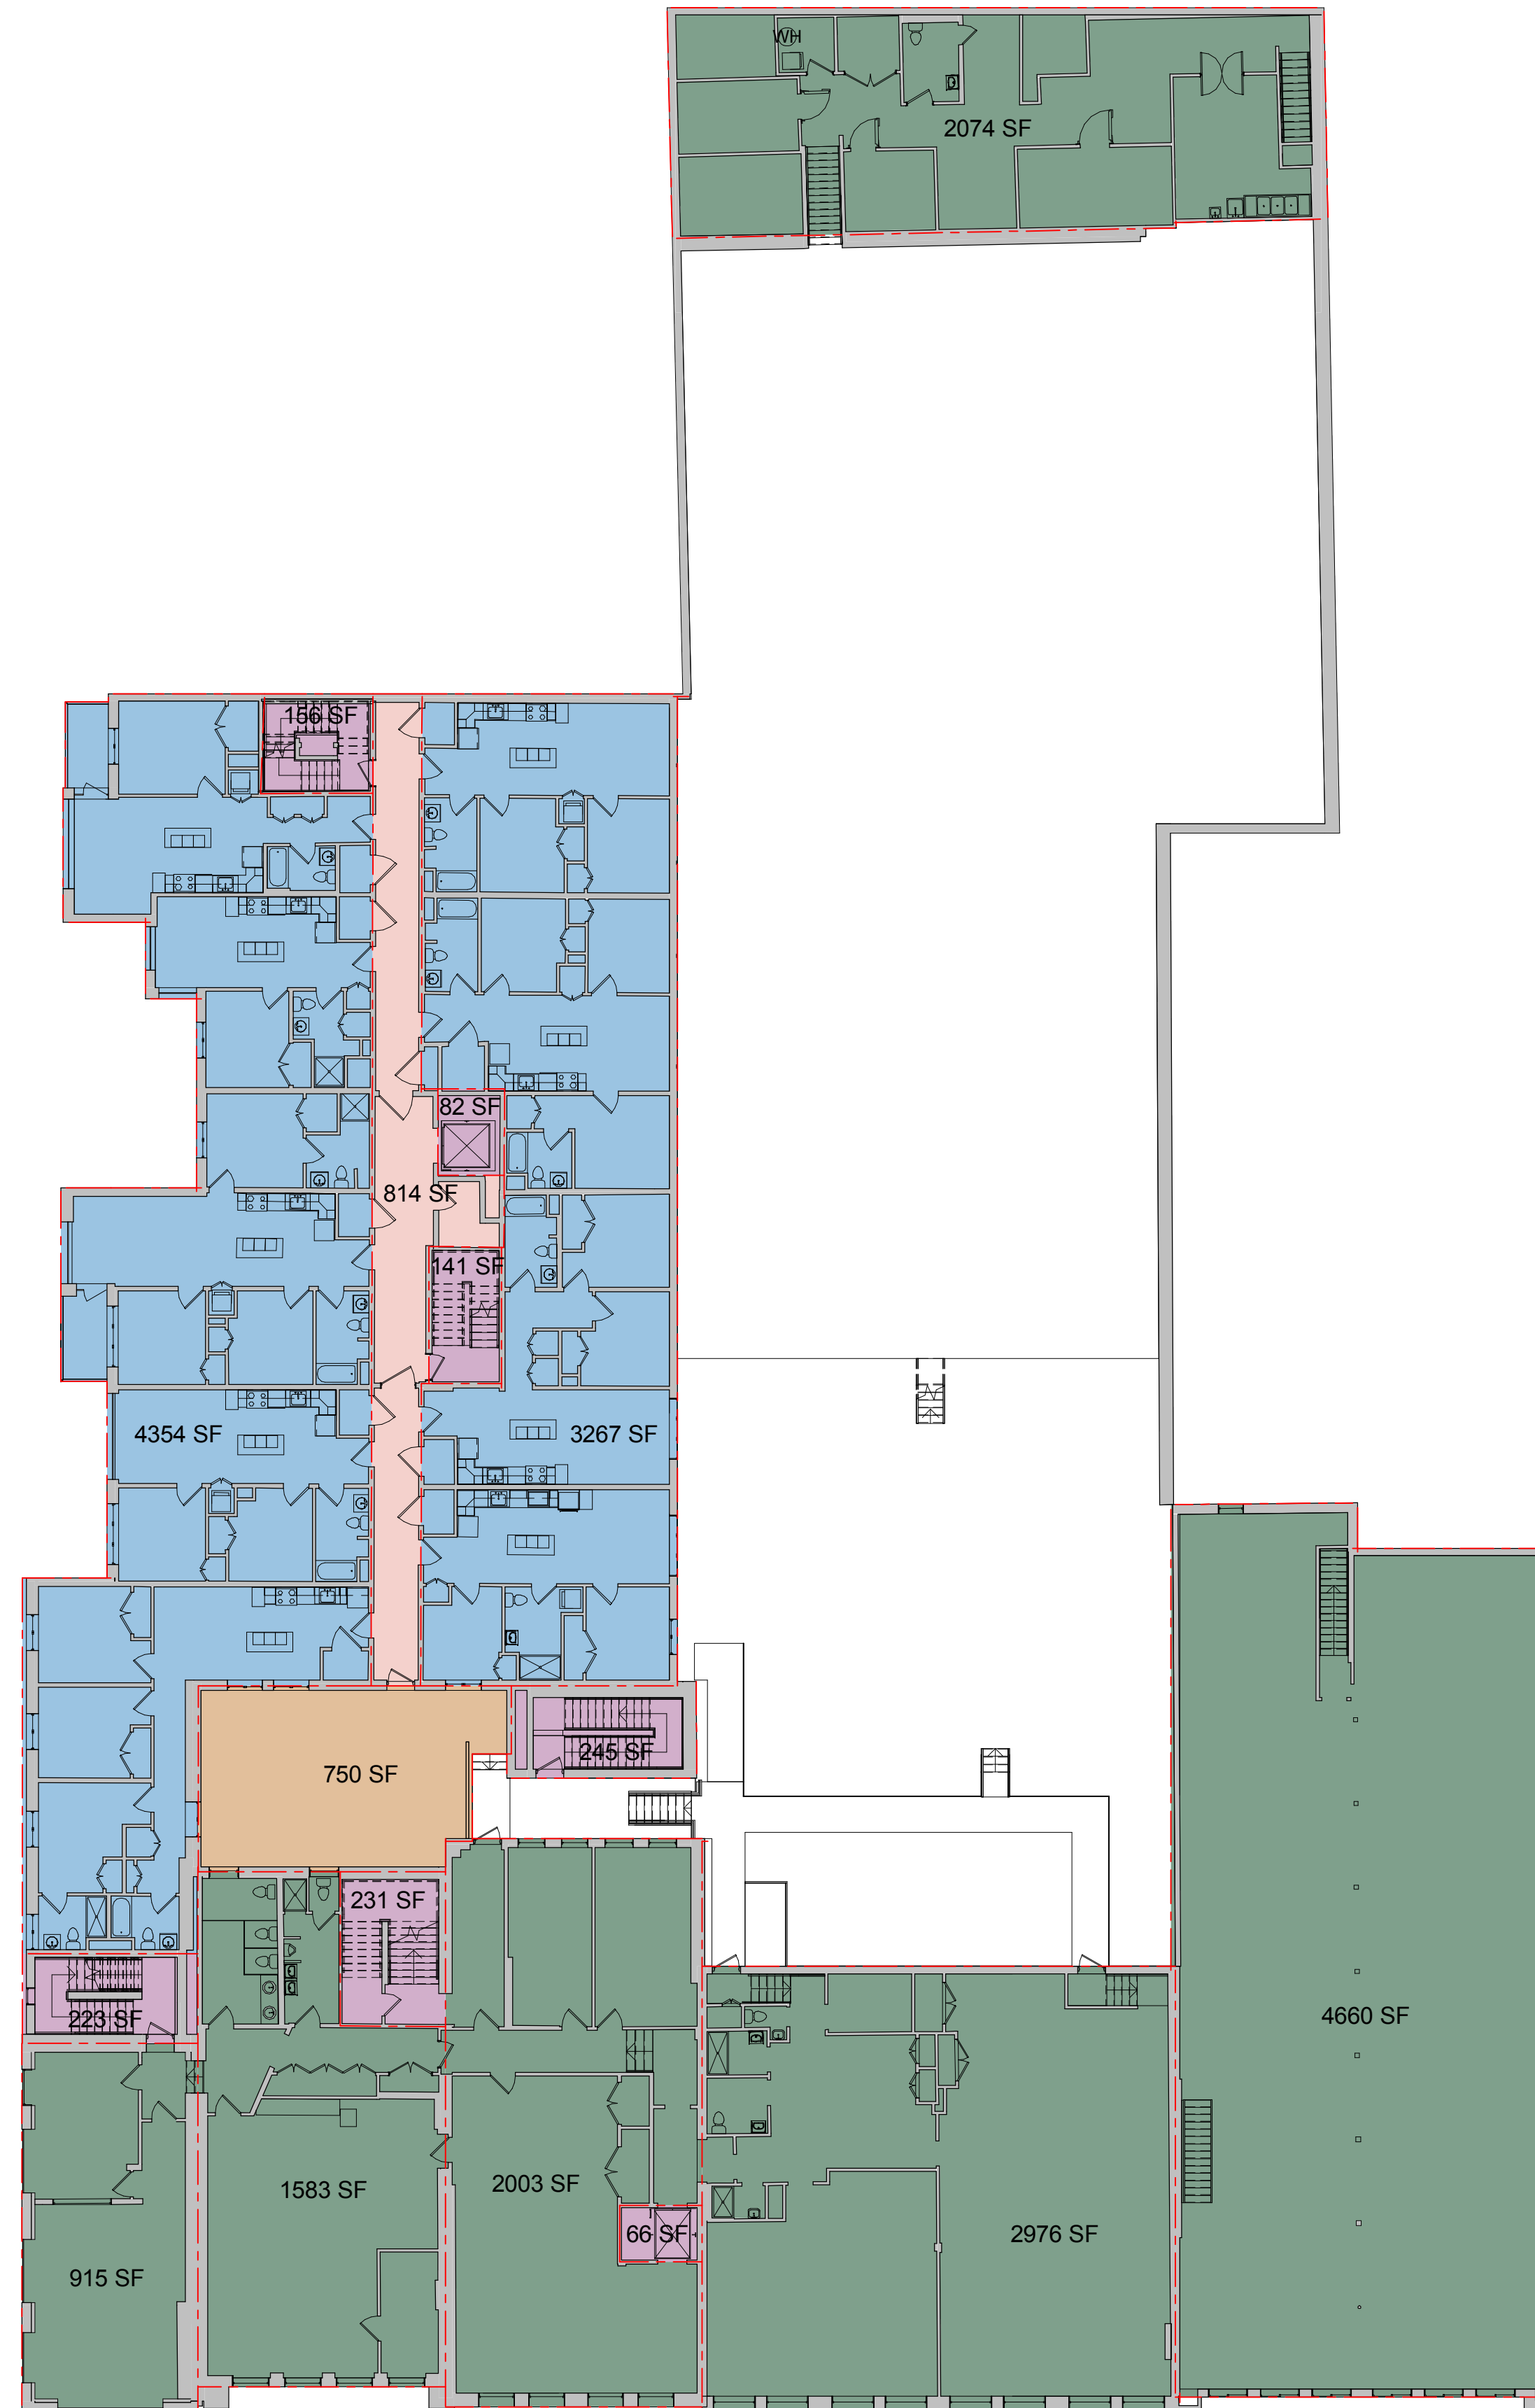

ALL AREA CALCULATIONS PER BOMA -  
Standard Methods of Measurement  
(ANSI/BOMA Z65.1-2017)

AREA DATA LEVEL 2	
BUSINESS	14210 SF
COMMON AREA	814 SF
MAJOR VERTICAL PENETRATION	1144 SF
RESIDENTIAL	7621 SF
SHARED AMENITY	750 SF
Grand Total	24539 SF

AREA LEGEND

- BUSINESS
- COMMON AREA
- MAJOR VERTICAL PENETRATION
- RESIDENTIAL
- SHARED AMENITY



© 2020 AEC CONSULTANTS INC

**ARCHITECTURAL AS BUILT**  
**Cambridge, MA 02139**


01	100% SUBMISSION	SEE COVER SHEET
NO.	ISSUES / REVISIONS	DATE


**SECOND FLOOR**

Designer	PROJECT MANAGER
Designer	PROJECT DIRECTOR
Project Number	PROJECT NUMBER
Author	DRAWN BY
	SHEET NUMBER

**AB-2**

① Level 2  
1/16" = 1'-0"

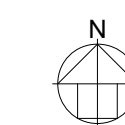

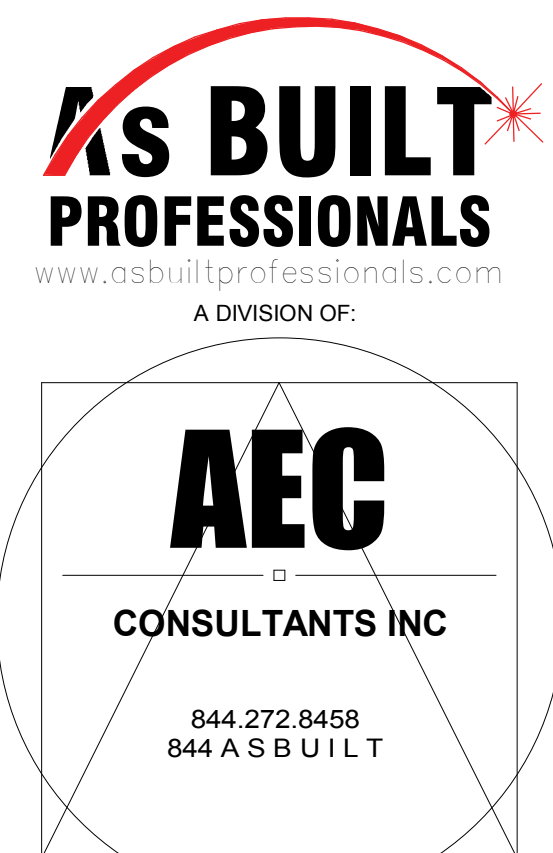


© 2020 AEC CONSULTANTS INC

AREA LEGEND

- BUSINESS
- COMMON AREA
- MAJOR VERTICAL PENETRATION
- RESIDENTIAL

ALL AREA CALCULATIONS PER BOMA - Standard Methods of Measurement (ANSI/BOMA Z65.1-2017)

AREA DATA LEVEL 3	
BUSINESS	4660 SF
COMMON AREA	737 SF
MAJOR VERTICAL PENETRATION	820 SF
RESIDENTIAL	8016 SF
<b>Grand Total</b>	<b>14233 SF</b>

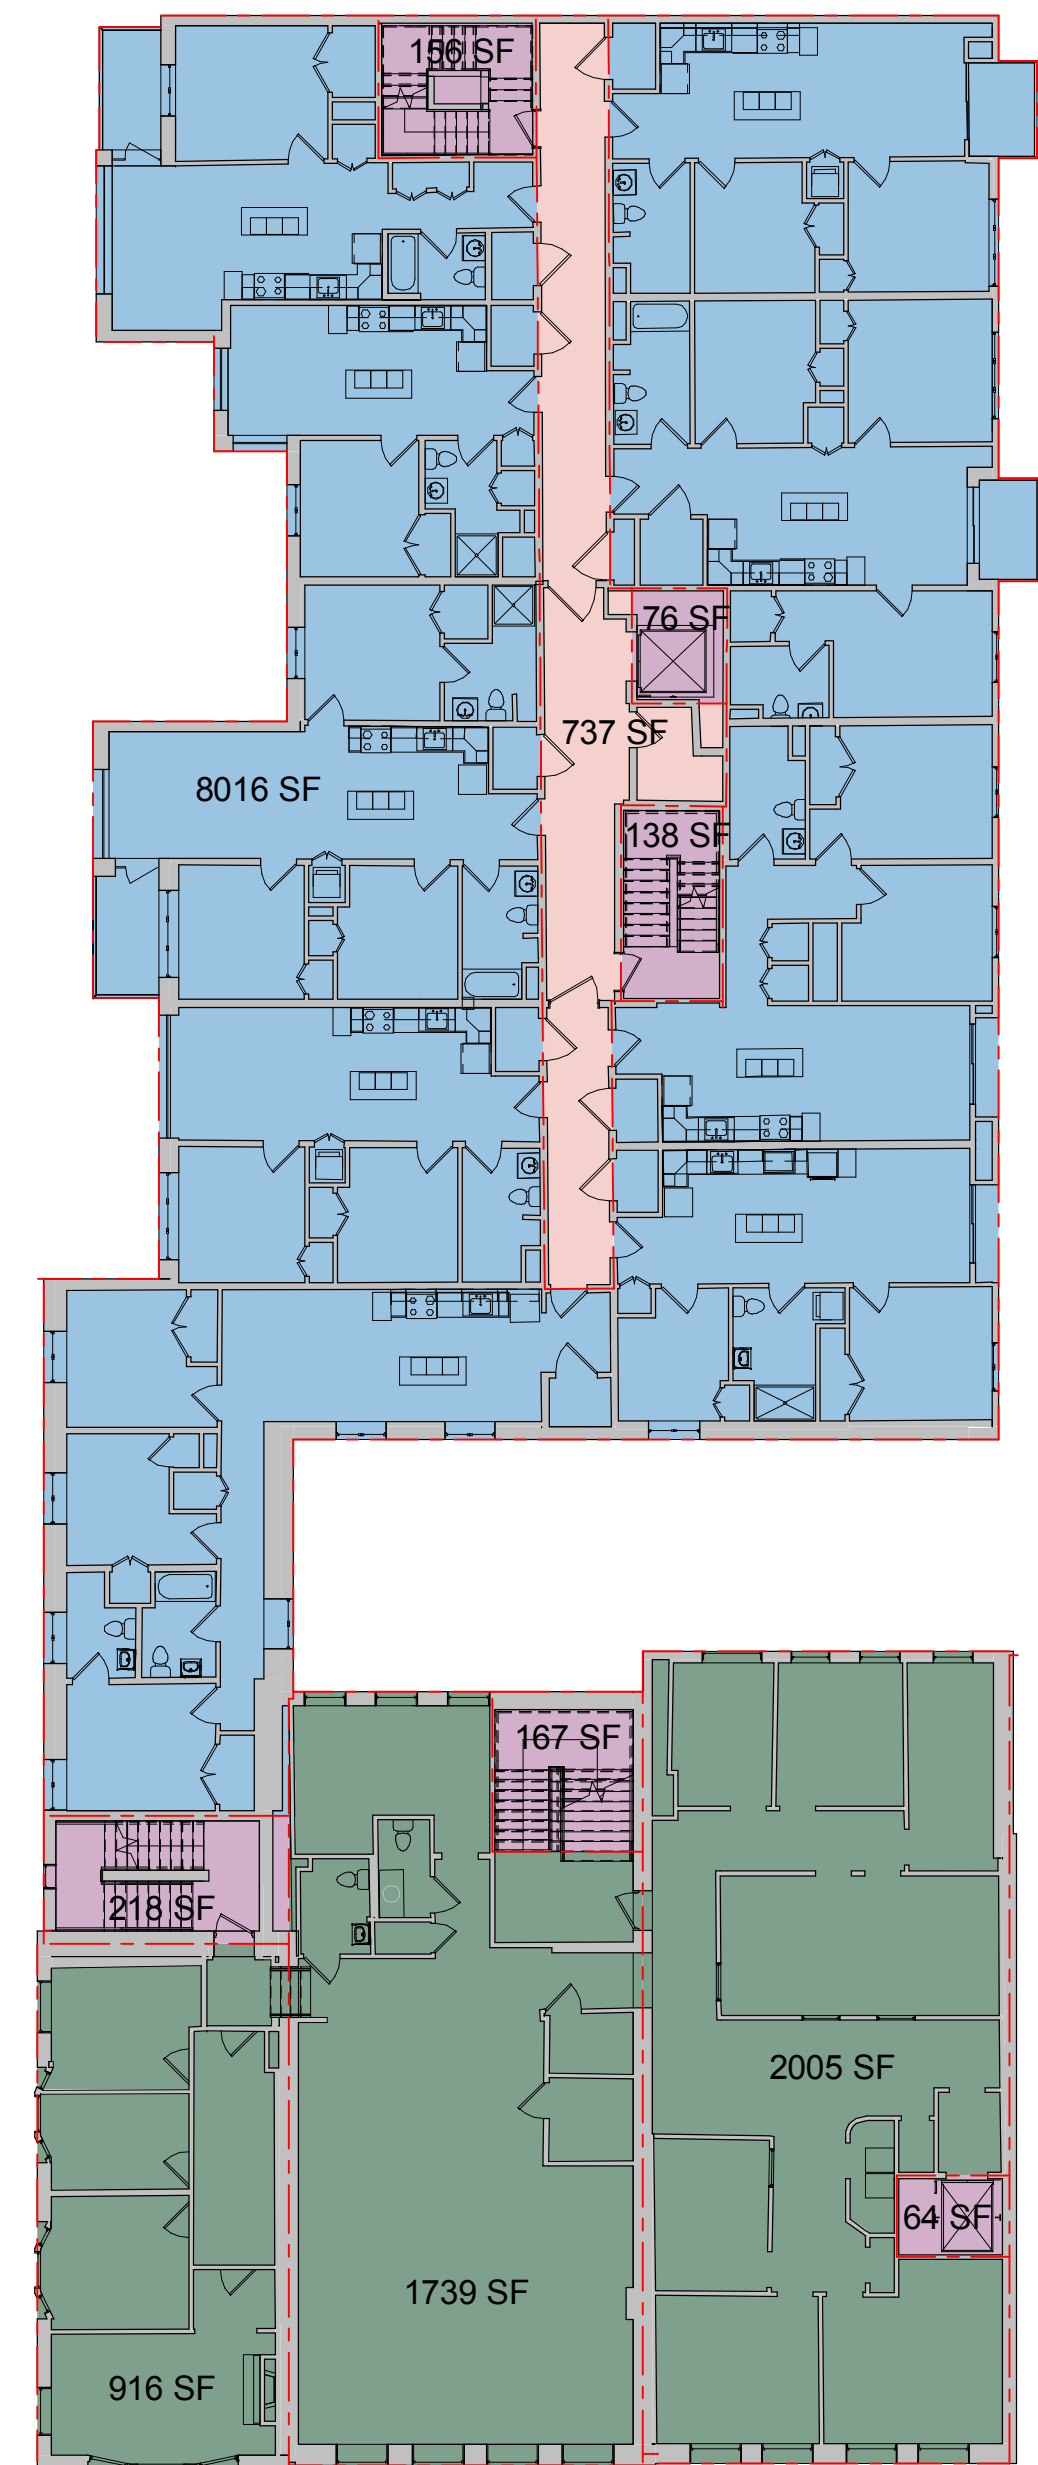

**ARCHITECTURAL AS BUILT**

**Cambridge, MA 02139**


NO.	ISSUES / REVISIONS	DATE
01	100% SUBMISSION	SEE COVER SHEET

**THIRD FLOOR**

Designer	PROJECT MANAGER
Designer	PROJECT DIRECTOR
Project Number	PROJECT NUMBER
Author	DRAWN BY
	SHEET NUMBER

**AB-3**

① Level 3  
1/16" = 1'-0"

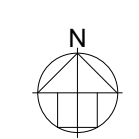

**AREA LEGEND**

- BUSINESS
- COMMON AREA
- MAJOR VERTICAL PENETRATION
- RESIDENTIAL

ALL AREA CALCULATIONS PER BOMA -  
 Standard Methods of Measurement  
 (ANSI/BOMA Z65.1-2017)

**AREA DATA LEVEL 4**







BUSINESS	4671 SF
COMMON AREA	734 SF
MAJOR VERTICAL PENETRATION	822 SF
RESIDENTIAL	8120 SF
Grand total	14347 SF

**AREA DATA LEVEL 5**

COMMON AREA	745 SF
MAJOR VERTICAL PENETRATION	597 SF
RESIDENTIAL	7977 SF
Grand total	9309 SF

**AREA DATA LEVEL 6**

COMMON AREA	748 SF
MAJOR VERTICAL PENETRATION	376 SF
RESIDENTIAL	6825 SF
Grand total	7950 SF

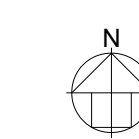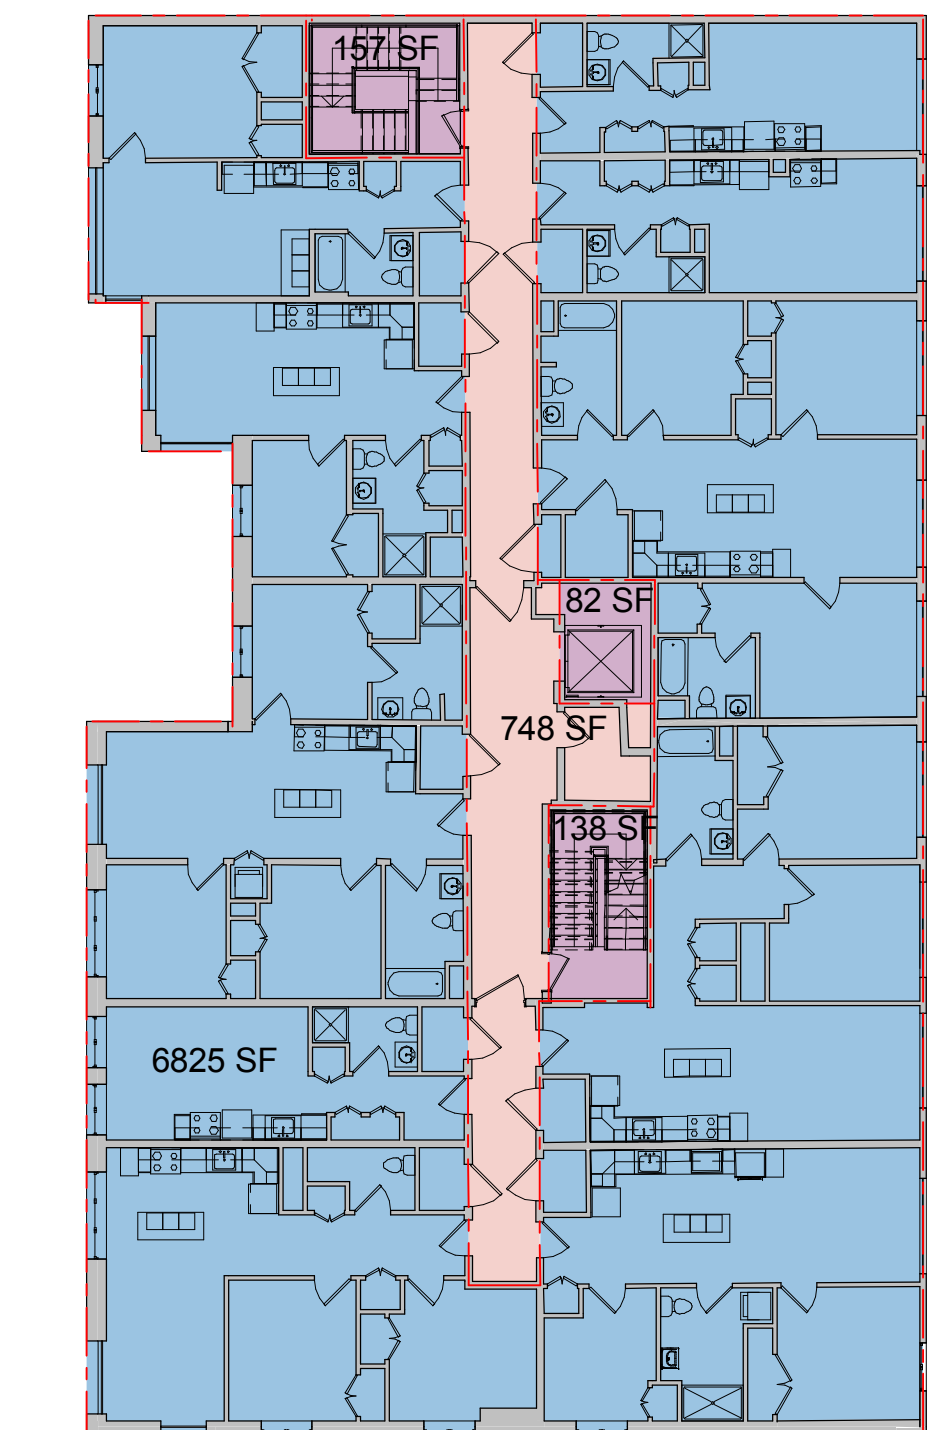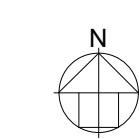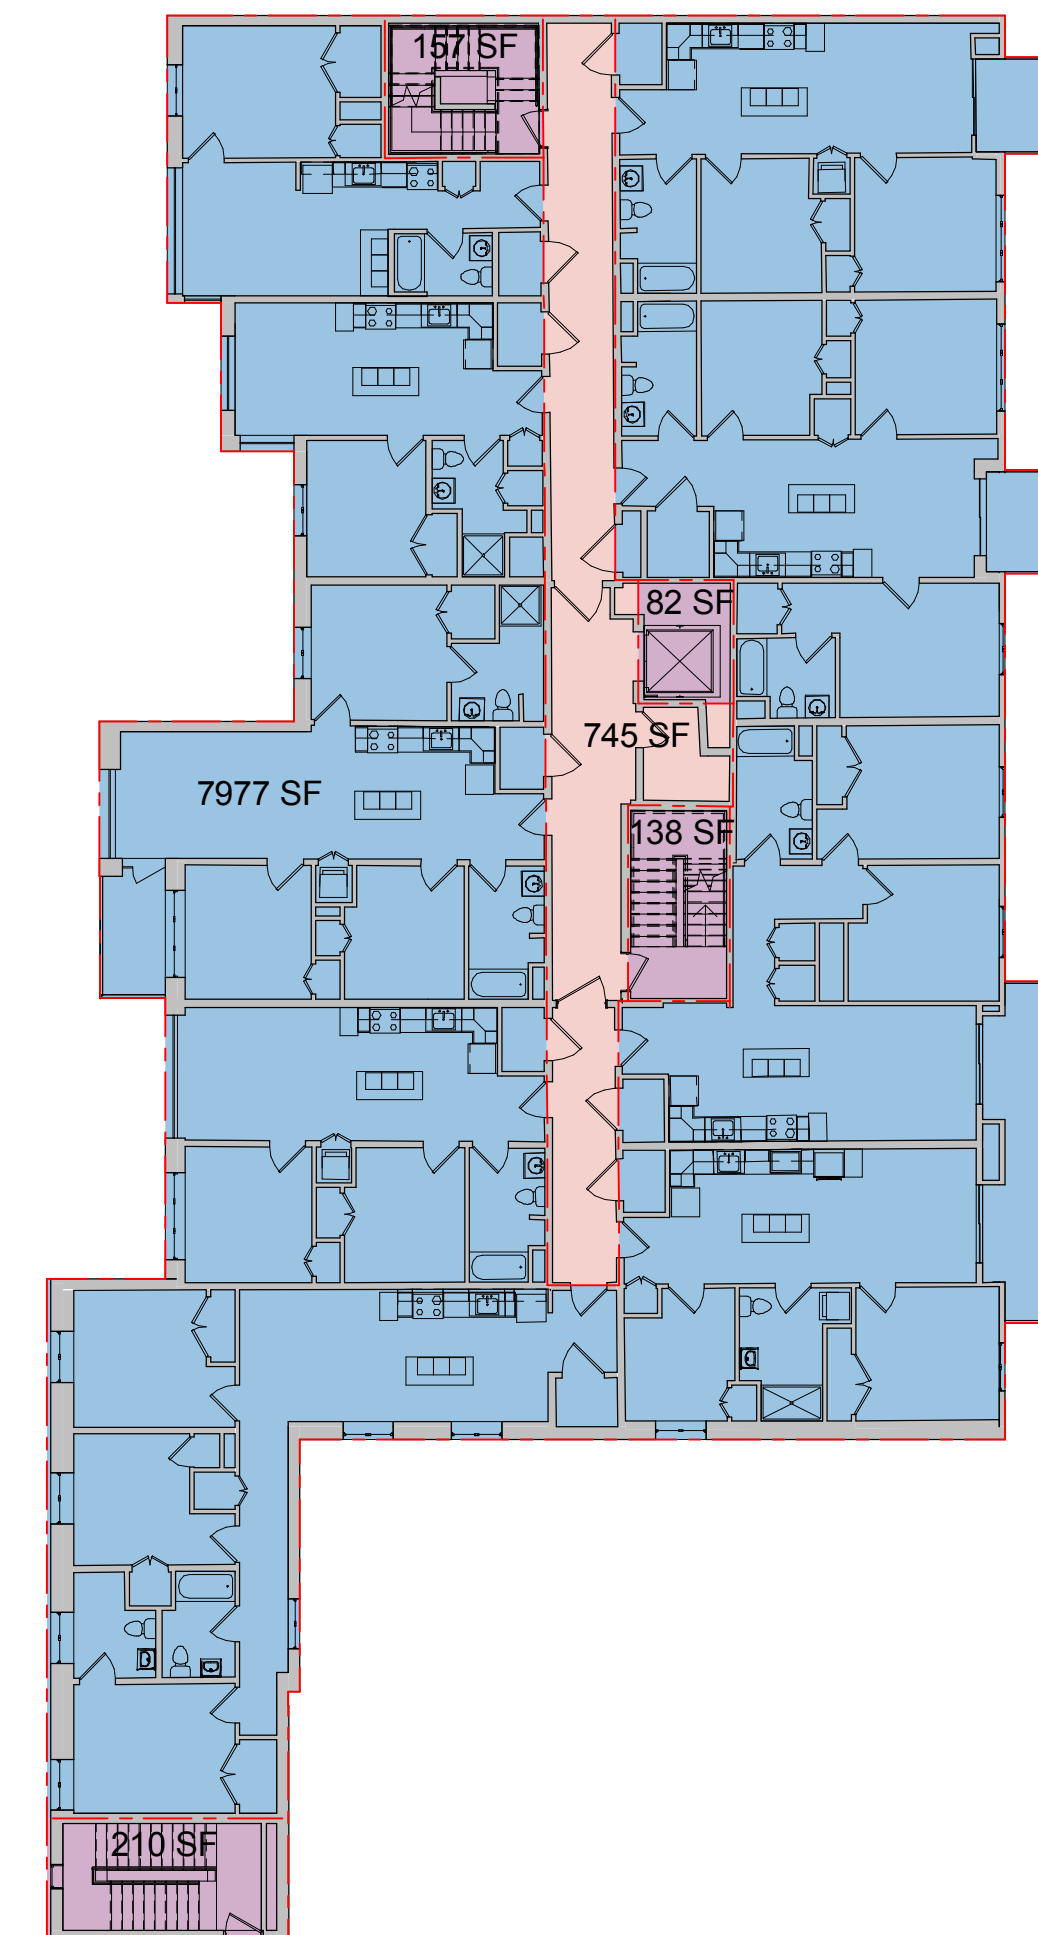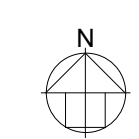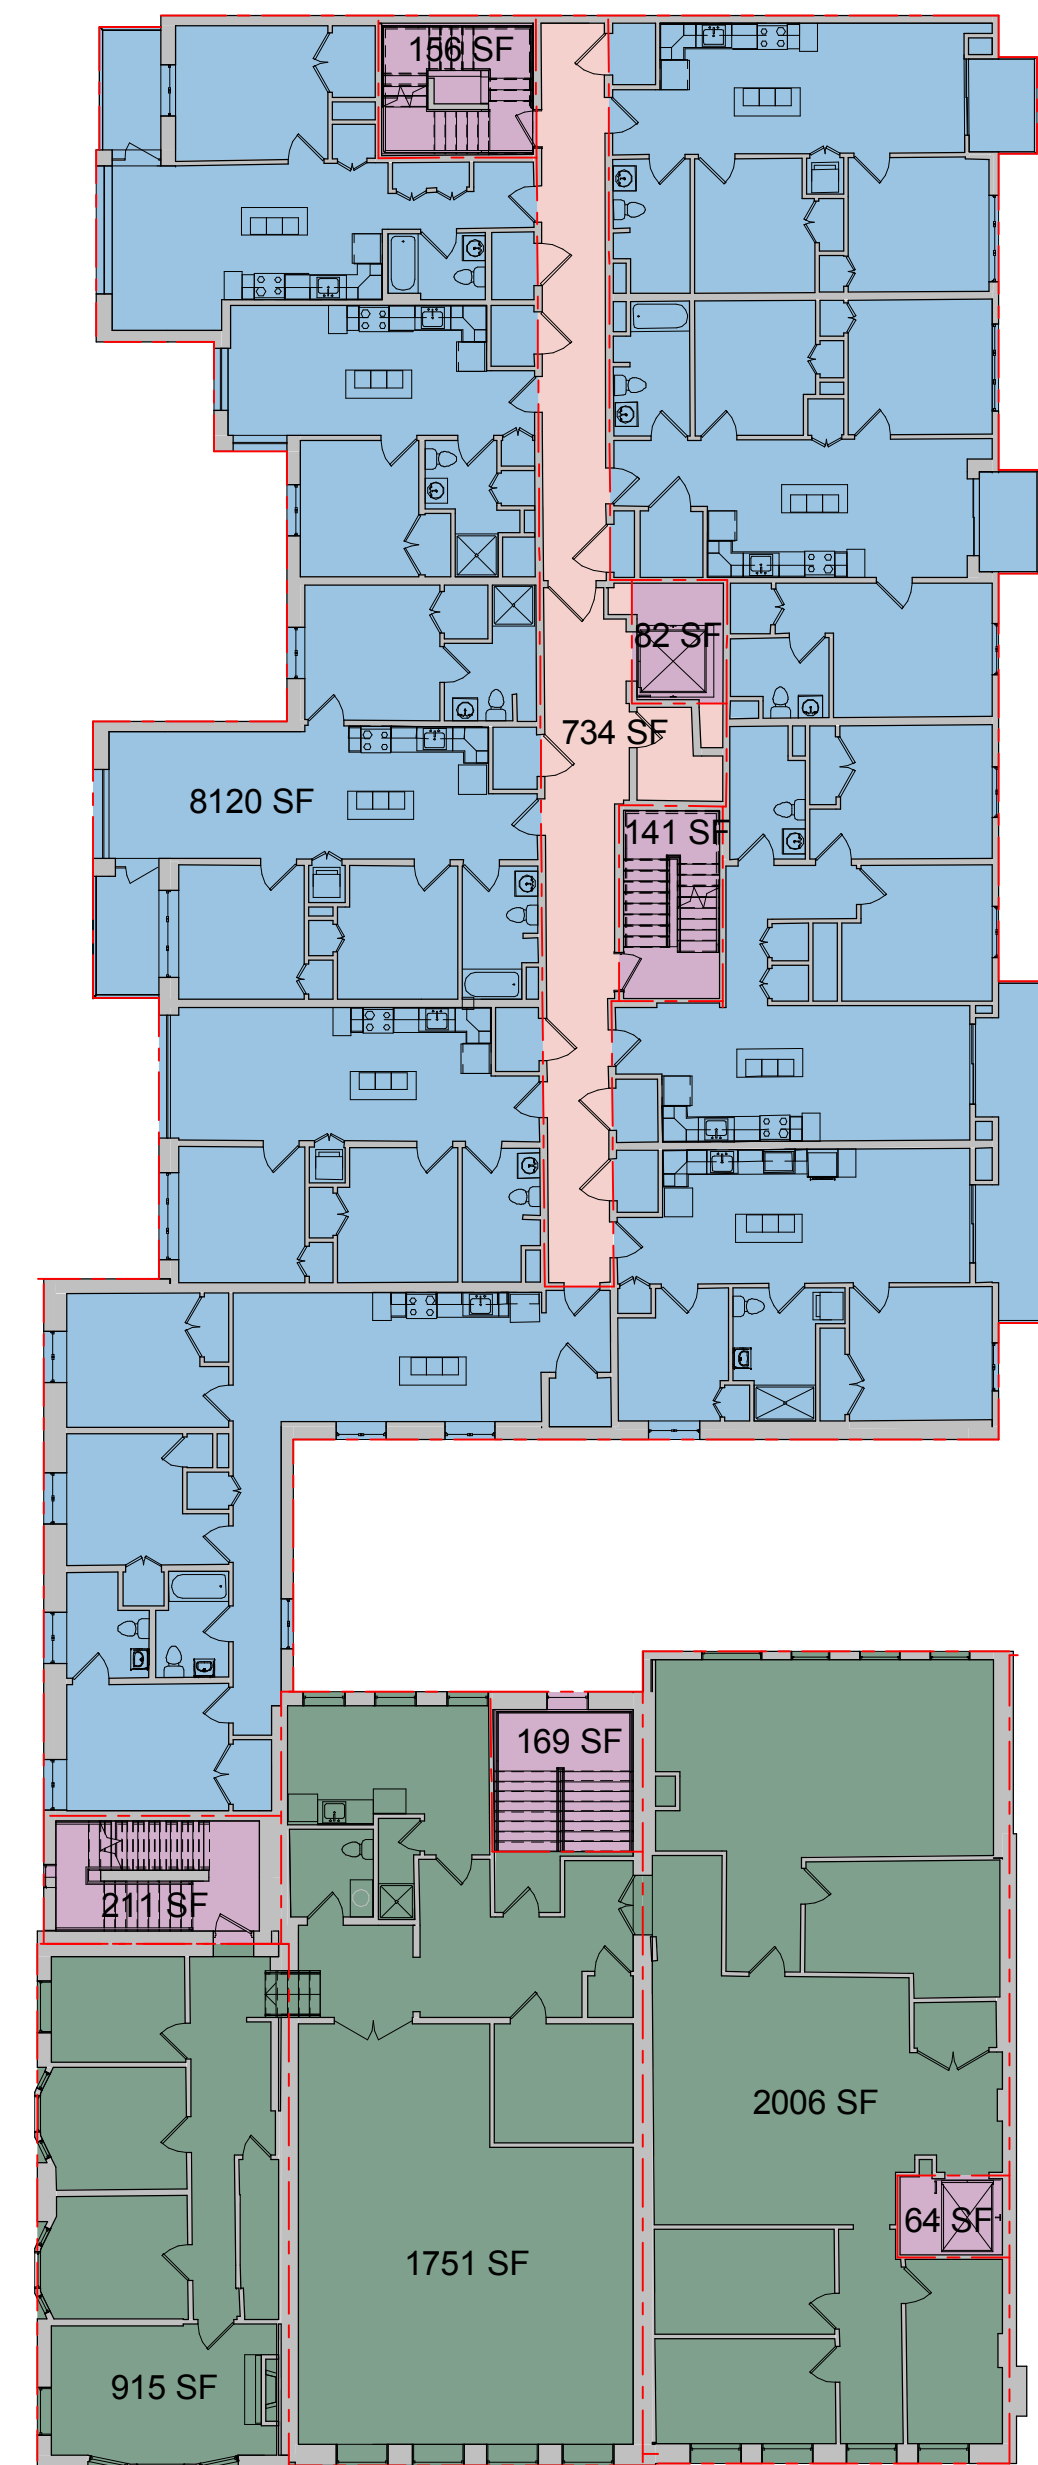

① Level 4  
 1/16" = 1'-0"

② Level 5  
 1/16" = 1'-0"

③ Level 6  
 1/16" = 1'-0"


**ARCHITECTURAL AS BUILT**  
**Cambridge, MA 02139**

01	100% SUBMISSION	SEE COVER SHEET
NO.	ISSUES / REVISIONS	DATE
SHEET TITLE		

**4TH, 5TH, & 6TH FLOORS**

Designer	PROJECT MANAGER
Designer	PROJECT DIRECTOR
Project Number	PROJECT NUMBER
Author	DRAWN BY
	SHEET NUMBER

**AB-4**

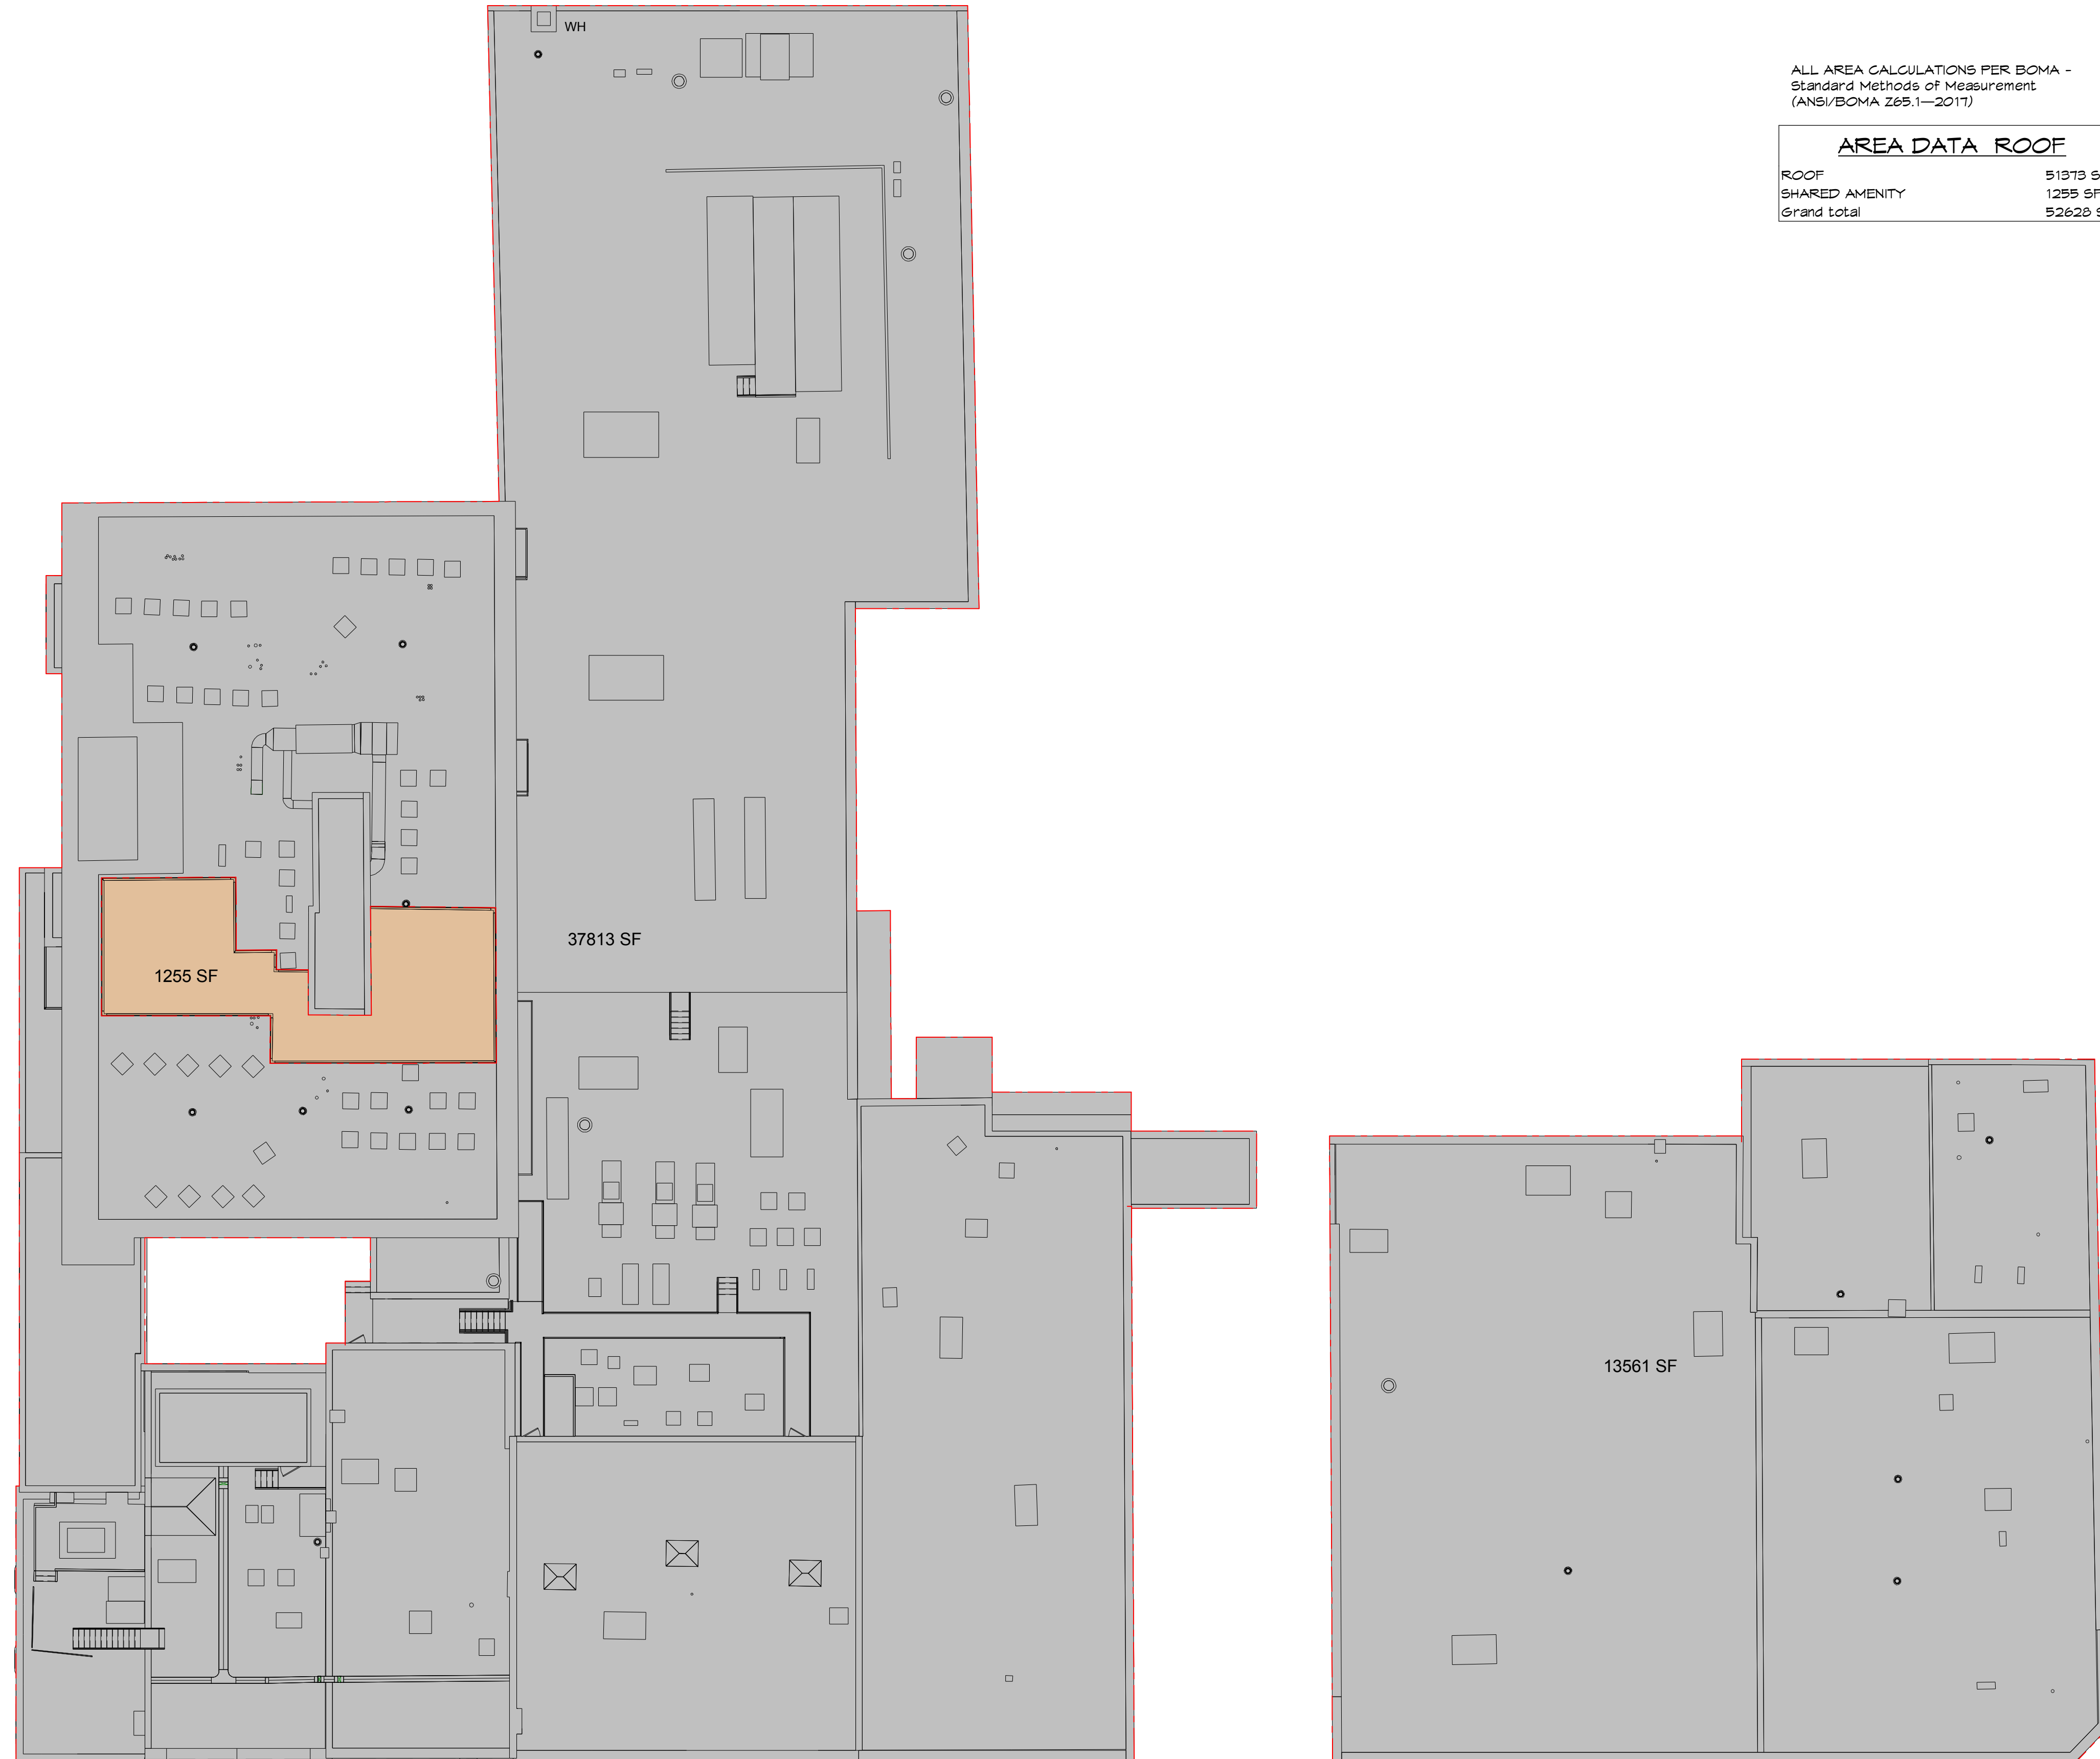

AREA LEGEND  
 ■ ROOF  
 ■ SHARED AMENITY

ALL AREA CALCULATIONS PER BOMA -  
 Standard Methods of Measurement  
 (ANSI/BOMA Z65.1-2017)

AREA DATA ROOF	
ROOF	51373 SF
SHARED AMENITY	1255 SF
Grand Total	52628 SF



© 2020 AEC CONSULTANTS INC

**ARCHITECTURAL AS BUILT**  
**Cambridge, MA 02139**


NO.	ISSUES / REVISIONS	DATE
01	100% SUBMISSION	SEE COVER SHEET

NO. ISSUES / REVISIONS DATE

**ROOF PLAN**

Designer	PROJECT MANAGER
Designer	PROJECT DIRECTOR
Project Number	PROJECT NUMBER
Author	DRAWN BY
	SHEET NUMBER

**AB-6**

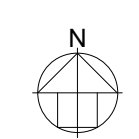






**ARCHITECTURAL AS BUILT**

**Cambridge, MA 02139**

NO.	ISSUES / REVISIONS	DATE
01	100% SUBMISSION	SEE COVER SHEET

**3D EXTERIOR ELEVATIONS**

Designer	PROJECT MANAGER
Designer	PROJECT DIRECTOR
Project Number	PROJECT NUMBER
Author	DRAWN BY
	SHEET NUMBER

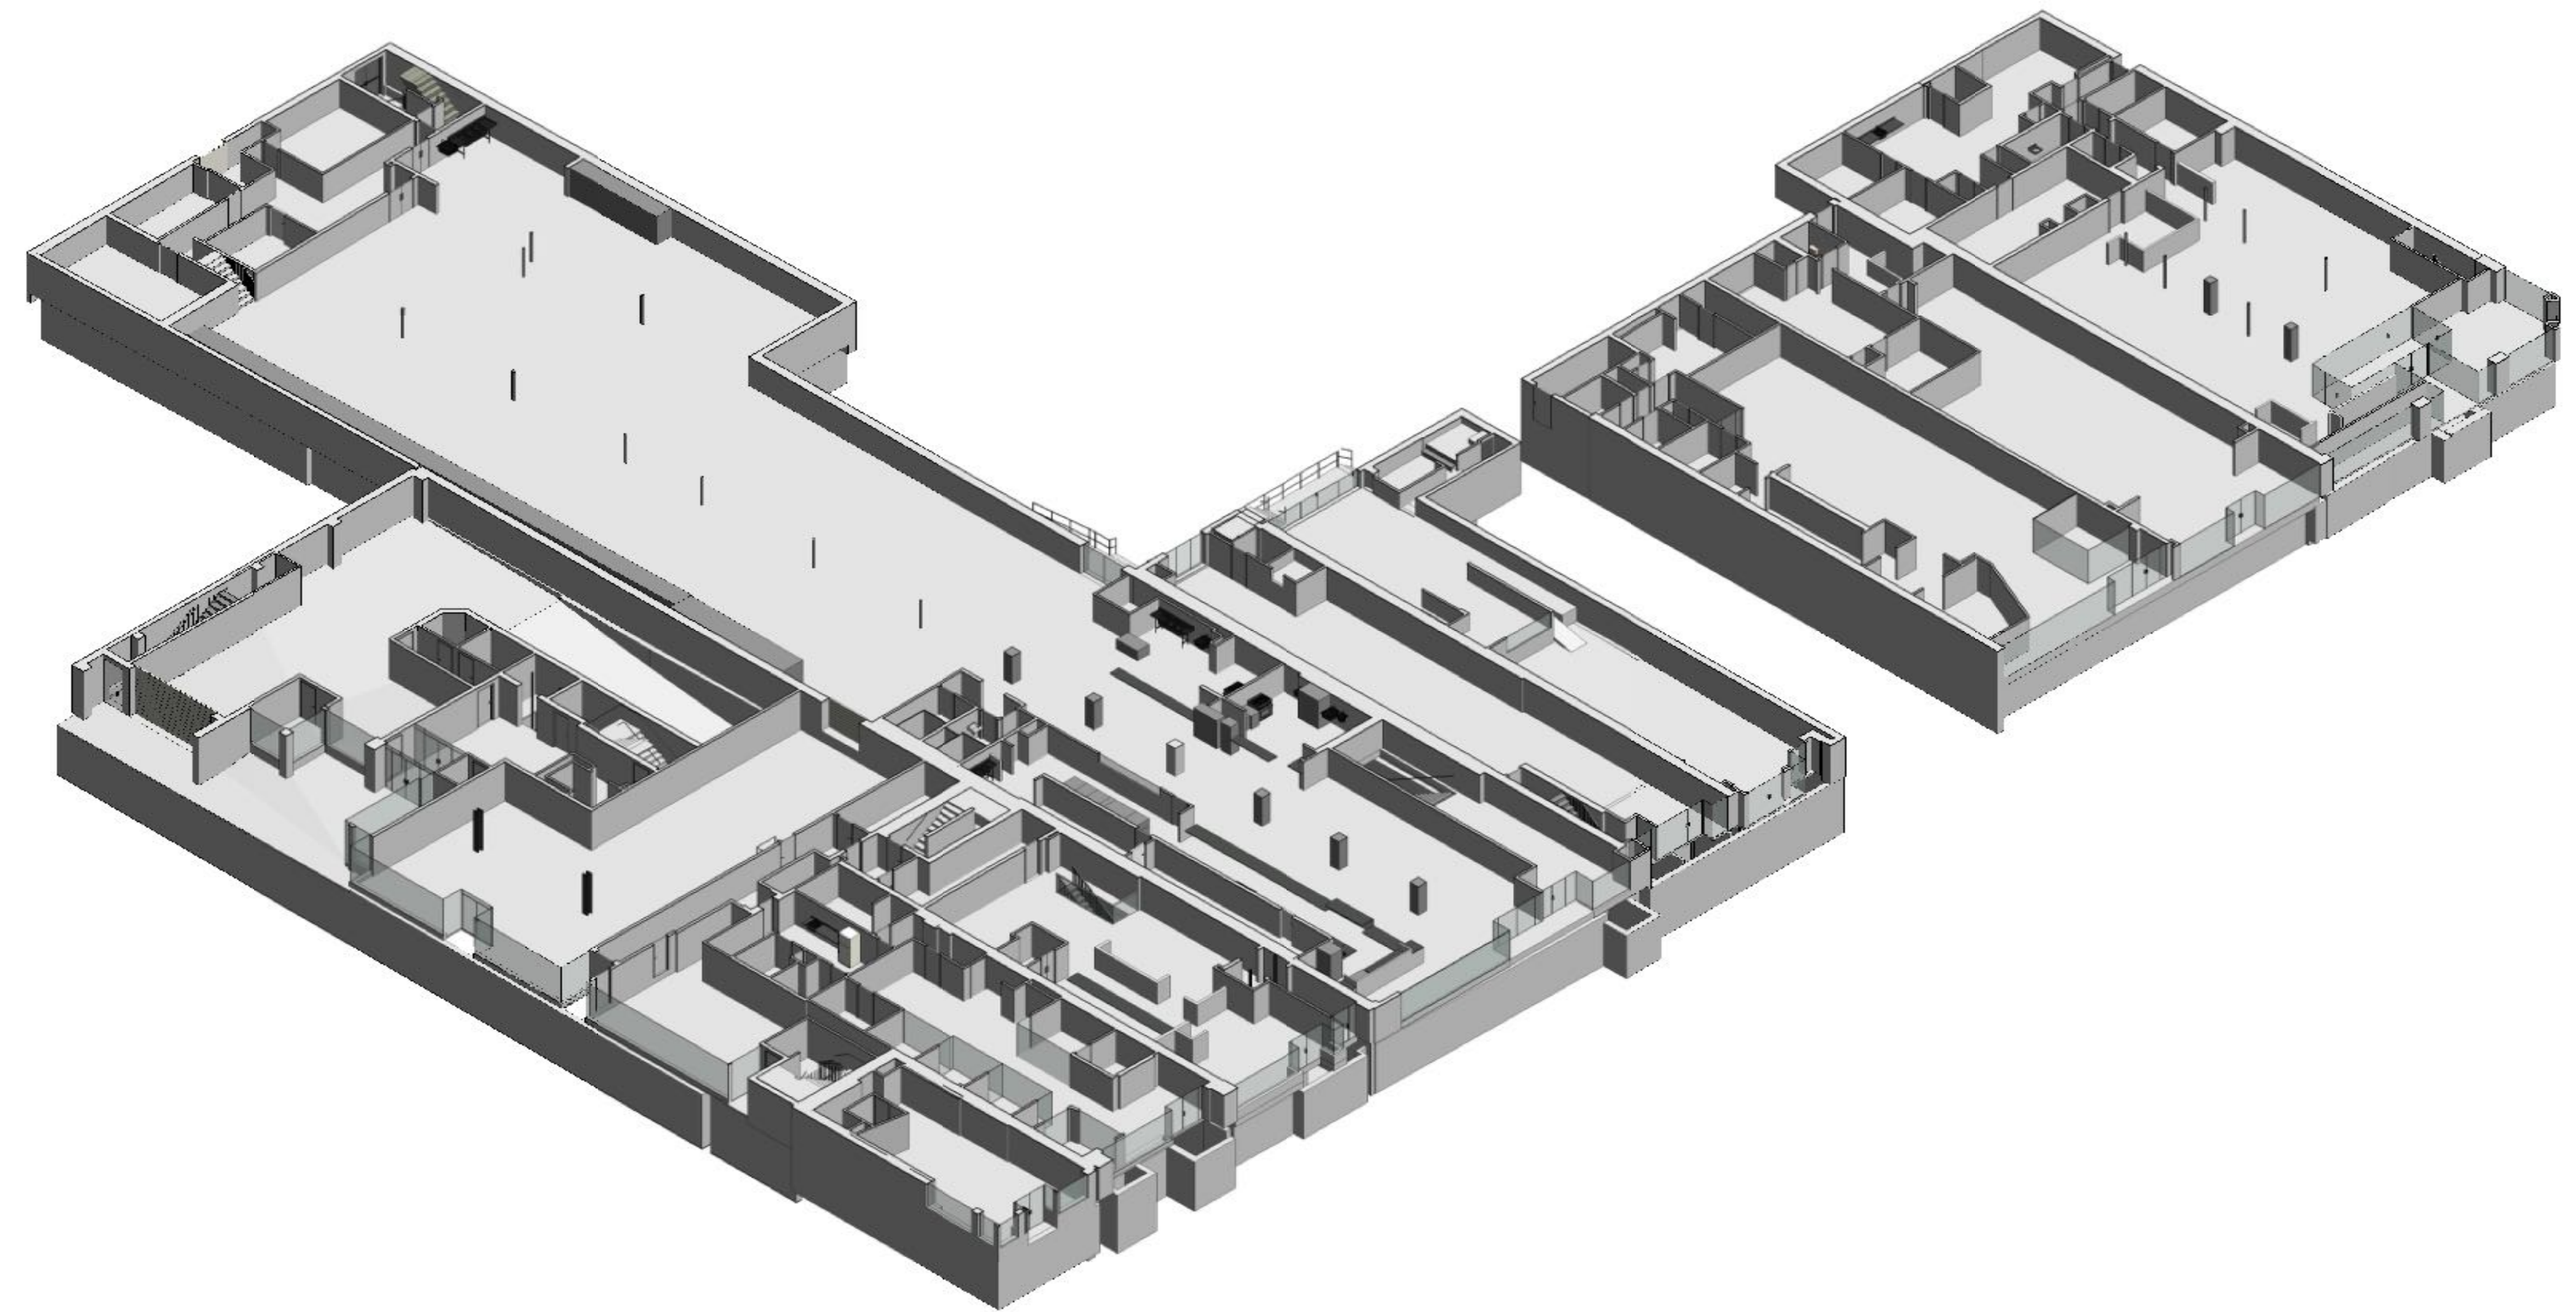


**ARCHITECTURAL AS BUILT**  
**Cambridge, MA 02139**

NO.	ISSUES / REVISIONS	DATE
01	100% SUBMISSION	SEE COVER SHEET

**3D SECTION**

Designer	PROJECT MANAGER
Designer	PROJECT DIRECTOR
Project Number	PROJECT NUMBER
Author	DRAWN BY

**AB-8**

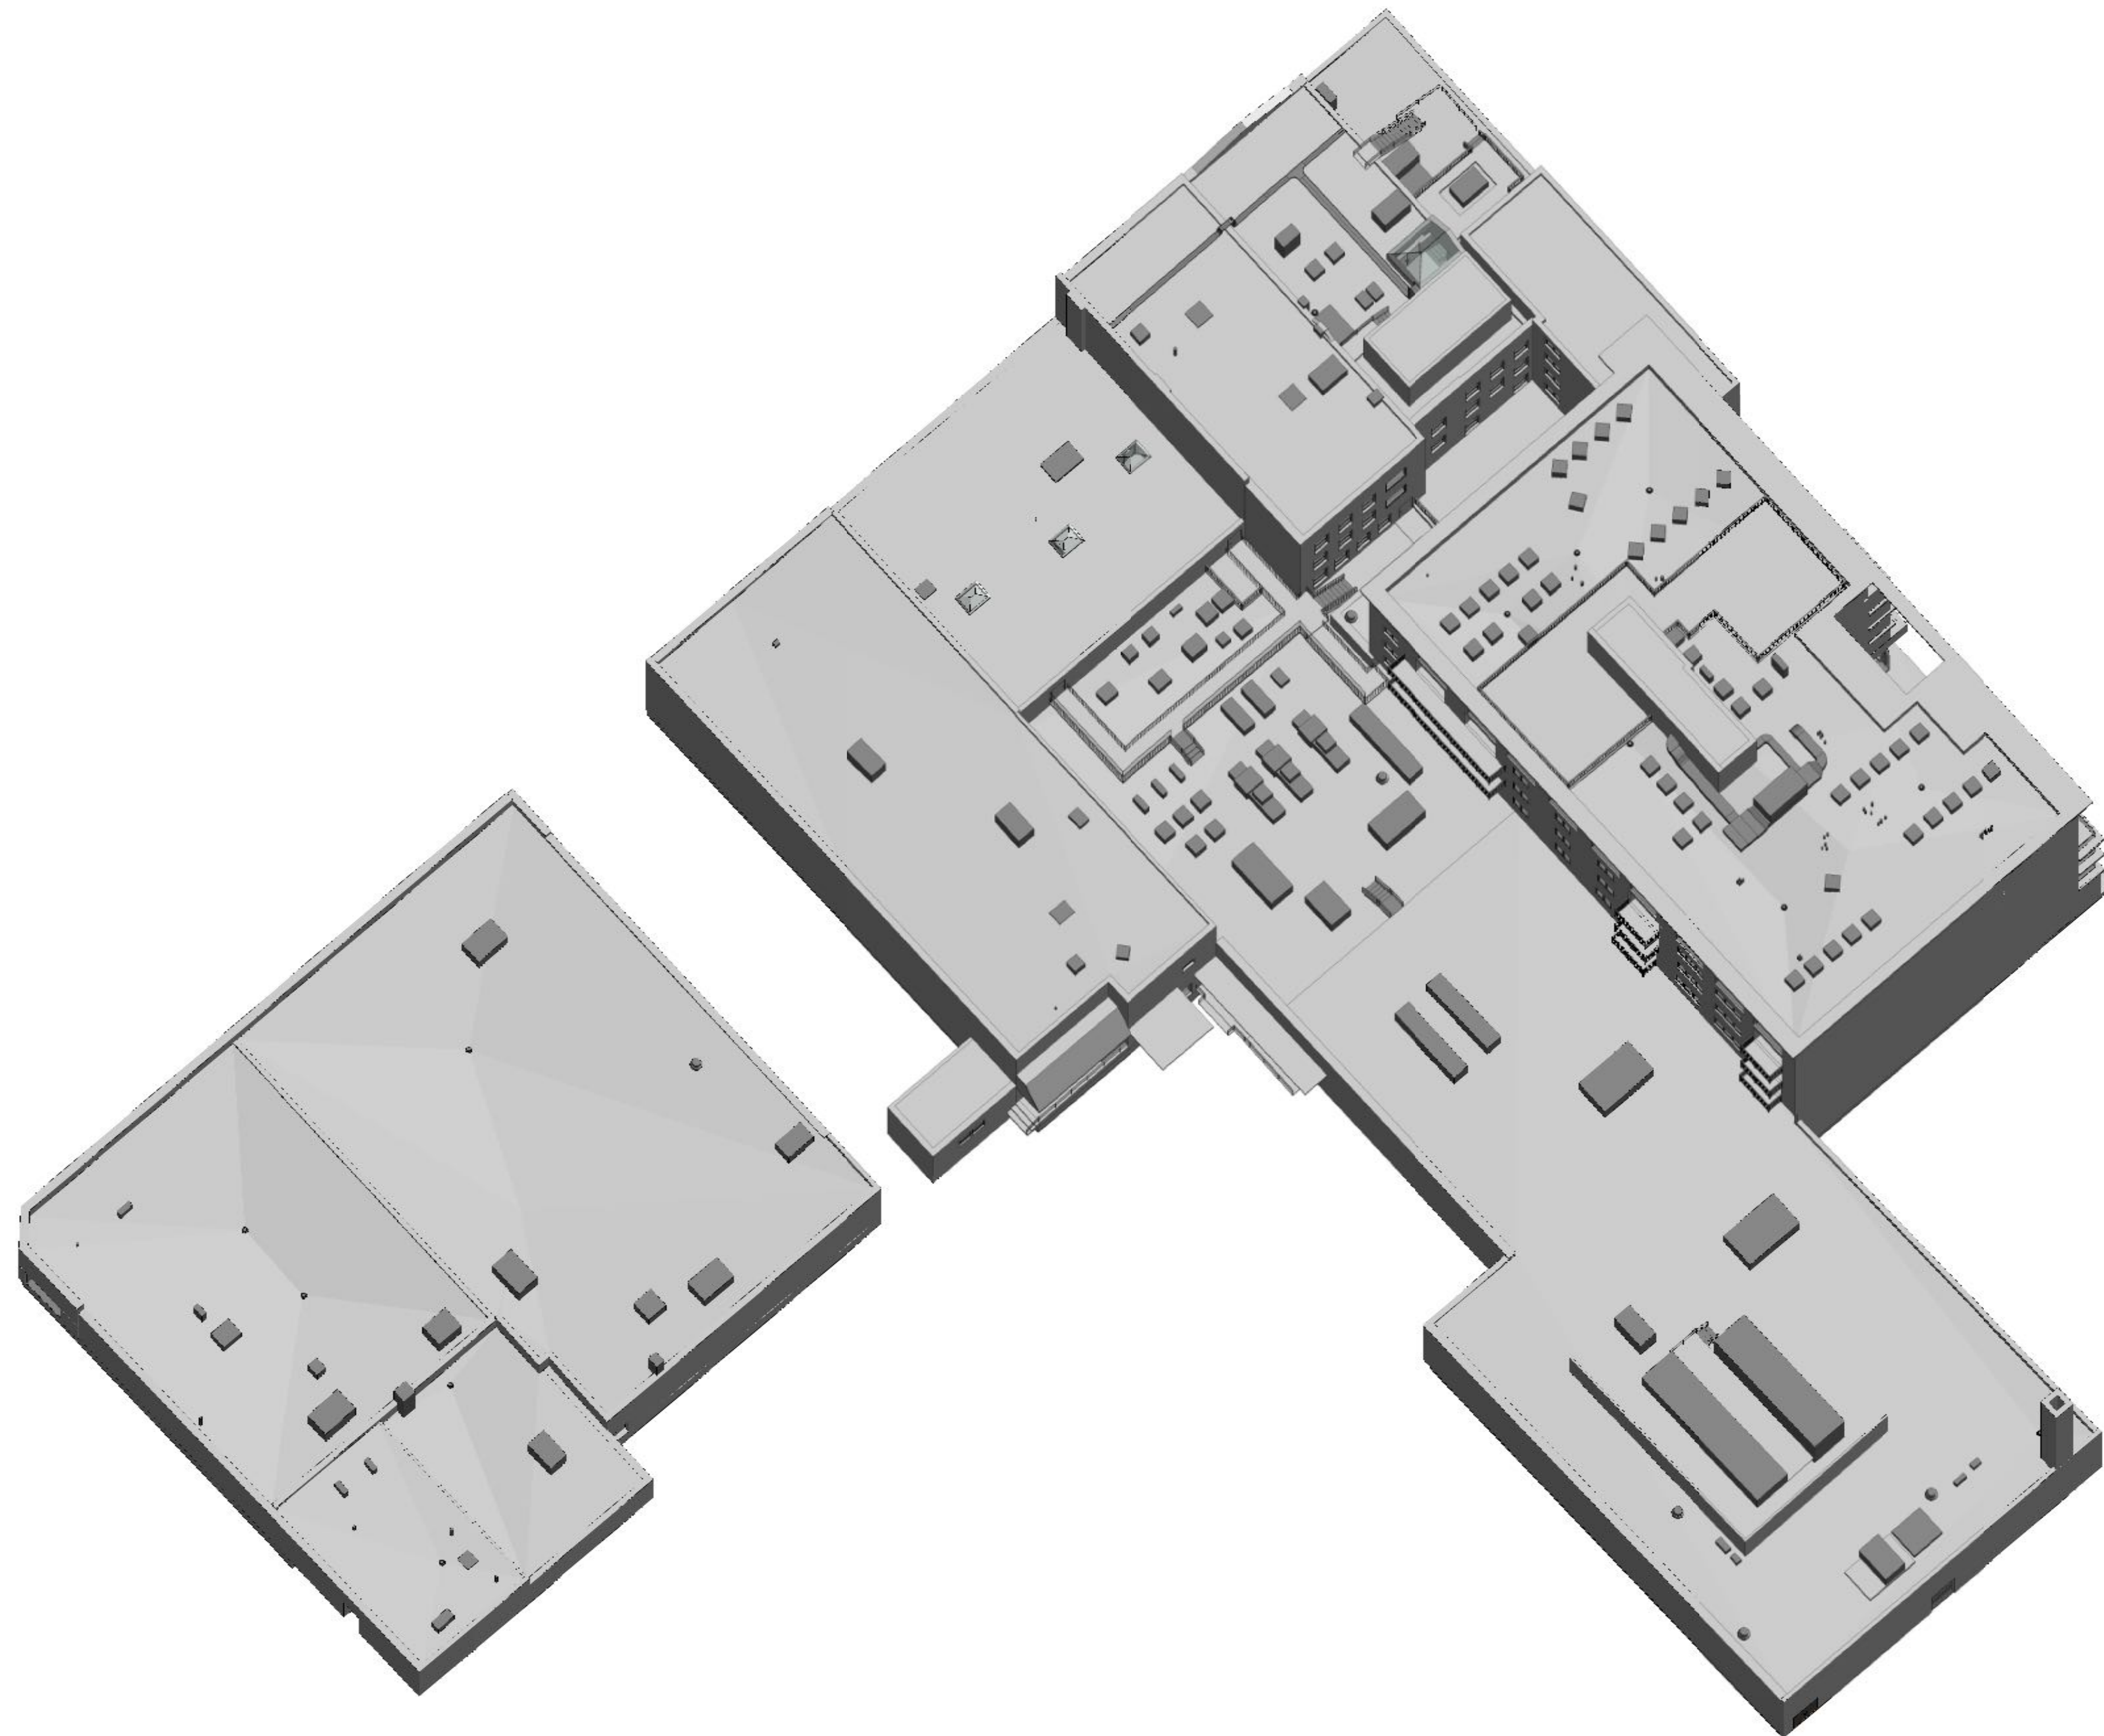

**As BUILT**  
**PROFESSIONALS**  
 www.asbuiltprofessionals.com  
 A DIVISION OF:

**AEC**  
 CONSULTANTS INC  
 844.272.8458  
 844 AS BUILT

© 2020 AEC CONSULTANTS INC

**ARCHITECTURAL AS BUILT**  
**Cambridge, MA 02139**

01	100% SUBMISSION	SEE COVER SHEET
NO.	ISSUES / REVISIONS	DATE
		SHEET TITLE

**3D ROOF**

Designer	PROJECT MANAGER
Designer	PROJECT DIRECTOR
Project Number	PROJECT NUMBER
	SCALE
Author	DRAWN BY
	SHEET NUMBER

**AB-9**