

# AS-BUILT DOCUMENTATION


## Point Reyes Station, CA



**100% SUBMITTAL**

### DRAWING INDEX

- 0C1 COVER
- 0SL SYMBOL LEGEND
- AB-1 FIRST FLOOR
- AB-2 SECOND FLOOR
- AB-3 1ST FLR REFLECTED CEILING PLAN
- AB-4 2ND FLR REFLECTED CEILING PLAN
- AB-5 ROOF PLAN
- AB-6 EXTERIOR ELEVATIONS
- AB-7 EXTERIOR ELEVATIONS
- AB-8 BUILDING SECTION
- AB-9 INTERIOR ELEVATIONS
- AB-10 3D FIRST FLOOR SECTION
- AB-11 3D SECOND FLOOR SECTION
- AB-12 3D ELEVATIONS
- AB-13 3D SECTIONS

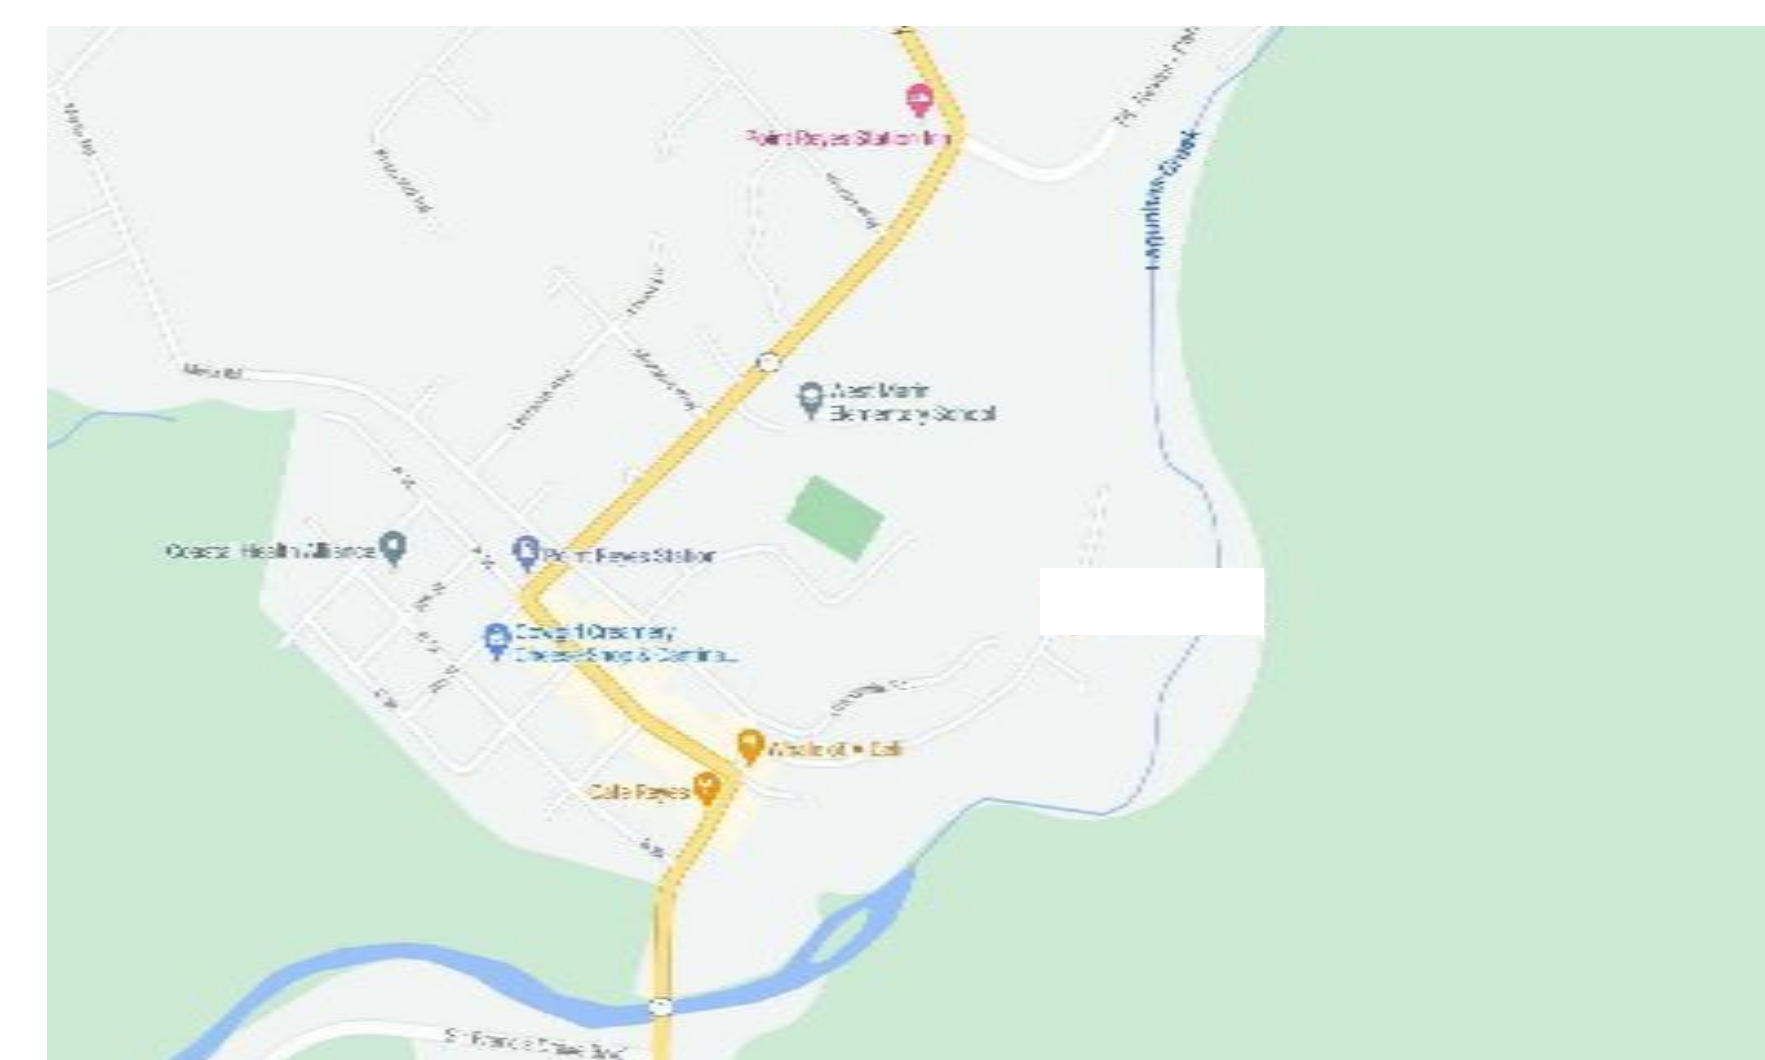

VICINITY MAP  
N.T.S.

AREA DATA	
FIRST FLOOR	4672 SF
FIRST FLOOR CAFE	1822 SF
SECOND FLOOR	4486 SF
Grand total	10981 SF



**ARCHITECTURAL AS BUILT**

**Point Reyes Station, CA**

NO.	ISSUES / REVISIONS	DATE	SHEET TITLE
01	100% SUBMISSION		SEE COVER SHEET

NO.	ISSUES / REVISIONS	DATE	SHEET TITLE


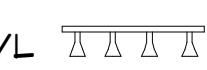
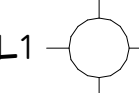
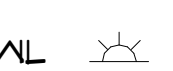
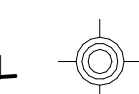
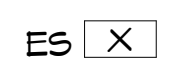
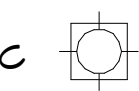

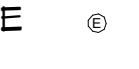

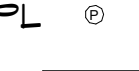

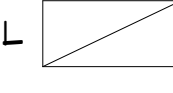
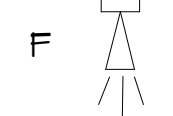
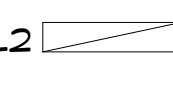

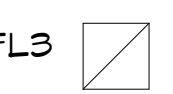
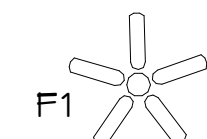

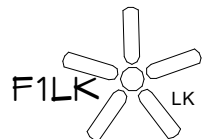

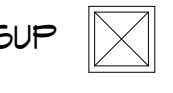





**COVER**

Designer	PROJECT MANAGER
Designer	PROJECT DIRECTOR
Project Number	PROJECT NUMBER
Author	DRAWN BY
	SHEET NUMBER














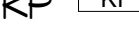
**0C1**

# SYMBOLS LEGEND

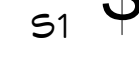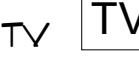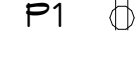

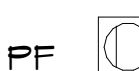


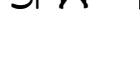

## RCP

EXH 	EXHAUST VENT	VL 	TRACK LIGHT OR VANITY LIGHT
L1 	CEILING MOUNTED LIGHT FIXTURE	WL 	WALL-MOUNTED LIGHT FIXTURE
L 	CEILING MOUNTED DIRECTIONAL LIGHT	ES 	EMERGENCY EXIT SIGN
RC 	RECESSED CAN LIGHT	EL 	EMERGENCY EXIT LIGHT
EYE 	EYEBALL OR SMALL CAN LIGHT	EEL 	EMERGENCY EXIT LIGHT W/ SIGN
HPL 	PENDANT LIGHT	STAIR 	LIGHTED STAIR SIGN
FL 	INDIVIDUAL FLUOR. LAY-IN FIXTURE 4 BULB	F 	FLOOD LIGHT
FL2 	INDIVIDUAL FLUOR. HANGING FIXTURE 2 BULB	PC 	PHOTO CELL
FL3 	INDIVIDUAL FLUOR. FLUSH MOUNT FIXTURE 4 BULB	F1 	CEILING FAN
C 	CAMERA	FILK 	CEILING FAN W/ LIGHT KIT
M 	MOTION DET.	7-2-6	CEILING HEIGHT AND TRIM 7'-2" ABOVE FLOOR BELOW WITH 6" CROWN MOULDING. NOTE: ALL CEILINGS NOT LABELED ARE PLASTER. CEILINGS SHOWN WITH A GRID ARE LAY IN ACOUSTICAL TILE..
SUP 	SUPPLY VENT	J 	JUNCTION BOX
SUP2 	SUPPLY VENT		
RET 	RETURN VENT		
RET2 	RETURN VENT		
spe 	SPEAKER		







## ELECTRIC

DAT 	DATA OUTLET
TEL 	TELEPHONE JACK
S1 	ELECTRIC SWITCH
TV 	CABLE TELEVISION OUTLET
P1 	DUPLEX RECEPTACLE OUTLET
P3 	SPECIAL PURPOSE CONNECTION OR OUTLET
PQ 	QUADRUPLX RECEPTACLE OUTLET
PF 	FLOOR DUPLEX RECEPTACLE OUTLET
PNL 	ELECTRIC PANEL
MTR 	ELECTRIC METER
BUT 	BUTTON SWITCH
DISC 	DISCONNECT SWITCH
LG 	GROUND/FLOOR LIGHT
KP 	KEY PAD



## FIRE PROTECTION

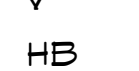
FE 	FIRE EXTINGUISHER
FP 	FIRE PULL
AS 	FIRE ALARM (HORN/SRTOBE)
SD 	SMOKE DETECTOR
SS 	SMOKE ALARM SPEAKER
SP 	SPRINKLER HEAD CEILING MOUNT
SPW 	SPRINKLER HEAD WALL MOUNT

## MEP


TH 	THERMOSTAT
FD 	FLOOR DRAIN
V 	VALVE
HB 	HOSE BIB
WS 	WATER SUPPLY
HEAT 	SUSPENDED GAS HEATER

## MISC

BOLLARD 	BOLLARD
ELEVATION SYMBOL 	11-4-11/16 SPOT ELEVATION

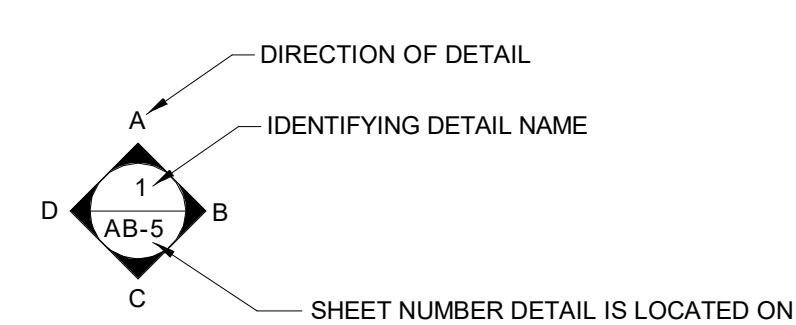

## INTERIOR ELEVATIONS

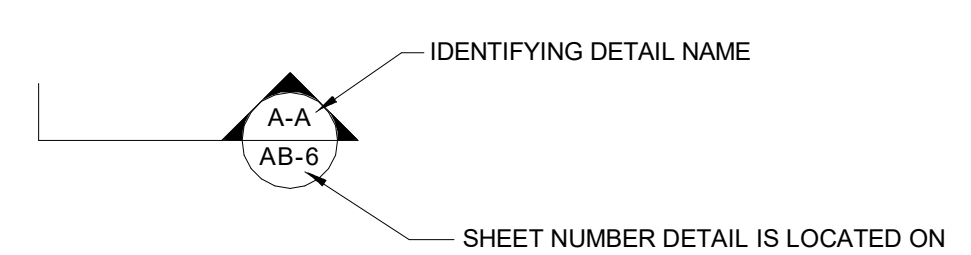






## BUILDING SECTION

### PHOTO DOCUMENTATION LEGEND

INDICATES LOCATION OF CAMERA  
 INDICATES DIRECTION OF CAMERA LENS AND CORRESPONDING PHOTO / VIDEO NUMBER

PS (SMALL)  
 PL (LARGE)

TYPES OF DOCUMENTATION

	GROUND BASED PHOTO		GROUND BASED VIDEO		360° SPHERICAL PHOTO		AERIAL BASED PHOTO		AERIAL BASED VIDEO
---	--------------------	---	--------------------	---	----------------------	---	--------------------	---	--------------------

**ARCHITECTURAL AS BUILT**

**Point Reyes Station, CA**


01	100% SUBMISSION	SEE COVER SHEET
NO.	ISSUES / REVISIONS	DATE

SHEET TITLE

## SYMBOL LEGEND



Designer	PROJECT MANAGER
Designer	PROJECT DIRECTOR
Project Number	PROJECT NUMBER
	SCALE
Author	DRAWN BY
	SHEET NUMBER

**OSL**

INTERIOR FINISH SCHEDULE				
Room	Floor Finish	Wainscot	Wall Finish	Ceiling Finish
BATH 1	TILE	FRP	GWB	GWB
BATH 2	TILE	FRP	GWB	GWB
BATH 3	TILE	TILE	GWB	GWB
CL	VINYL		GWB	GWB
DATA	CPT		GWB	GWB
DINING	WOOD	WOOD	GWB	GWB
FREEZER	S.S.		S.S.	S.S.
HALLWAY	CPT		GWB	GWB
KITCHEN	TILE		GWB	GWB
LAUNDRY	CPT		GWB	GWB
MECH.	VINYL		GWB	GWB
OFFICE	CPT		GWB	GWB
PREP	TILE		GWB	GWB
STORAGE	CPT		GWB	GWB
STUDIO	CPT		GWB	GWB
TELECOM	CPT		GWB	GWB
WC	VINYL	FRP	GWB	GWB

DOOR SCHEDULE				
Type	Count	Width	Height	Comments
A	32	2' - 6"	6' - 8"	
B	21	3' - 0"	6' - 8"	
C	1	6' - 0"	7' - 0"	
D	2	2' - 0"	6' - 8"	
E	1	4' - 10"	8' - 0"	
F	6	5' - 10"	8' - 0"	
G	2	3' - 0"	6' - 8"	
H	2	3' - 0"	6' - 8"	
J	1	6' - 0"	6' - 8"	
K	1	3' - 8"	6' - 8"	
L	10	5' - 11"	8' - 0"	

WINDOW SCHEDULE				
Mark	Count	Width	Height	Operation
A	50	4' - 0"	4' - 0"	SLIDING
B	6	2' - 5"	3' - 0"	FIXED
C	6	2' - 5"	1' - 5"	AWNING
D	3	2' - 9"	1' - 3"	AWNING
E	1	2' - 6"	6' - 6"	FIXED
F	12	3' - 0"	3' - 10"	SLIDING
G	1	1' - 6"	6' - 8"	FIXED
H	1	5' - 0"	4' - 0"	SLIDING

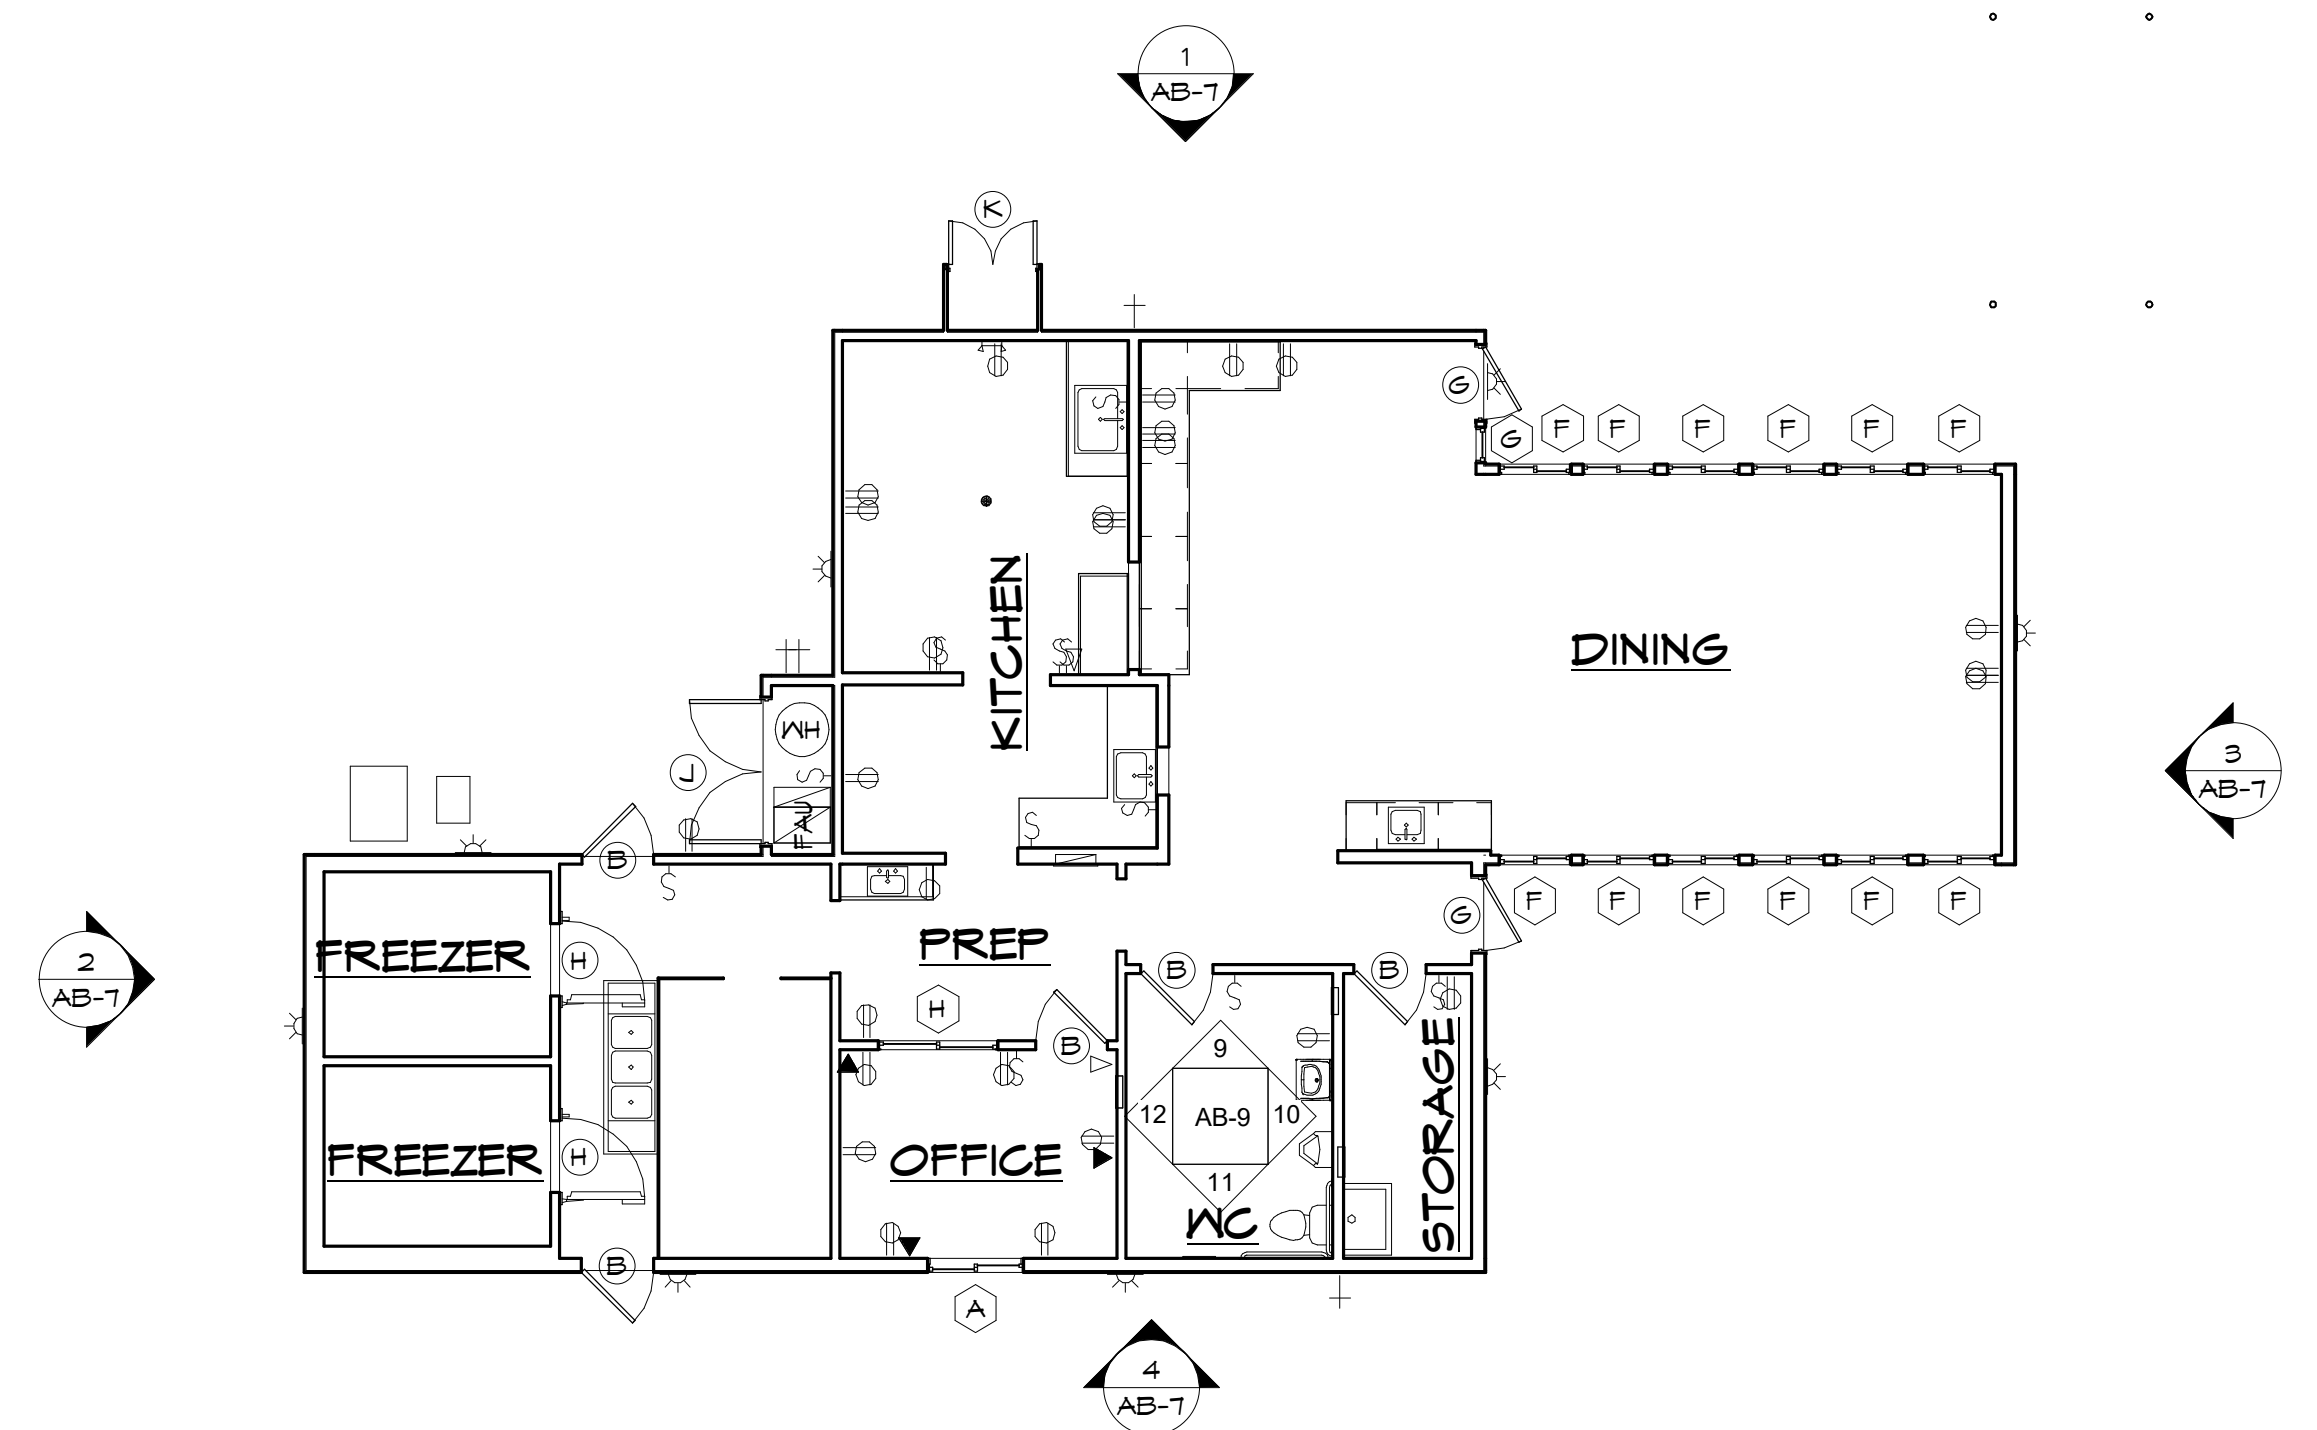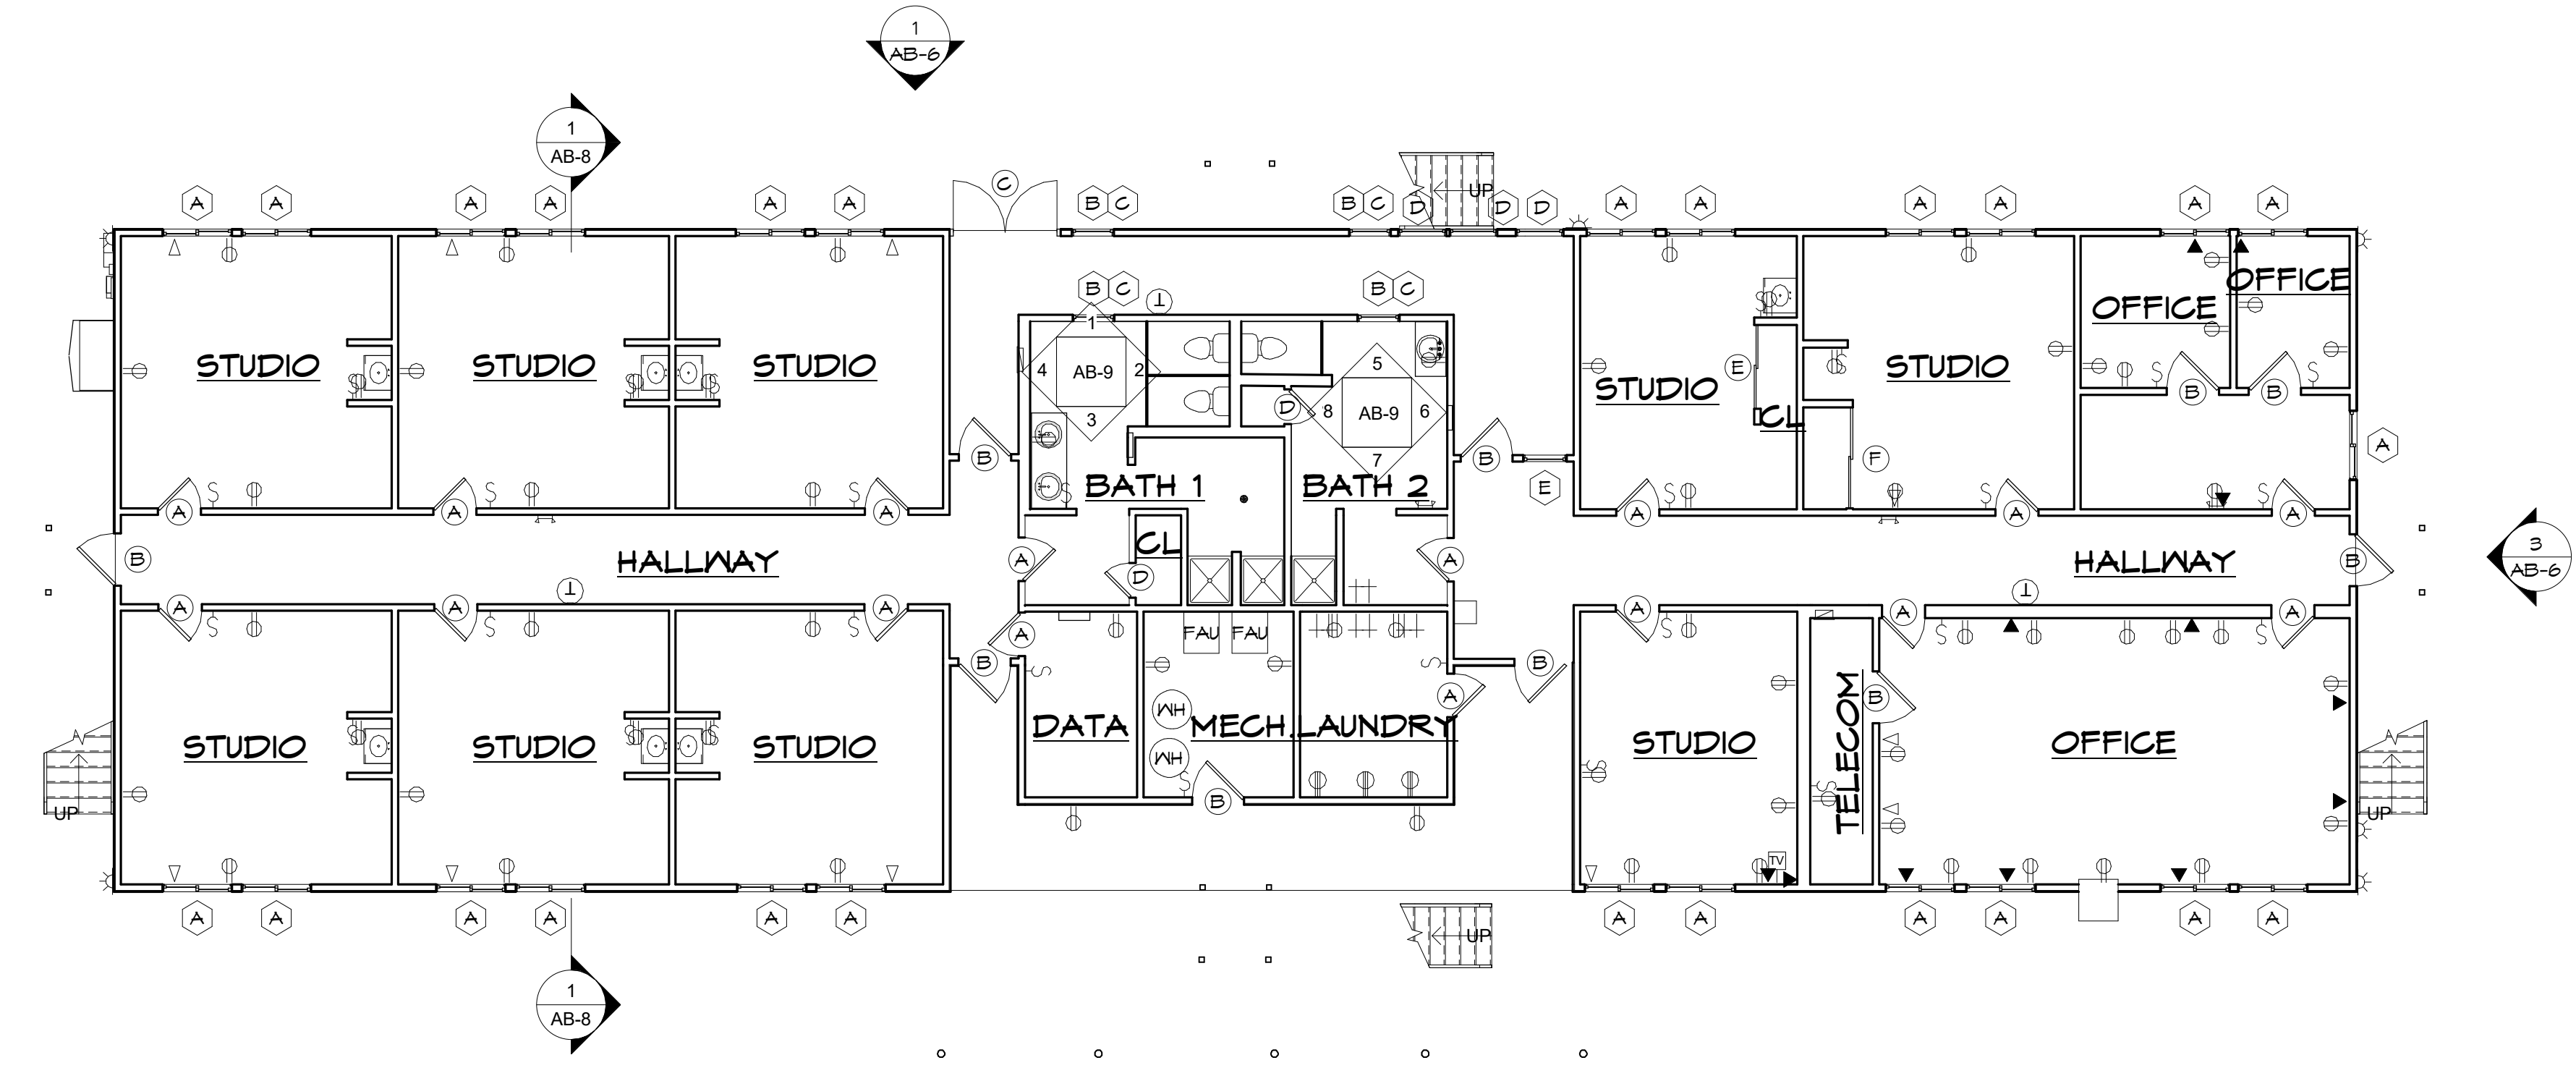

1 FIRST FLOOR  
1/8" = 1'-0"


**ARCHITECTURAL AS BUILT**  
**Point Reyes Station, CA**

01	100% SUBMISSION	SEE COVER SHEET
NO.	ISSUES / REVISIONS	DATE
SHEET TITLE		

**FIRST FLOOR**

Designer	PROJECT MANAGER
Designer	PROJECT DIRECTOR
Project Number	PROJECT NUMBER
Author	DRAWN BY
	SHEET NUMBER

**AB-1**

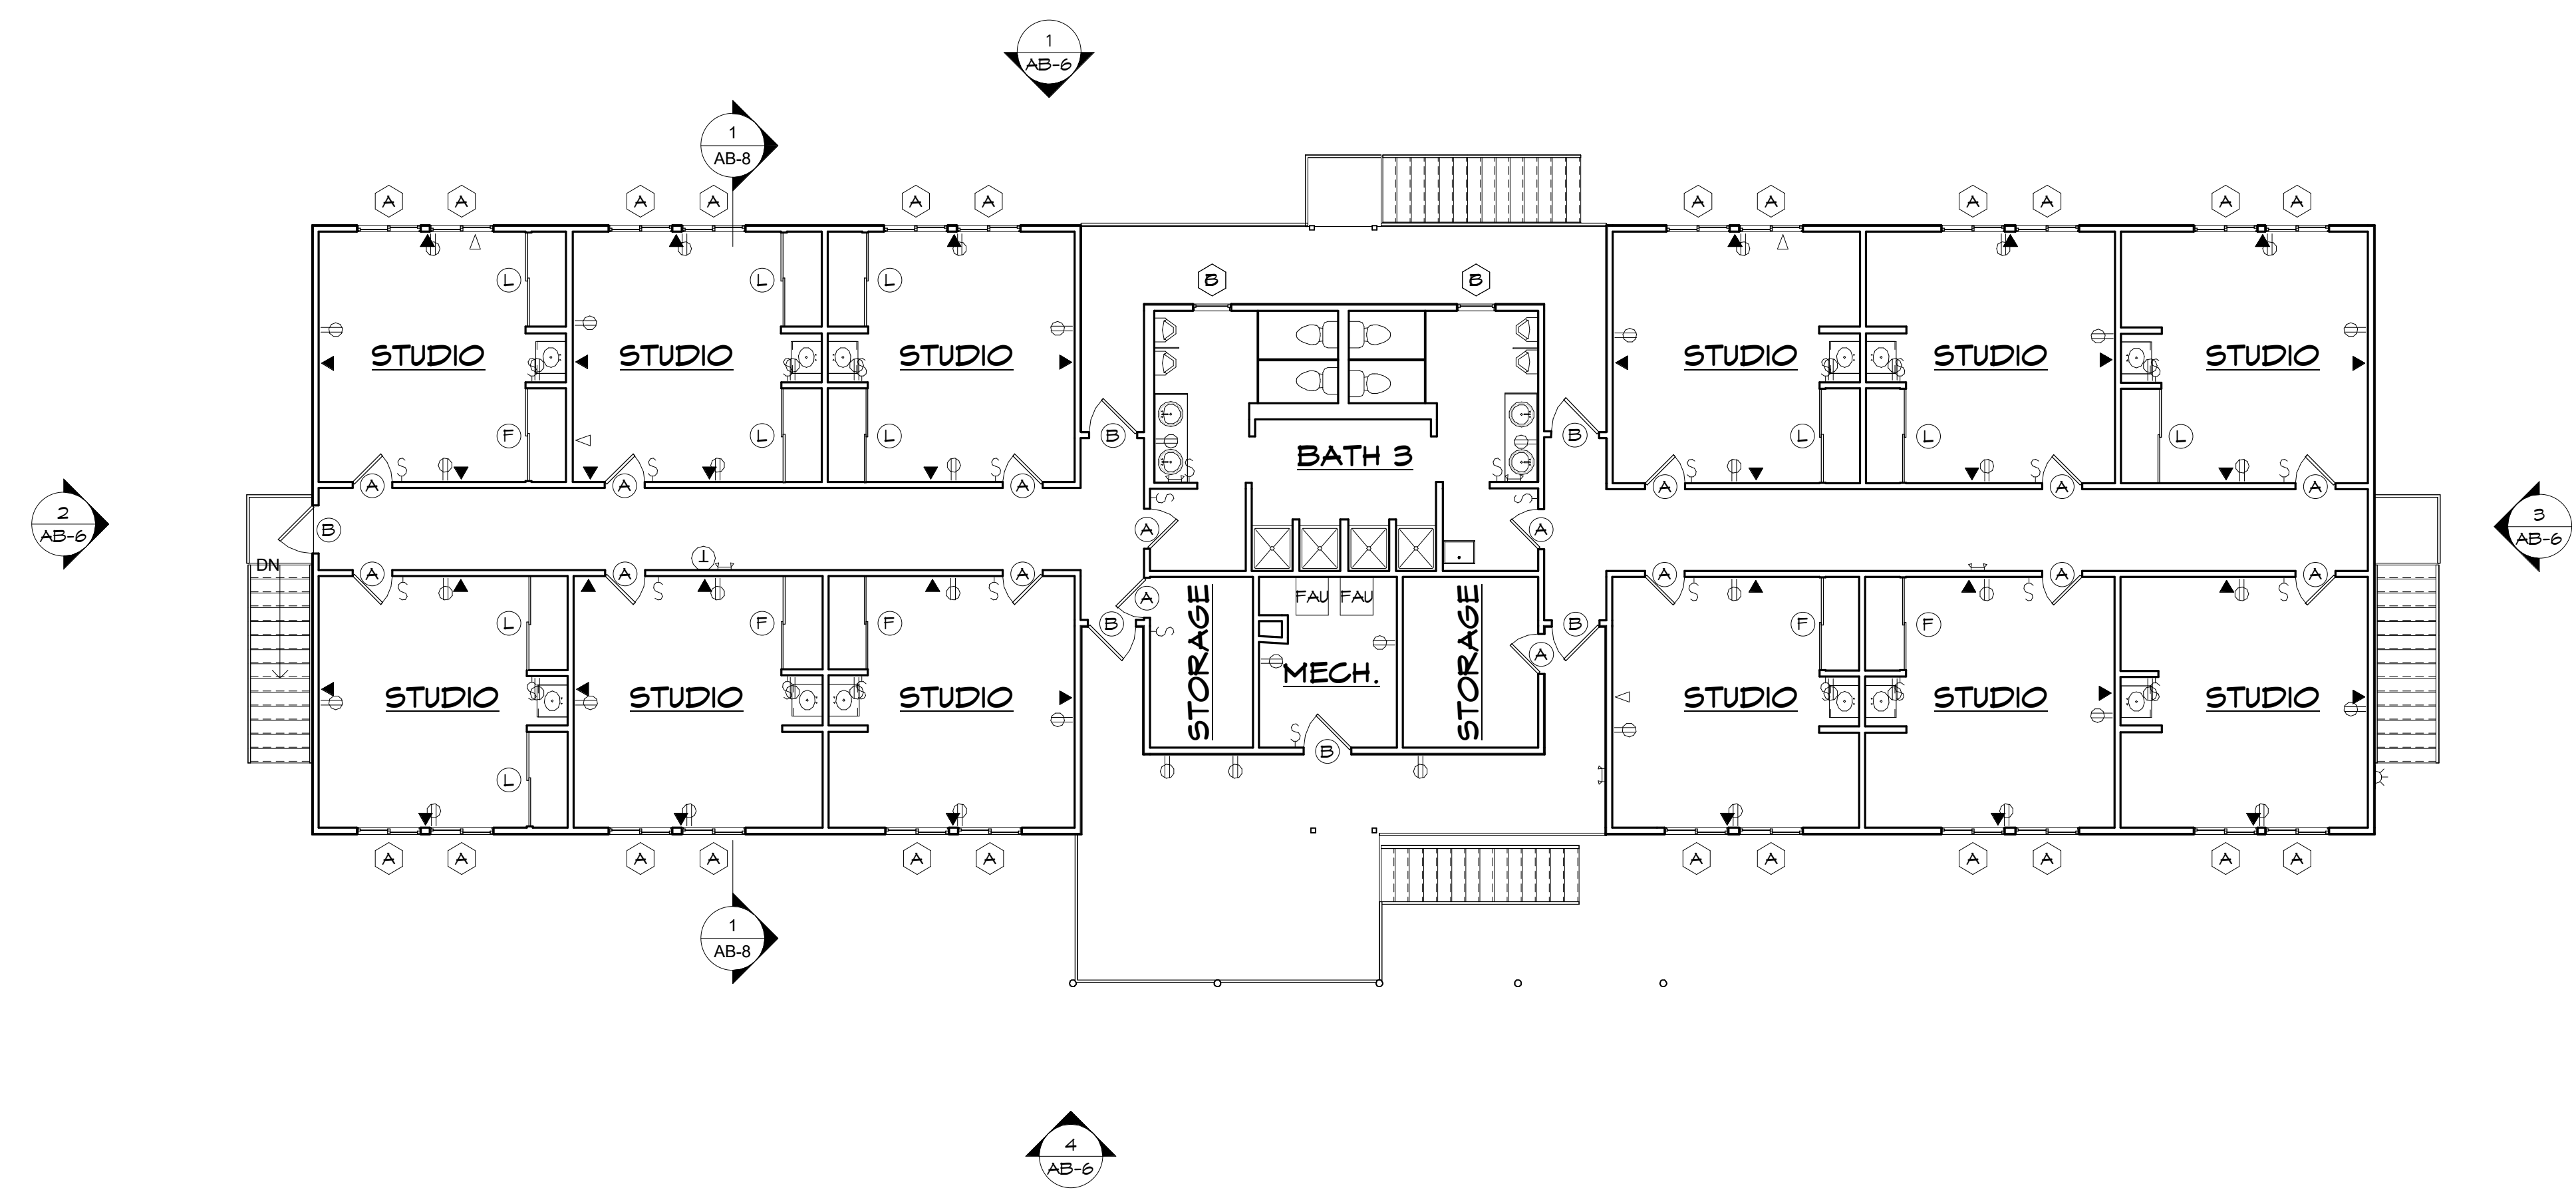

**ARCHITECTURAL AS BUILT**  
**Point Reyes Station, CA**


NO.	ISSUES / REVISIONS	DATE
01	100% SUBMISSION	SEE COVER SHEET

**SECOND FLOOR**

Designer	PROJECT MANAGER
Designer	PROJECT DIRECTOR
Project Number	PROJECT NUMBER
Author	DRAWN BY
	SHEET NUMBER

**AB-2**

**ARCHITECTURAL AS BUILT**  
**Point Reyes Station, CA**

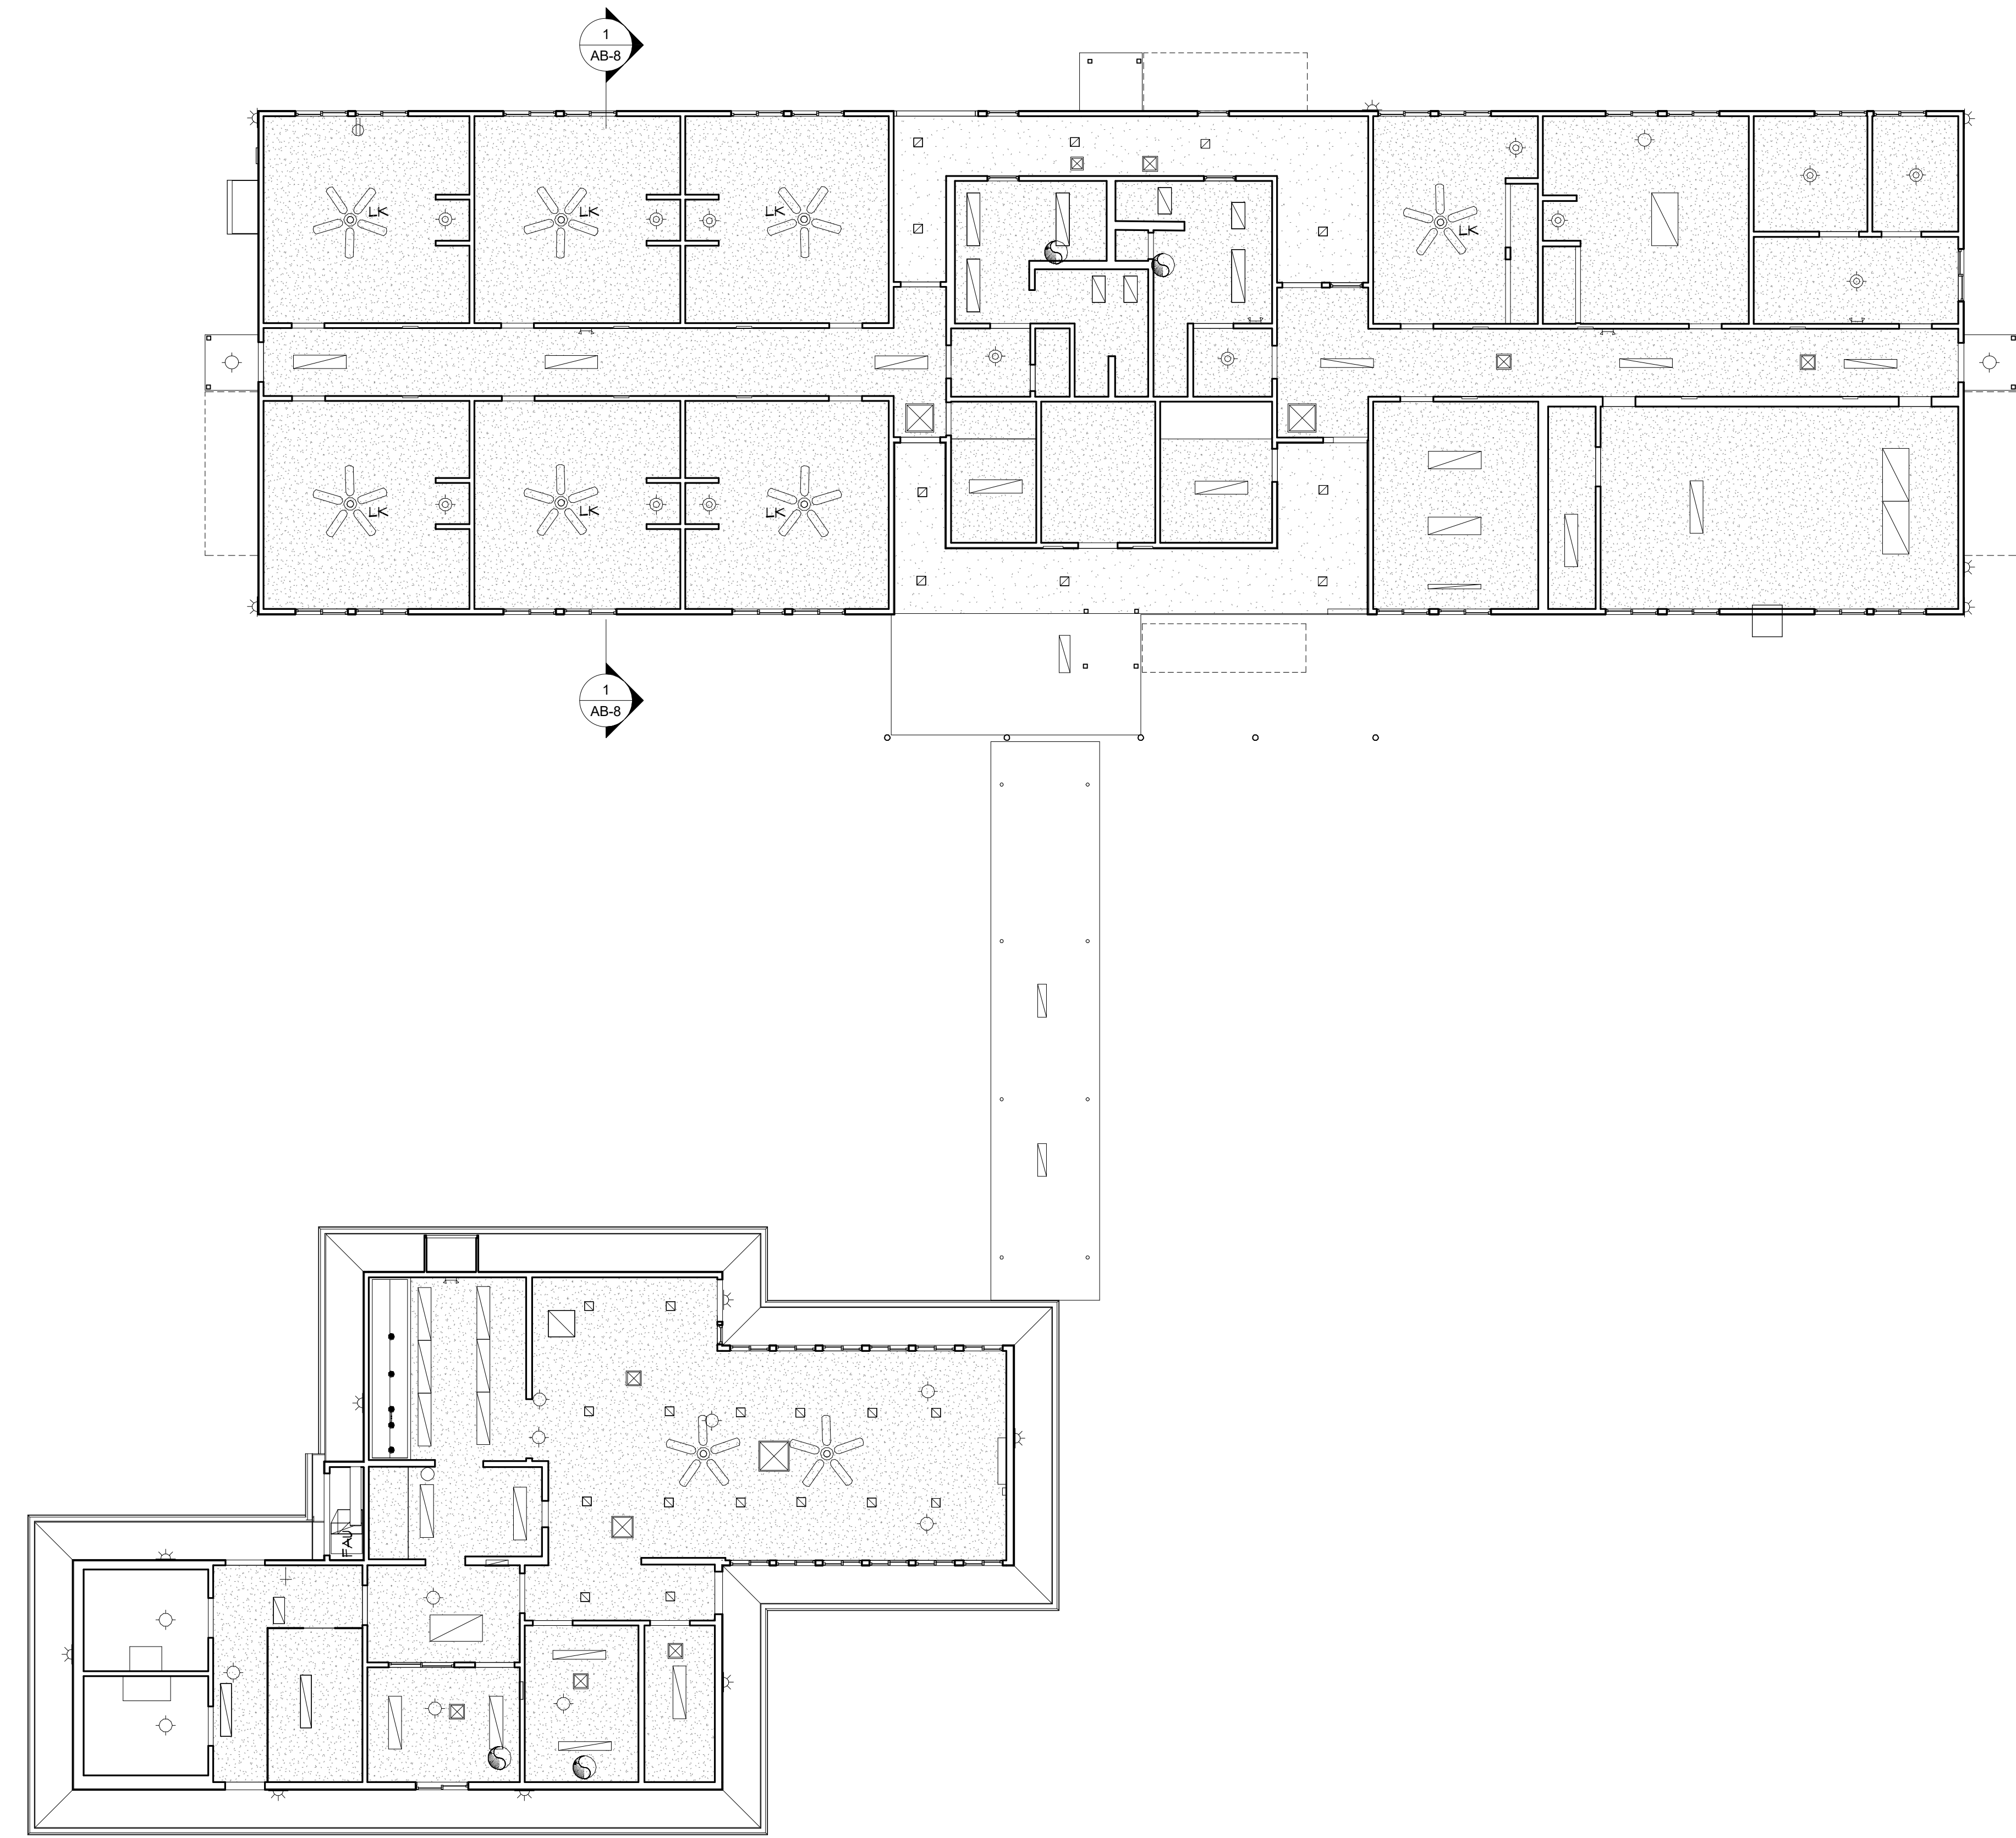


**1 FIRST FLOOR**  
 1/8" = 1'-0"

NO.	ISSUES / REVISIONS	DATE	SHEET TITLE
01	100% SUBMISSION		SEE COVER SHEET

**1ST FLR REFLECTED  
 CEILING PLAN**

Designer	PROJECT MANAGER
Designer	PROJECT DIRECTOR
Project Number	PROJECT NUMBER
Author	DRAWN BY
	SHEET NUMBER

**AB-3**

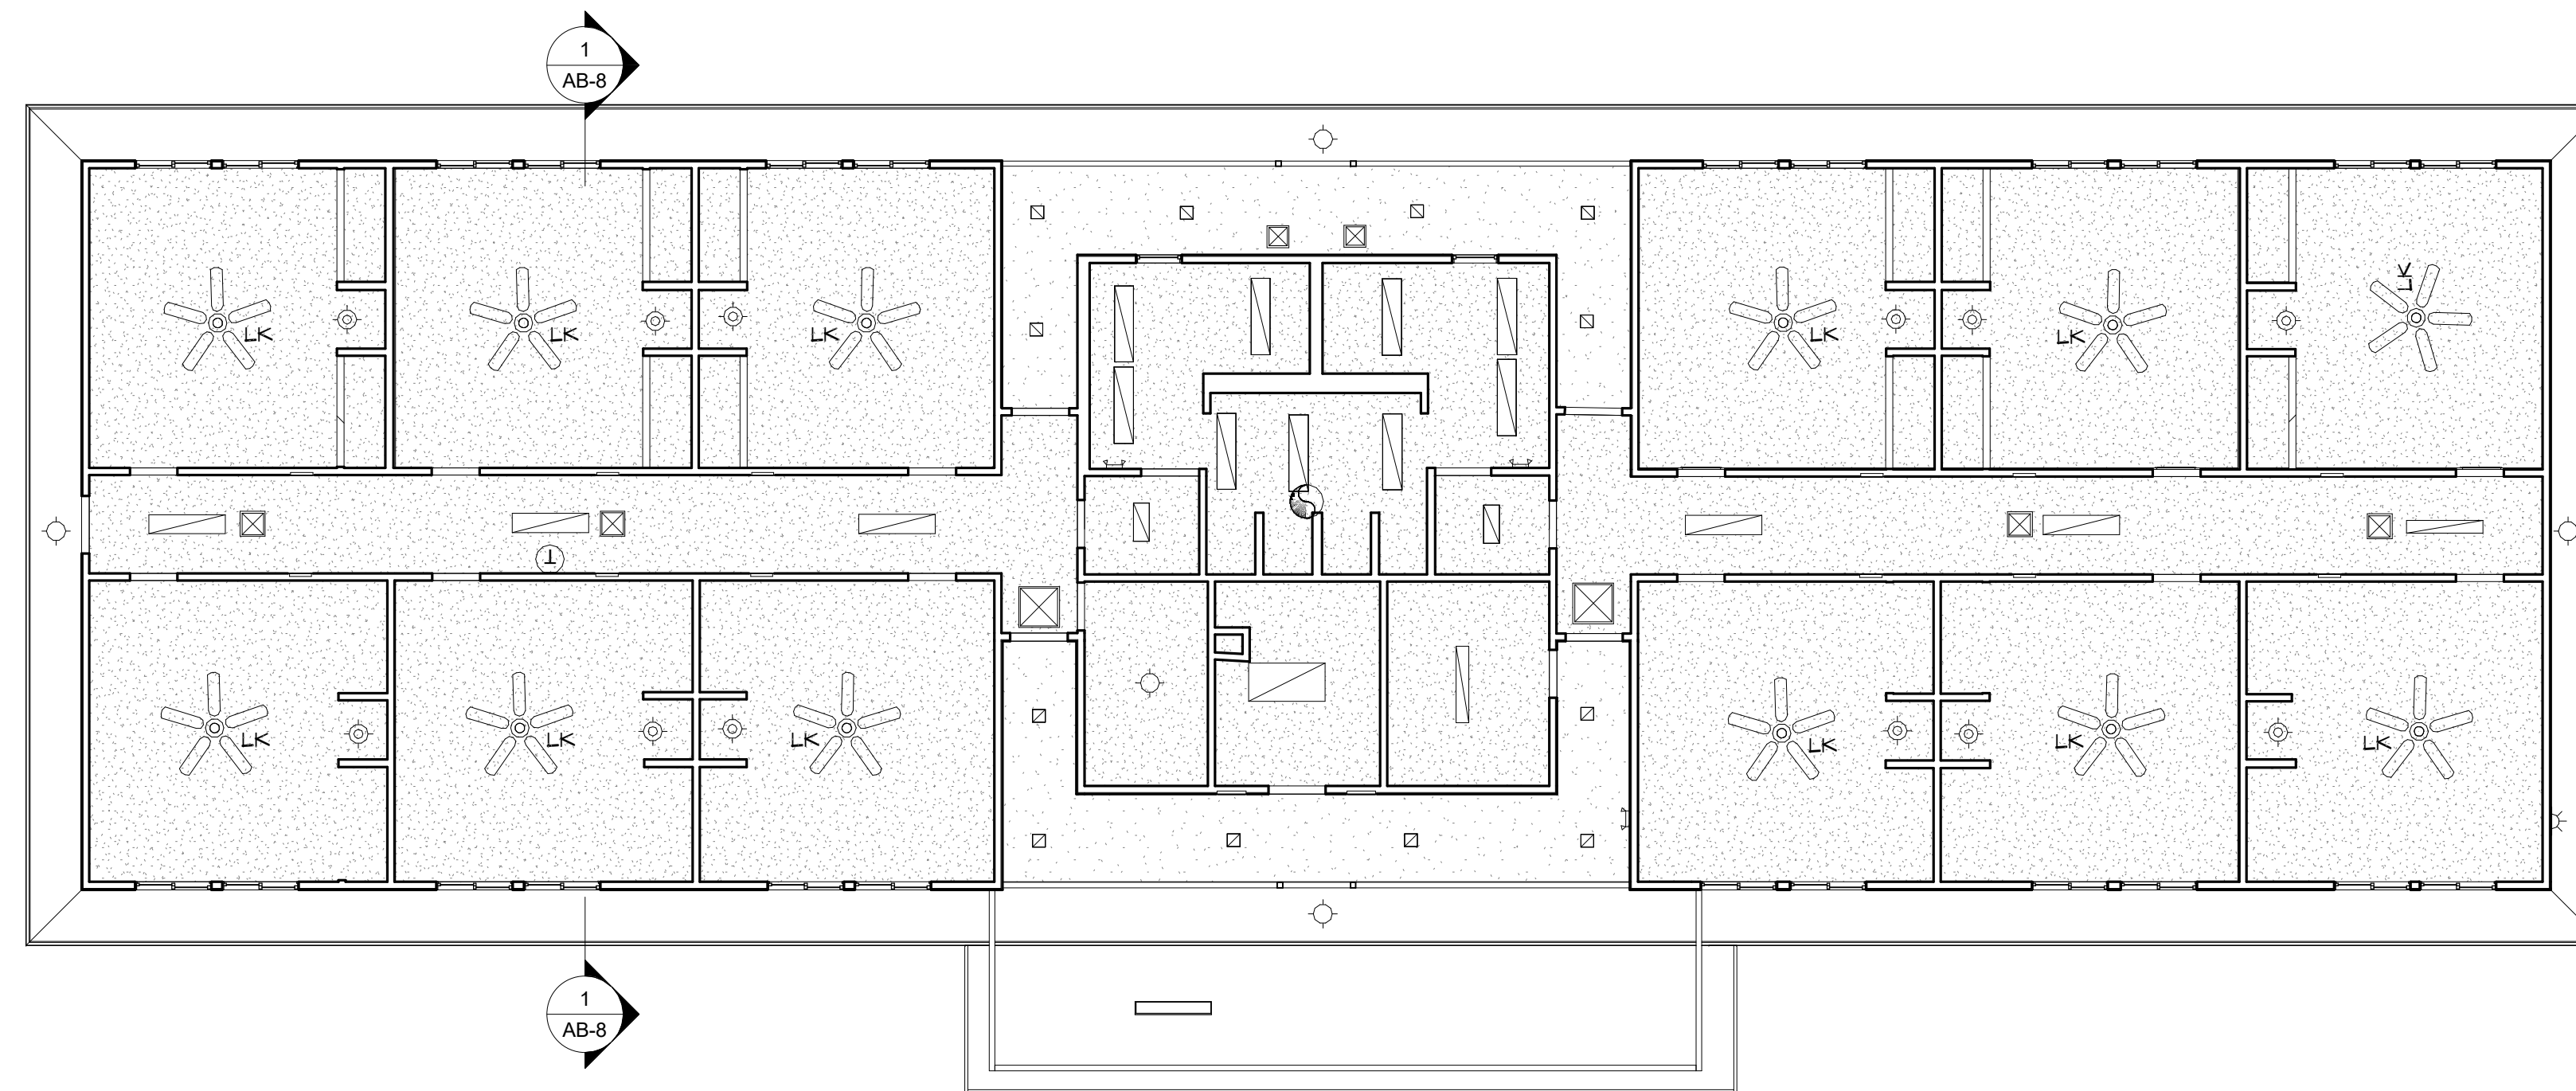

**ARCHITECTURAL AS BUILT**  
**Point Reyes Station, CA**


NO.	ISSUES / REVISIONS	DATE
01	100% SUBMISSION	SEE COVER SHEET

**2ND FLR REFLECTED  
 CEILING PLAN**

Designer	PROJECT MANAGER
Designer	PROJECT DIRECTOR
Project Number	PROJECT NUMBER
Author	DRAWN BY
	SHEET NUMBER

**AB-4**

**ARCHITECTURAL AS BUILT**  
**Point Reyes Station, CA**

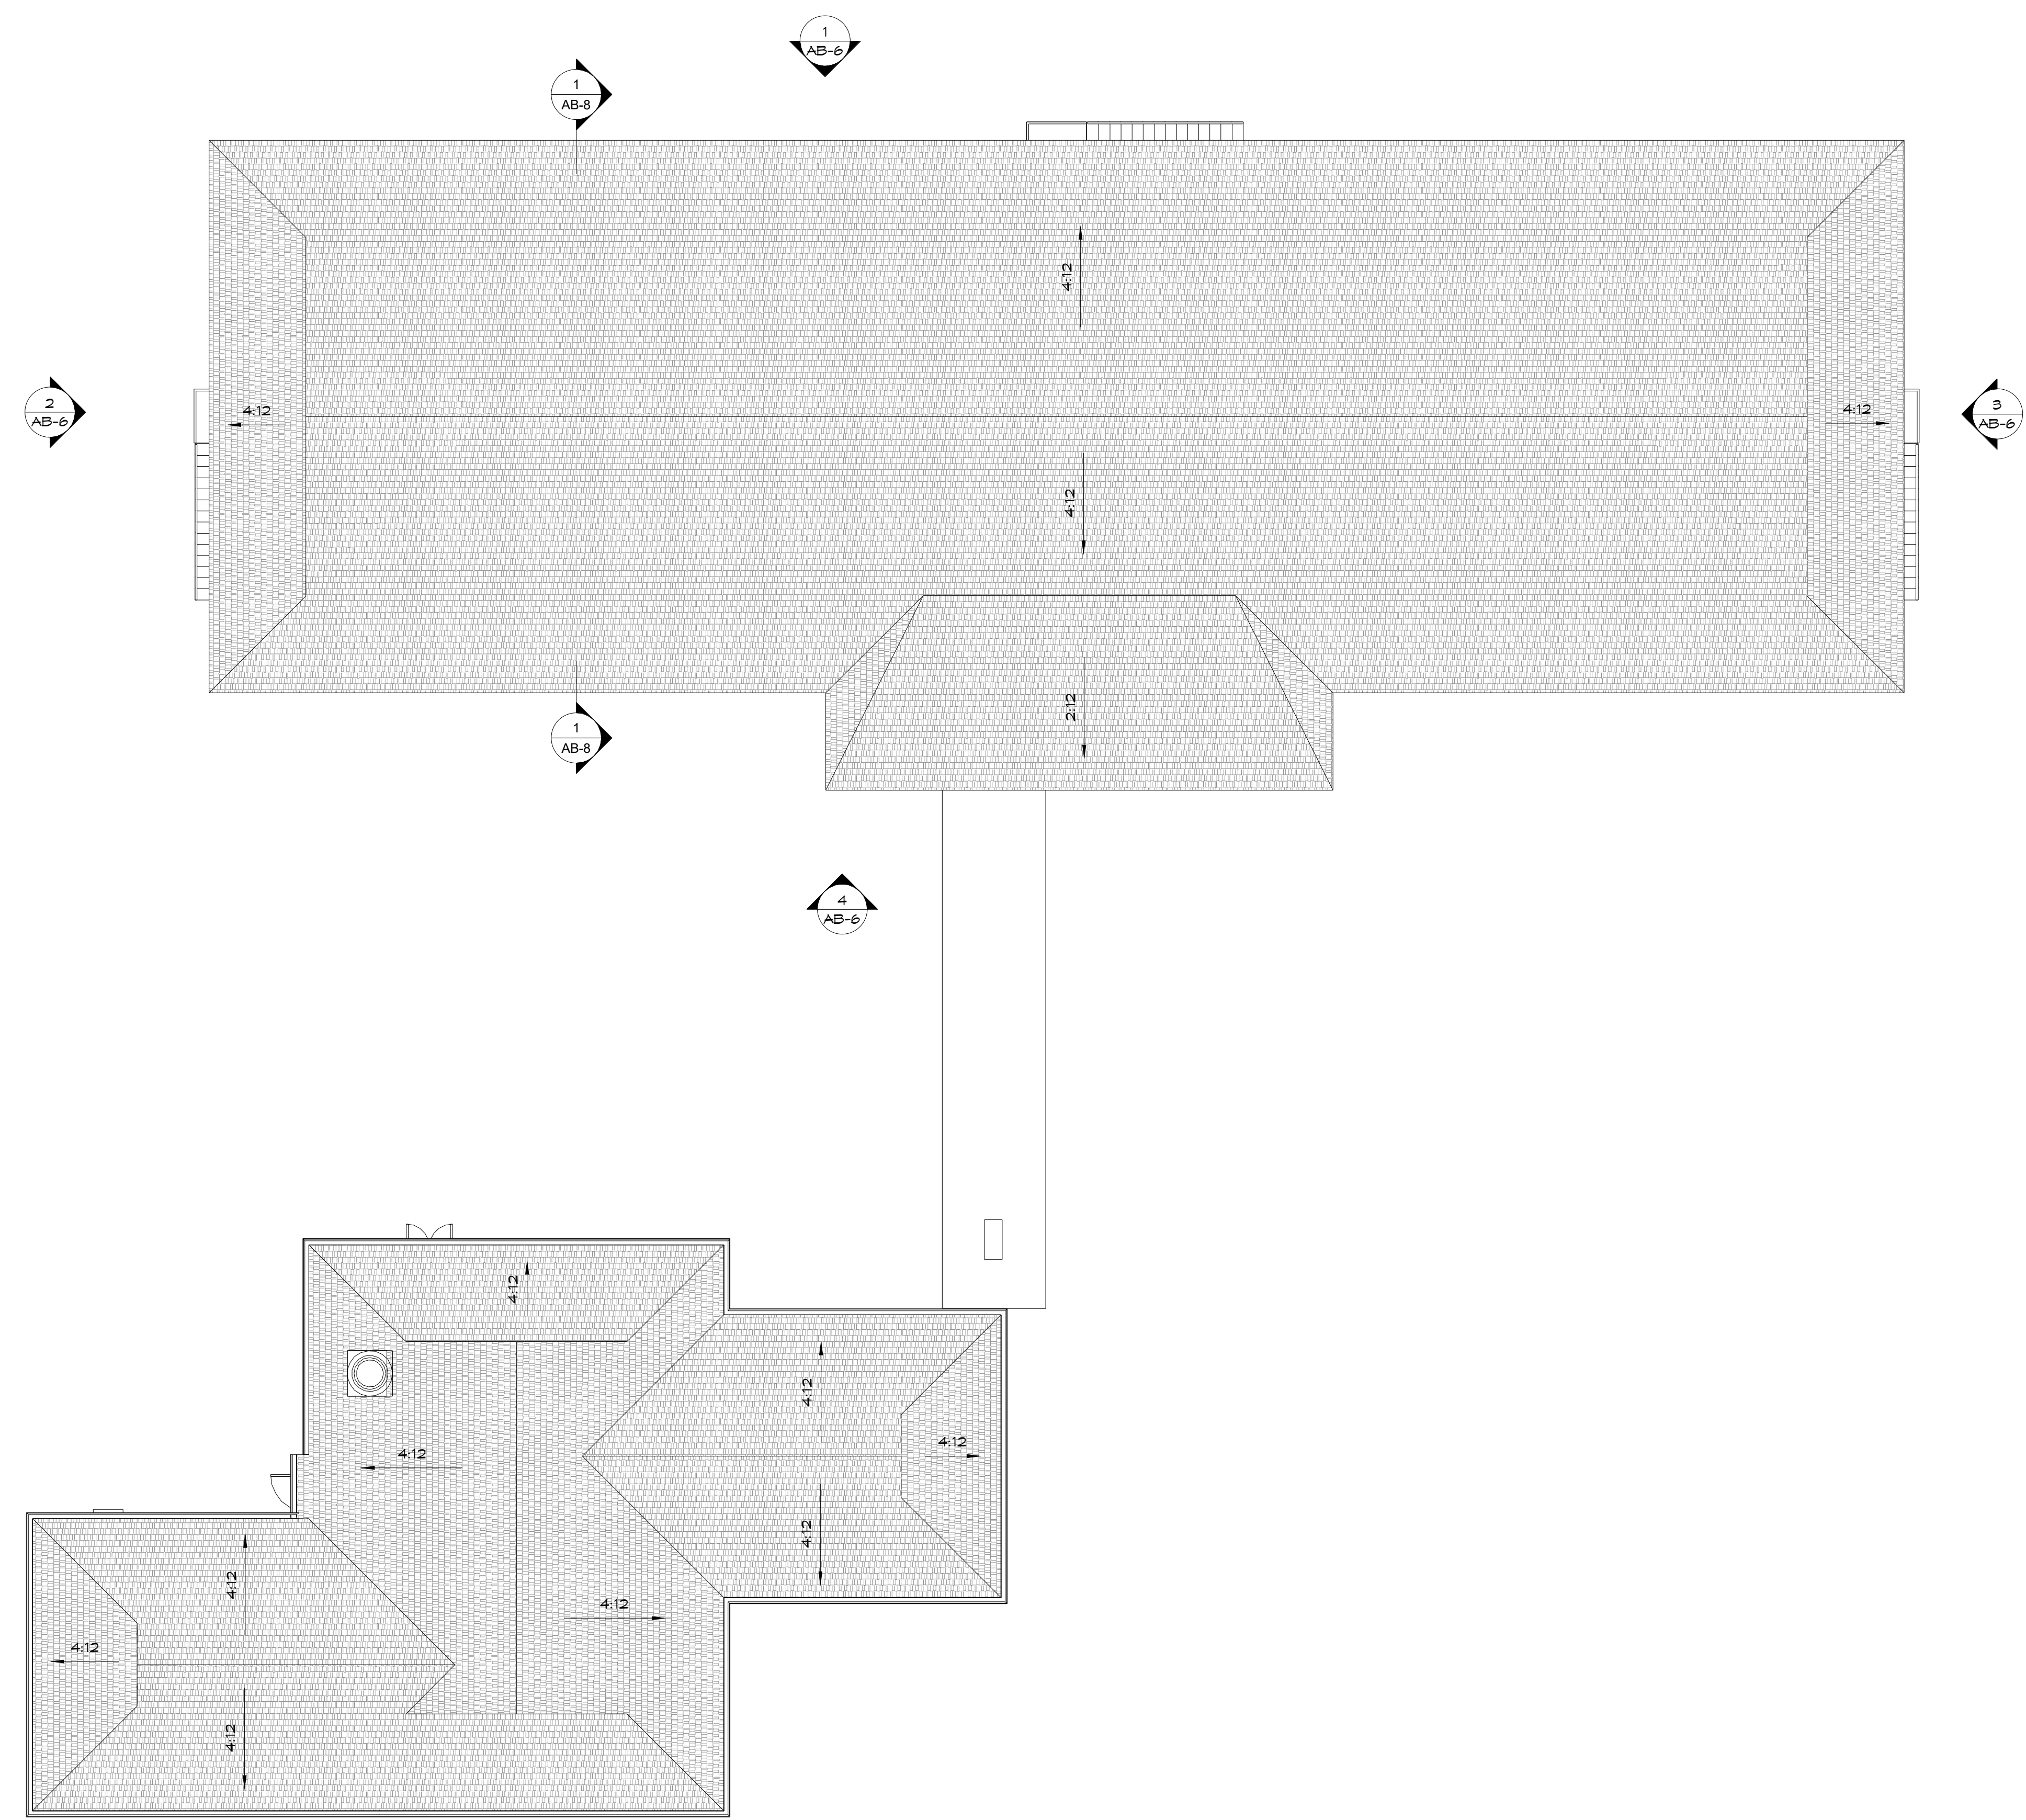

**1 ROOF PLAN**  
 1/8" = 1'-0"

01	100% SUBMISSION	SEE COVER SHEET
NO.	ISSUES / REVISIONS	DATE


**ROOF PLAN**

Designer	PROJECT MANAGER
Designer	PROJECT DIRECTOR
Project Number	PROJECT NUMBER
Author	DRAWN BY
	SHEET NUMBER


**AB-5**

**EXTERIOR FINISH SCHEDULE**


Asphalt Shingle
Lap Siding
Stucco

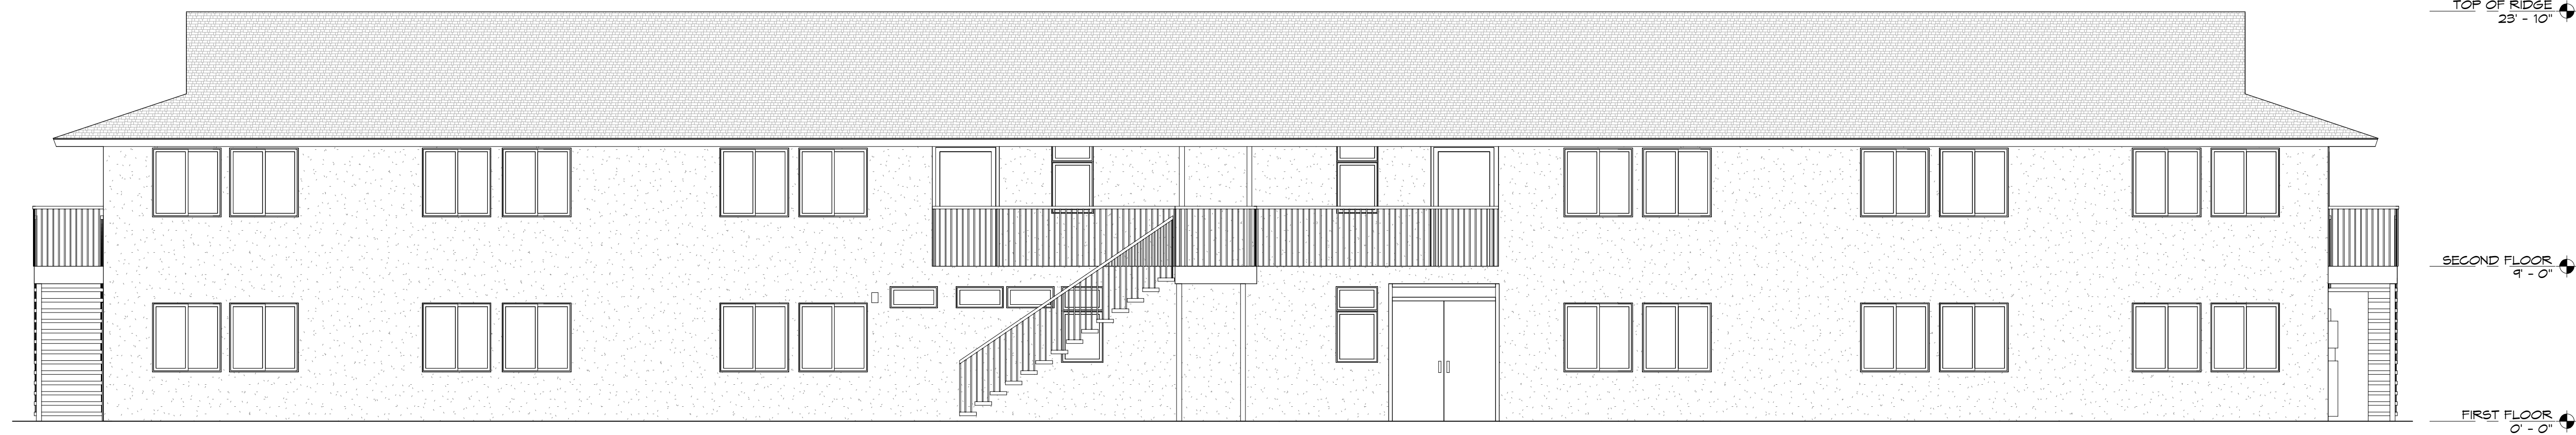

**1 FRONT**  
3/16" = 1'-0"

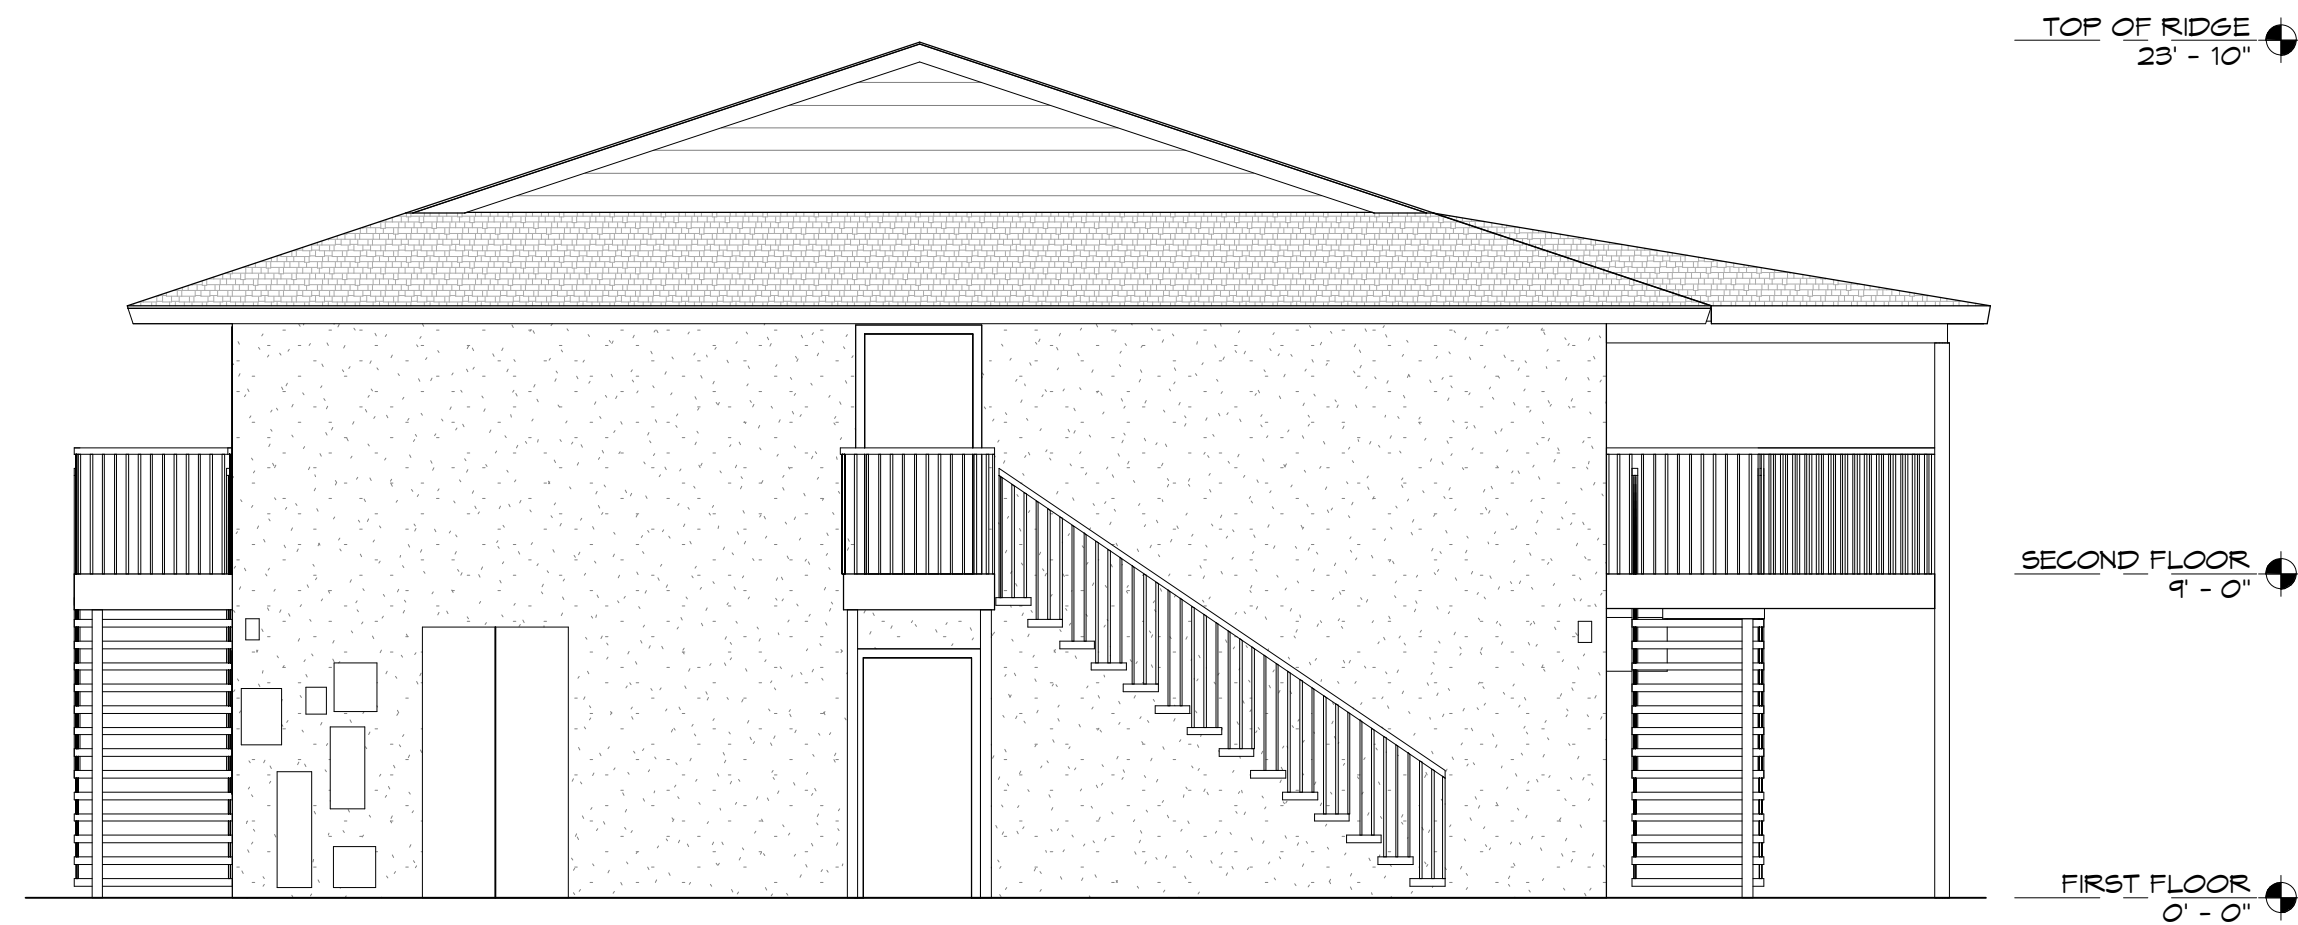

**2 LEFT**  
3/16" = 1'-0"

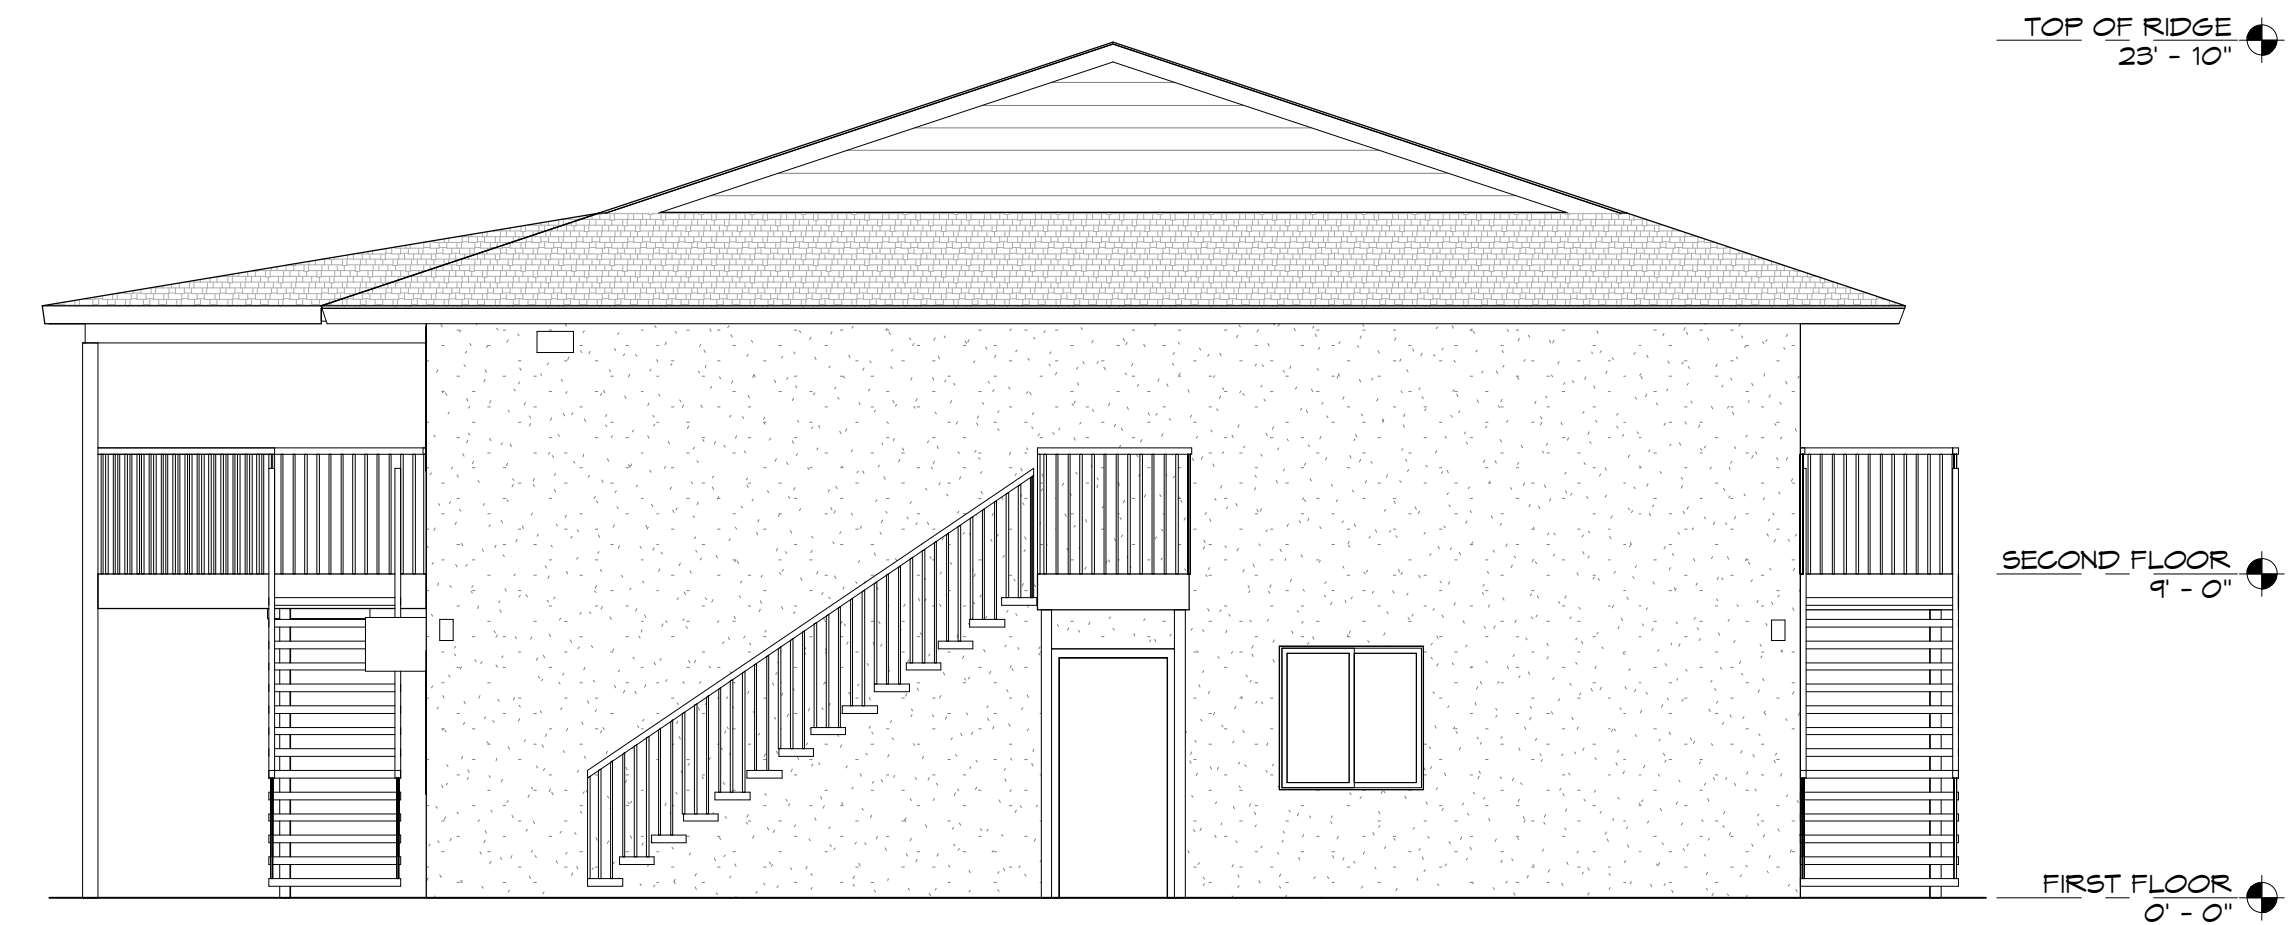

**3 RIGHT**  
3/16" = 1'-0"



**4 BACK**  
3/16" = 1'-0"

**ARCHITECTURAL AS BUILT**  
**Point Reyes Station, CA**


01	100% SUBMISSION	SEE COVER SHEET
NO.	ISSUES / REVISIONS	DATE
SHEET TITLE		

**EXTERIOR ELEVATIONS**


Designer	PROJECT MANAGER
Designer	PROJECT DIRECTOR
Project Number	PROJECT NUMBER
Author	DRAWN BY
	SHEET NUMBER

**AB-6**




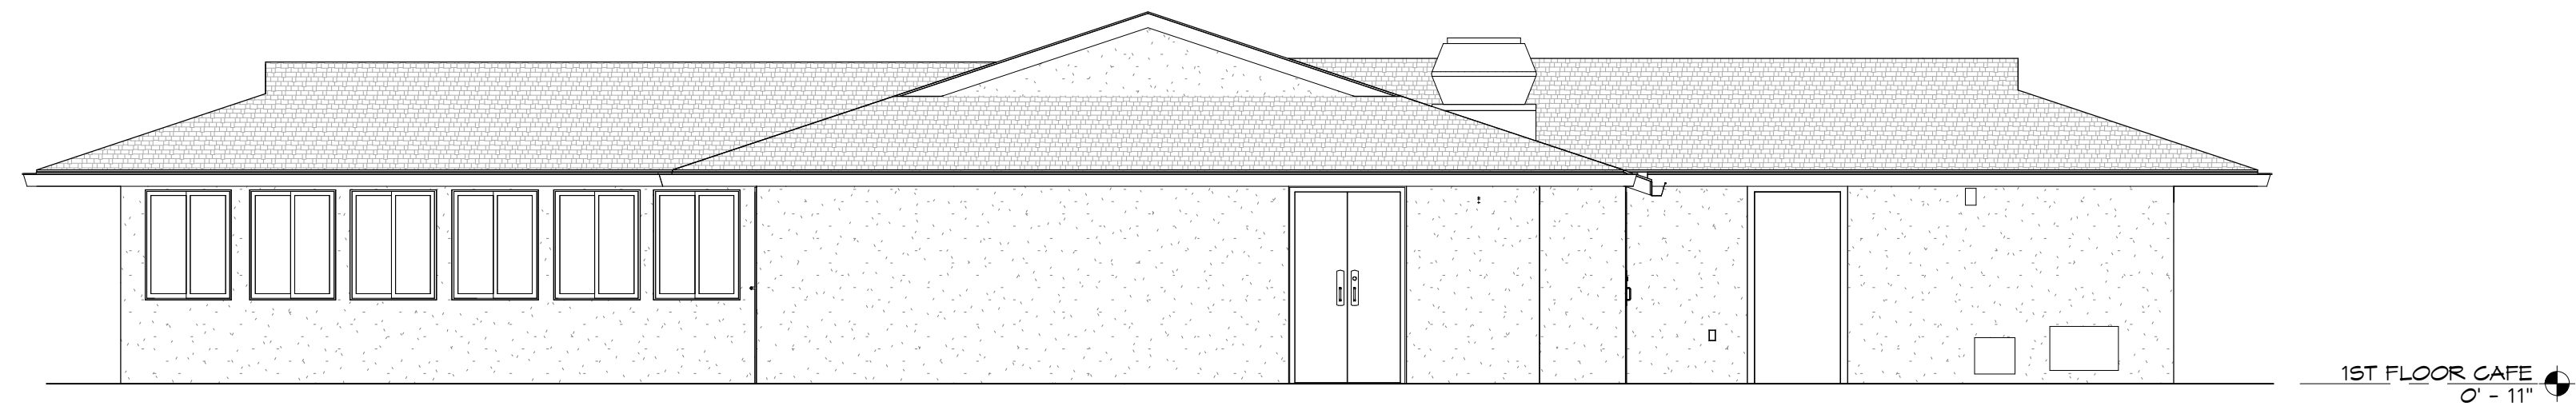


**1 CAFE FRONT**  
3/16" = 1'-0"

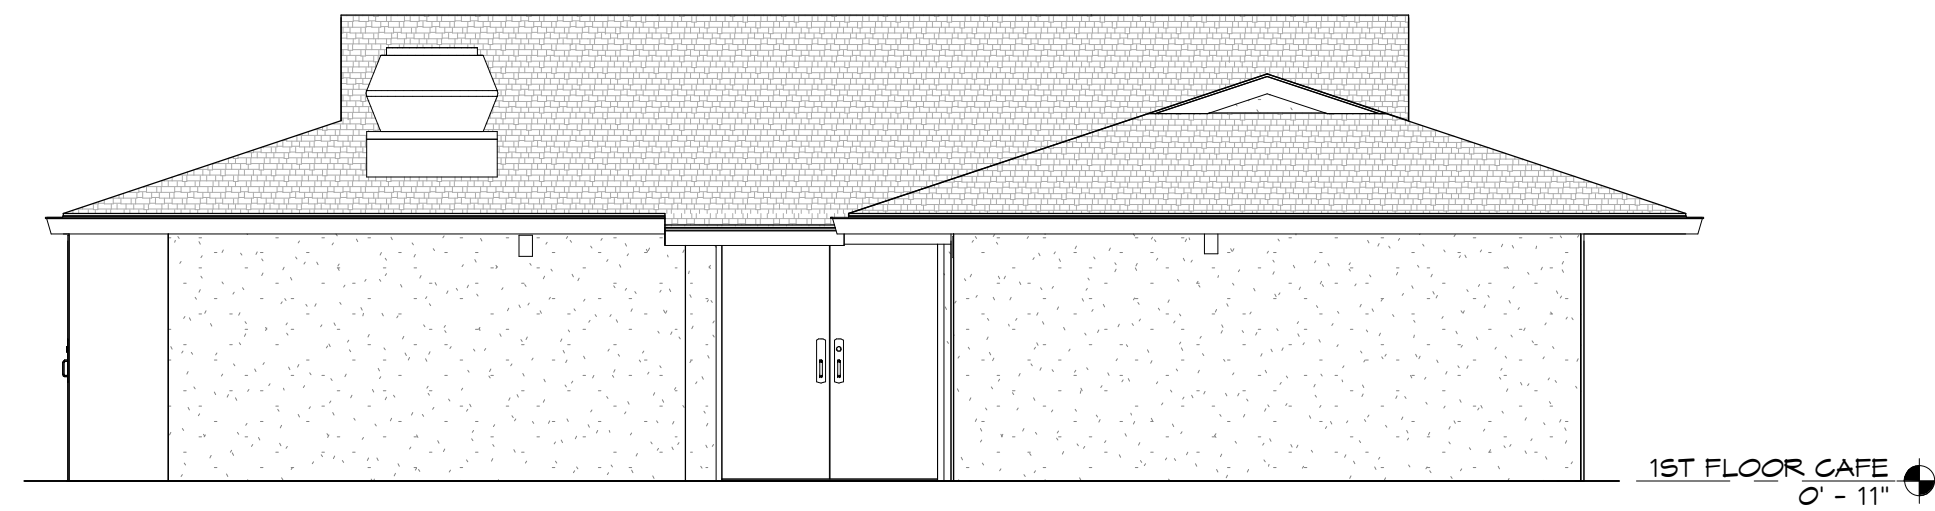

**2 CAFE LEFT**  
3/16" = 1'-0"

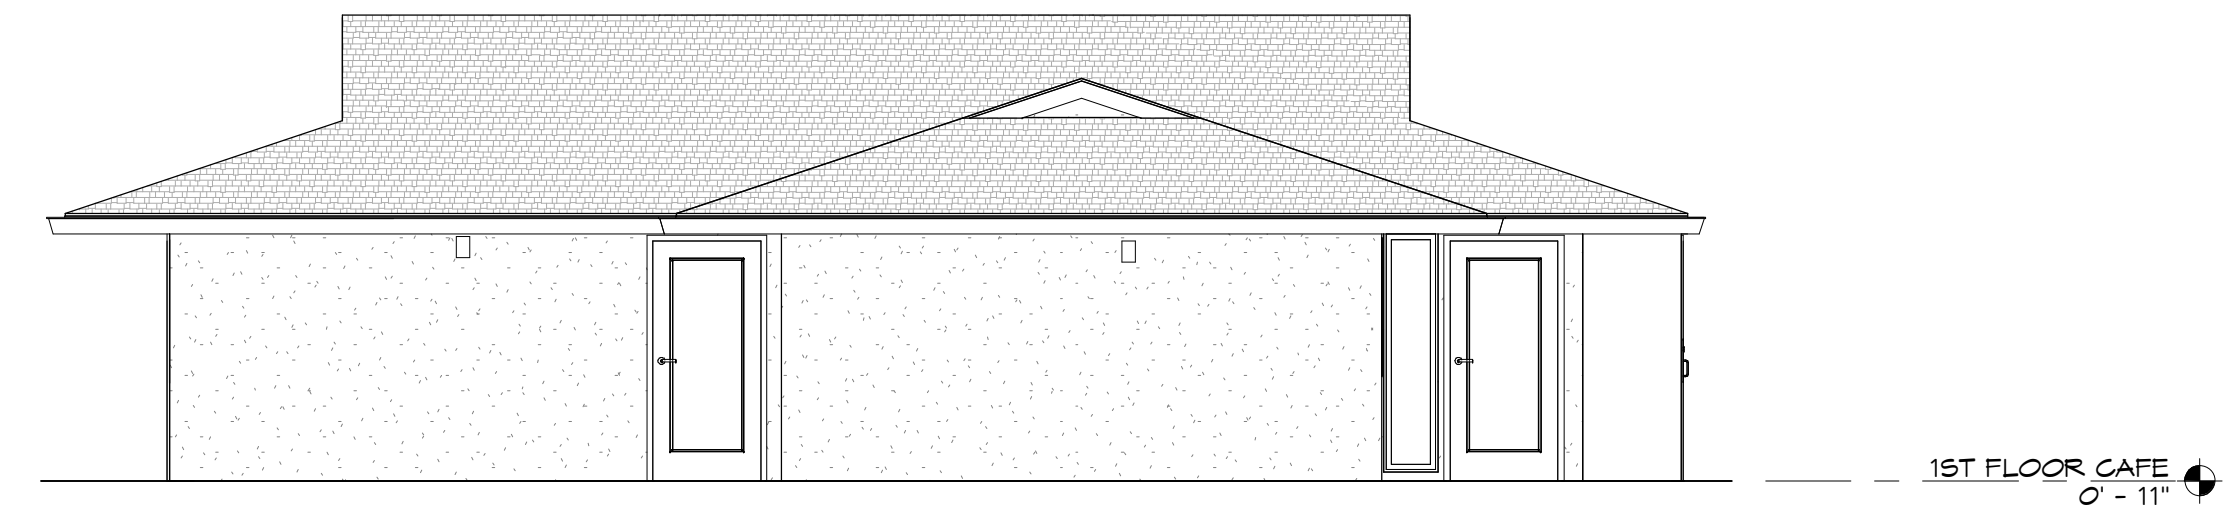

**3 CAFE RIGHT**  
3/16" = 1'-0"

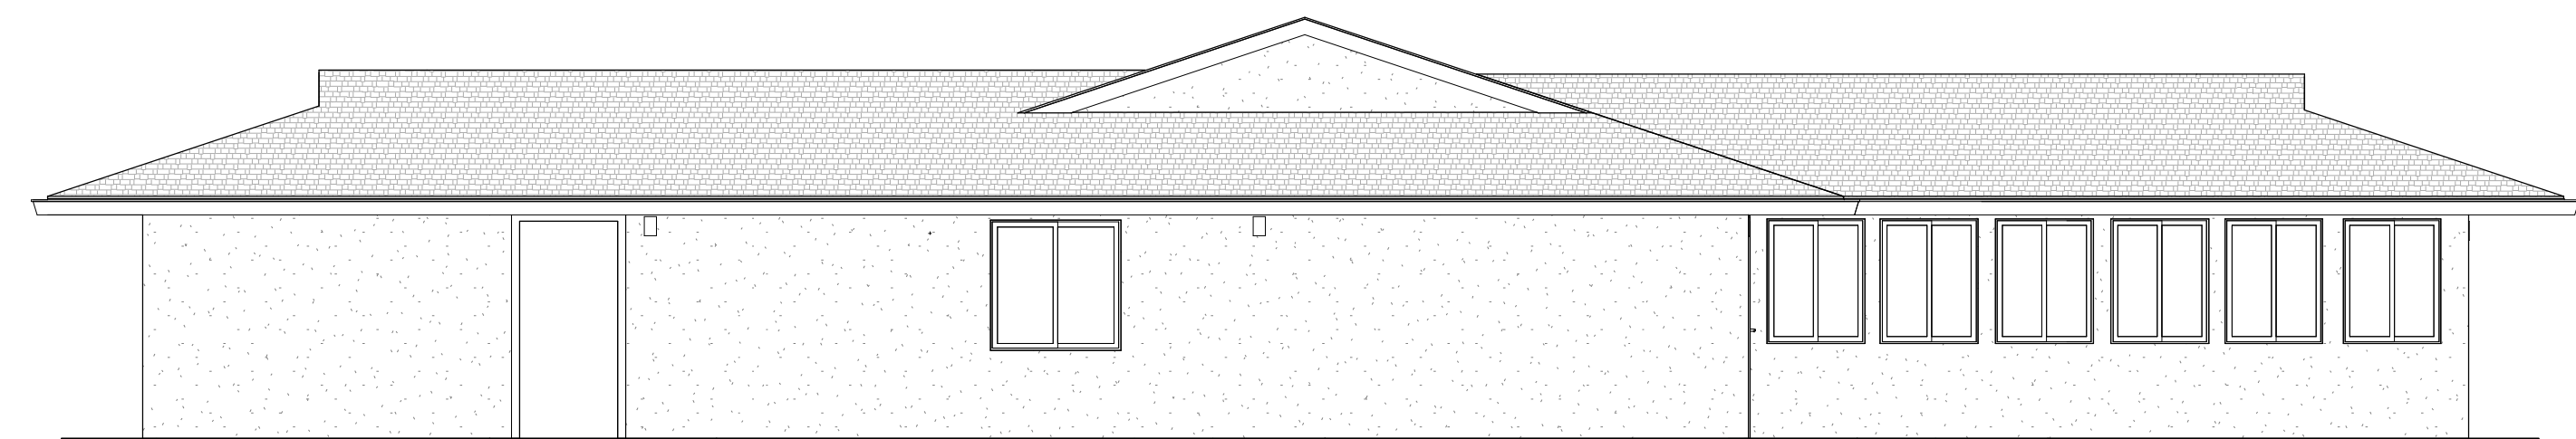

**4 CAFE BACK**  
3/16" = 1'-0"

**ARCHITECTURAL AS BUILT**  
**Point Reyes Station, CA**


NO.	ISSUES / REVISIONS	DATE	SHEET TITLE
01	100% SUBMISSION		SEE COVER SHEET

**EXTERIOR ELEVATIONS**

Designer	PROJECT MANAGER
Designer	PROJECT DIRECTOR
Project Number	PROJECT NUMBER
Author	DRAWN BY
	SHEET NUMBER

**AB-7**

**ARCHITECTURAL AS BUILT**  
**Point Reyes Station, CA**

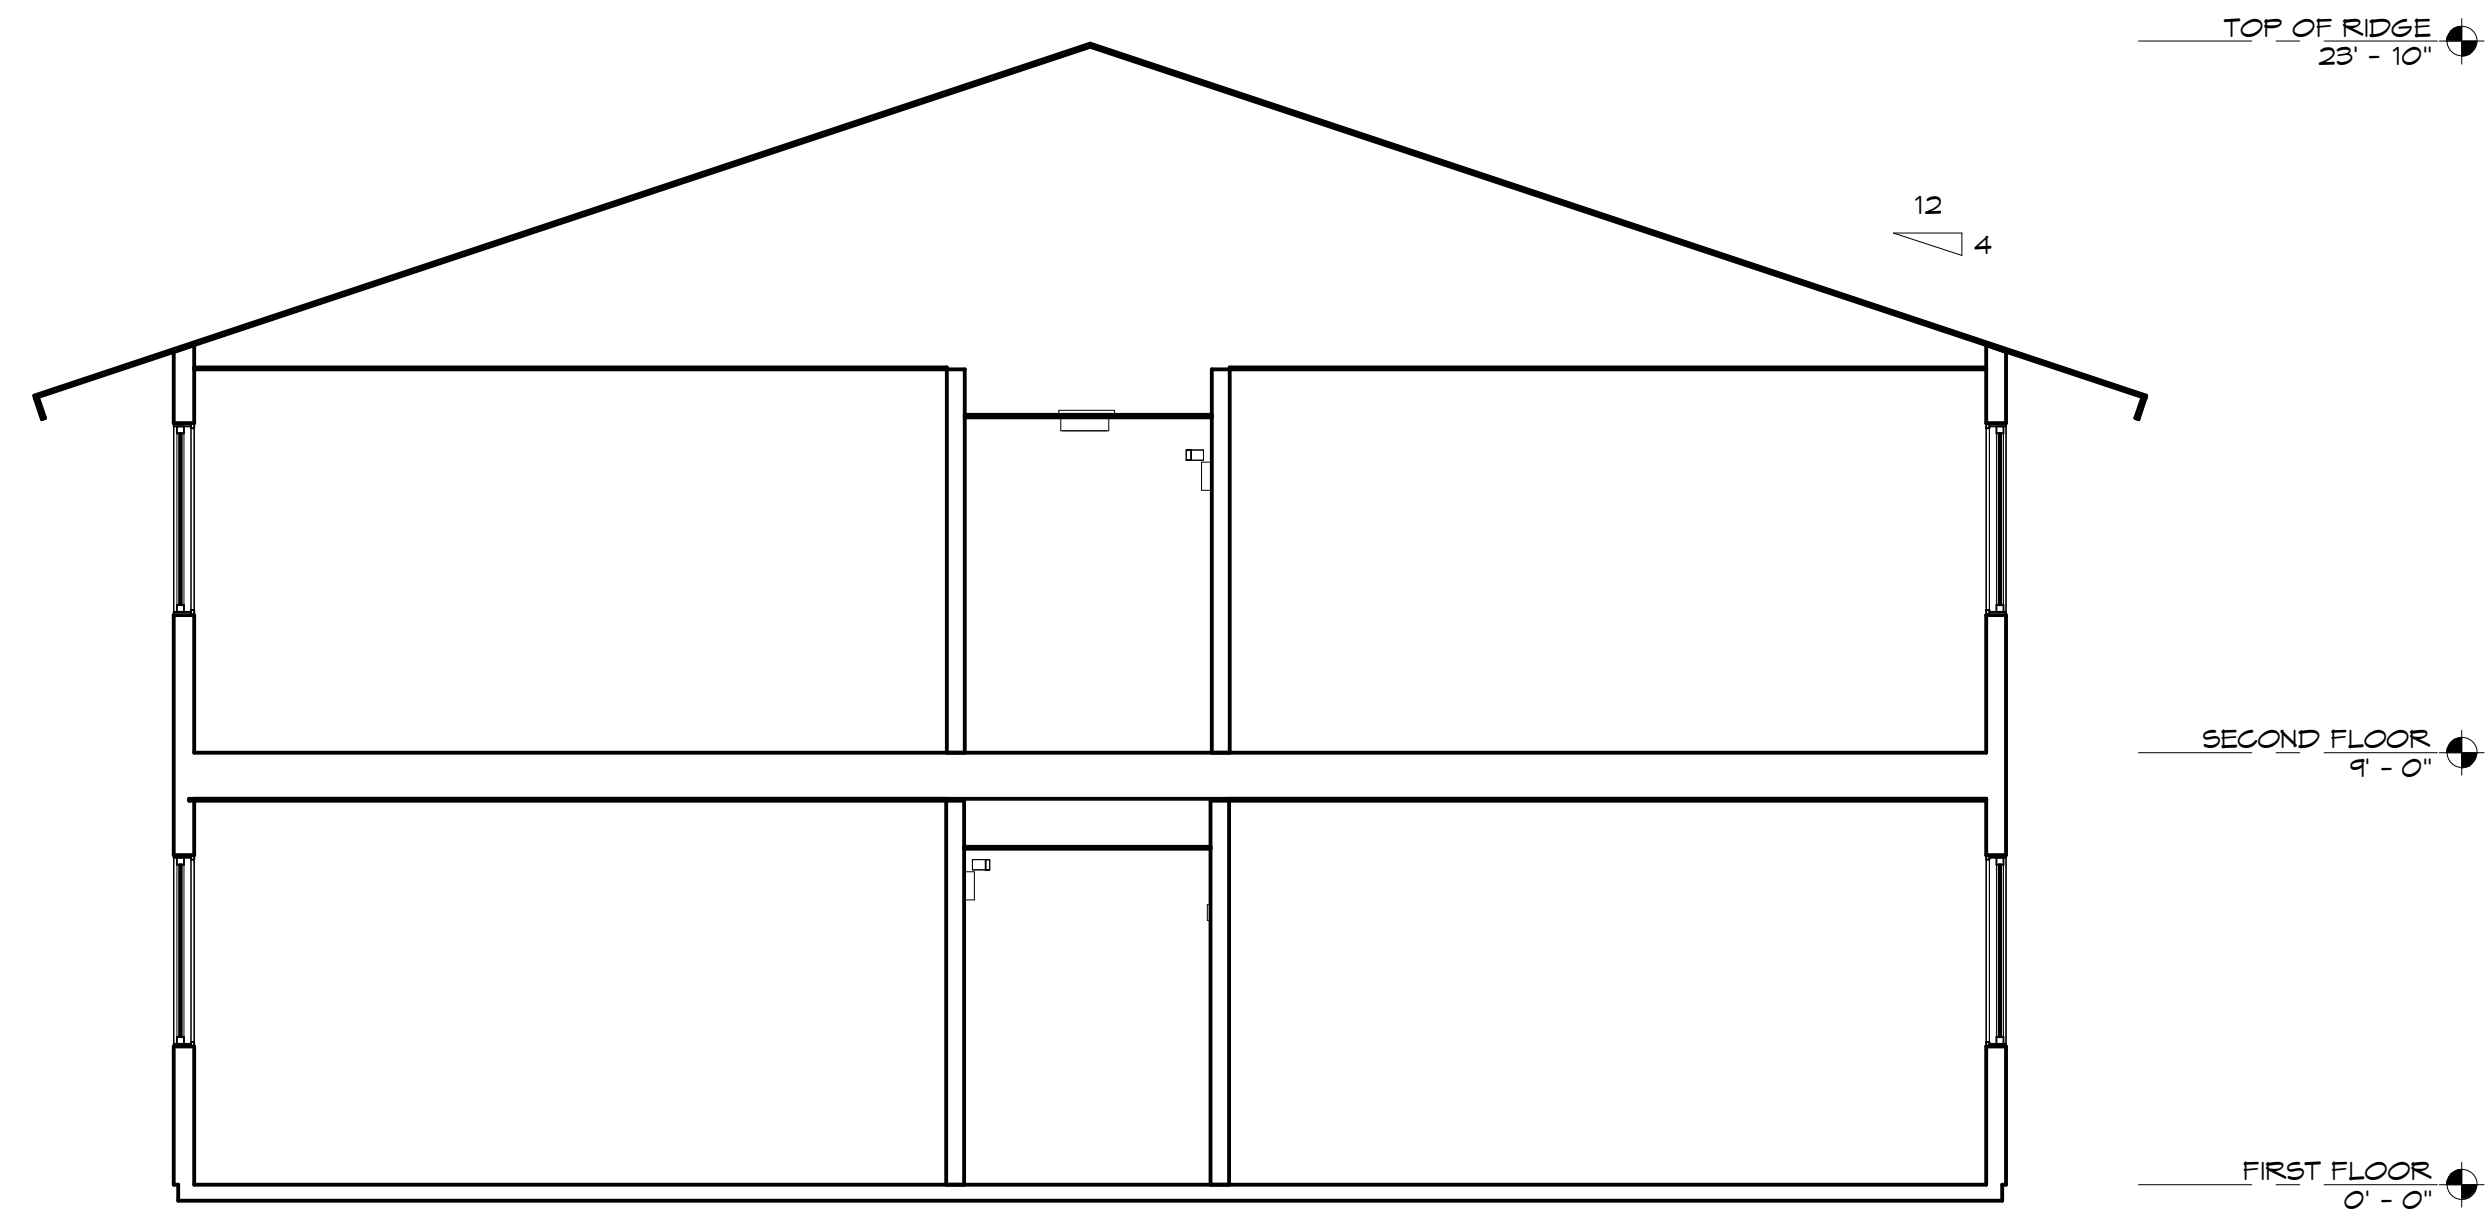


**1 BUILDING SECTION**  
 1/4" = 1'-0"

NO.	ISSUES / REVISIONS	DATE
01	100% SUBMISSION	SEE COVER SHEET


**BUILDING SECTION**

Designer	PROJECT MANAGER
Designer	PROJECT DIRECTOR
Project Number	PROJECT NUMBER
Author	DRAWN BY
	SHEET NUMBER


**AB-8**

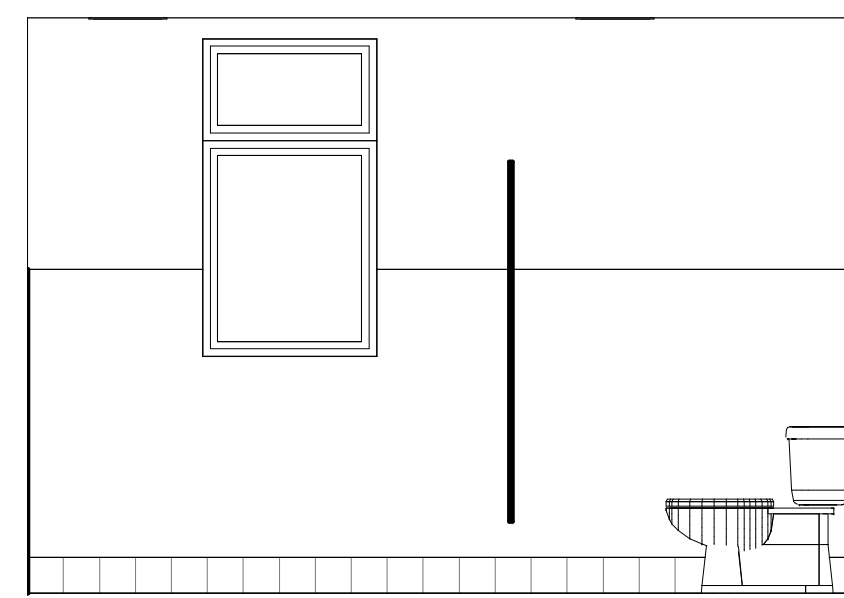


1 BATH 1 - A  
 3/8" = 1'-0"

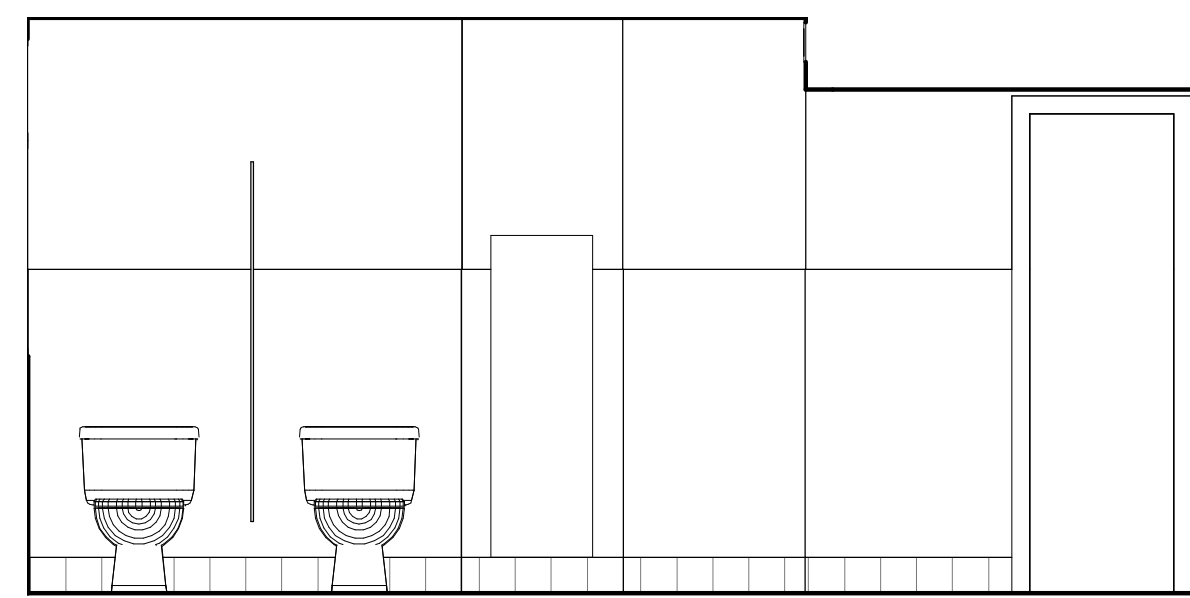


2 BATH 1 - B  
 3/8" = 1'-0"

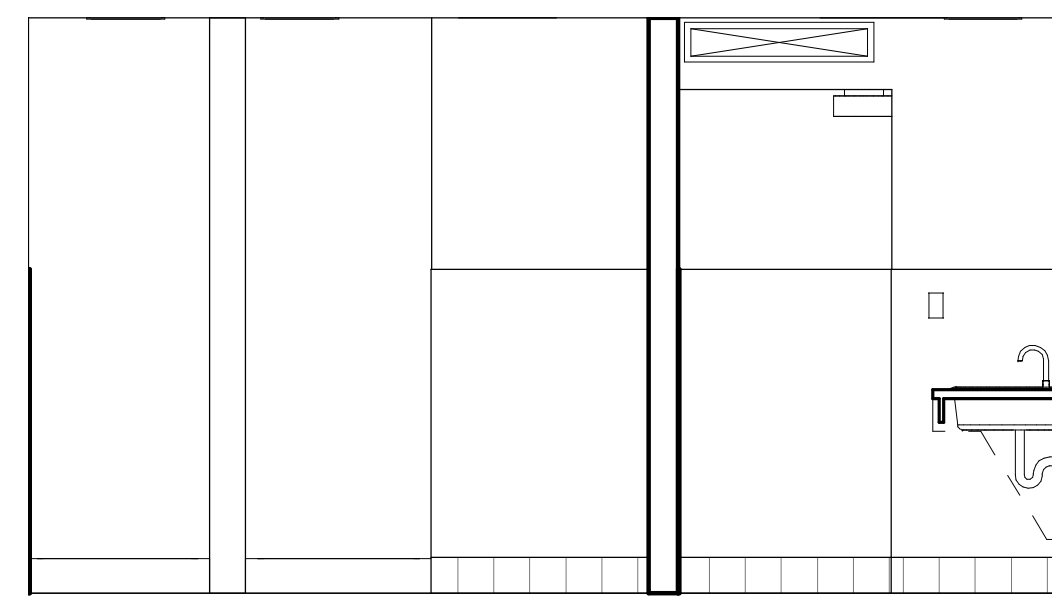


3 BATH 1 - C  
 3/8" = 1'-0"

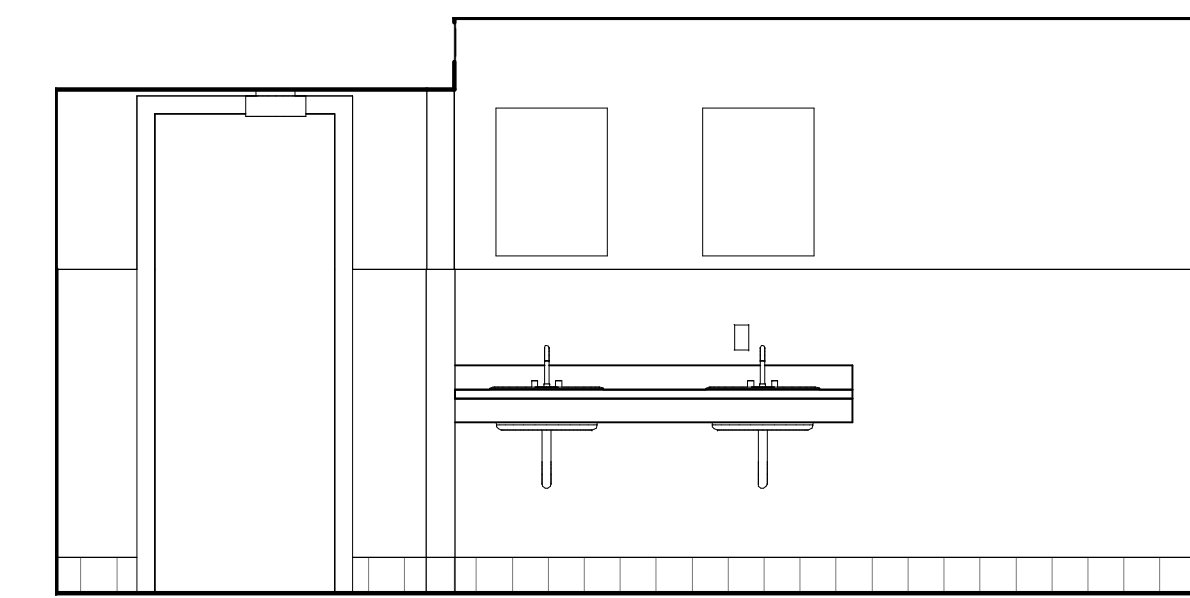


4 BATH 1 - D  
 3/8" = 1'-0"

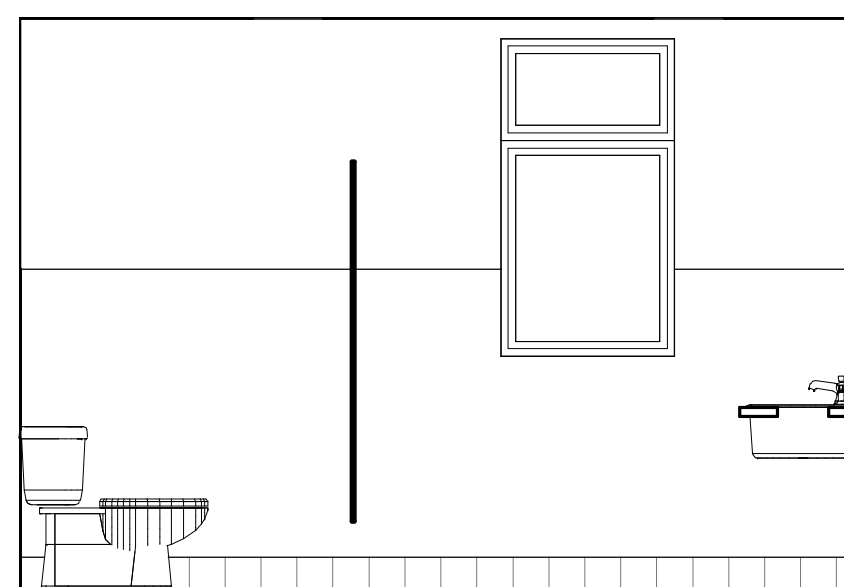


5 BATH 2 - A  
 3/8" = 1'-0"

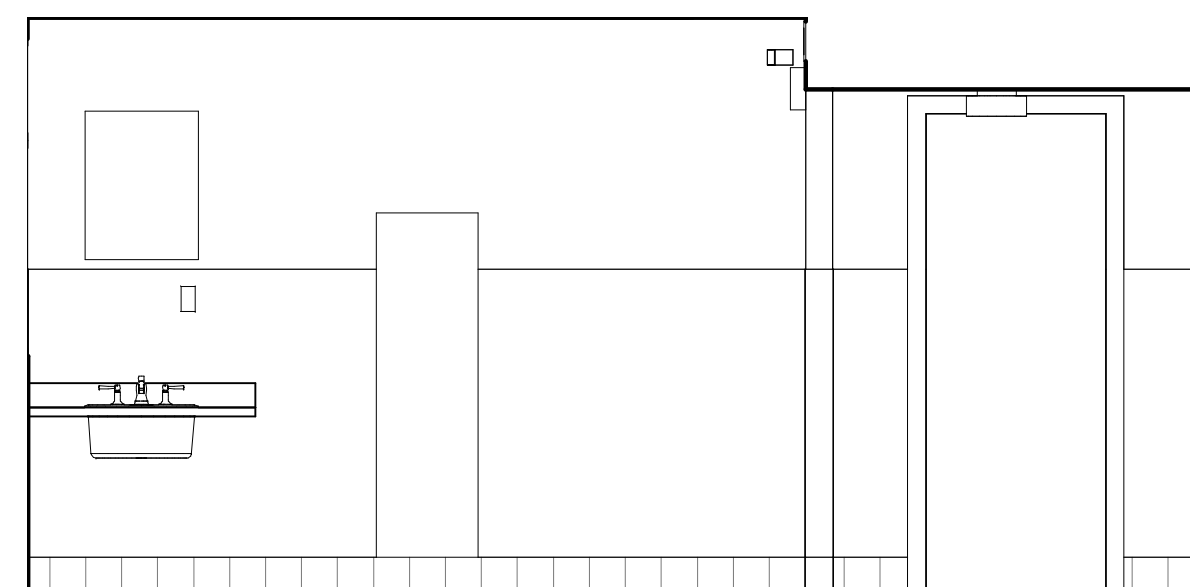


6 BATH 2 - B  
 3/8" = 1'-0"

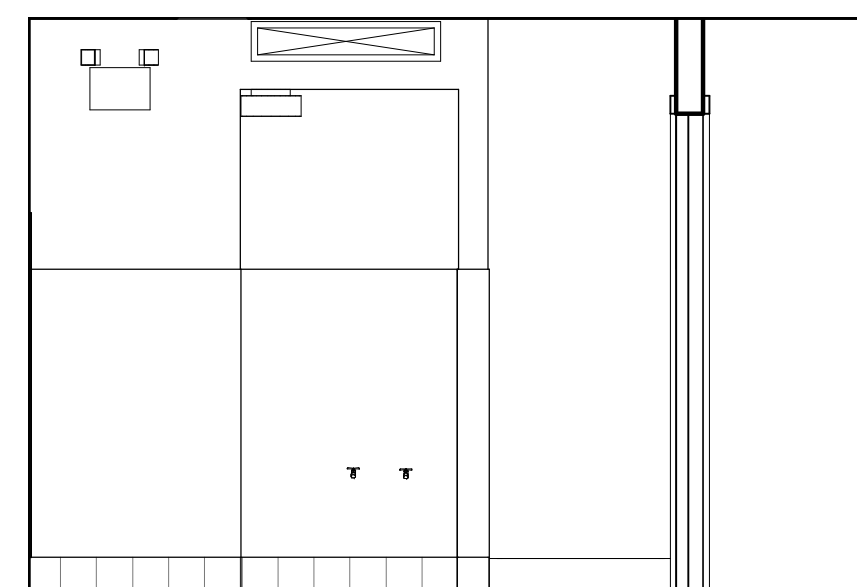


7 BATH 2 - C  
 3/8" = 1'-0"

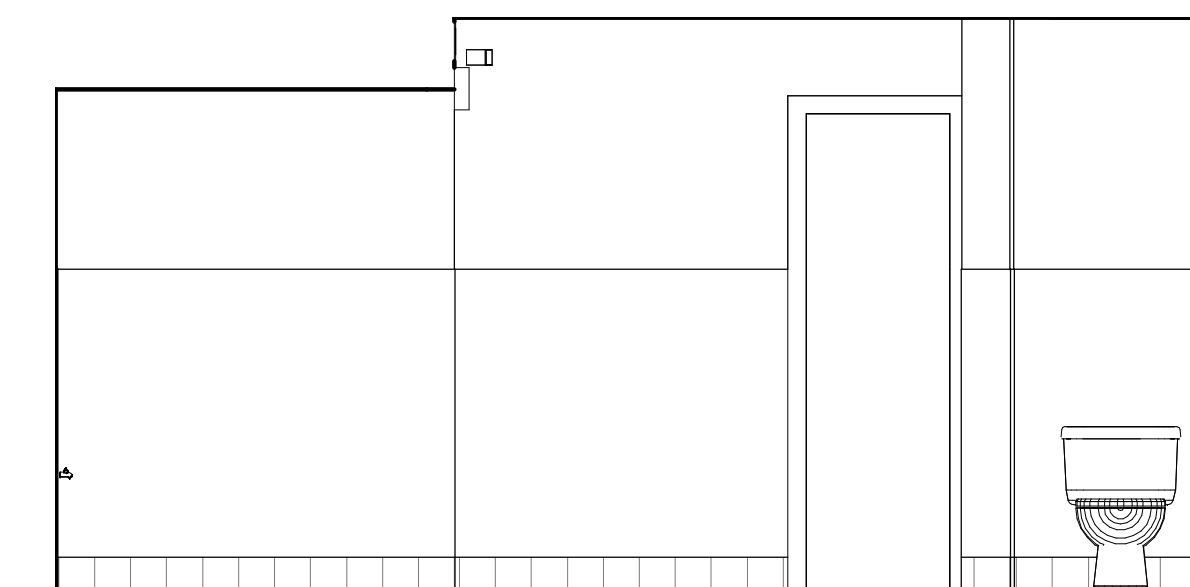


8 BATH 2 - D  
 3/8" = 1'-0"

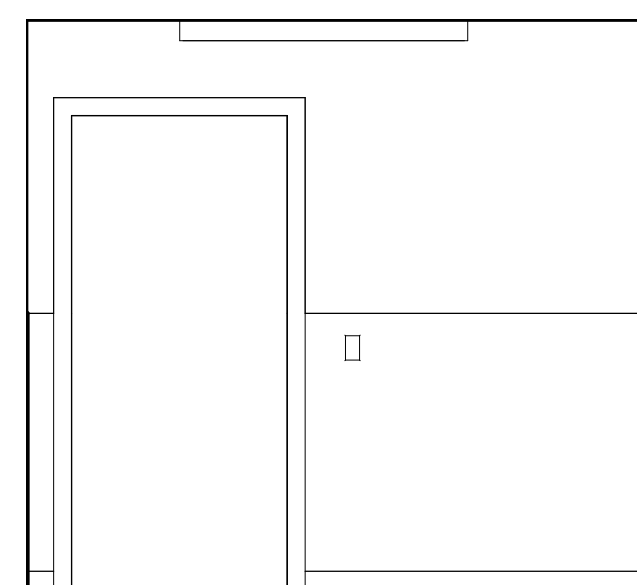


9 WC - A  
 3/8" = 1'-0"

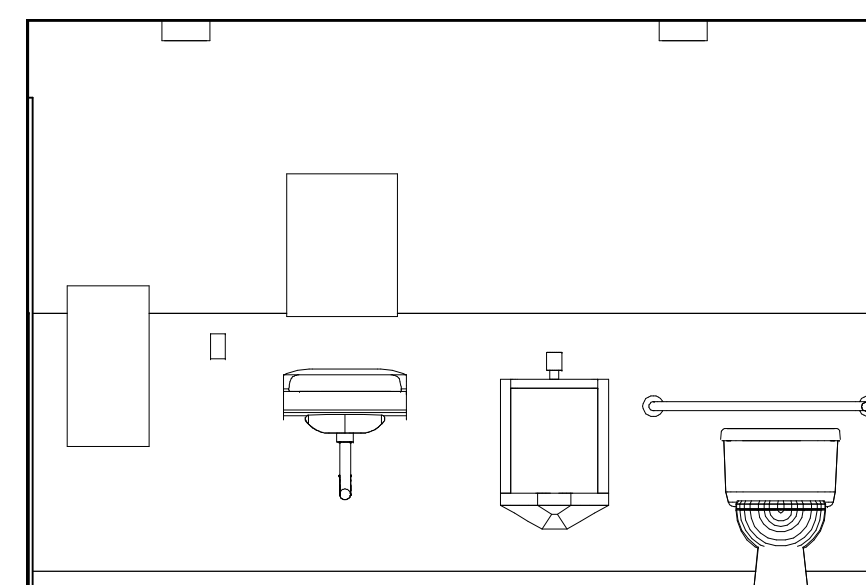

10 WC - B  
 3/8" = 1'-0"

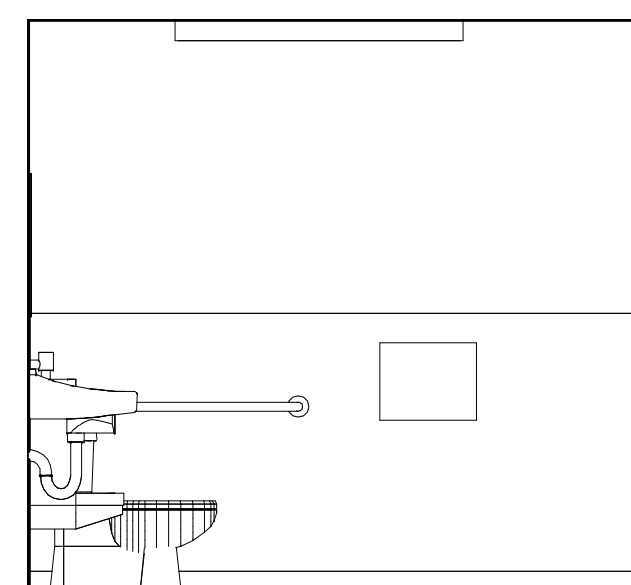

11 WC - C  
 3/8" = 1'-0"

 


12 WC - D  
 3/8" = 1'-0"

**ARCHITECTURAL AS BUILT**  
**Point Reyes Station, CA**

NO.	ISSUES / REVISIONS	DATE
01	100% SUBMISSION	SEE COVER SHEET

**INTERIOR ELEVATIONS**

Designer	PROJECT MANAGER
Designer	PROJECT DIRECTOR
Project Number	PROJECT NUMBER
Author	DRAWN BY
	SHEET NUMBER

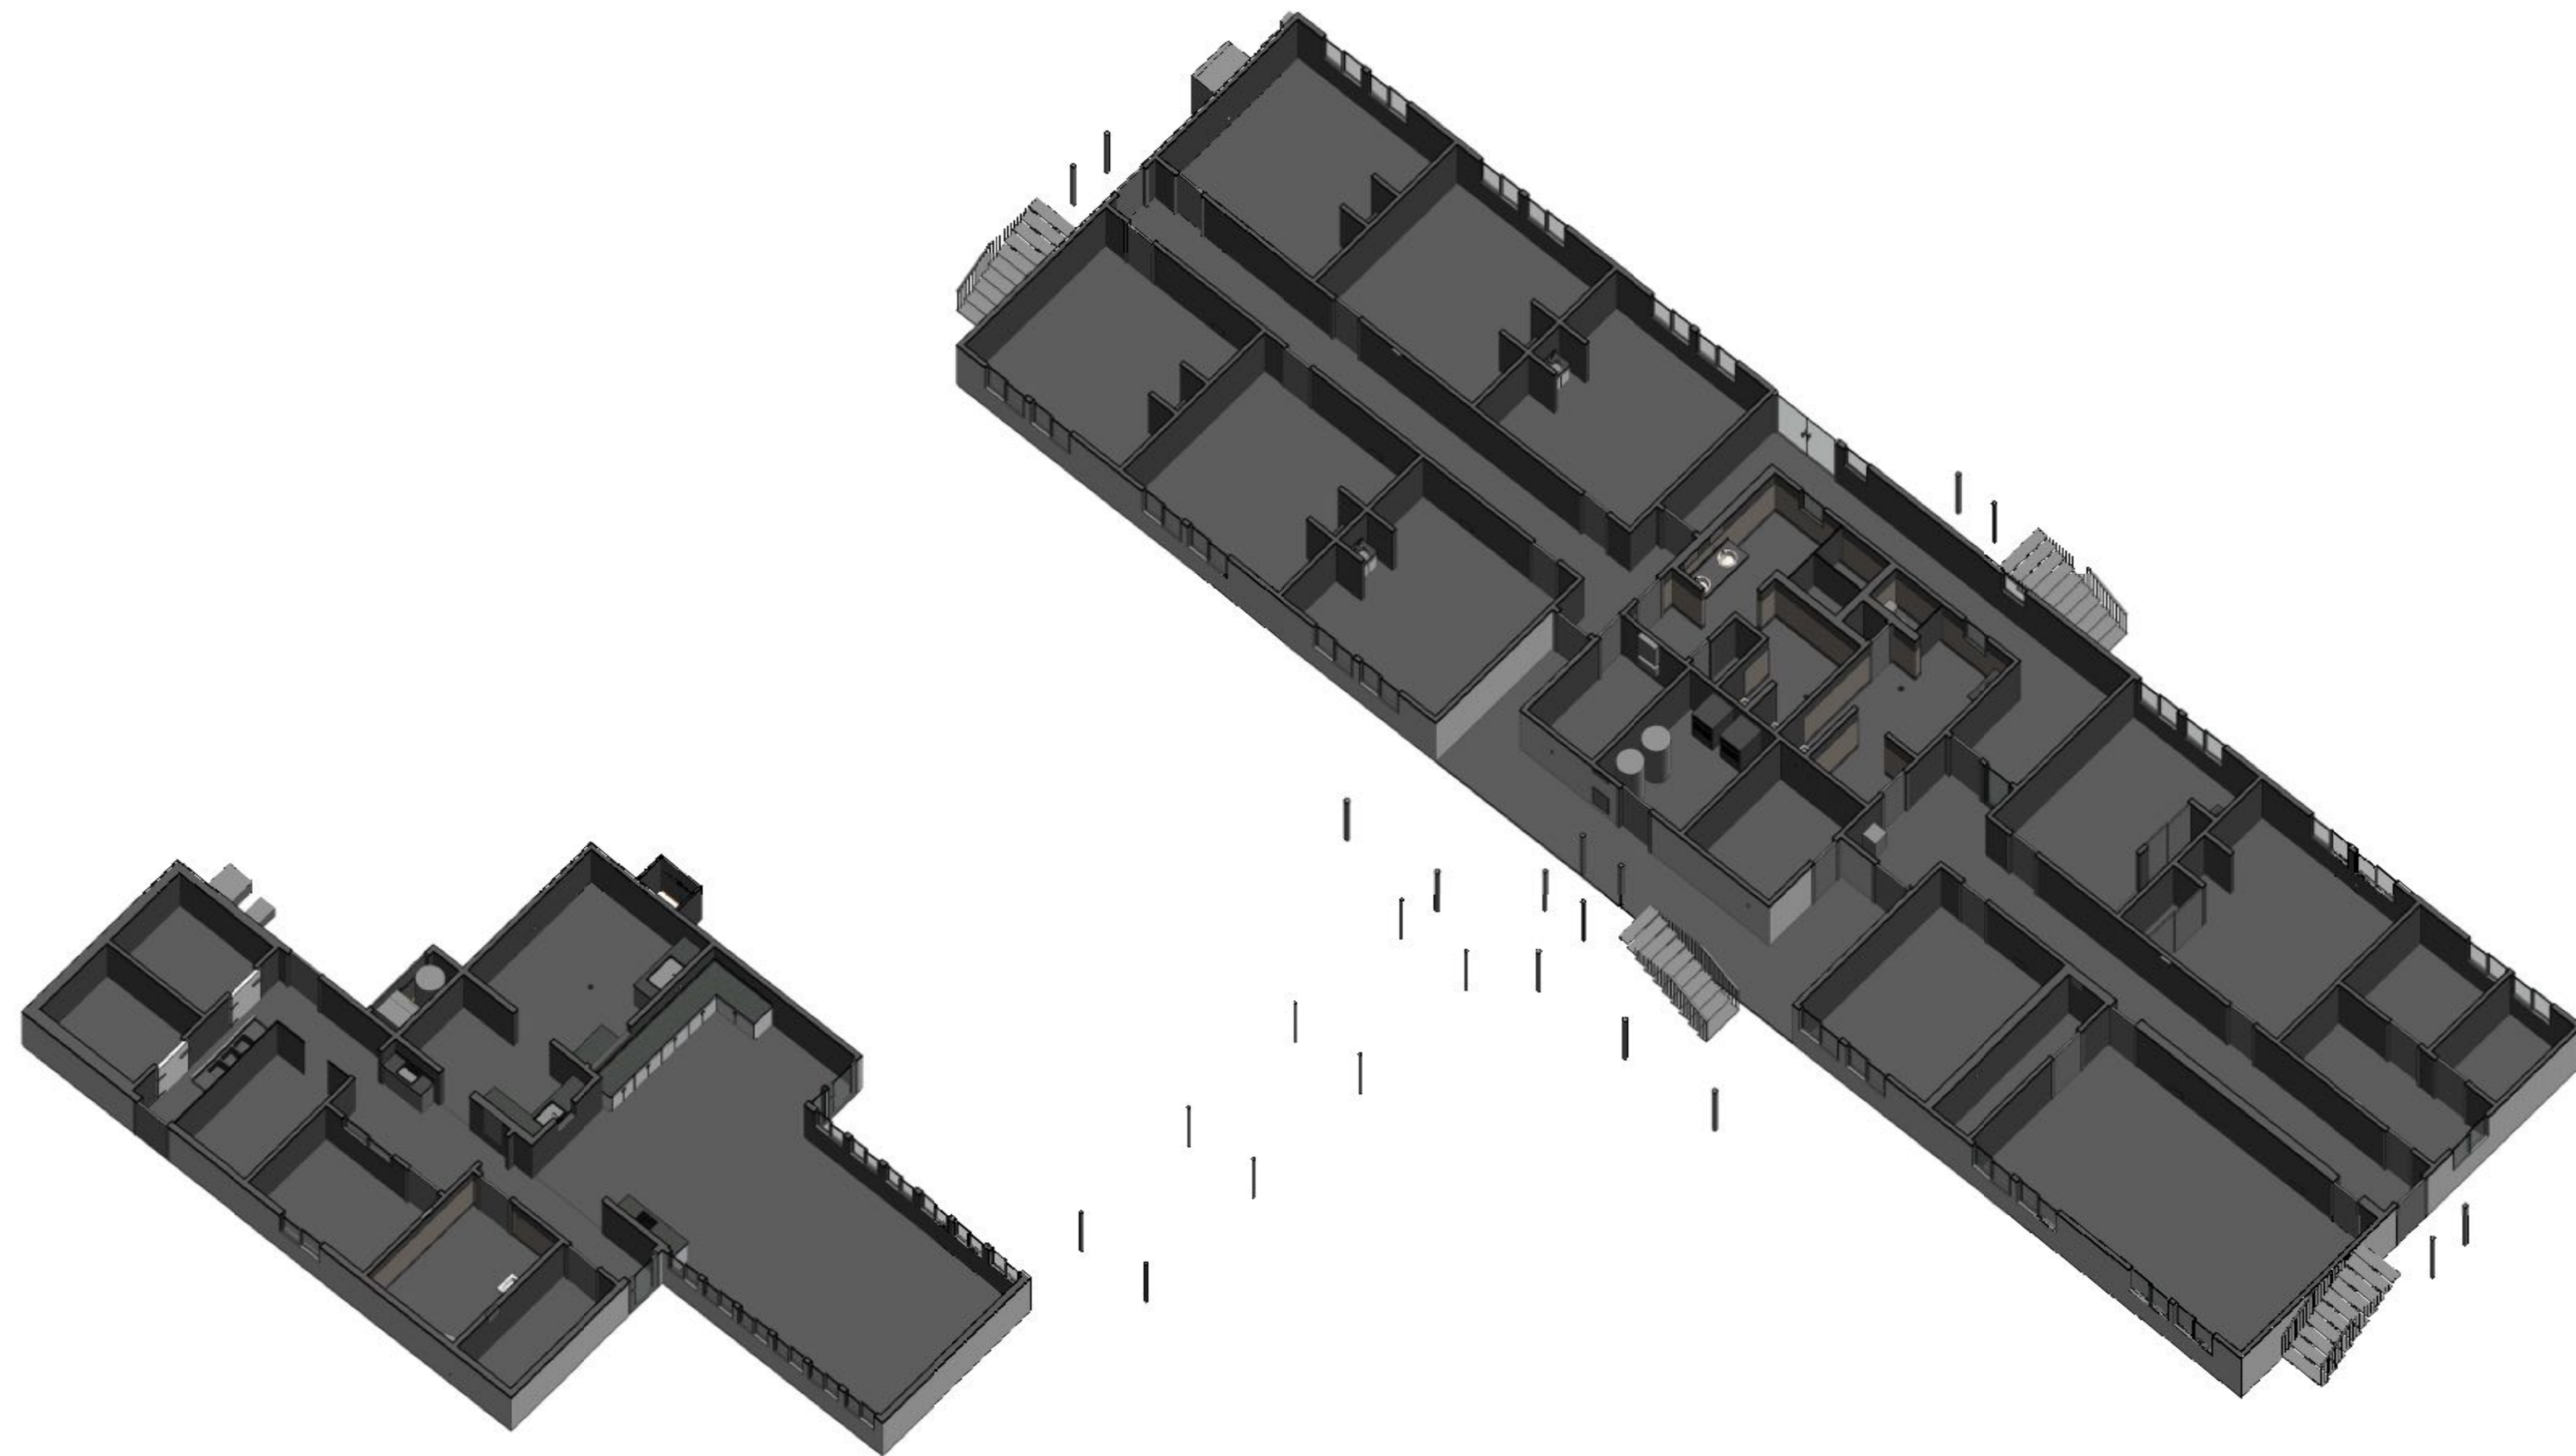


**ARCHITECTURAL AS BUILT**  
**Point Reyes Station, CA**

NO.	ISSUES / REVISIONS	DATE
01	100% SUBMISSION	SEE COVER SHEET

**3D FIRST FLOOR SECTION**

Designer	PROJECT MANAGER
Designer	PROJECT DIRECTOR
Project Number	PROJECT NUMBER
Author	DRAWN BY
	SHEET NUMBER

**AB-10**

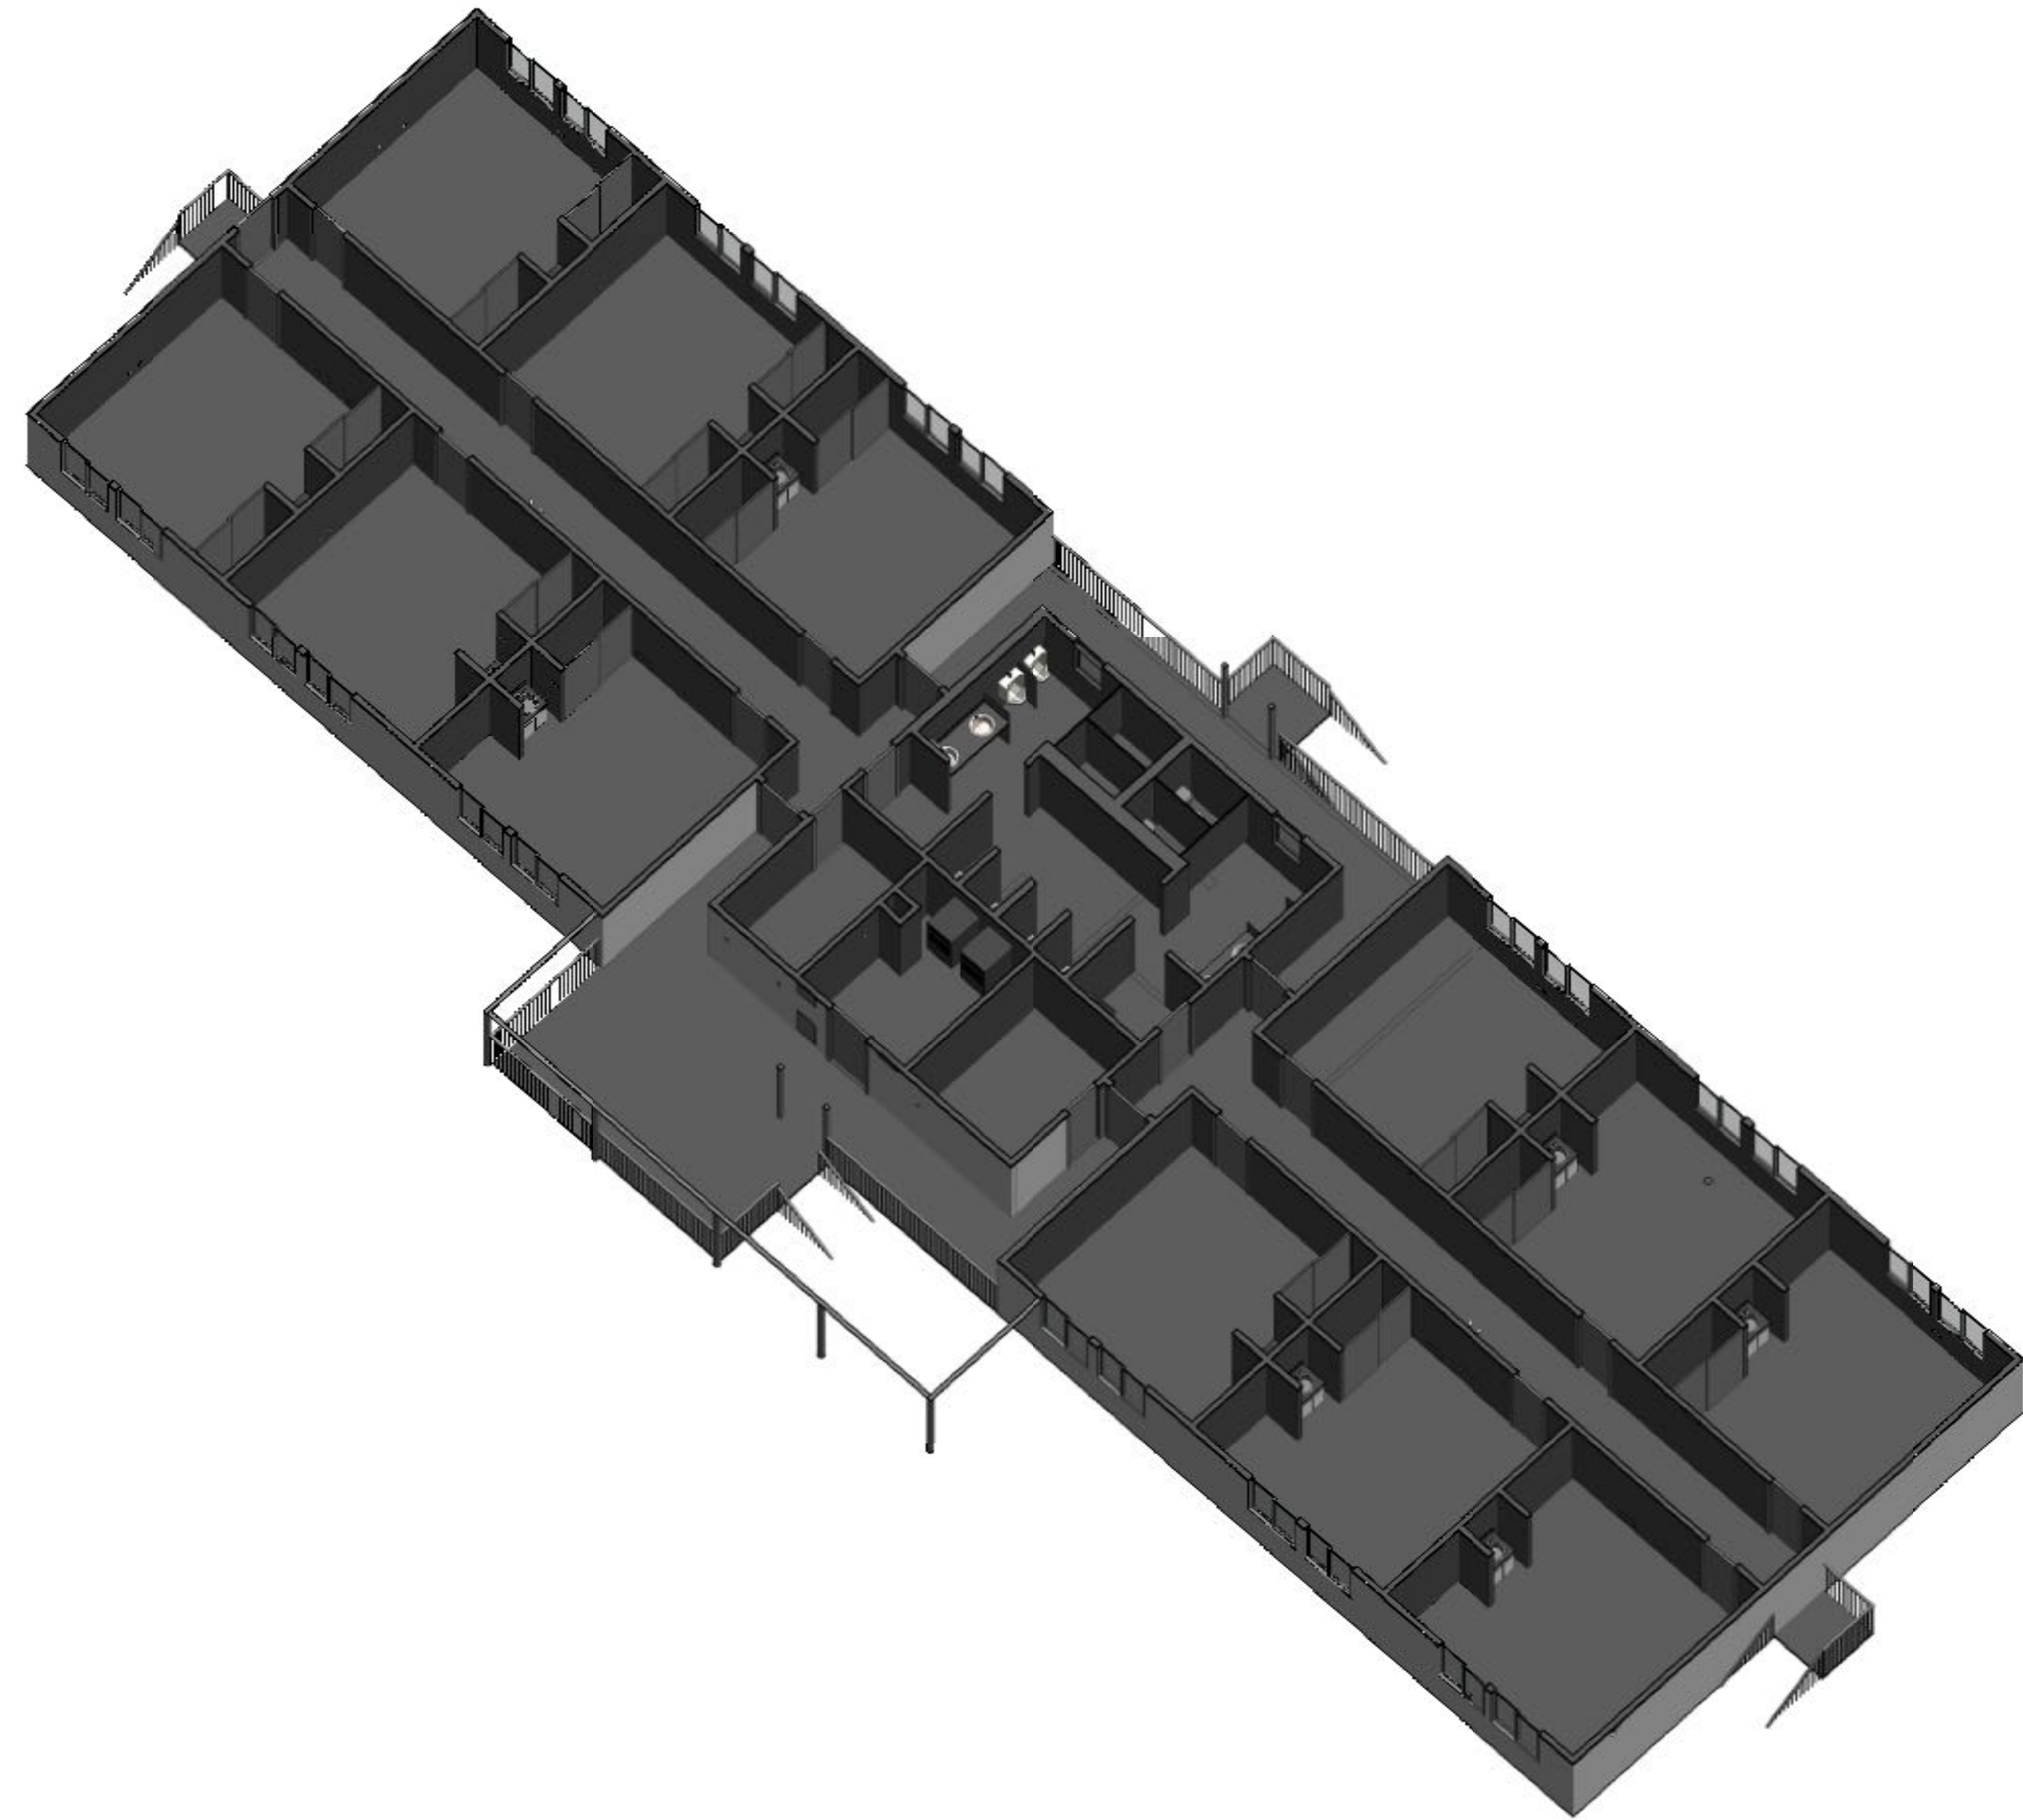



**ARCHITECTURAL AS BUILT**  
**Point Reyes Station, CA**

01	100% SUBMISSION	SEE COVER SHEET
NO.	ISSUES / REVISIONS	DATE
		SHEET TITLE

**3D SECOND FLOOR SECTION**

Designer	PROJECT MANAGER
Designer	PROJECT DIRECTOR
Project Number	PROJECT NUMBER
	SCALE
Author	DRAWN BY
	SHEET NUMBER

**AB-11**

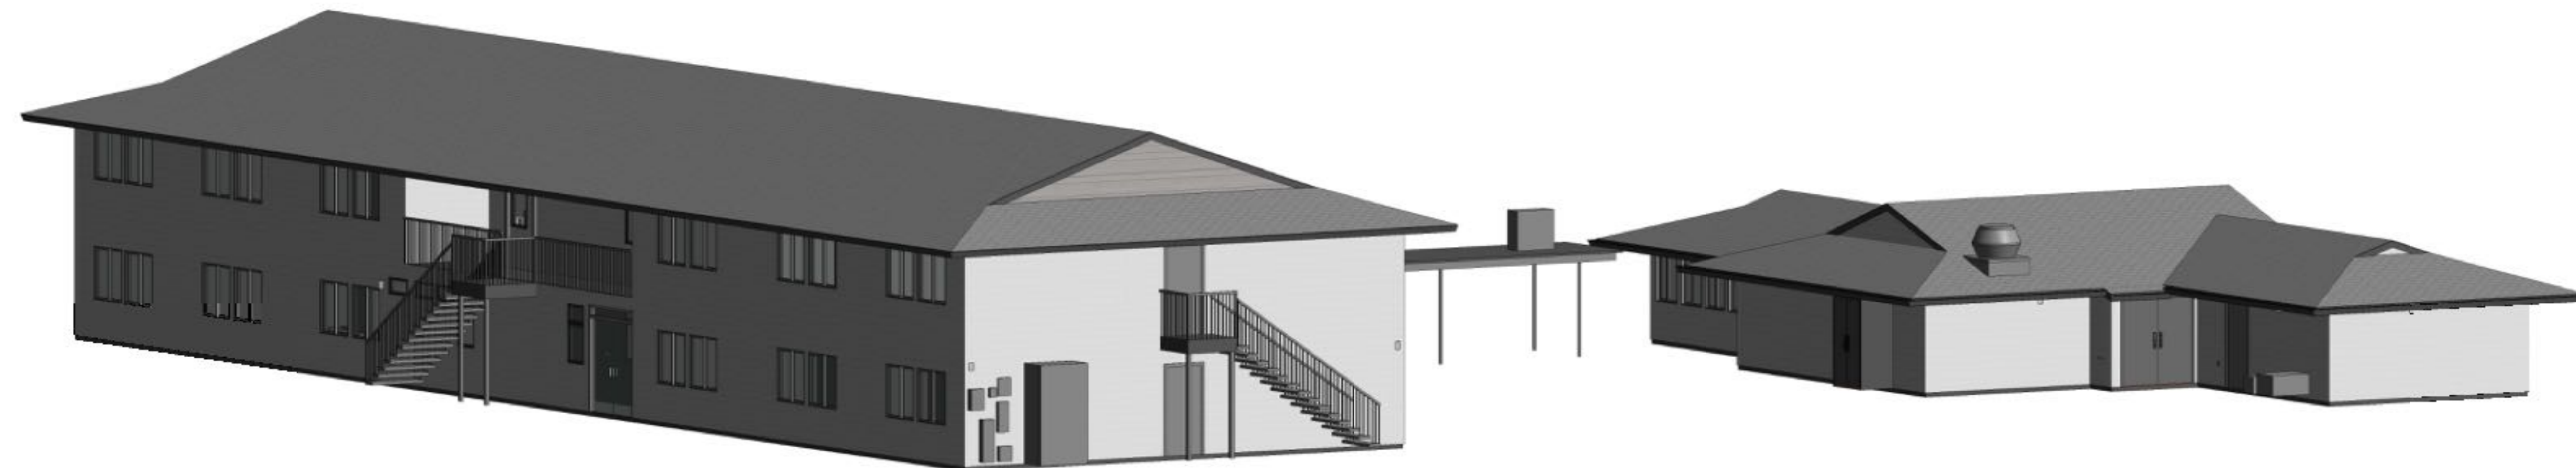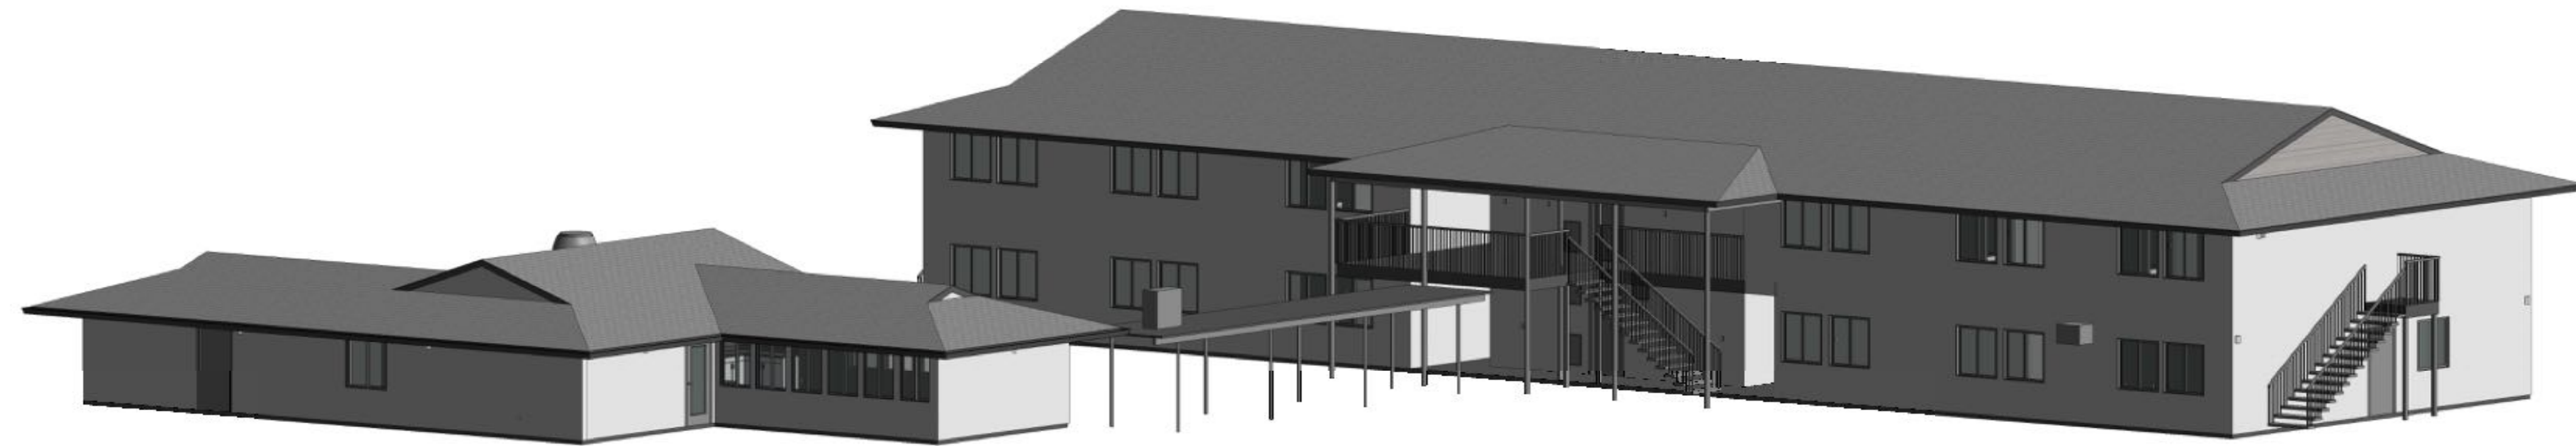



**ARCHITECTURAL AS BUILT**  
**Point Reyes Station, CA**

01	100% SUBMISSION	SEE COVER SHEET
NO.	ISSUES / REVISIONS	DATE
SHEET TITLE		

**3D ELEVATIONS**

Designer	PROJECT MANAGER
Designer	PROJECT DIRECTOR
Project Number	PROJECT NUMBER
Author	DRAWN BY
	SHEET NUMBER

**AB-12**

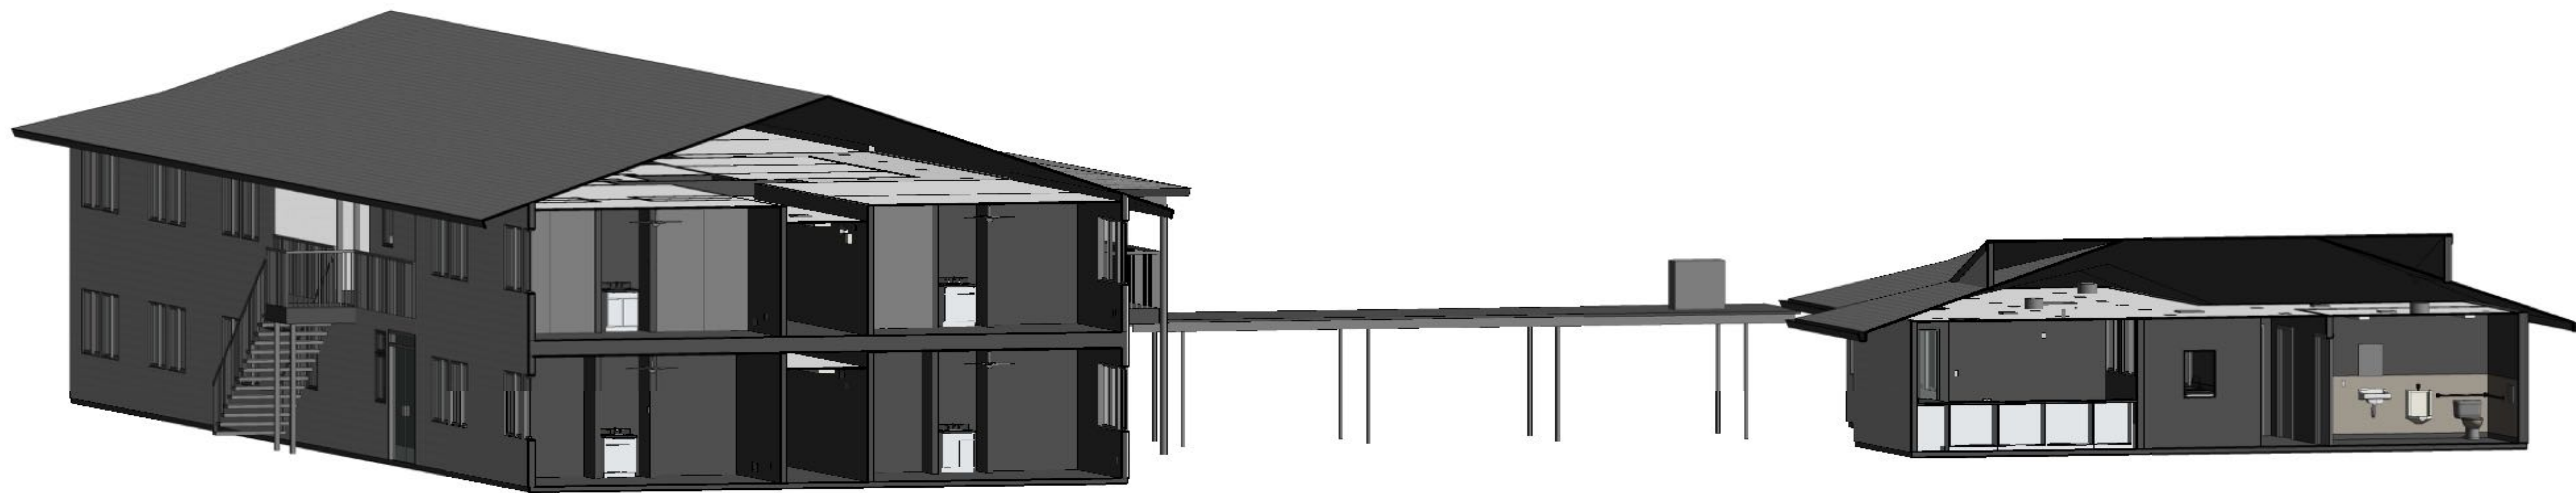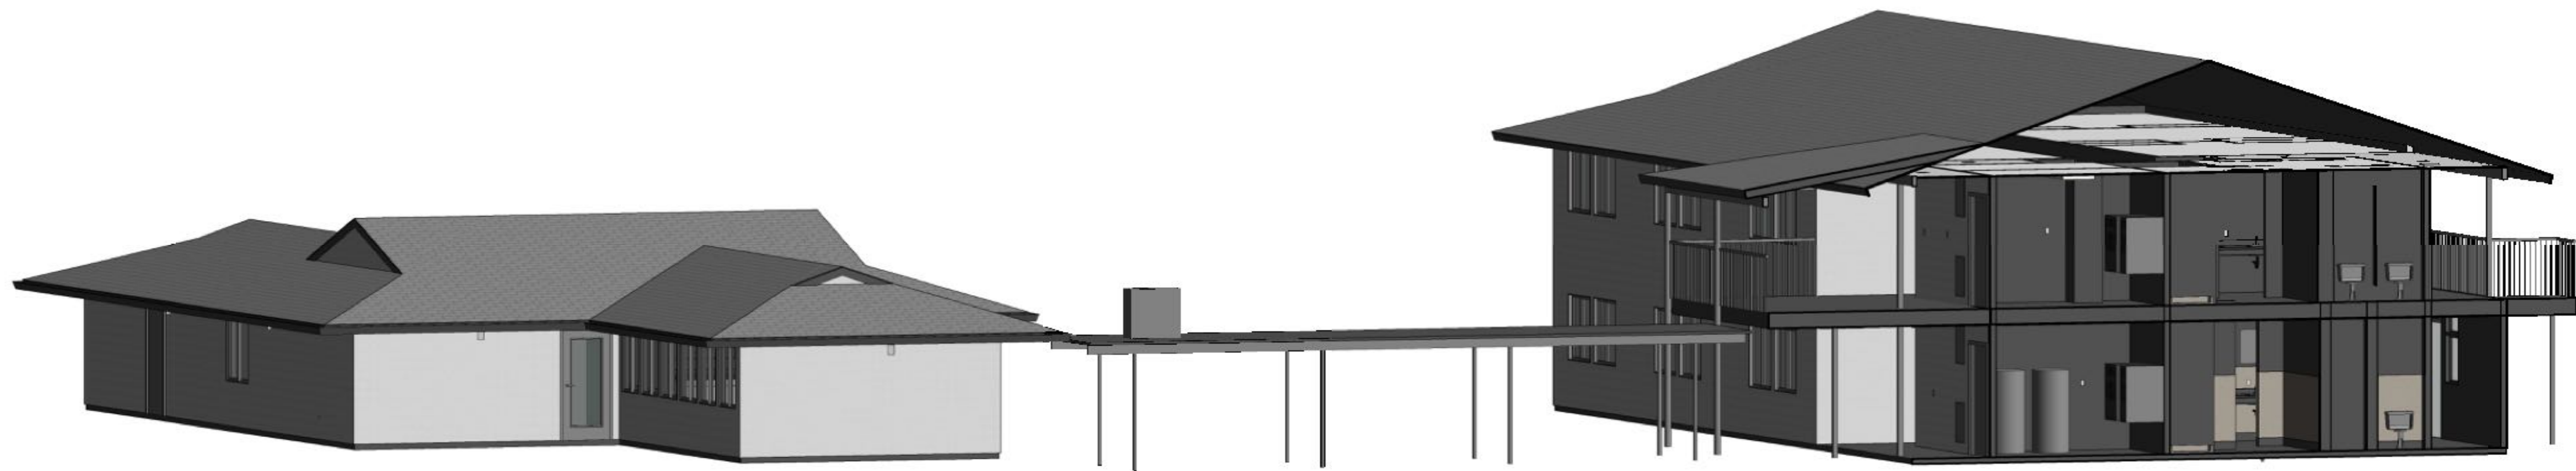

**ARCHITECTURAL AS BUILT**  
**Point Reyes Station, CA**

01	100% SUBMISSION	SEE COVER SHEET
NO.	ISSUES / REVISIONS	DATE
		SHEET TITLE

**3D SECTIONS**

Designer	PROJECT MANAGER
Designer	PROJECT DIRECTOR
Project Number	PROJECT NUMBER
	SCALE
Author	DRAWN BY
	SHEET NUMBER

**AB-13**