

AS-BUILT DOCUMENTATION


Point Reyes Station, CA



100% SUBMITTAL

DRAWING INDEX

- 0C1 COVER
- 0SL SYMBOL LEGEND
- AB-1 FIRST FLOOR
- AB-2 SECOND FLOOR
- AB-3 1ST FLR REFLECTED CEILING PLAN
- AB-4 2ND FLR REFLECTED CEILING PLAN
- AB-5 ROOF PLAN
- AB-6 EXTERIOR ELEVATIONS
- AB-7 BUILDING SECTION
- AB-8 INTERIOR ELEVATIONS
- AB-9 3D FIRST FLOOR SECTION
- AB-10 3D SECOND FLOOR SECTION
- AB-11 3D ELEVATIONS
- AB-12 3D SECTIONS

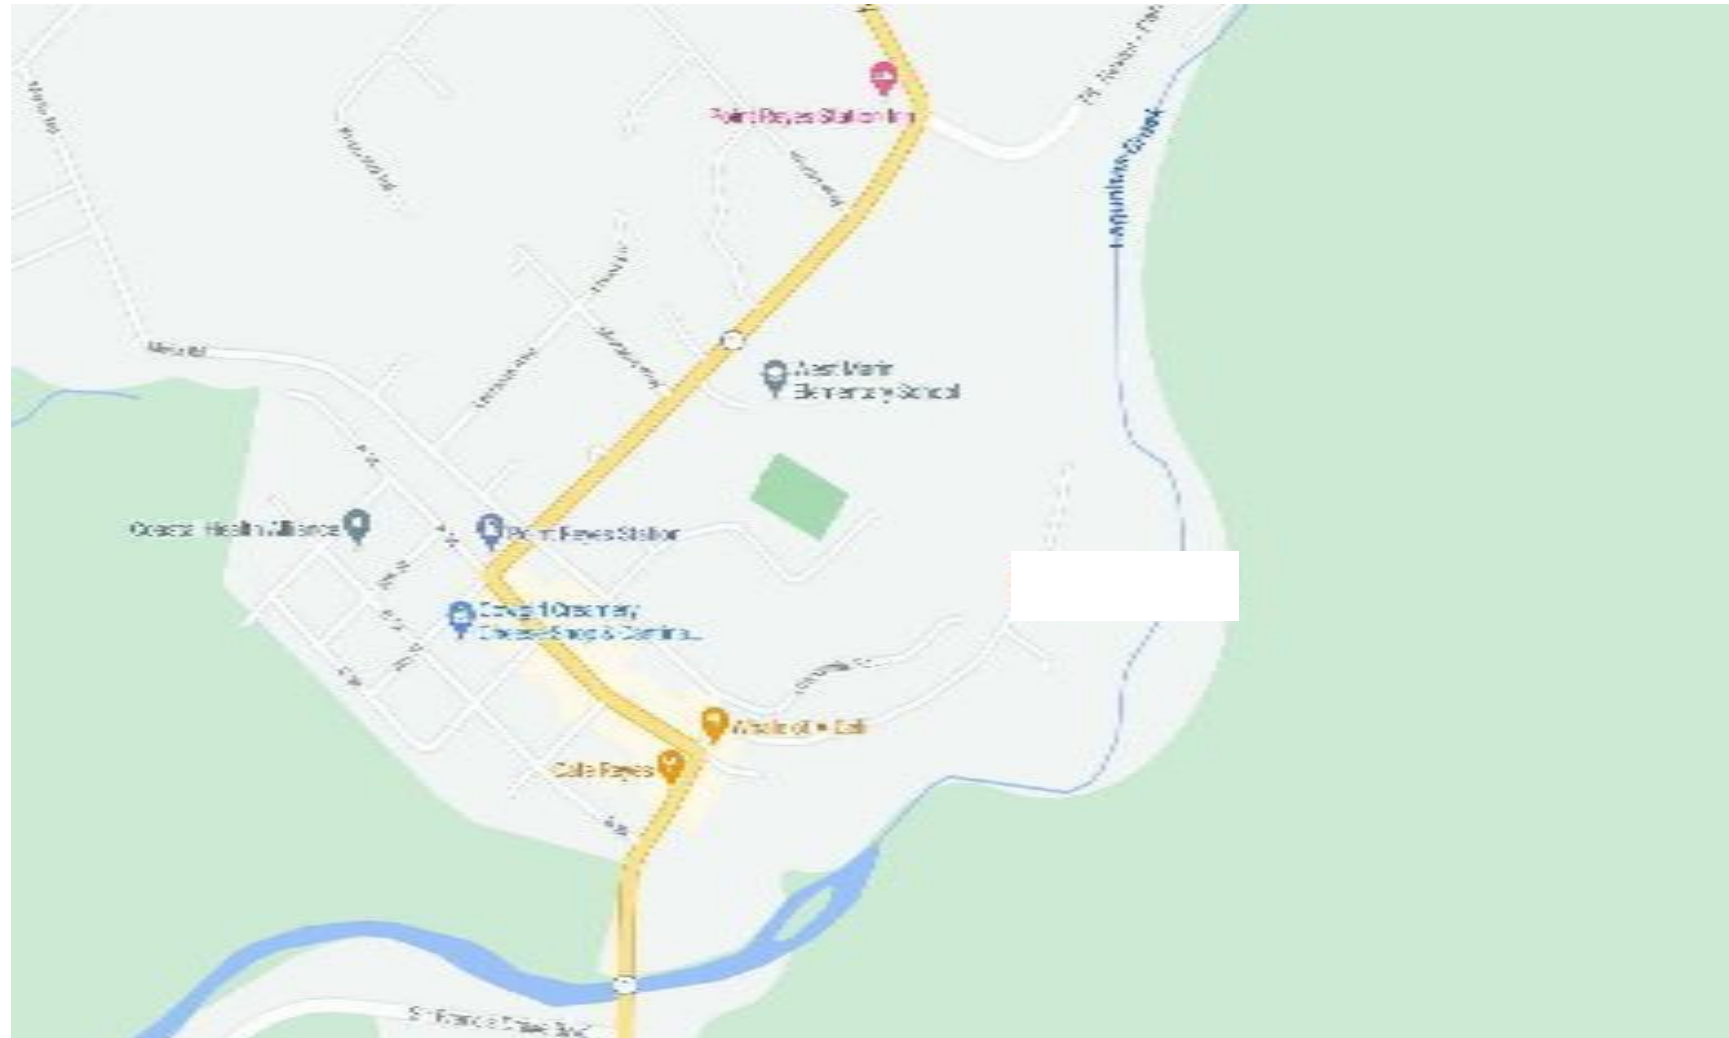

VICINITY MAP
N.T.S.

AREA DATA	
FIRST FLOOR	1370 SF
SECOND FLOOR	1402 SF
Grand total	2772 SF



ARCHITECTURAL AS BUILT

Point Reyes Station, CA

01	100% SUBMISSION	SEE COVER SHEET
NO.	ISSUES / REVISIONS	DATE

COVER


Designer	PROJECT MANAGER
Designer	PROJECT DIRECTOR
Project Number	PROJECT NUMBER
	SCALE
Author	DRAWN BY
	SHEET NUMBER

0C1

Room	Floor Finish	Mainscot	Wall Finish	Ceiling Finish
BATH	VINYL		G&B	G&B
BEDROOM	CPT		G&B	G&B
CL	CPT		G&B	G&B
HALL	CPT		G&B	G&B
KITCHEN	VINYL		G&B	G&B
LAUNDRY	VINYL		G&B	G&B
LIVING	CPT		G&B	G&B
PANTRY	VINYL		G&B	G&B
UTILITY	VINYL		G&B	G&B

Type	Count	Width	Height	Comments
A	3	3' - 0"	6' - 0"	
B	6	2' - 0"	6' - 0"	
C	3	5' - 0"	6' - 0"	
E	3	5' - 10"	6' - 0"	
F	15	2' - 6"	6' - 0"	
G	3	8' - 0"	8' - 0"	
H	3	3' - 5"	8' - 0"	

Mark	Count	Width	Height	Operation
A	3	5' - 10"	3' - 10"	SLIDING
B	6	4' - 0"	4' - 0"	SLIDING

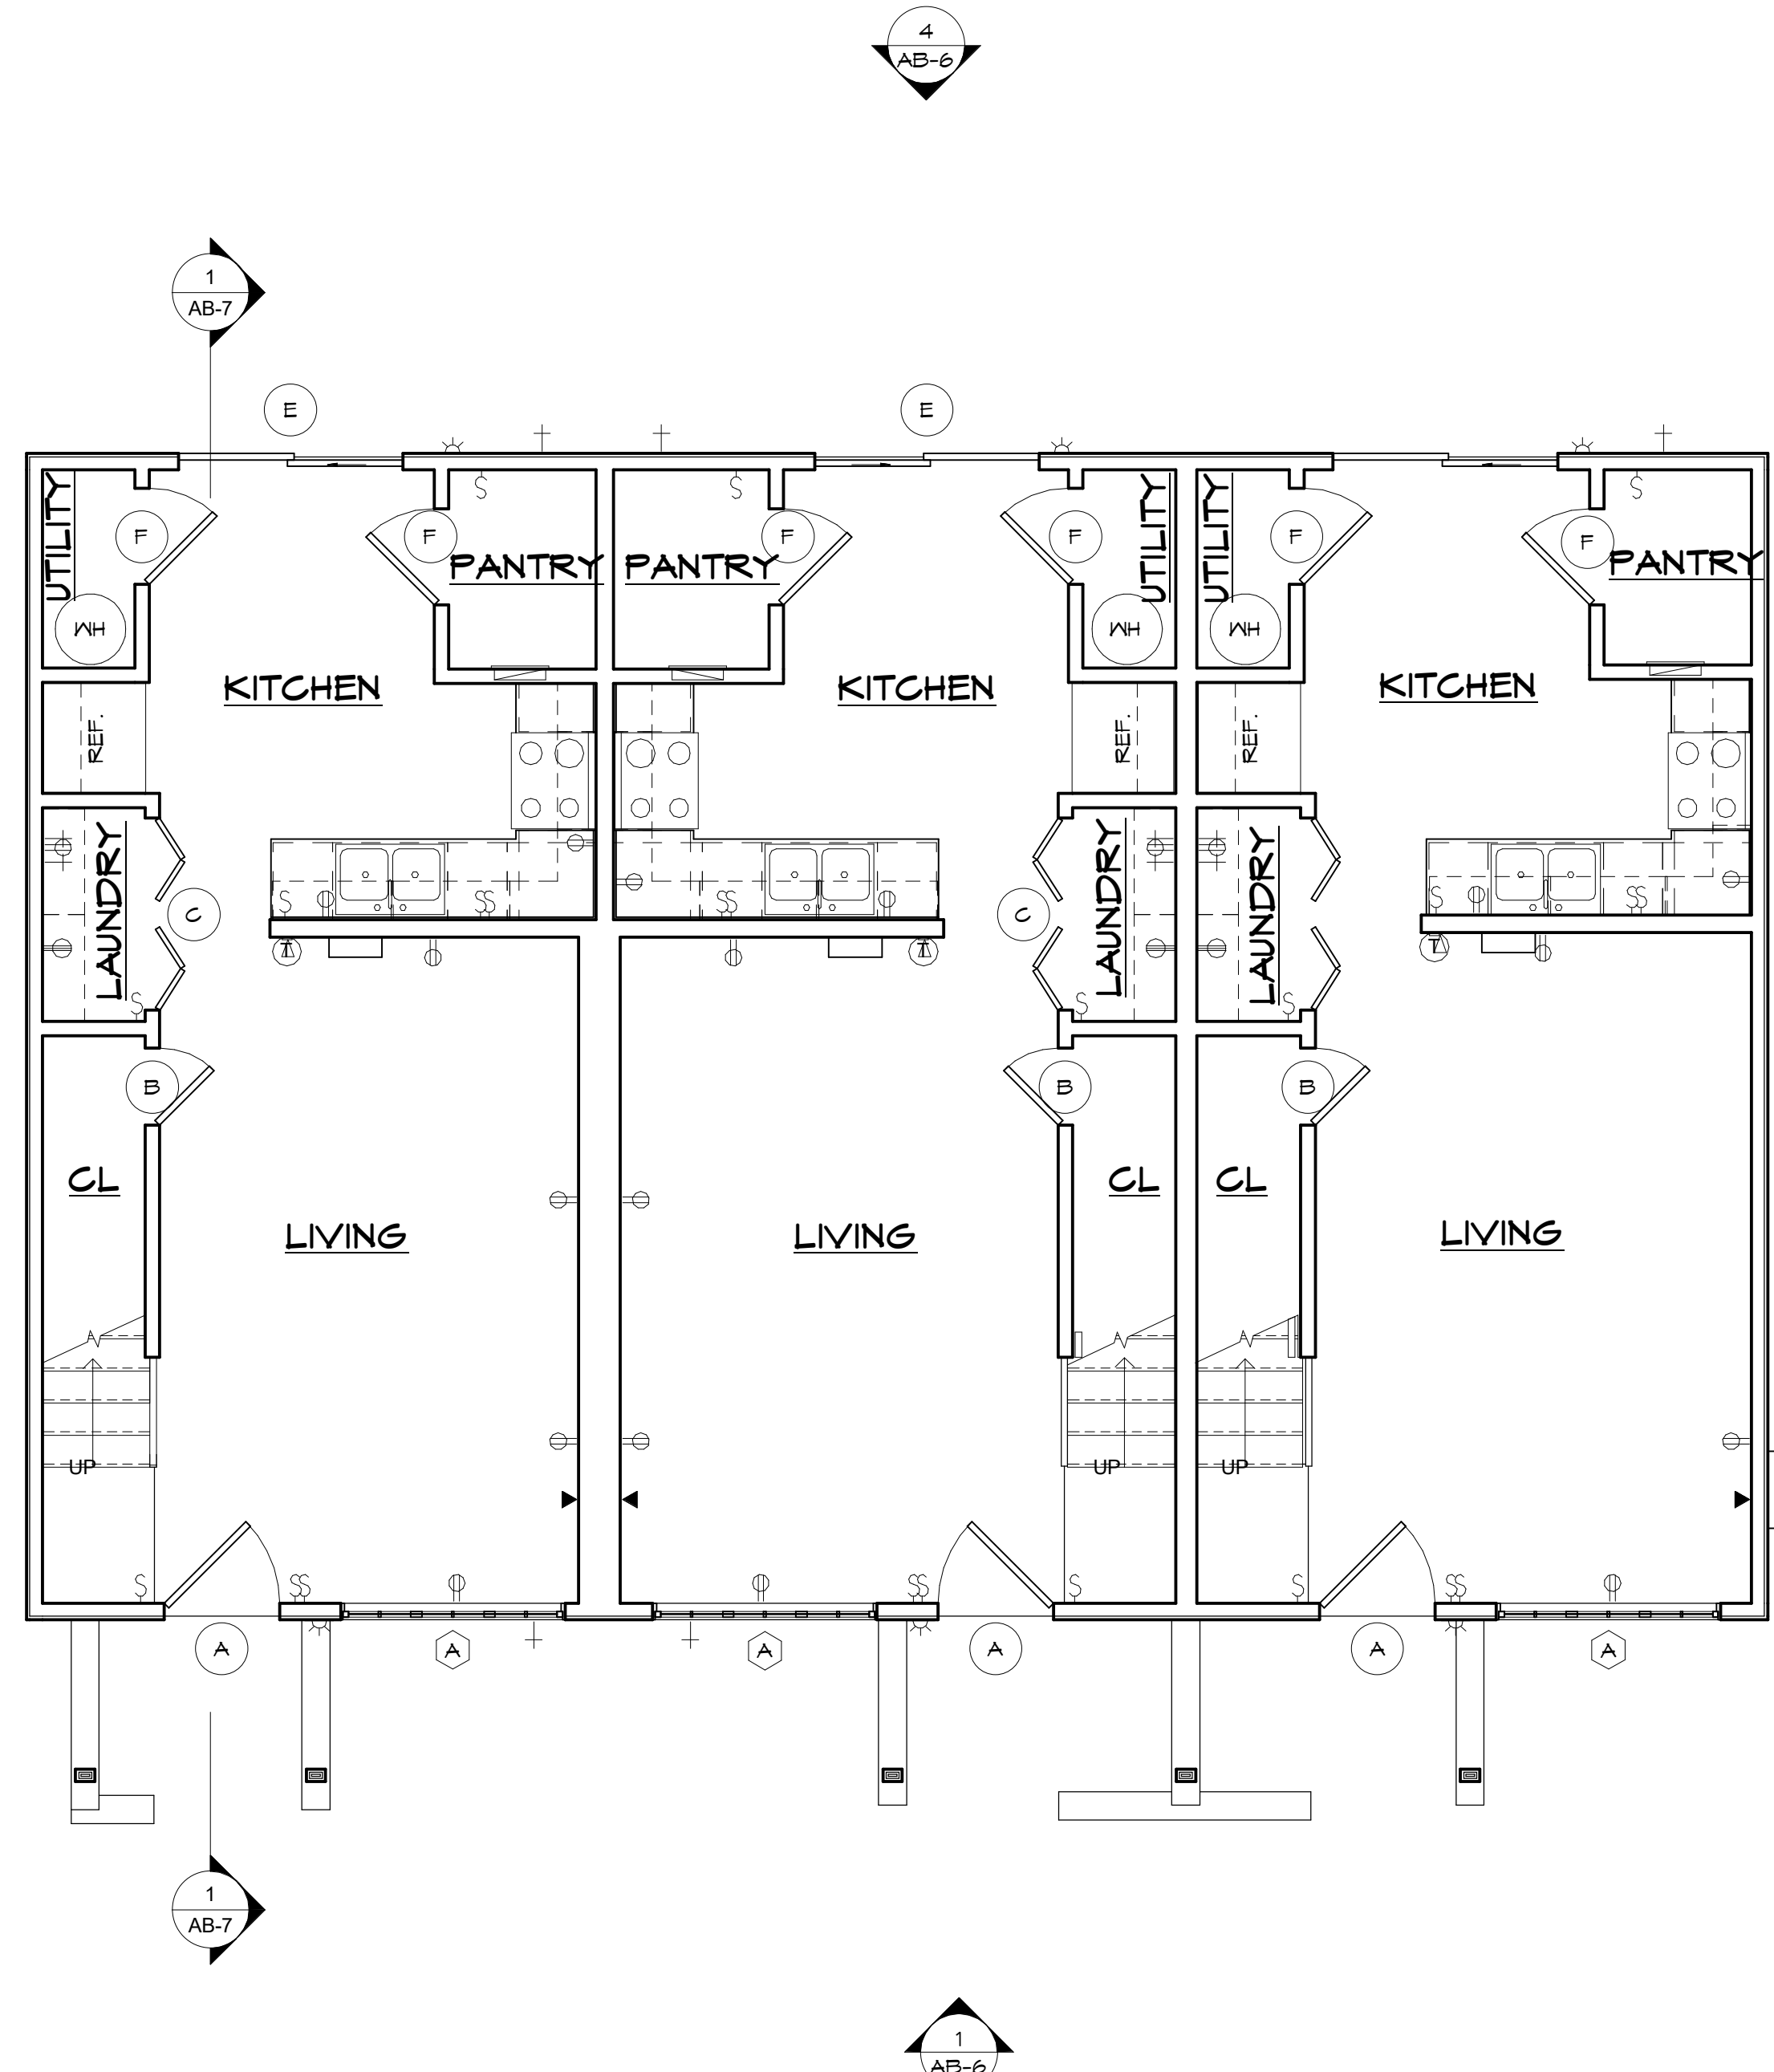


ARCHITECTURAL AS BUILT
Point Reyes Station, CA

1 FIRST FLOOR
1/4" = 1'-0"

01	100% SUBMISSION	SEE COVER SHEET
NO.	ISSUES / REVISIONS	DATE
SHEET TITLE		
FIRST FLOOR		
Designer	PROJECT MANAGER	
Designer	PROJECT DIRECTOR	
Project Number	PROJECT NUMBER	
Author	DRAWN BY	
	SHEET NUMBER	

AB-1

ARCHITECTURAL AS BUILT
Point Reyes Station, CA

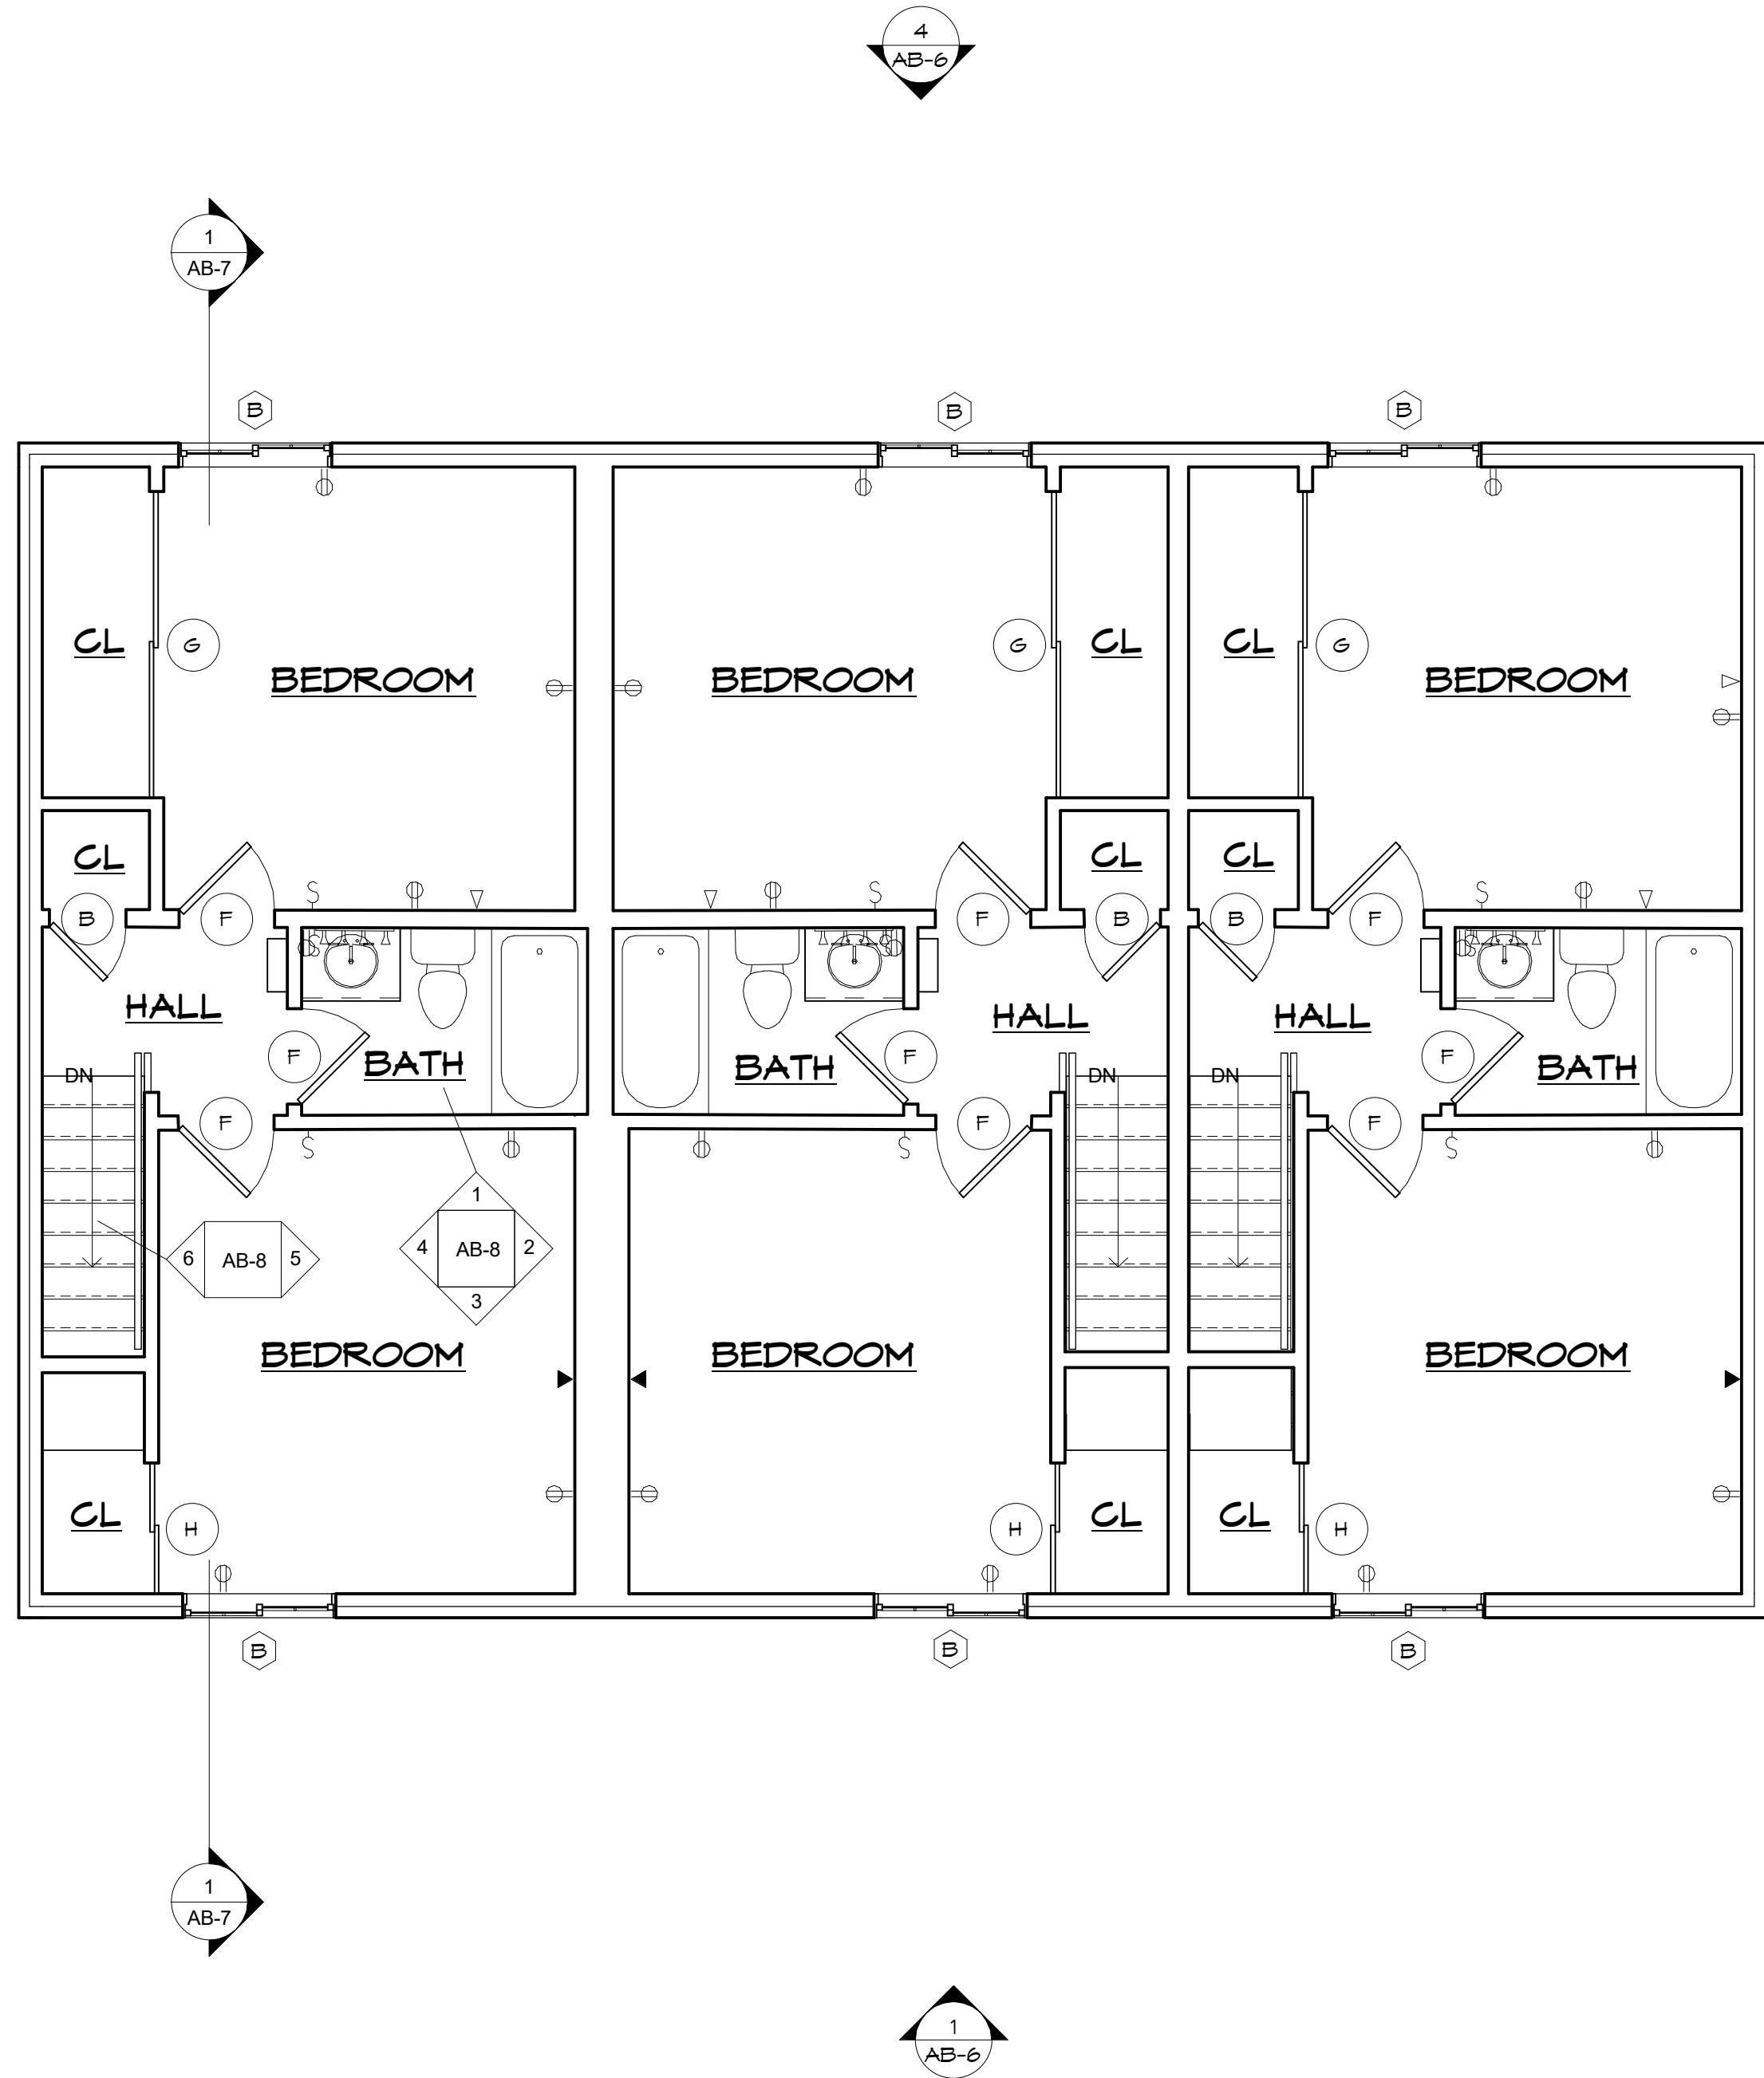


1 SECOND FLOOR
 1/4" = 1'-0"

01	100% SUBMISSION	SEE COVER SHEET
NO.	ISSUES / REVISIONS	DATE

SECOND FLOOR

Designer	PROJECT MANAGER
Designer	PROJECT DIRECTOR
Project Number	PROJECT NUMBER
Author	DRAWN BY
	SHEET NUMBER

AB-2

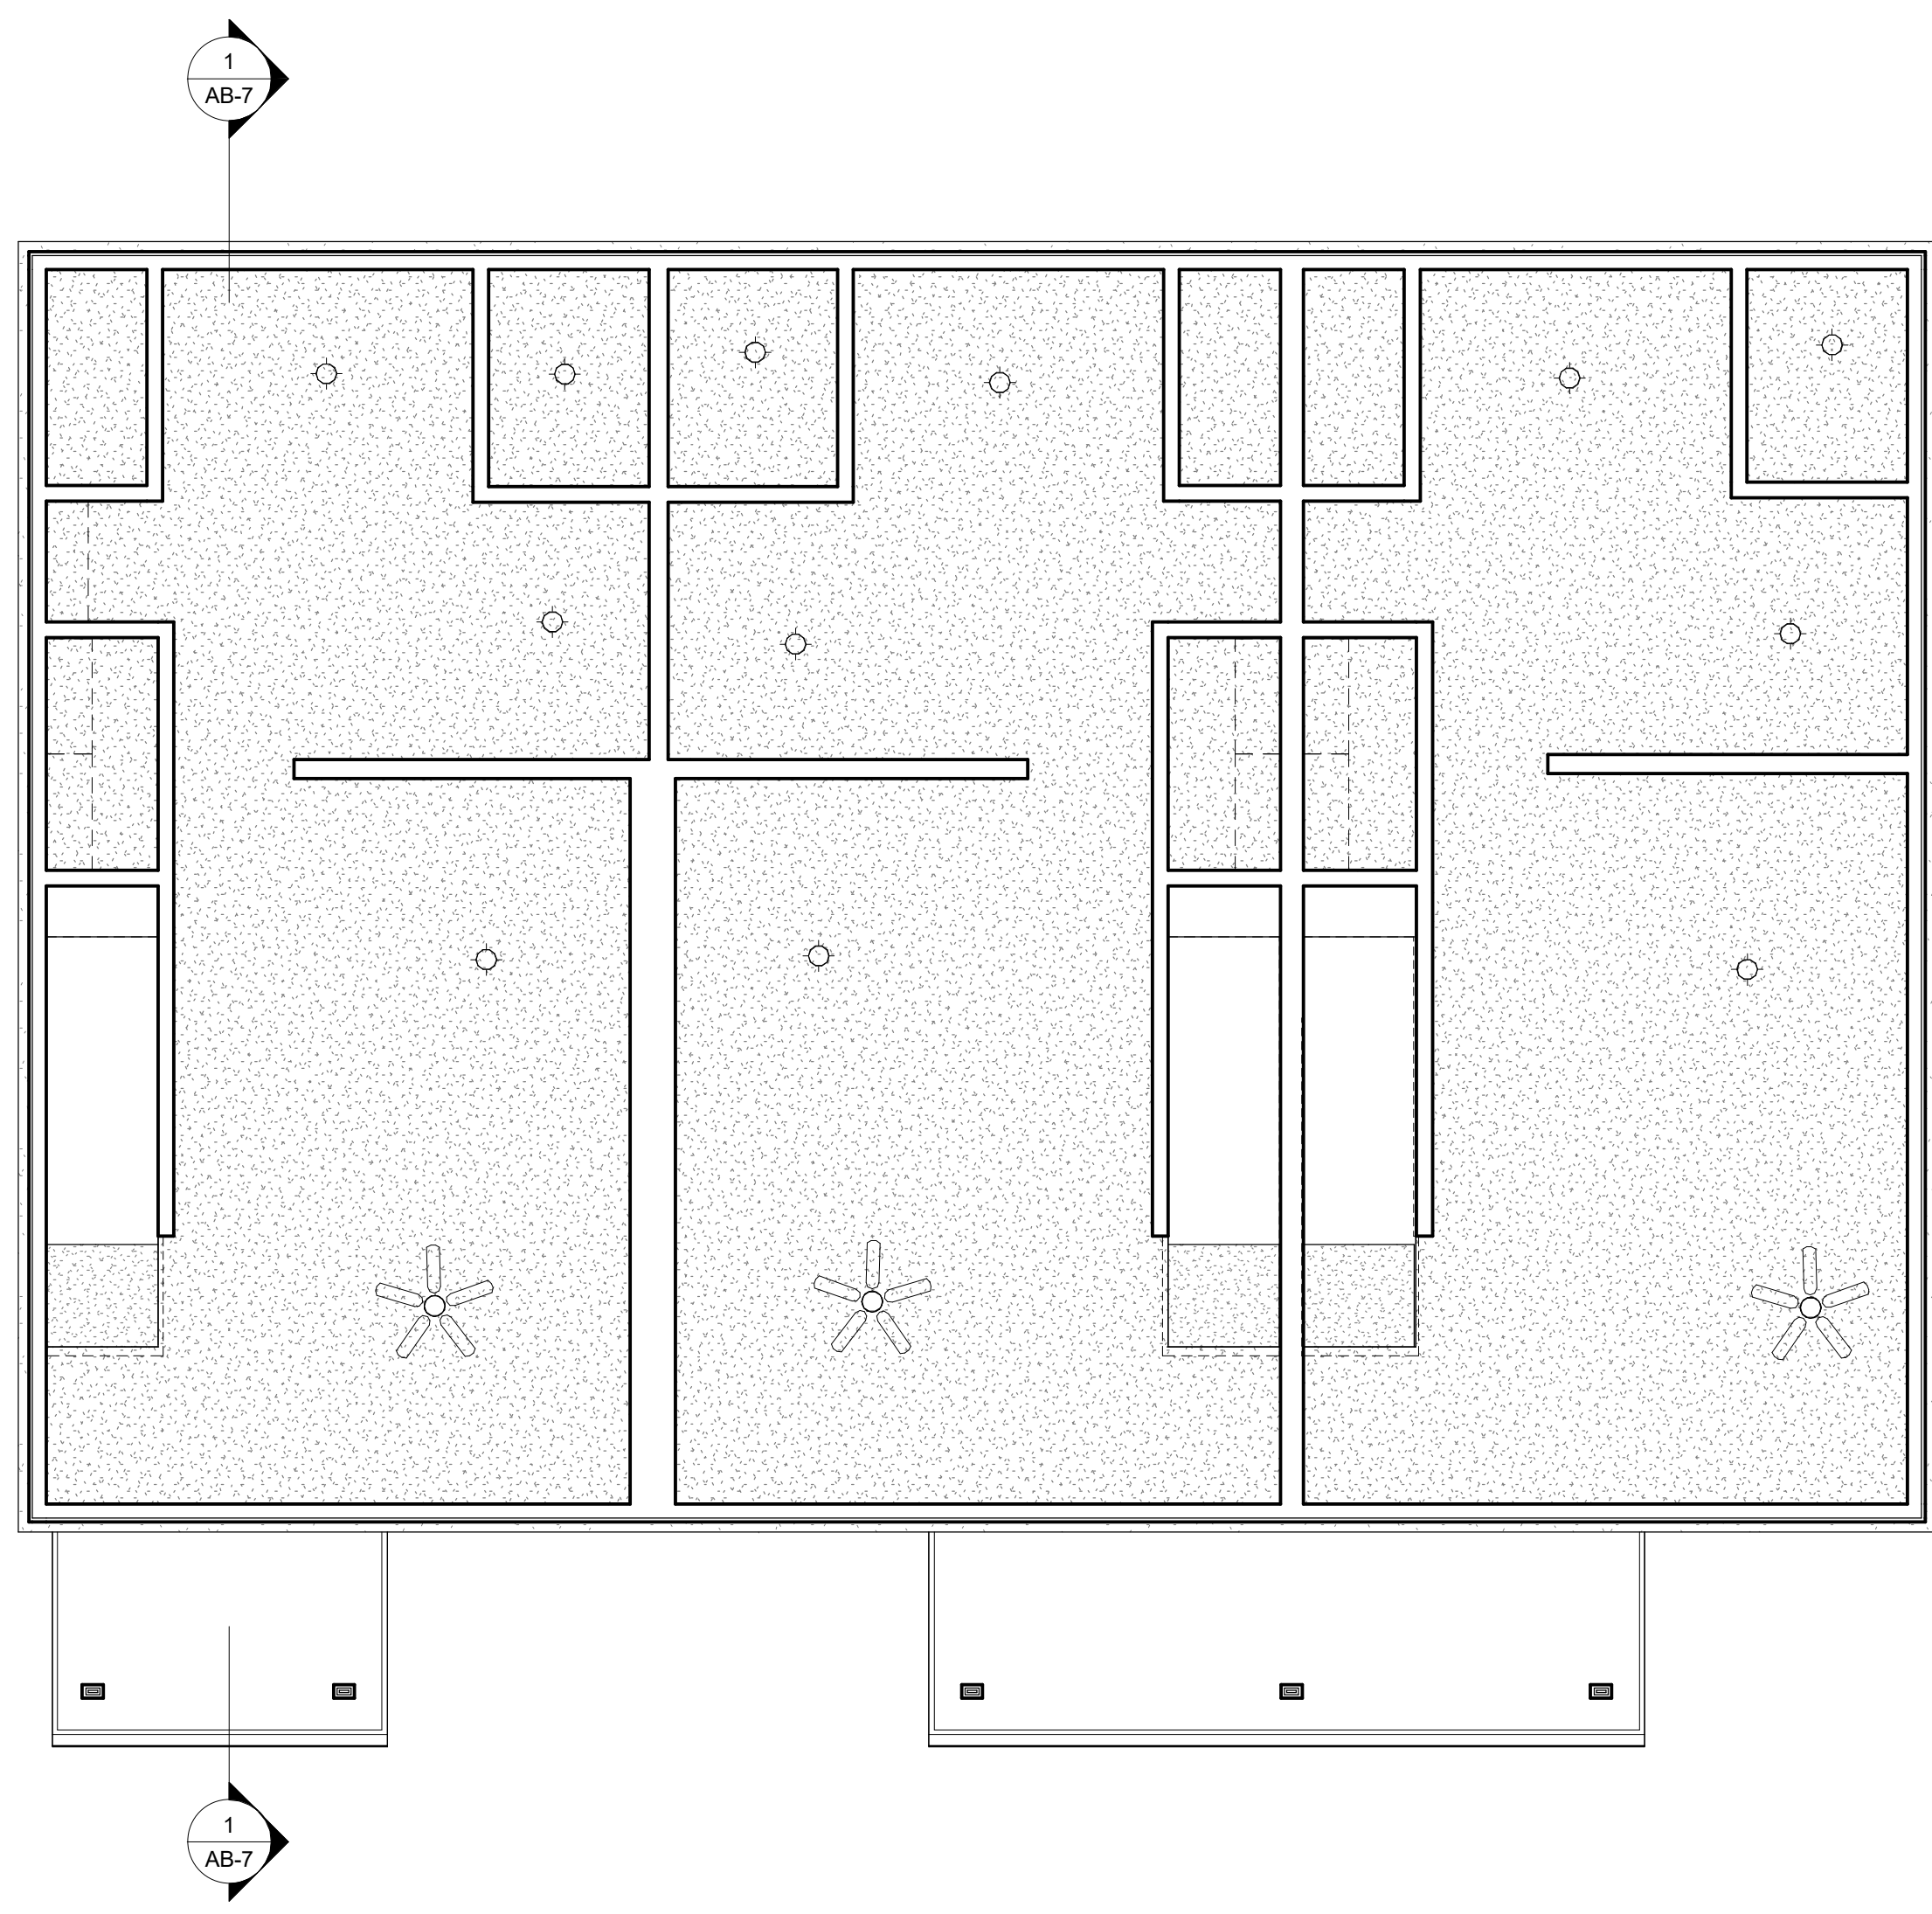


ARCHITECTURAL AS BUILT
Point Reyes Station, CA

NO.	ISSUES / REVISIONS	DATE
01	100% SUBMISSION	SEE COVER SHEET

**1ST FLR REFLECTED
 CEILING PLAN**

Designer	PROJECT MANAGER
Designer	PROJECT DIRECTOR
Project Number	PROJECT NUMBER
Author	DRAWN BY

AB-3

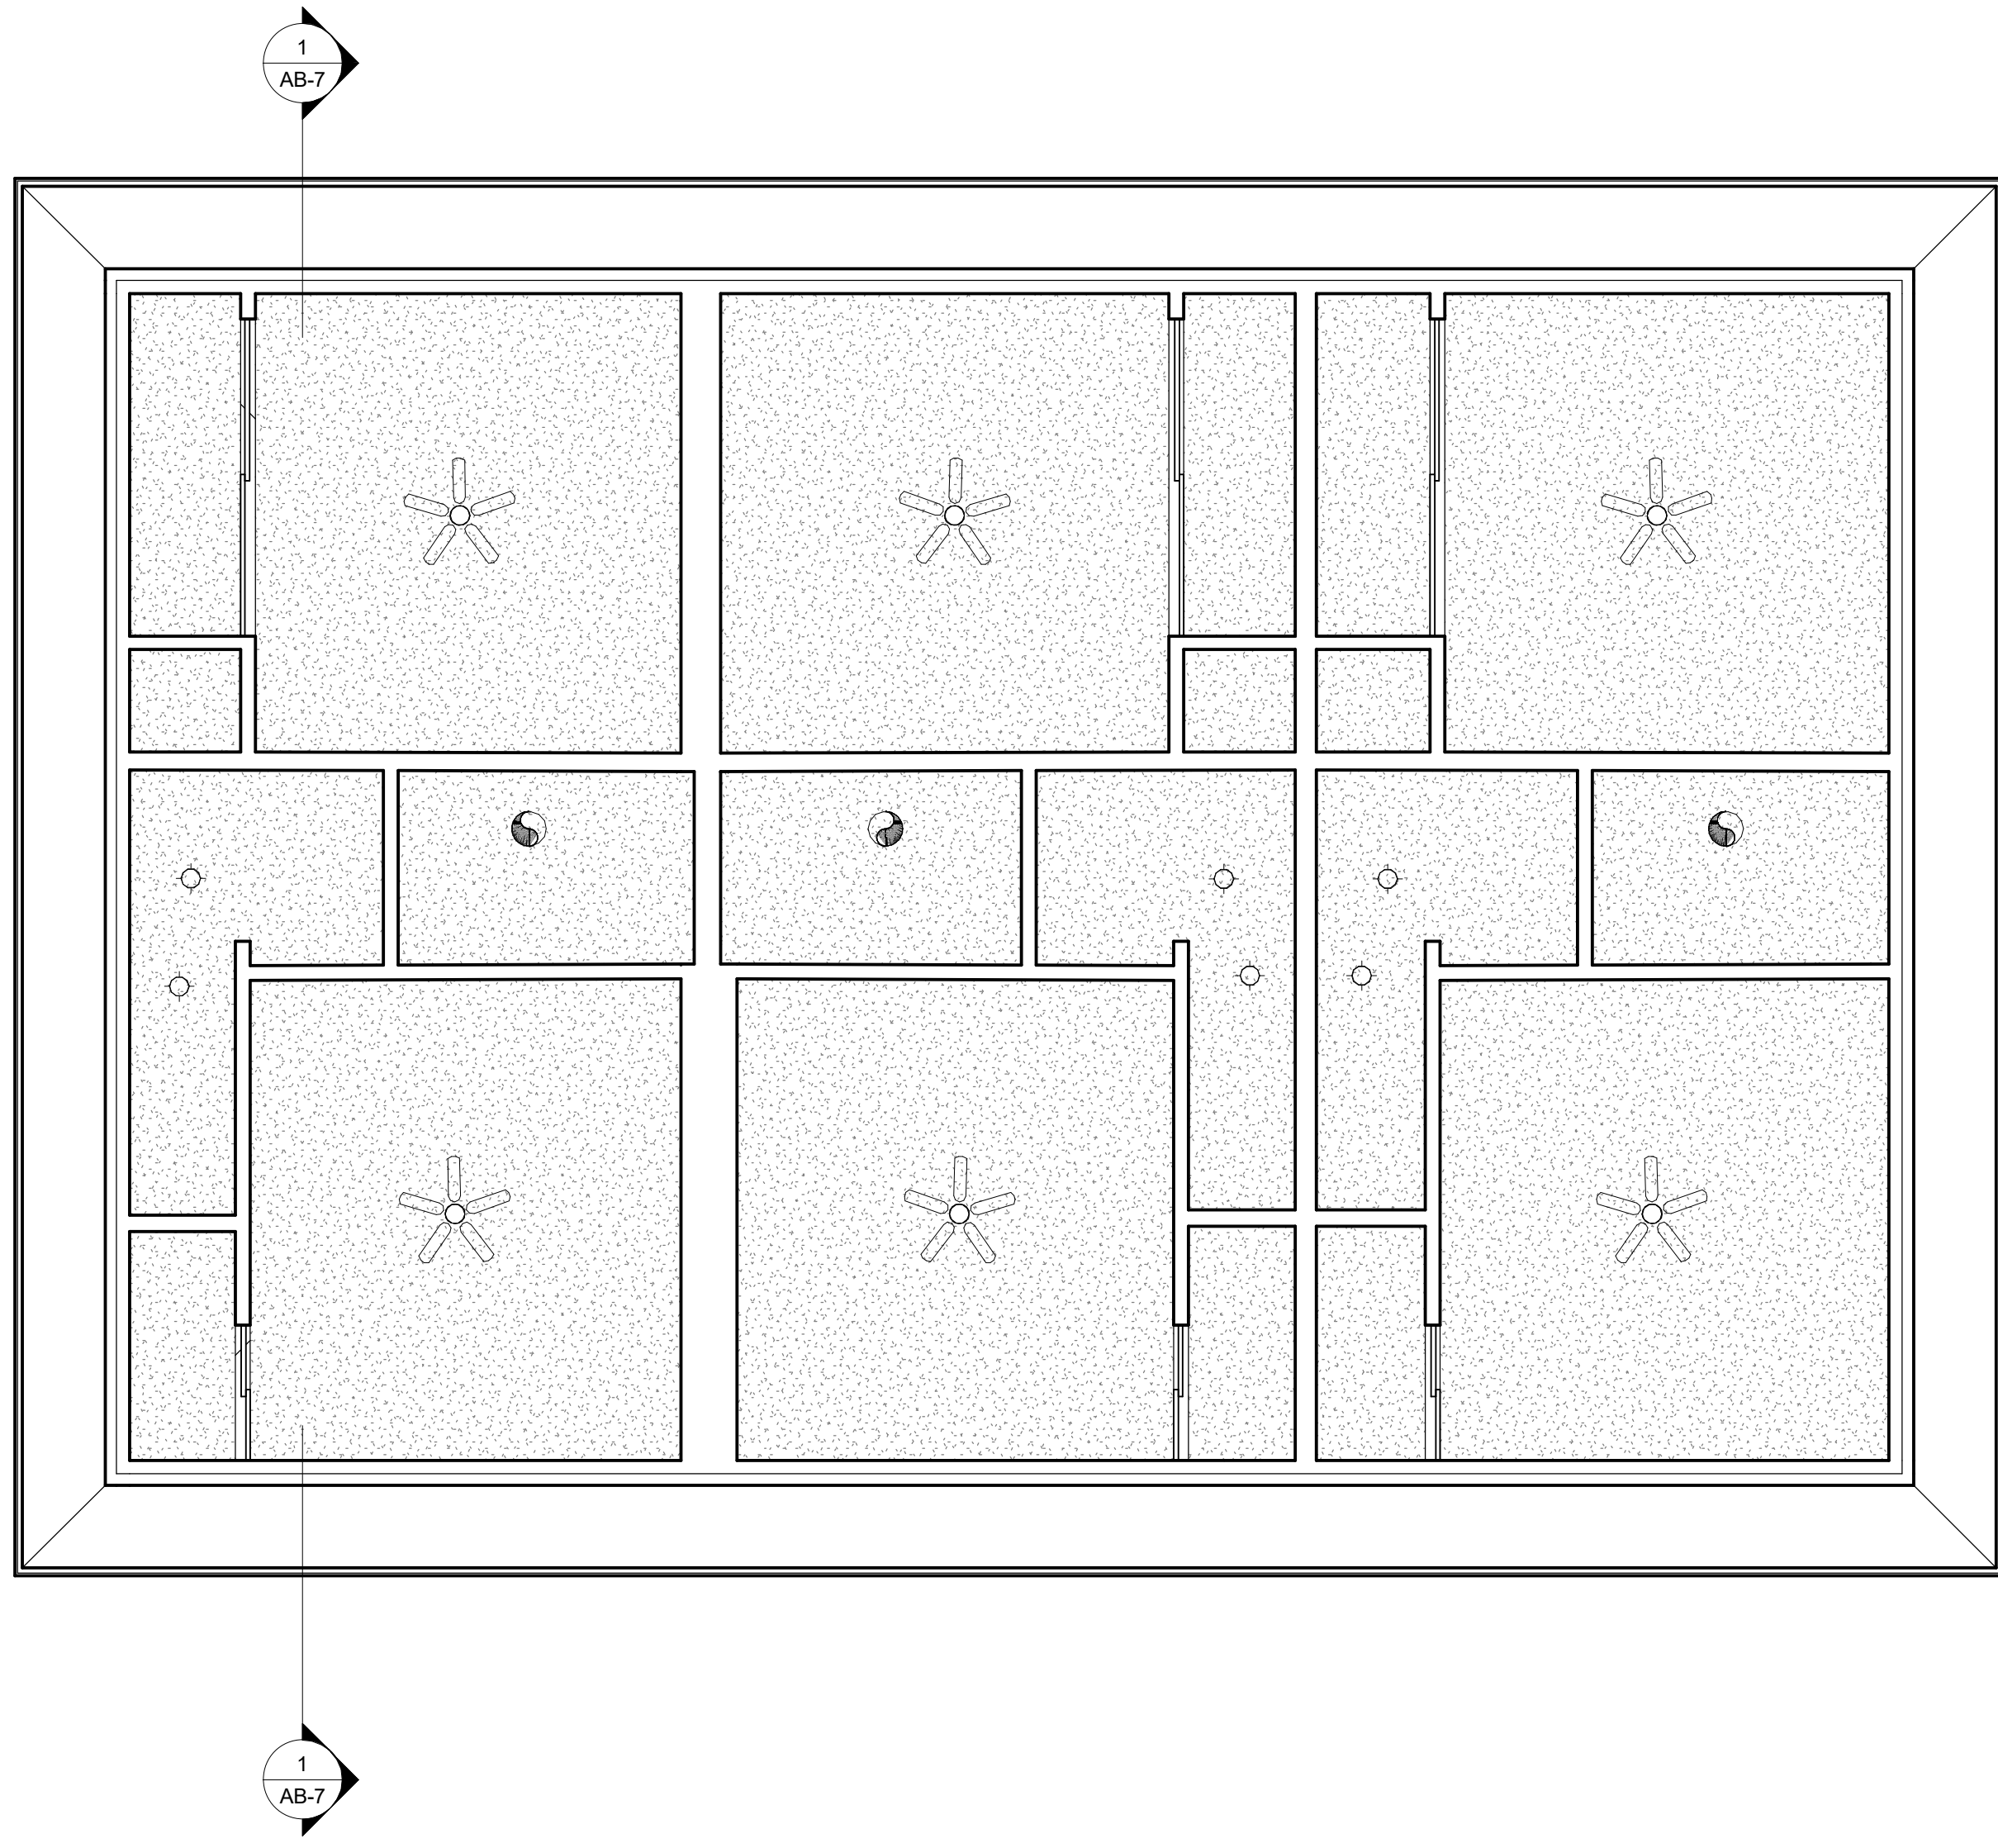

ARCHITECTURAL AS BUILT
Point Reyes Station, CA


NO.	ISSUES / REVISIONS	DATE	SHEET TITLE
01	100% SUBMISSION		SEE COVER SHEET

**2ND FLR REFLECTED
 CEILING PLAN**

Designer	PROJECT MANAGER
Designer	PROJECT DIRECTOR
Project Number	PROJECT NUMBER
	SCALE
Author	DRAWN BY
	SHEET NUMBER

AB-4

ARCHITECTURAL AS BUILT
Point Reyes Station, CA

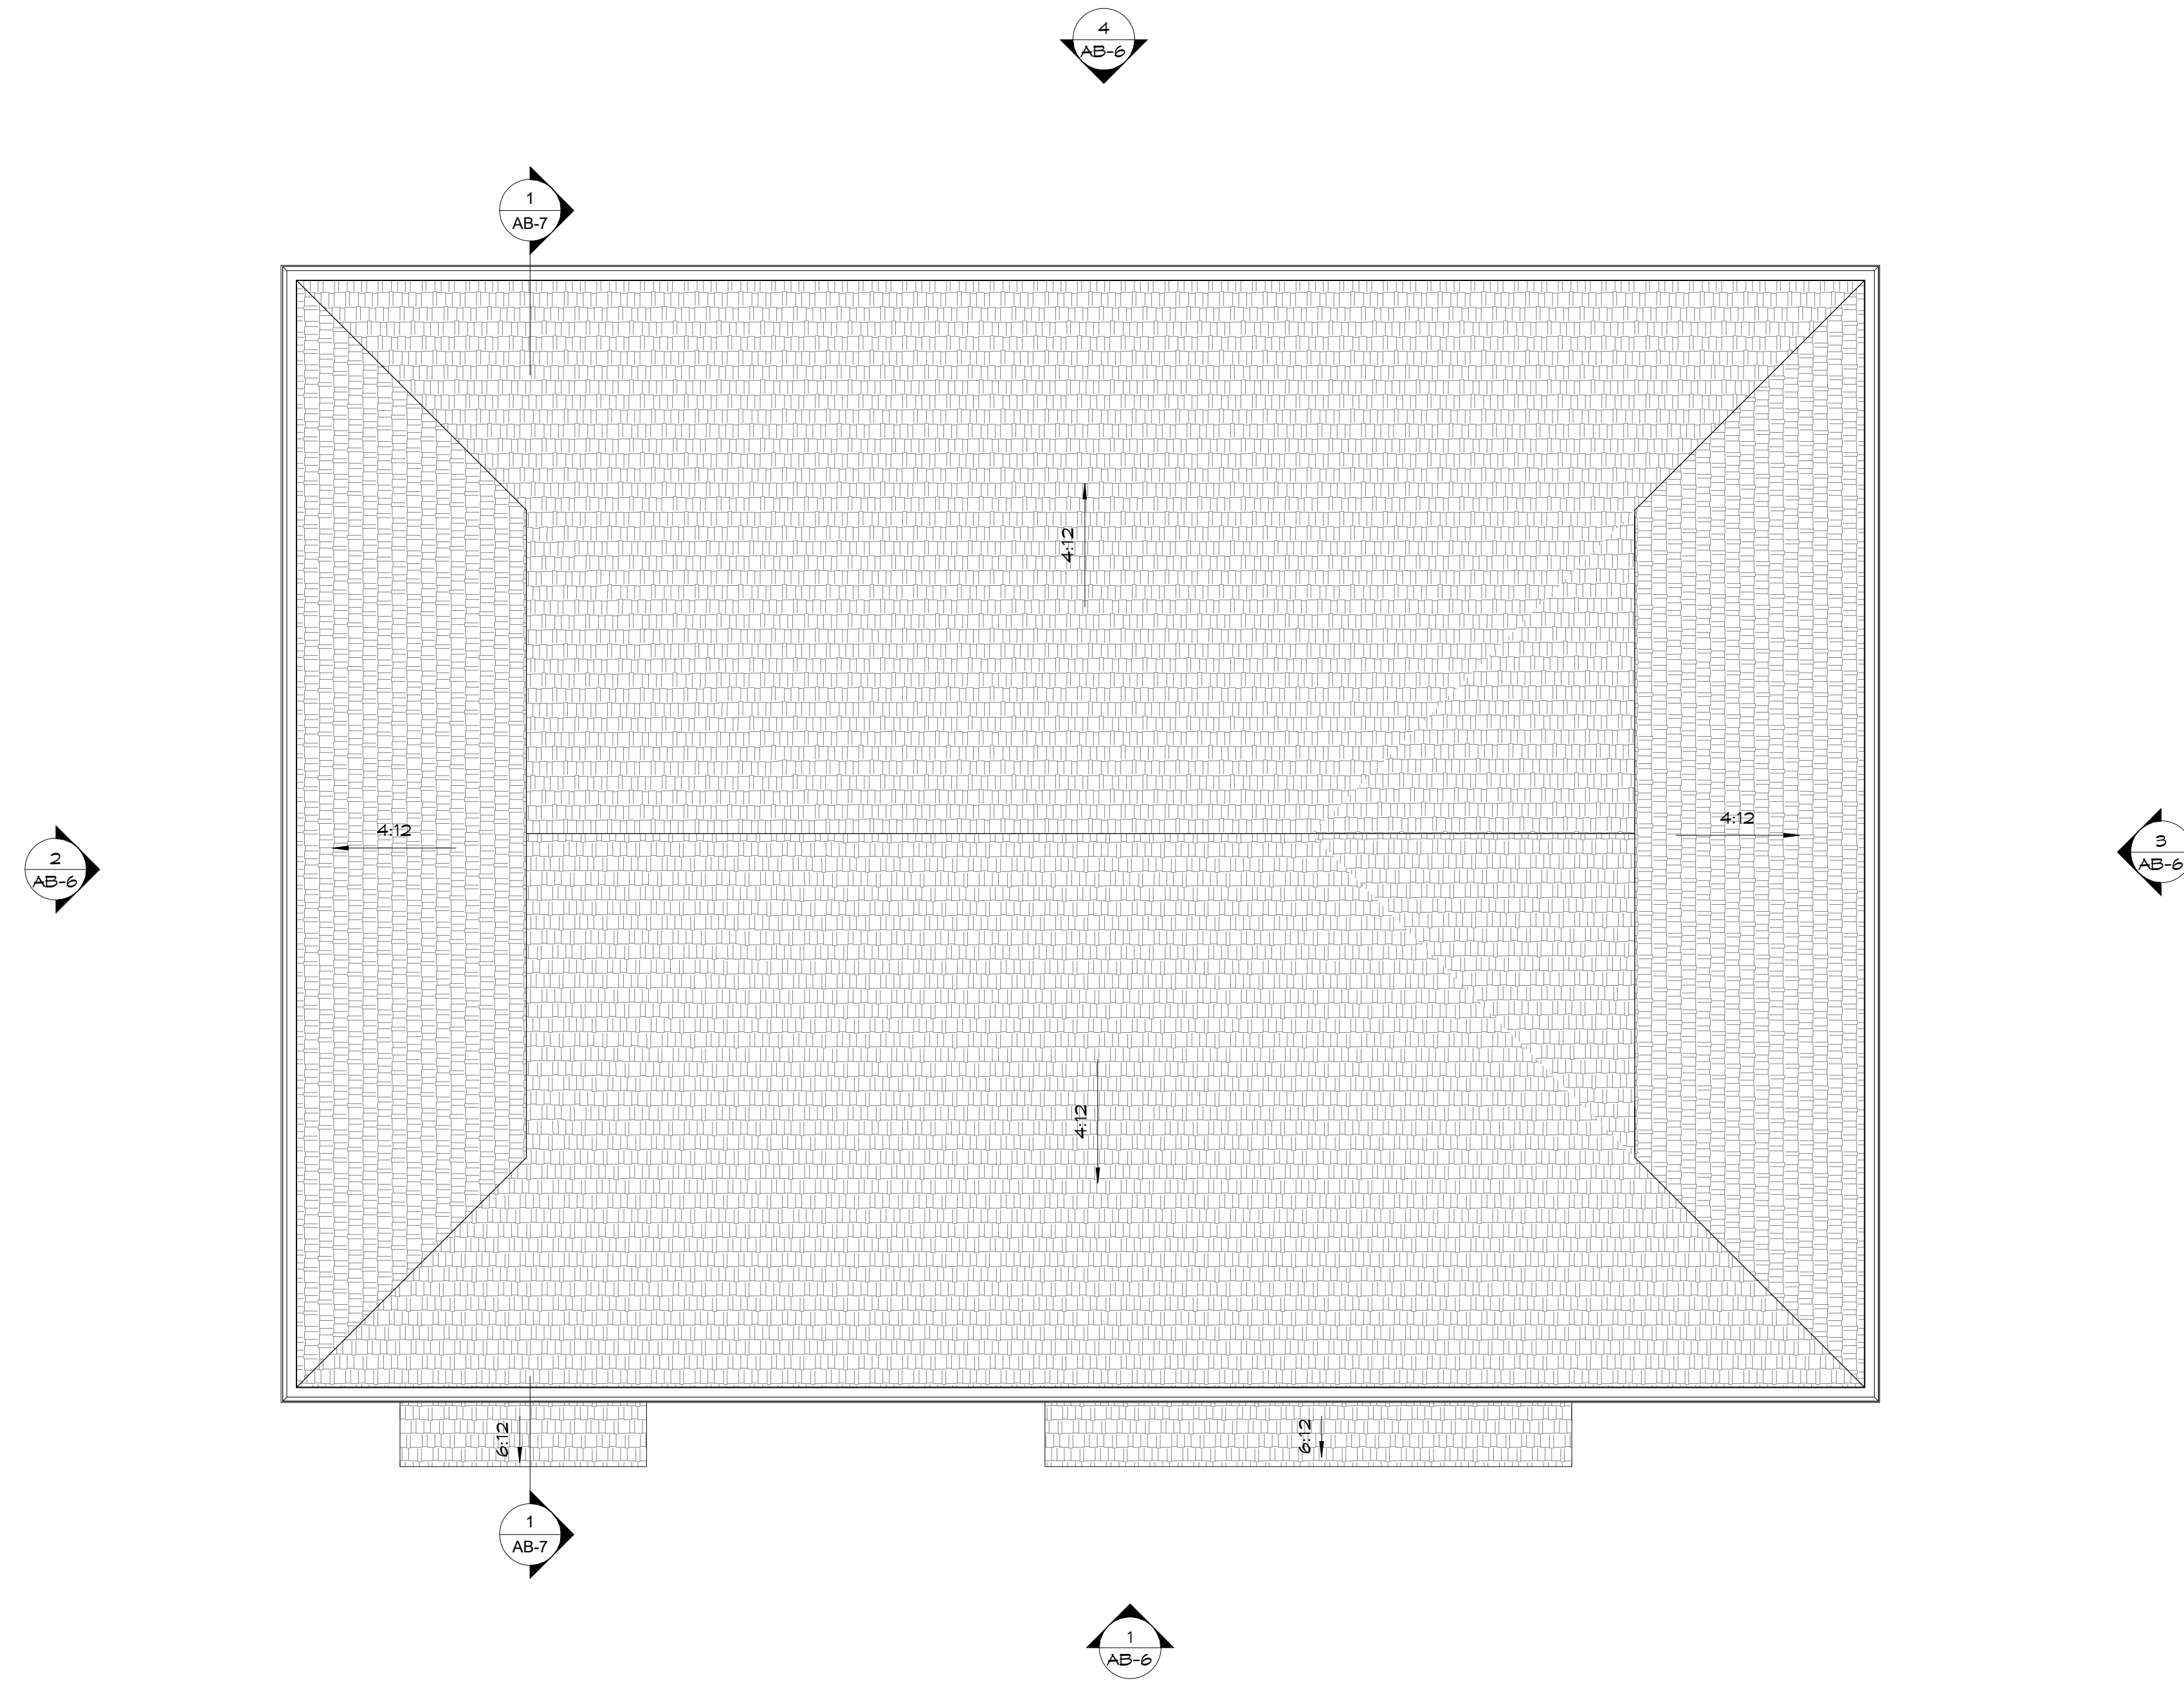

1 ROOF PLAN
 1/4" = 1'-0"

NO.	ISSUES / REVISIONS	DATE	SHEET TITLE
01	100% SUBMISSION		SEE COVER SHEET


ROOF PLAN

Designer	PROJECT MANAGER
Designer	PROJECT DIRECTOR
Project Number	PROJECT NUMBER
Author	DRAWN BY
	SHEET NUMBER

AB-5


EXTERIOR FINISH SCHEDULE

Asphalt Shingle
Lap Siding
Stucco

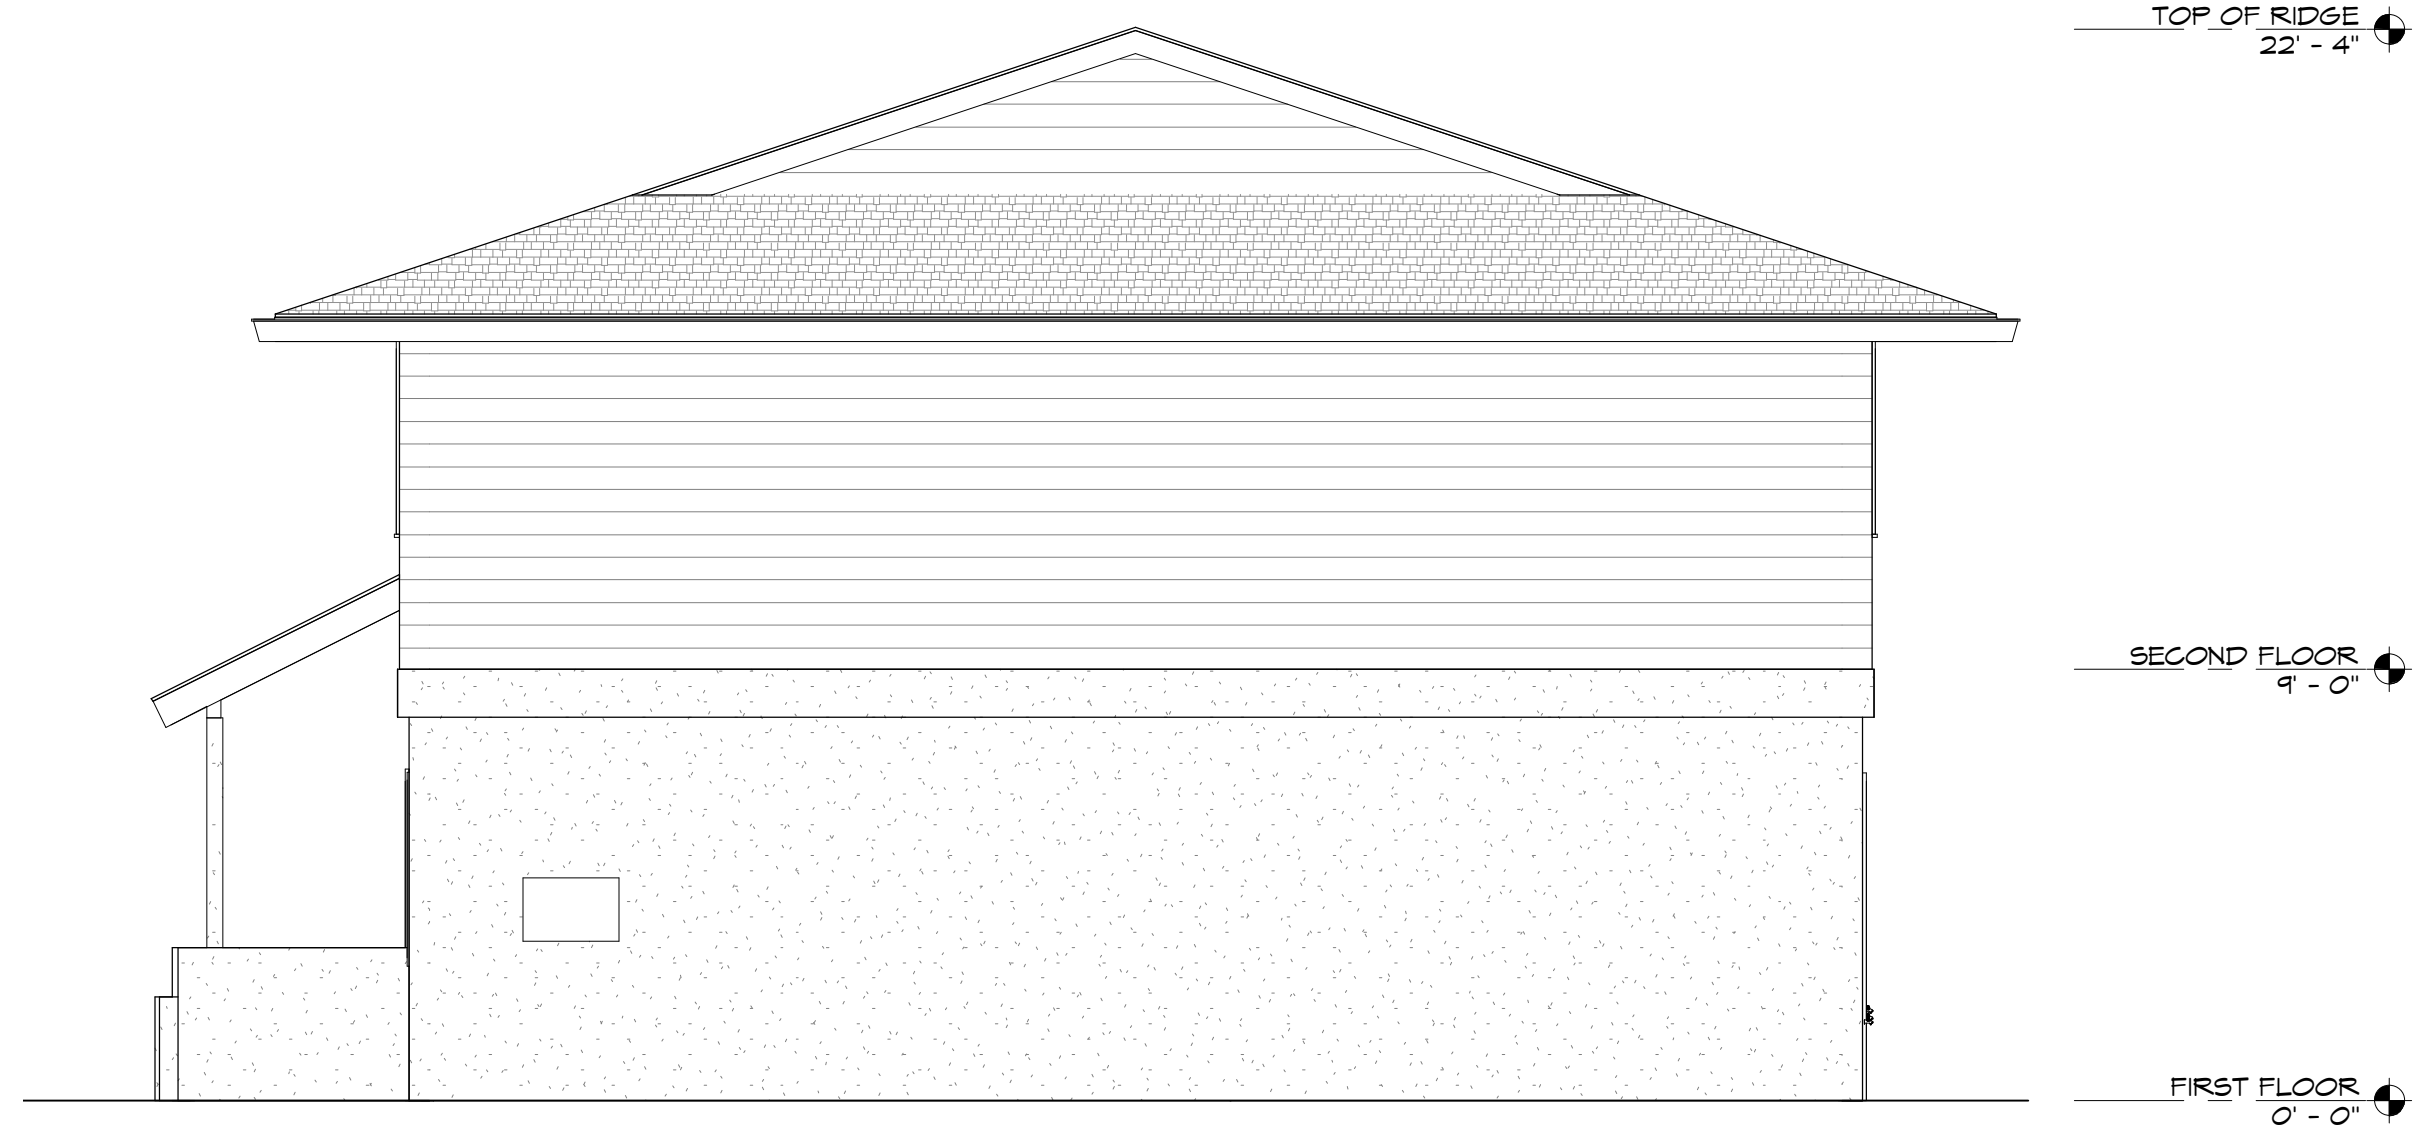

3 RIGHT
1/4" = 1'-0"

1 FRONT
1/4" = 1'-0"

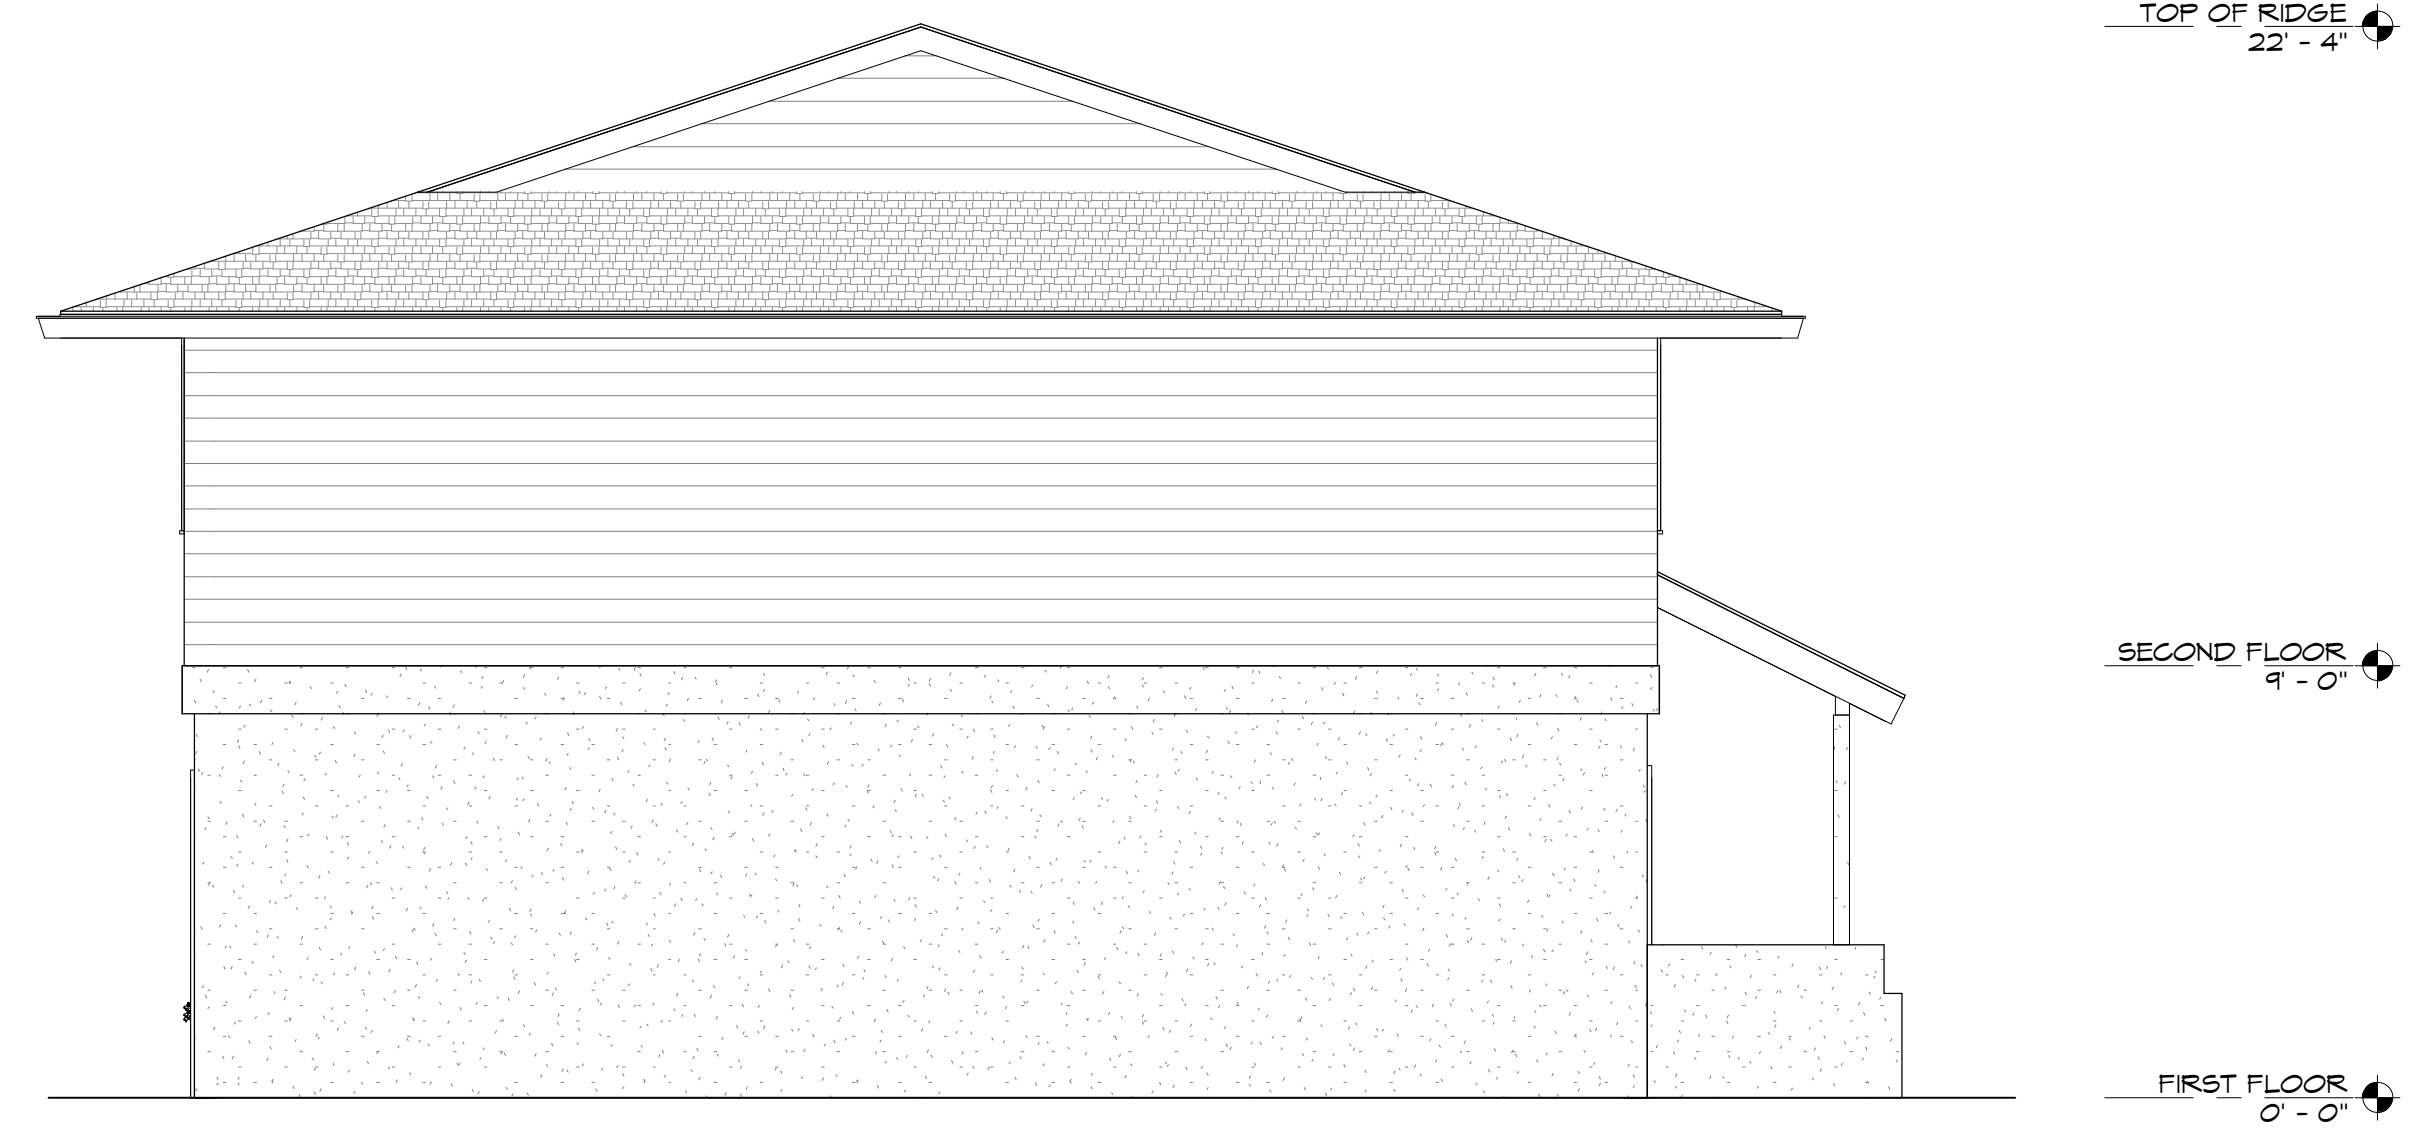

4 BACK
1/4" = 1'-0"

2 LEFT
1/4" = 1'-0"


ARCHITECTURAL AS BUILT
Point Reyes Station, CA

01	100% SUBMISSION	SEE COVER SHEET
NO.	ISSUES / REVISIONS	DATE

EXTERIOR ELEVATIONS

Designer	PROJECT MANAGER
Designer	PROJECT DIRECTOR
Project Number	PROJECT NUMBER
Author	DRAWN BY
	SHEET NUMBER

ARCHITECTURAL AS BUILT
Point Reyes Station, CA

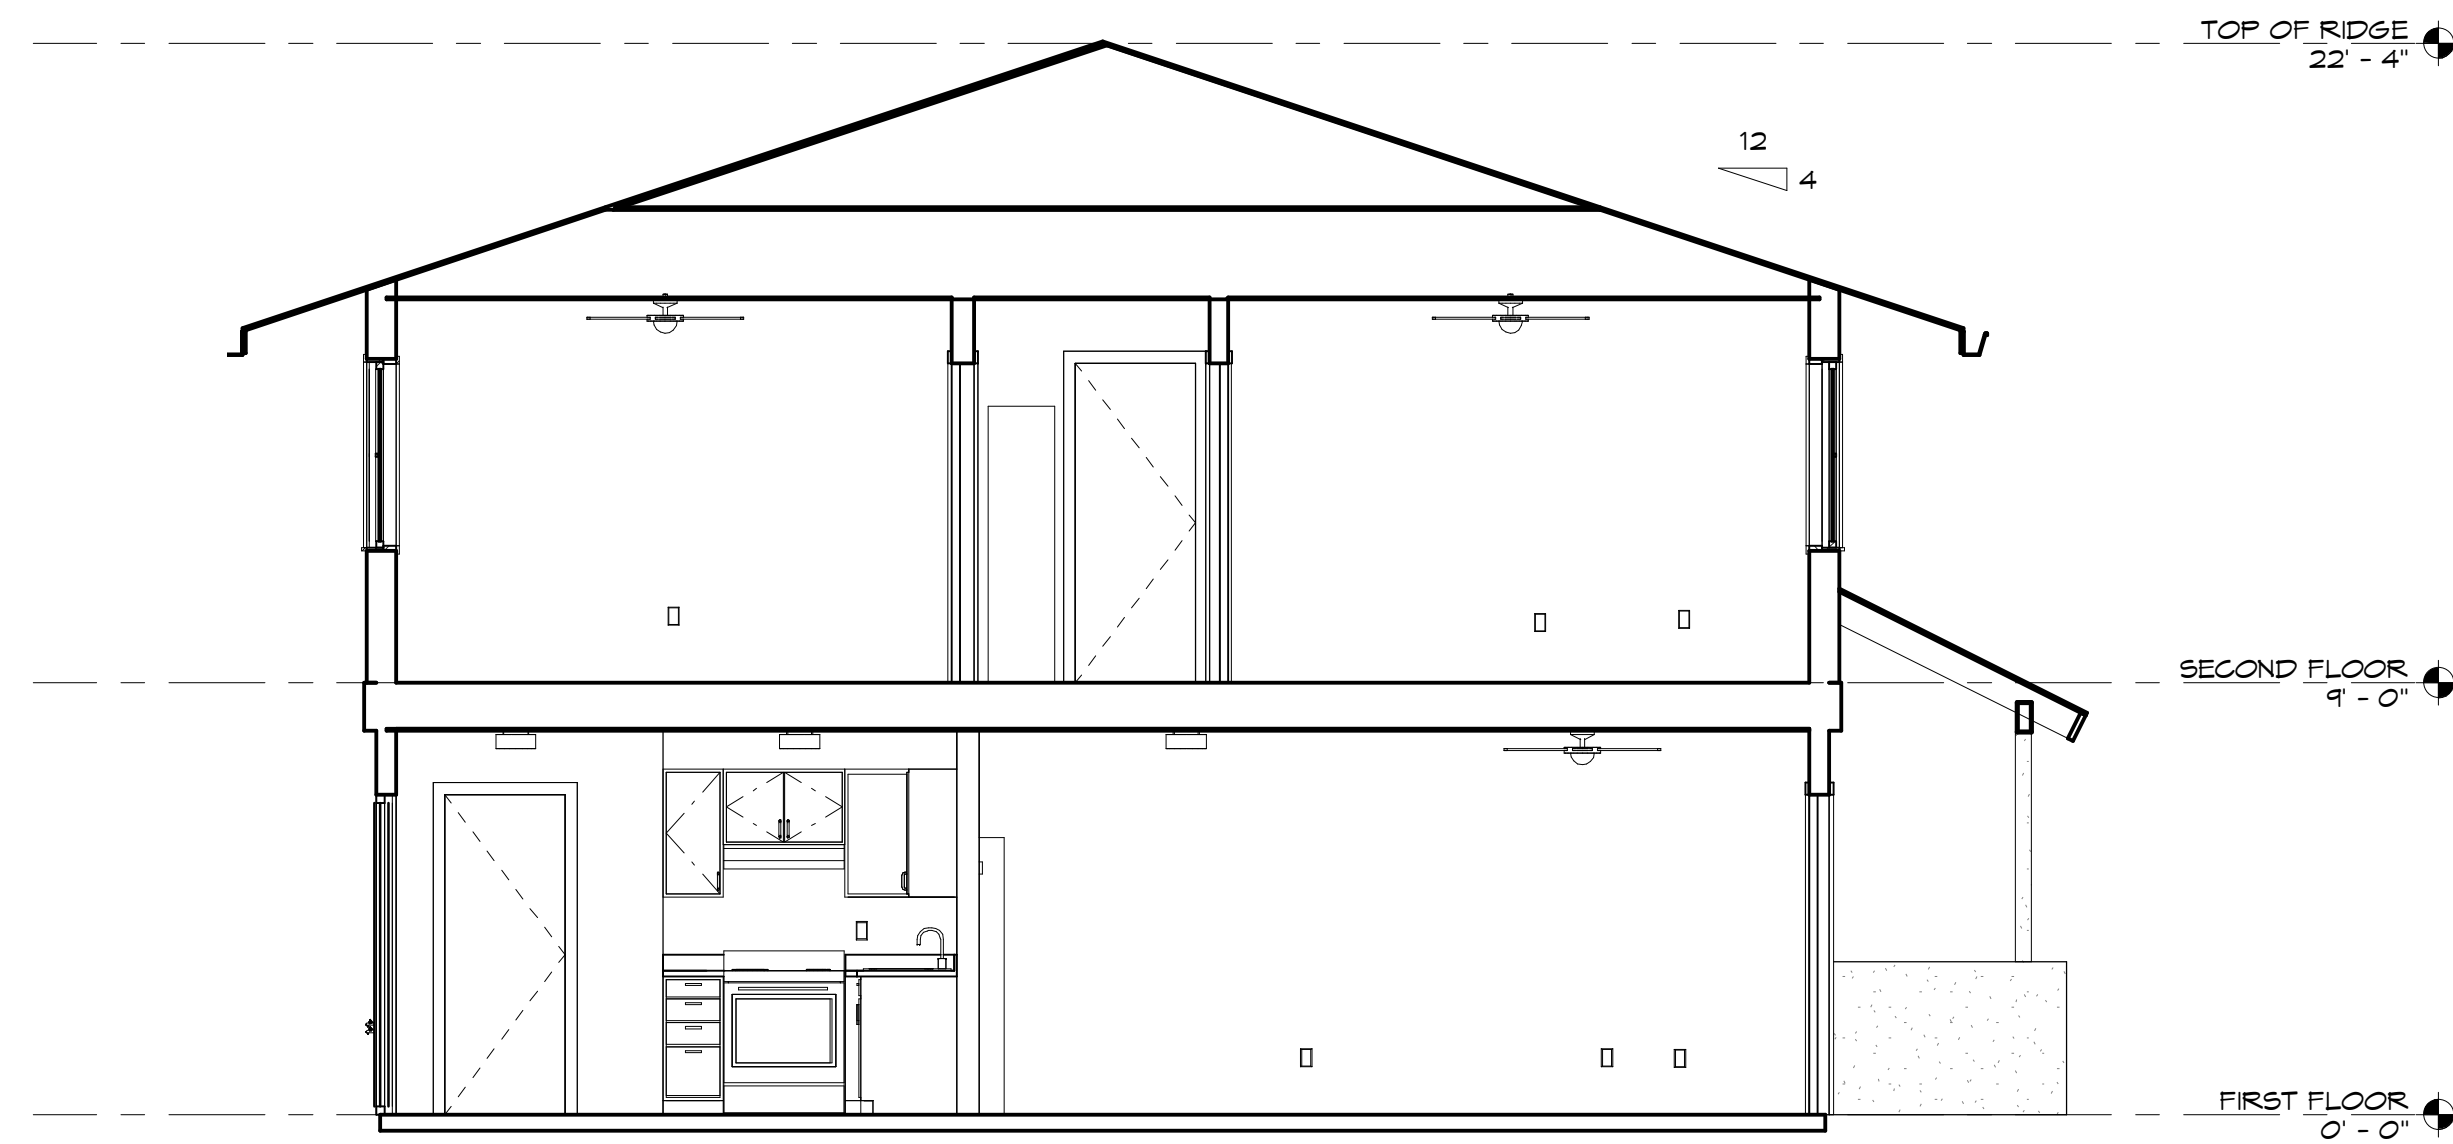


1 BUILDING SECTION
 1/4" = 1'-0"

NO.	ISSUES / REVISIONS	DATE
01	100% SUBMISSION	SEE COVER SHEET

BUILDING SECTION

Designer	PROJECT MANAGER
Designer	PROJECT DIRECTOR
Project Number	PROJECT NUMBER
Author	DRAWN BY
	SHEET NUMBER

AB-7

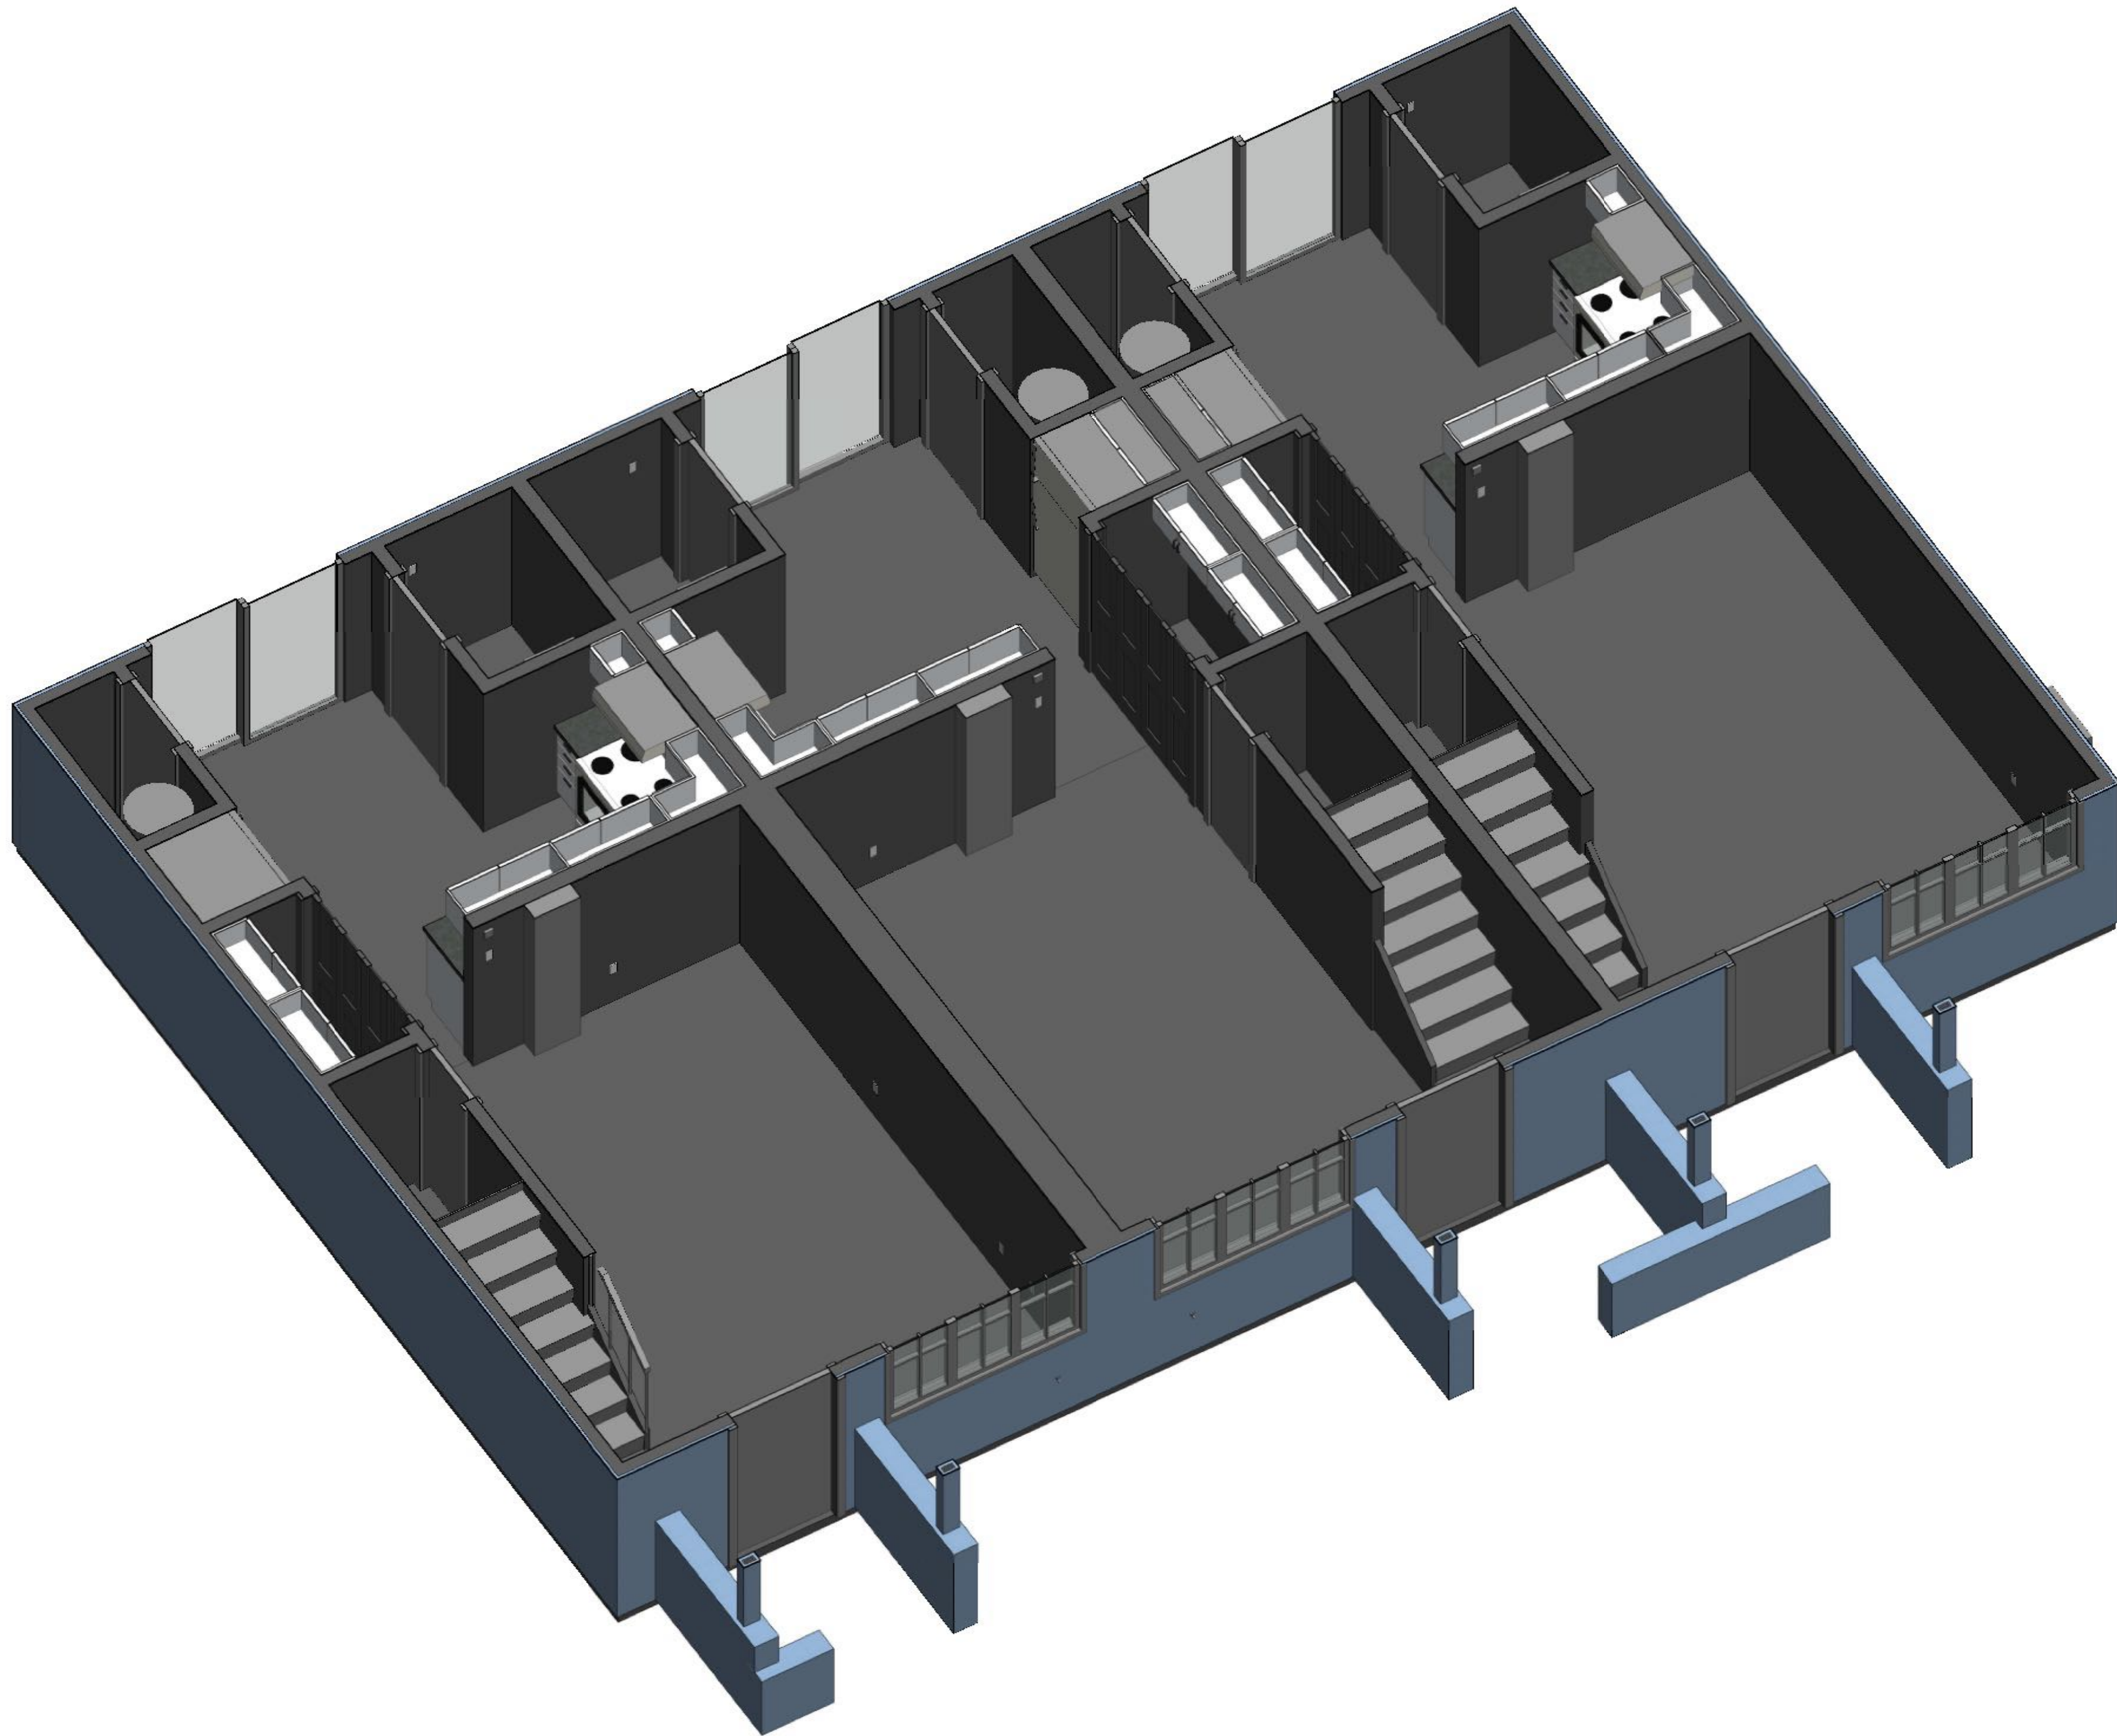


ARCHITECTURAL AS BUILT
Point Reyes Station, CA

01	100% SUBMISSION	SEE COVER SHEET
NO.	ISSUES / REVISIONS	DATE
		SHEET TITLE

3D FIRST FLOOR SECTION

Designer	PROJECT MANAGER
Designer	PROJECT DIRECTOR
Project Number	PROJECT NUMBER
	SCALE
Author	DRAWN BY
	SHEET NUMBER

AB-9

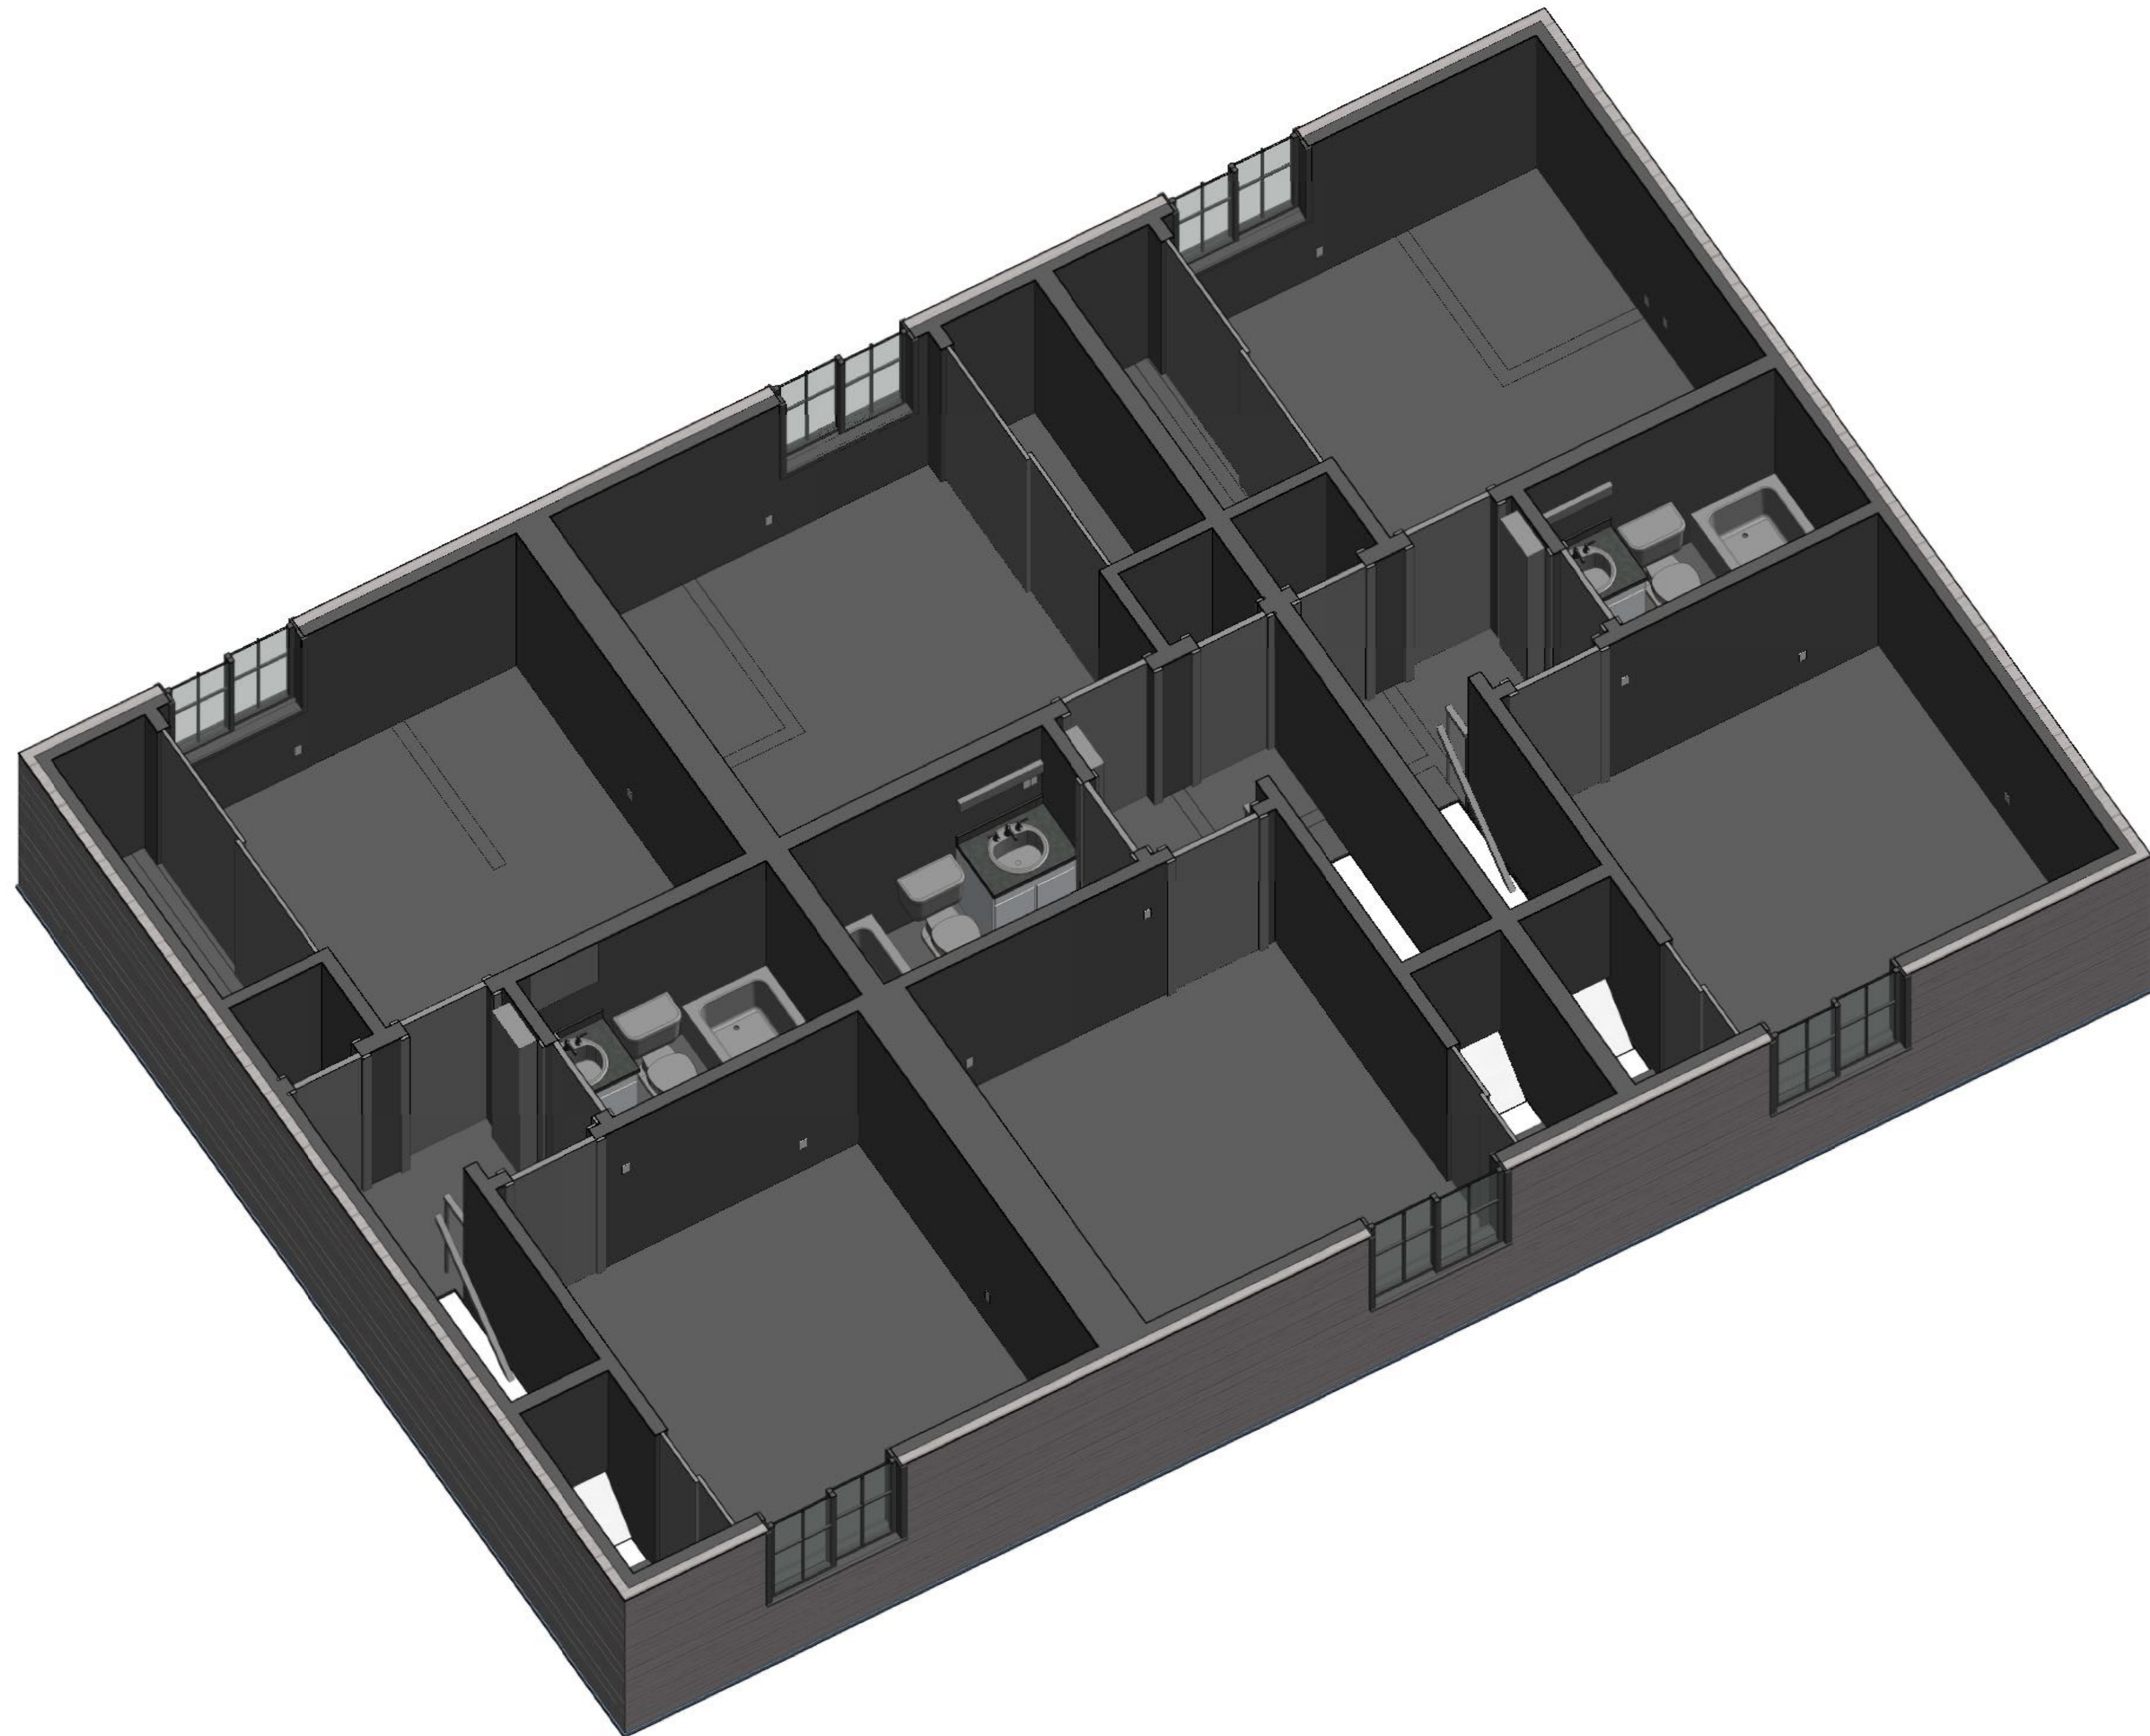



ARCHITECTURAL AS BUILT
Point Reyes Station, CA

NO.	ISSUES / REVISIONS	DATE	SHEET TITLE
01	100% SUBMISSION		SEE COVER SHEET

3D SECOND FLOOR SECTION

Designer	PROJECT MANAGER
Designer	PROJECT DIRECTOR
Project Number	PROJECT NUMBER
	SCALE
Author	DRAWN BY
	SHEET NUMBER

AB-10

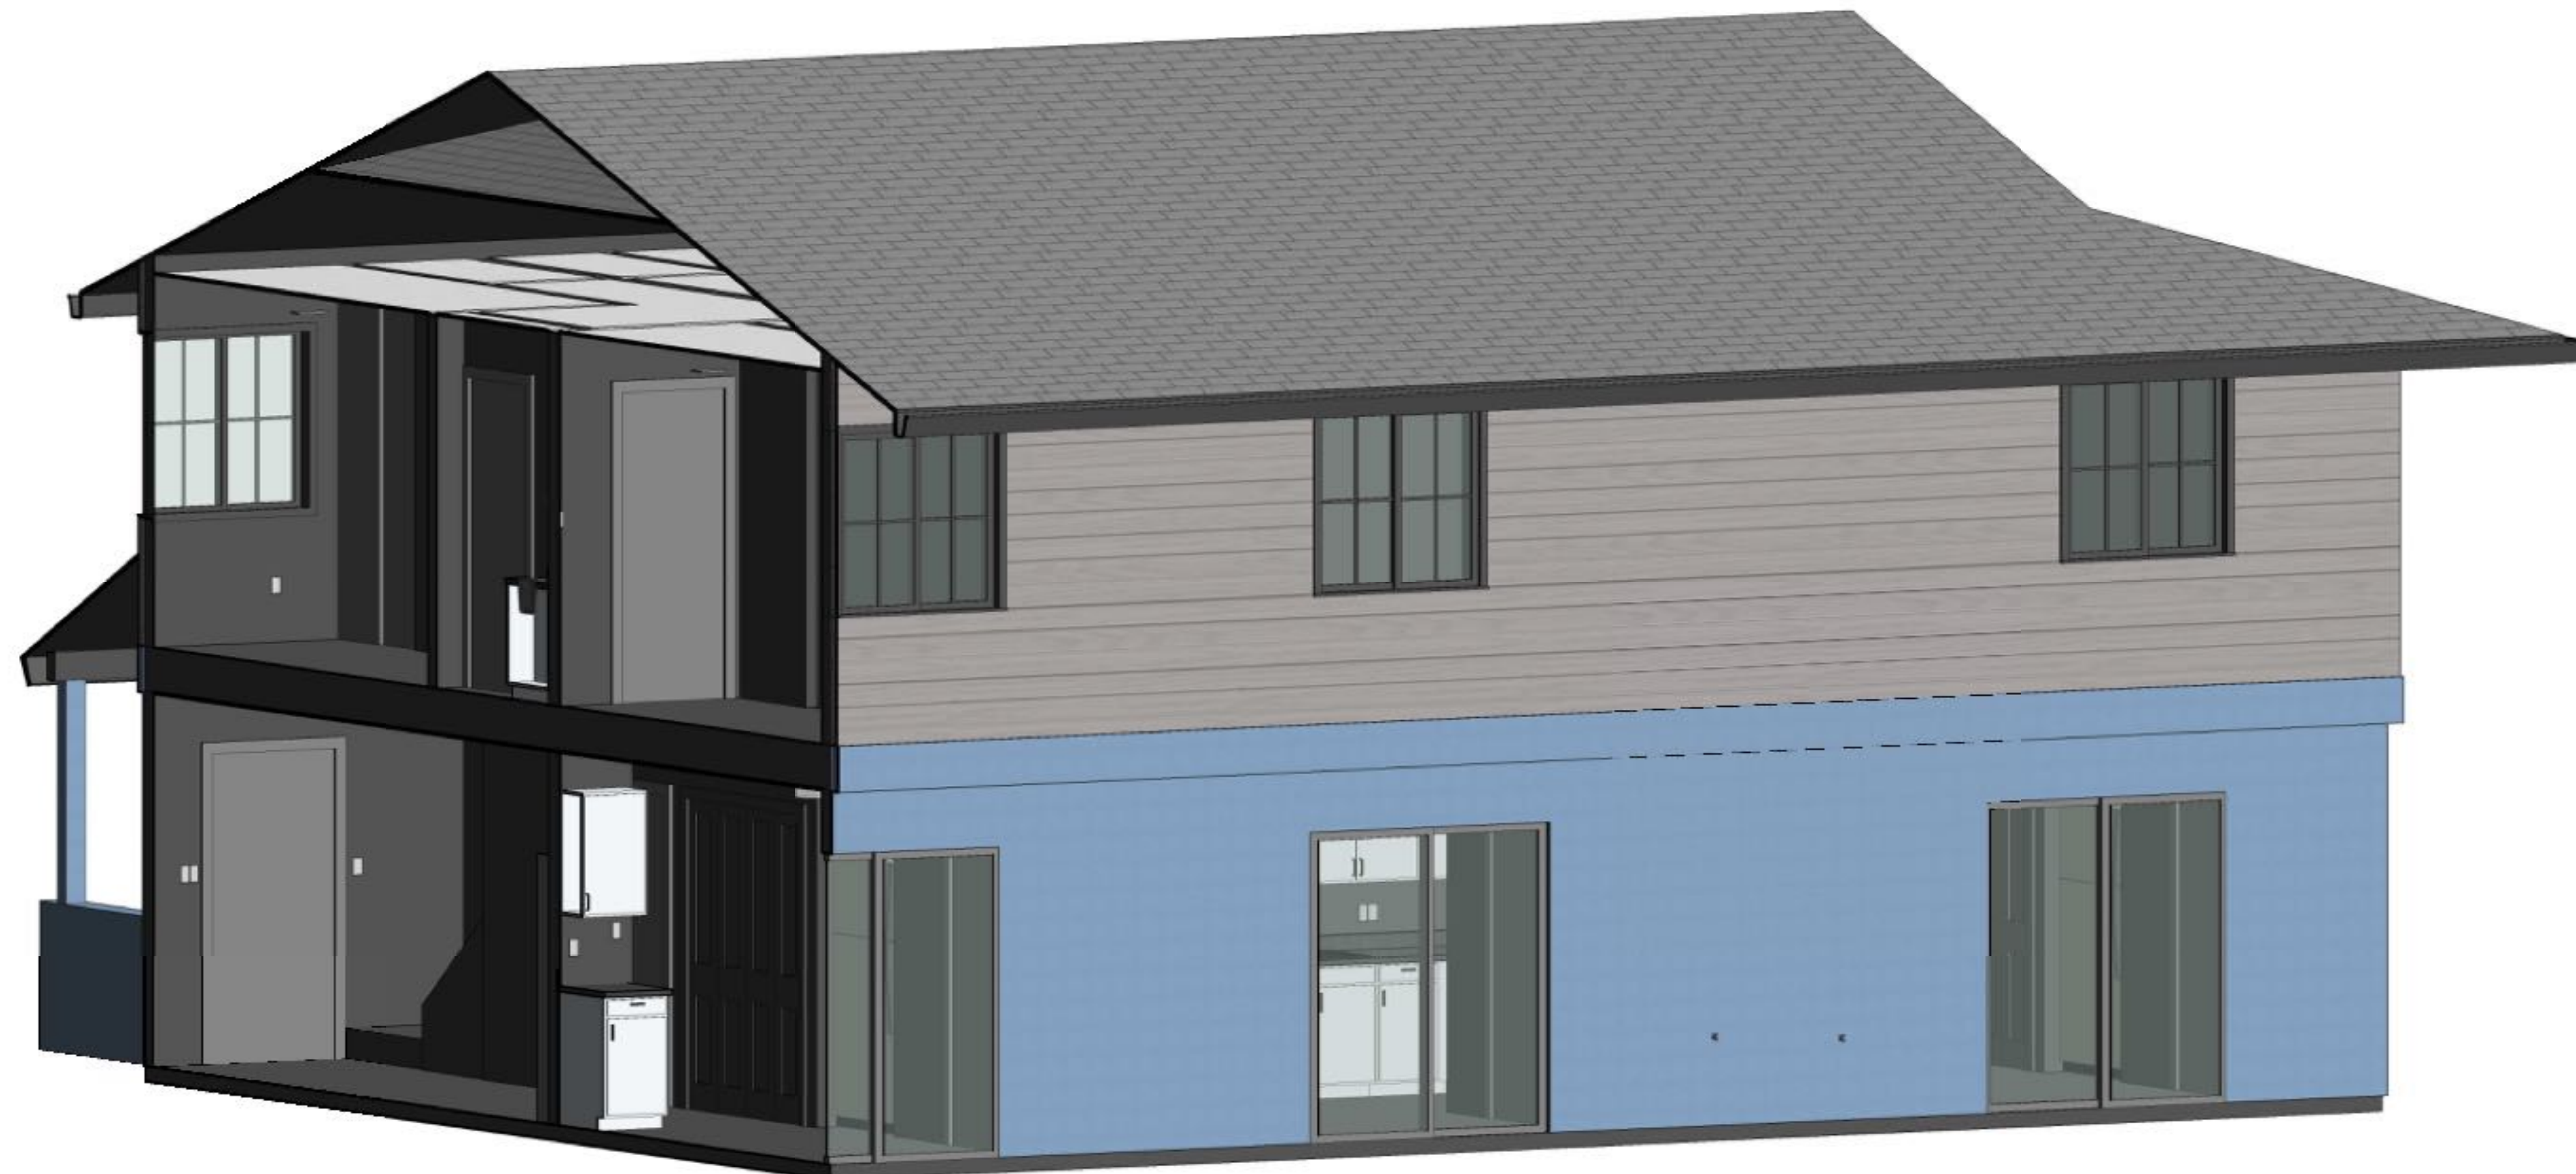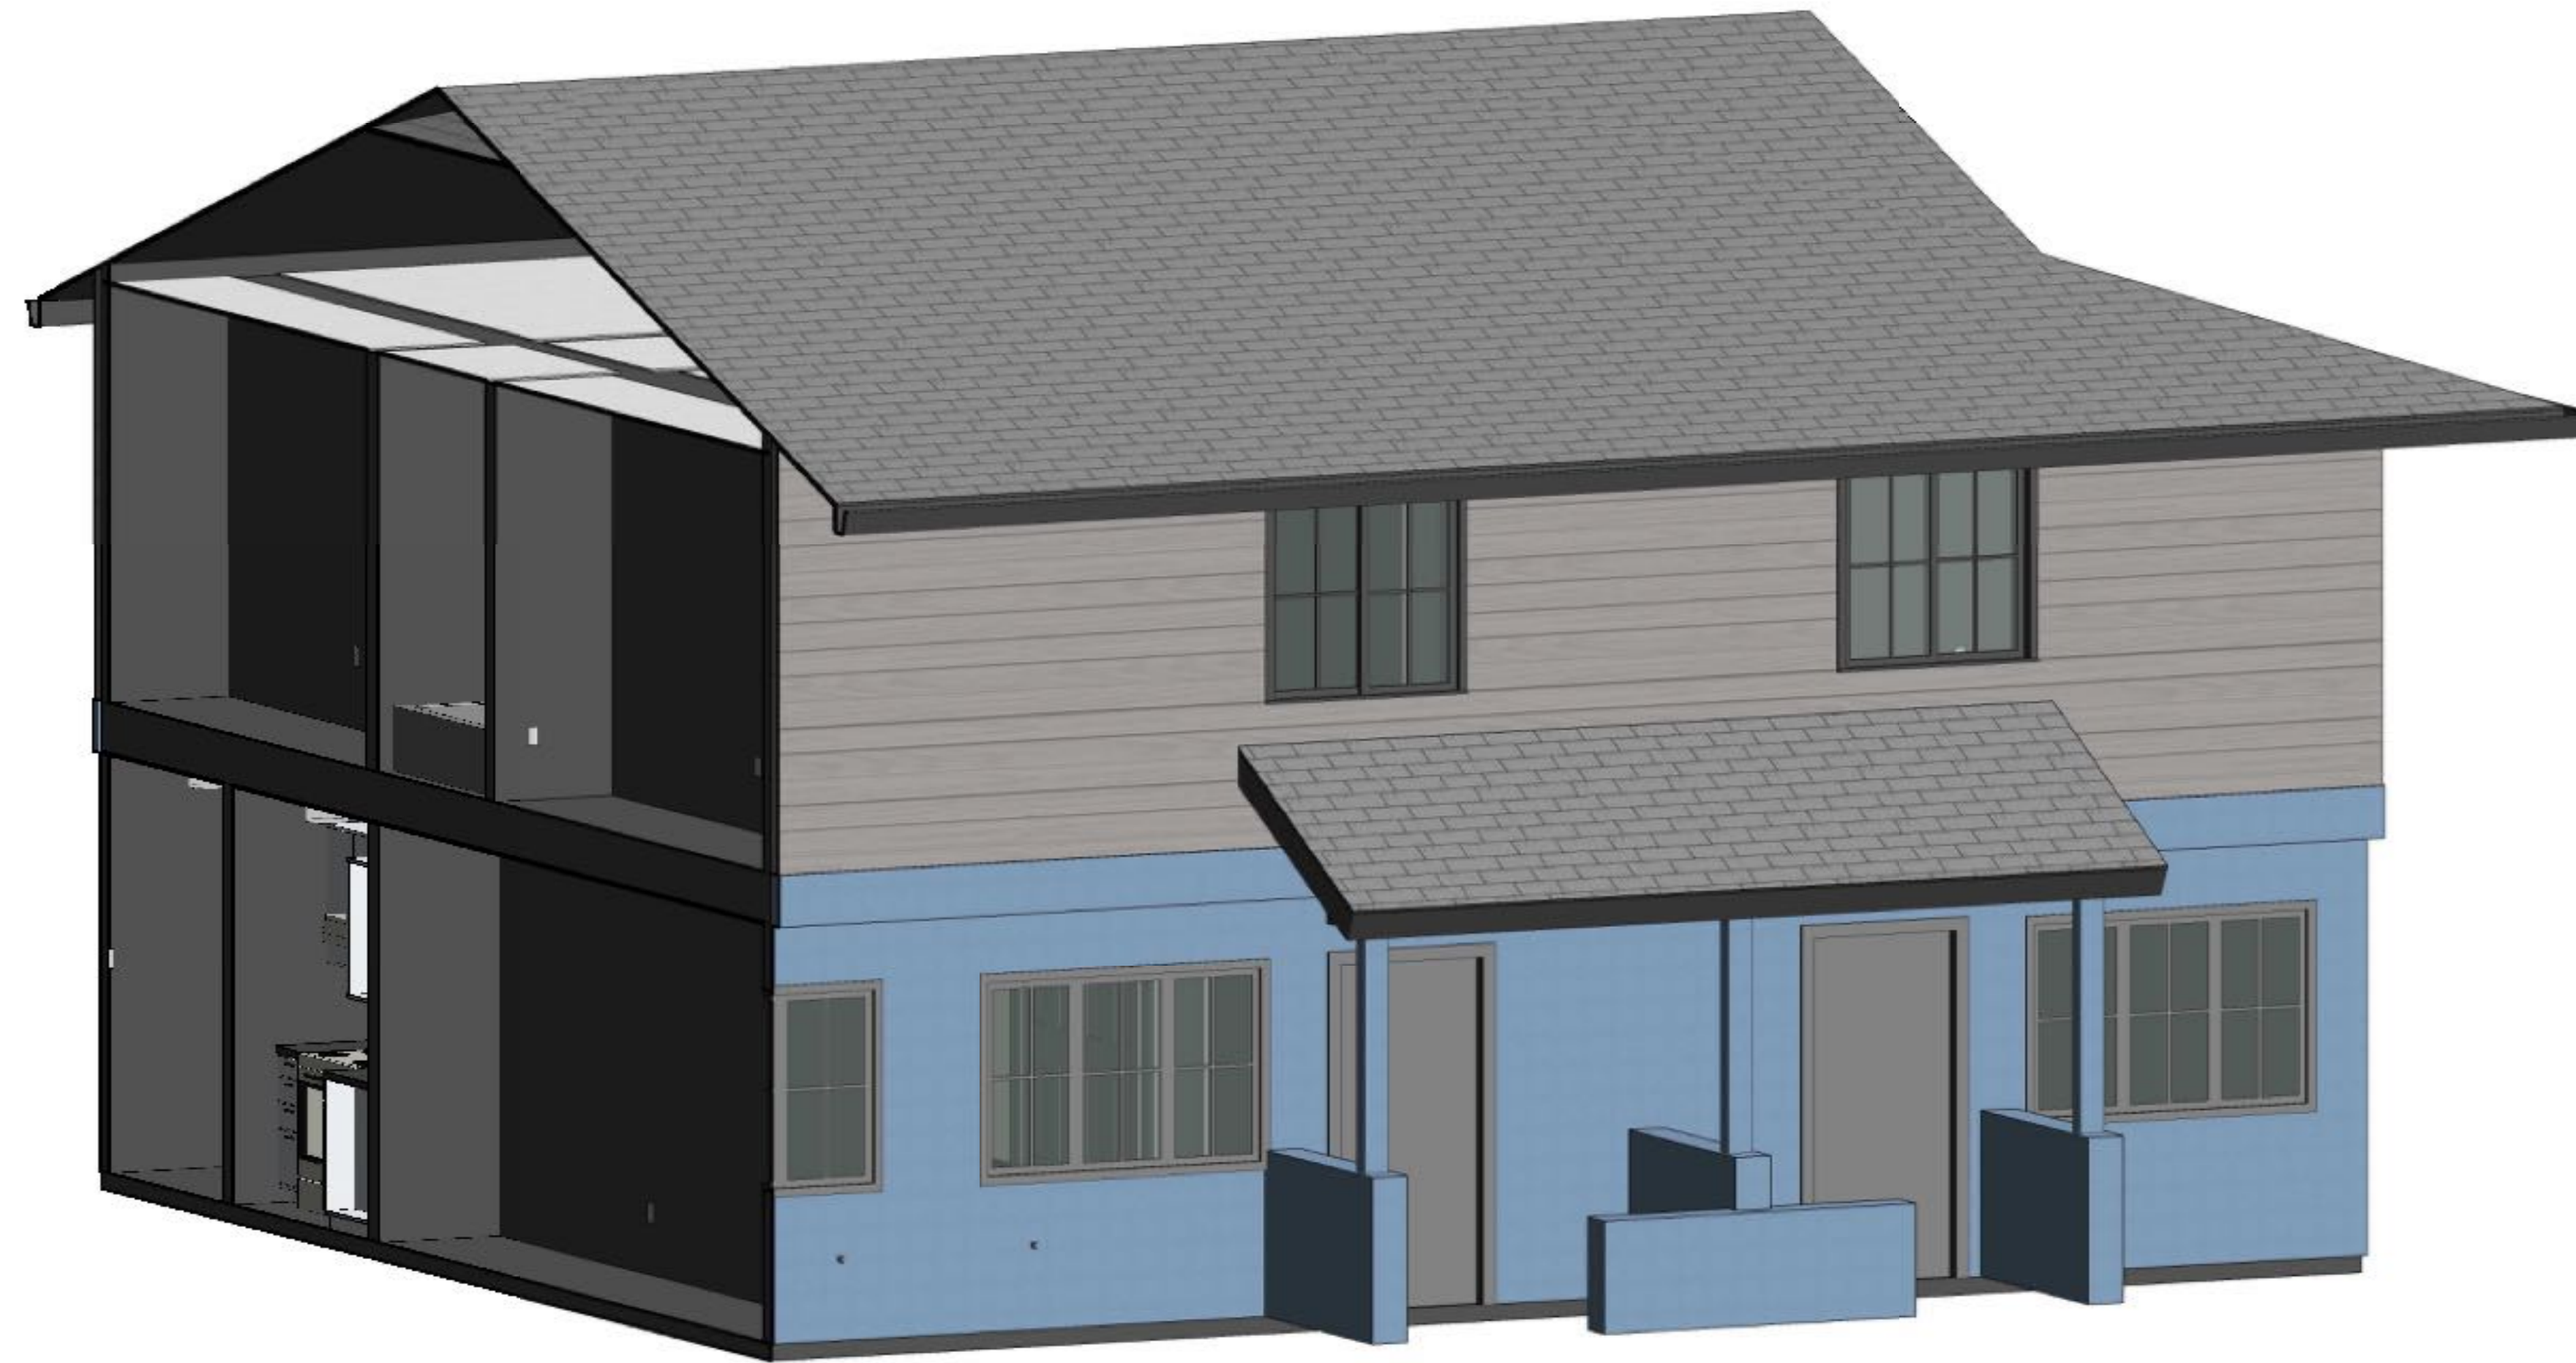

ARCHITECTURAL AS BUILT
Point Reyes Station, CA

01	100% SUBMISSION	SEE COVER SHEET
NO.	ISSUES / REVISIONS	DATE
		SHEET TITLE

3D SECTIONS

Designer	PROJECT MANAGER
Designer	PROJECT DIRECTOR
Project Number	PROJECT NUMBER
	SCALE
Author	DRAWN BY
	SHEET NUMBER

AB-12