www.asbuiltprofessionals.com

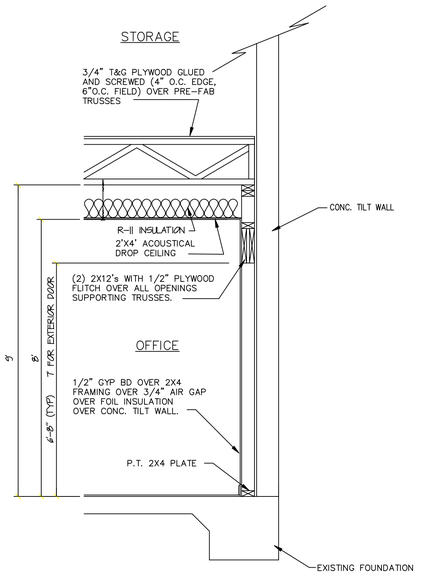

EXISTING EXTERIOR NORTH WALL AT OFFICE DETAIL 1/2"=1'-0"

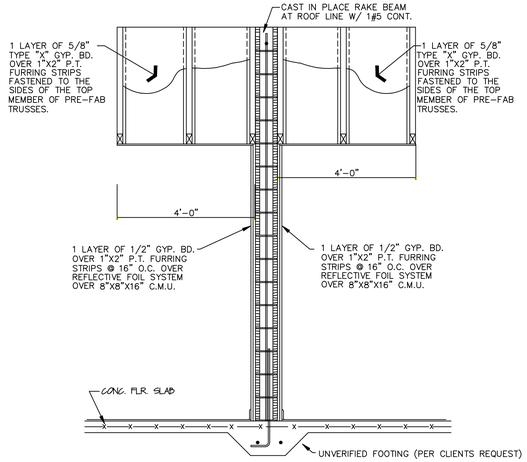

VERIFIED TENANT SEPARATION 1/2"=1'-0"

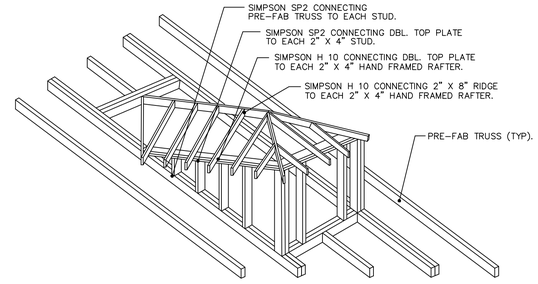

EXISTING DORMER FRAMING AND STRAPPING DETAIL
NOT TO SCALE

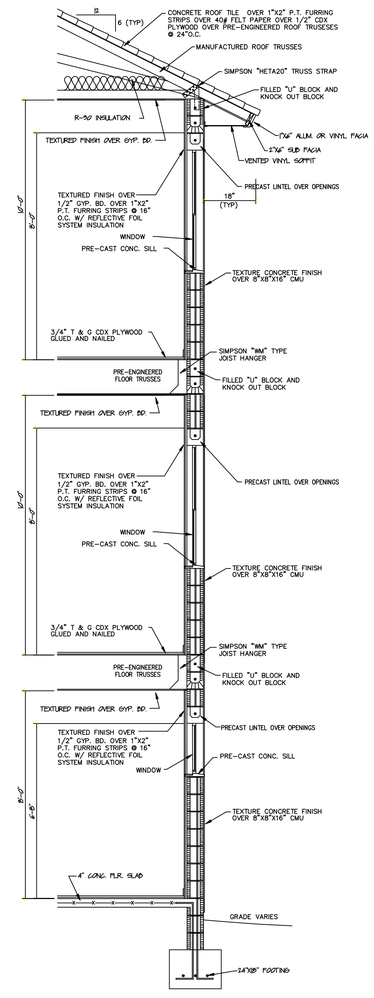

TYPICAL EXISTING WALL SECTION 1/2"=1'-0"

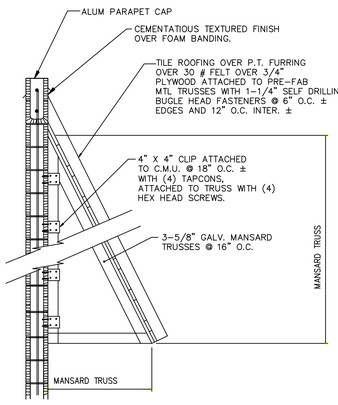

TYPICAL EXISTING MANSARD ROOF SECTION

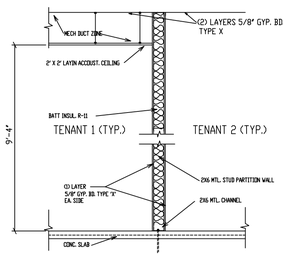

TYPICAL EXISTING INTERIOR TENANT SEPARATION

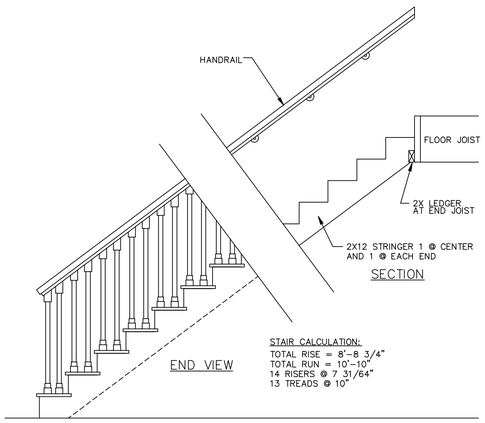

EXISTING STAIR DETAIL

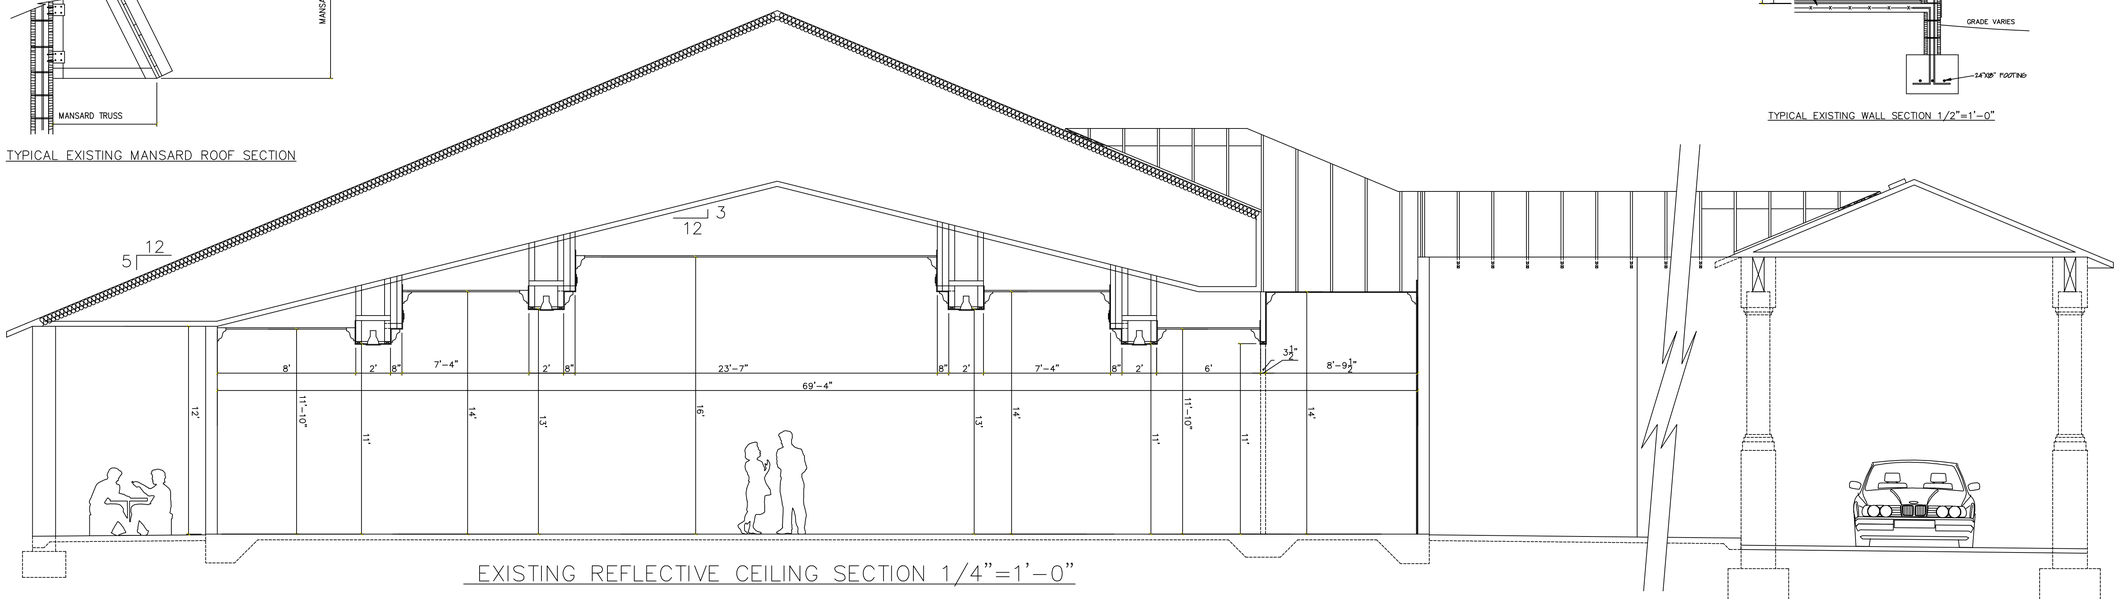

EXISTING REFLECTIVE CEILING SECTION 1/4"=1'-0"

PROJECT NAME: BLANK FOR SECURITY
PROJECT LOCATION BLANK FOR SECURITY

THIS AS-BUILT DRAWING WAS PREPARED BY:
AS BUILT PROFESSIONALS
A SERVICE OF A.E.C. CONSULTANTS INC.
WWW.ASBUILTPROFESSIONALS.COM
866-903-8842
TOLL FREE

JOB NO.
000-00-00

SHEET
AB-1 of AB-1